

**APPROACH AREA DETAIL - BUTT**

LOCATION

ROCKINGHAM	
0+53	- BEGIN COLD PLANING
TOWN HIGHWAYS	
4+35 (I-91 NB ON RAMP B)	- END COLD PLANING
7+30 (I-91 NB ON RAMP B)	- END COLD PLANING
13+55 (I-91 SB OFF RAMP C)	- END COLD PLANING
15+18 (I-91 SB OFF RAMP C)	- END COLD PLANING
20+21 (I-91 SB ON RAMP D)	- END COLD PLANING
23+34 (I-91 SB ON RAMP D)	- END COLD PLANING
28+51 (SCHOOL BUS DEPOT RD)	- END COLD PLANING
29+05	- END COLD PLANING

**SEEDING FORMULA - RURAL AREAS**

% WT.	LBS./A.	NAME	PUR %	GERM %
37.5	22.5	CREEPING RED FESCUE	98	85
37.5	22.5	TALL FESCUE	95	90
5.0	3.0	RED TOP	95	90
15.0	9.0	BIRDSFOOT TREFOIL	98	85
5.0	3.0	ANNUAL RYEGRASS	95	85
100.0	60.0			

**SEEDING NOTES**

SEED MIXTURE: SHALL NOT HAVE A WEED CONTENT EXCEEDING 0.40% BY WEIGHT AND SHALL BE FREE OF ALL NOXIOUS SEED.


SEED: TO BE APPLIED PER SEEDING FORMULAS OR AS DIRECTED BY THE RESIDENT ENGINEER.

FERTILIZER: FORMULA 10-20-10, TO BE USED WITH SEED, APPLIED AT THE RATE OF 500 LBS./ACRE. (HYDRO SEEDERS MAY USE 19-19-19 FORMULA).

AGRICULTURAL LIMESTONE: TO BE APPLIED AT THE RATE OF 2 TONS/ACRE, OR AS DIRECTED BY THE RESIDENT ENGINEER.

HAY MULCH: TO BE PLACED ON THE EARTH SLOPES AT THE RATE OF 2 TONS/ACRE, OR AS DIRECTED BY THE RESIDENT ENGINEER.


TOPSOIL: TO BE USED WITH SEED AS INDICATED ON THE PLANS, OR AS DIRECTED BY THE RESIDENT ENGINEER.

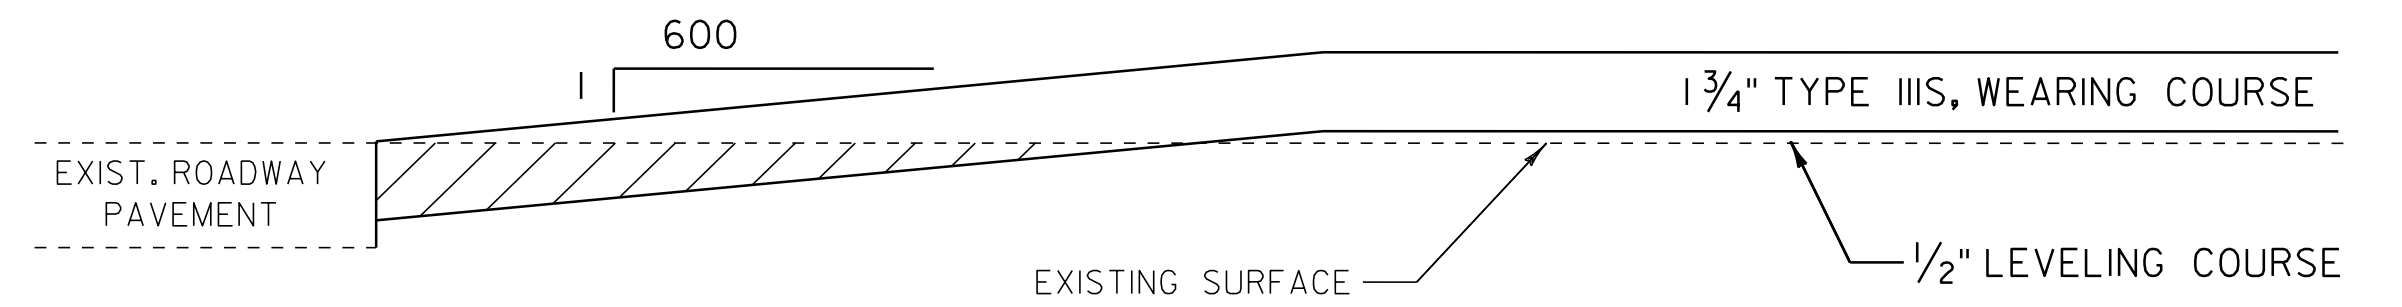

**APPROACH AREA DETAIL - TAPER**

LOCATION

ROCKINGHAM	
29+05 TO 30+18 - BEGIN OVERLAY	
TOWN HIGHWAYS	
TH 75 RT 60+00	TH 84 LT 41+24
TH 6 RT 85+77	TH 78 LT 71+75
TH 27 LT 126+13	TH 78 LT 102+25
TH 2 LT 173+84	TH 77 RT 150+88
TH 82 RT 187+15	TH 4 RT 184+09
TH 8 RT 283+72	TH 14 RT 263+57
TH 12 LT 336+37	TH 81 LT 312+37
CHESTER	
TH 62 LT C 17+21	TH 6 RT C 29+83
TH 60 LT C 33+53	GMHS LT C 98+33
TH 123 RT C 102+60	

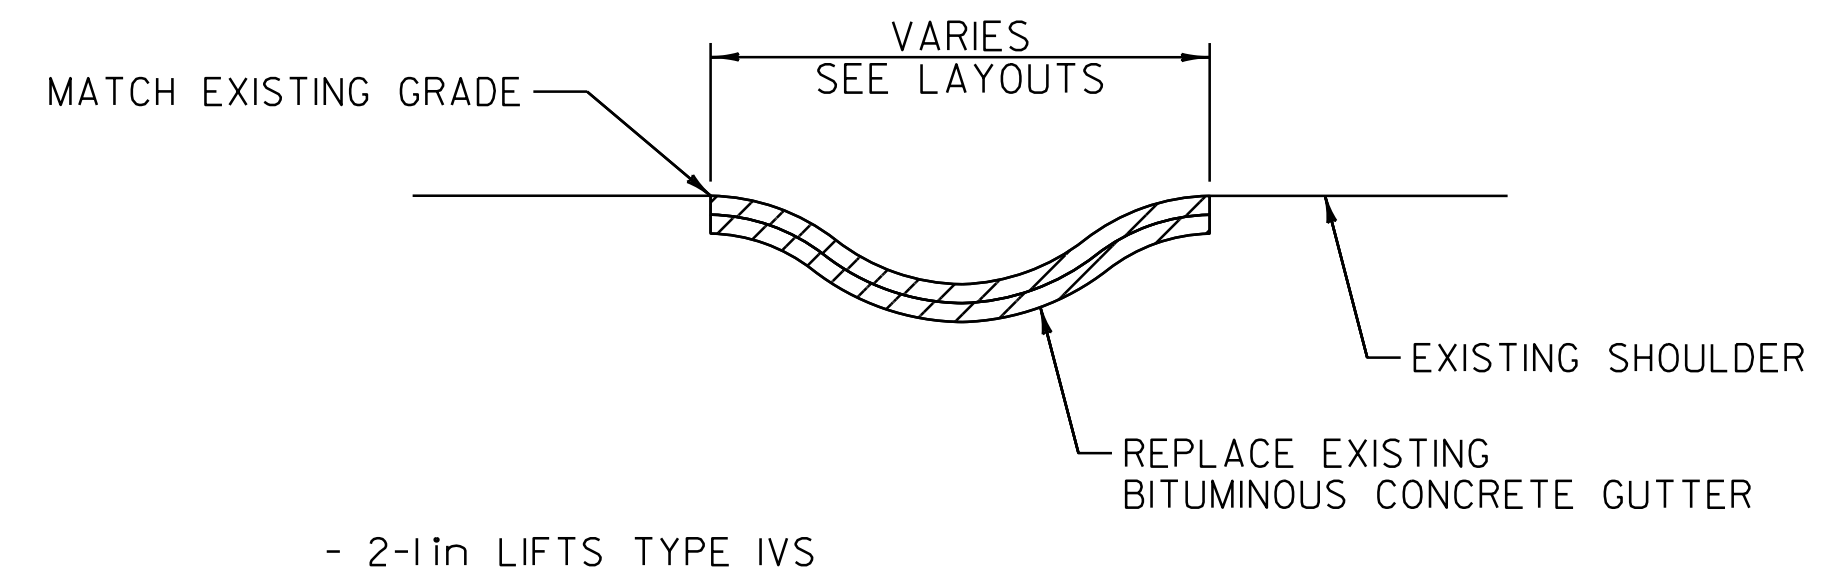

**BITUMINOUS CONCRETE GUTTERS AND TRAFFIC ISLANDS**

NOT TO SCALE

LOCATION

ROCKINGHAM		CHESTER	
26+46 TO	27+45 RT	C 4+44 LT	
65+05 RT		C 6+00 RT	
65+09 LT			
107+74.35 TO	108+20 RT		
111+63.5 LT			
285+05 LT			
299+45 LT			
305+25 LT			

**PROJECT TYPICAL 2**

PROJECT NAME: ROCKINGHAM-CHESTER	PLOT DATE: 31-AUG-2012 14:00
PROJECT NUMBER: NH 2628(I)	DRAWN BY: MRS
FILE NAME: 06B224	CHECKED BY: PTS
PROJECT LEADER: PTS	SHEET 4 OF 82
DESIGNED BY: NULL	
IPARM FILE NAME: pb224ty02.i	

NOT TO SCALE