

TEMPORARY 4" WHITE LINE, PAINT
 DURABLE 4" WHITE LINE, THERMOPLASTIC
 12+00 TO 13+20 SOLID LT
 12+00 TO 13+18 DASHED LT (LANE LINE)
 12+00 TO 17+00 SOLID RT
 14+04 TO 15+06 SOLID LT
 15+30 TO 17+00 SOLID LT

TEMPORARY 8" WHITE LINE, PAINT
 DURABLE 8" WHITE LINE, THERMOPLASTIC
 13+18 TO 13+80 SOLID LT
 13+18 TO 14+04 SOLID LT

















TEMPORARY 4" YELLOW LINE, PAINT
 DURABLE 4" YELLOW LINE, THERMOPLASTIC
 12+00 TO 14+98 SOLID LT & RT
 15+38 TO 17+00 SOLID LT & RT

REMOVAL AND DISPOSAL OF GUARDRAIL
 12+00.0 TO 12+71.0 LT
 STEEL BEAM GUARDRAIL, GALVANIZED
 12+00.0 TO 12+33.5 LT

SHOULDER BERM REMOVAL
 12+00 TO 17+00 RT

REMOVING SIGNS
 AS SHOWN - 8

MANUFACTURED TERMINAL SECTION, FLARED
 DELINEATOR WITH STEEL POST
 12+71.0 LT

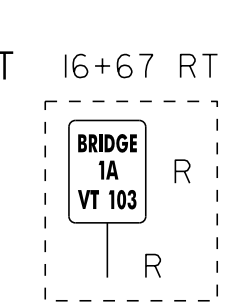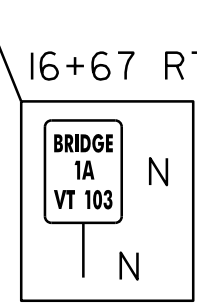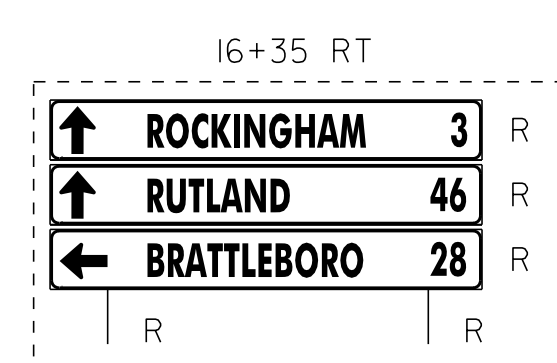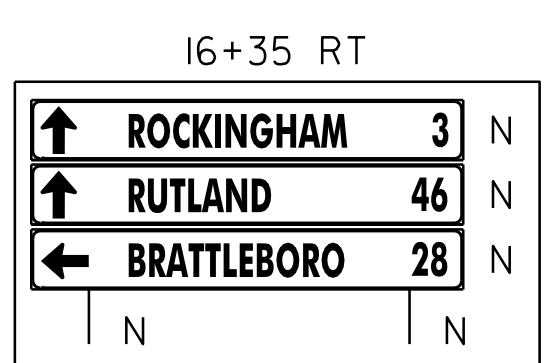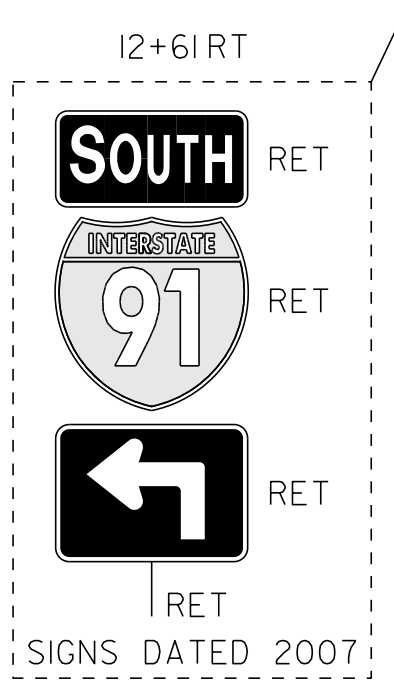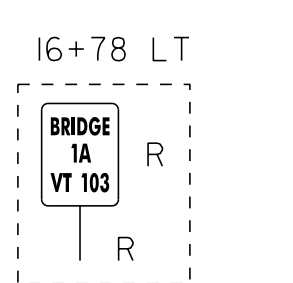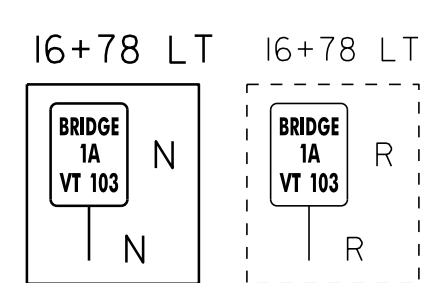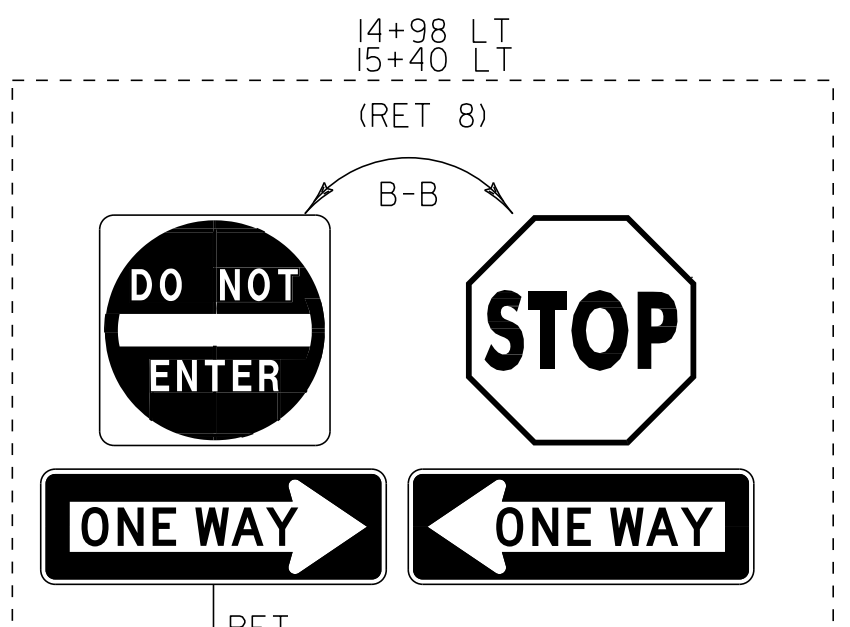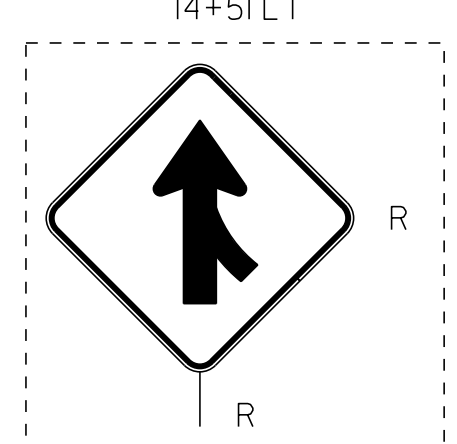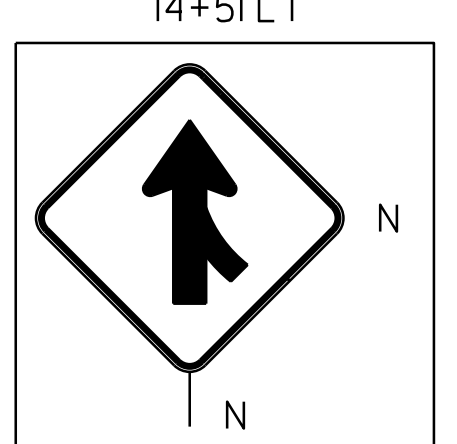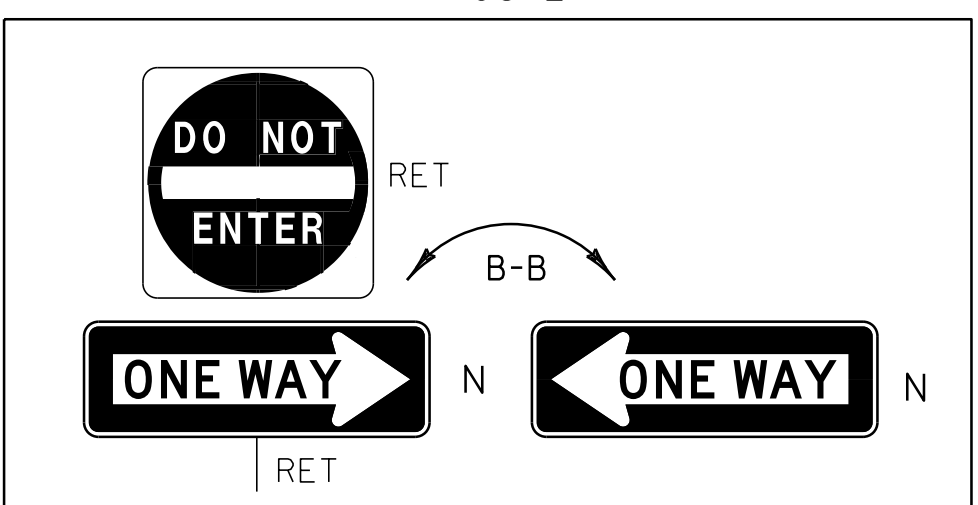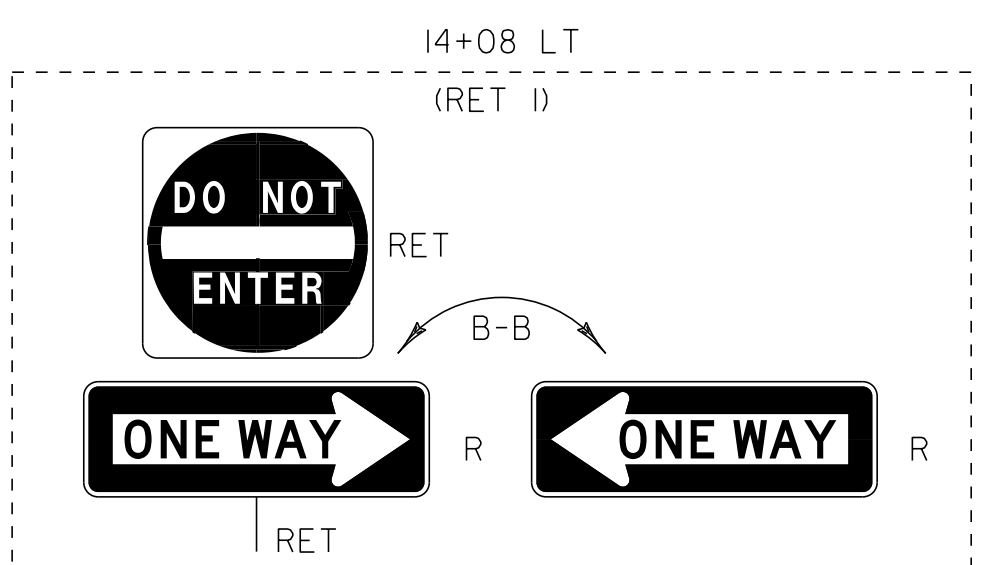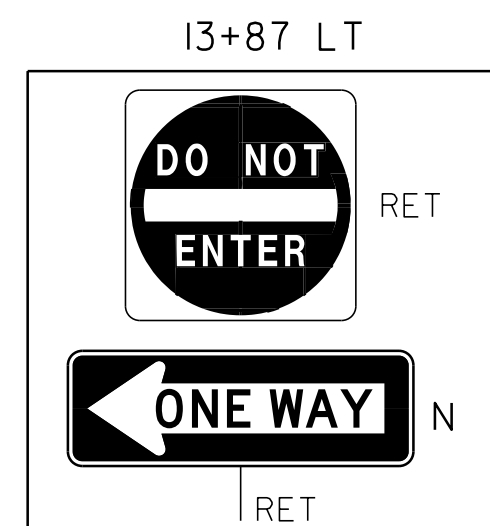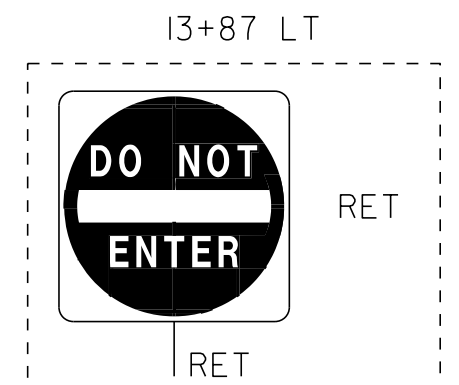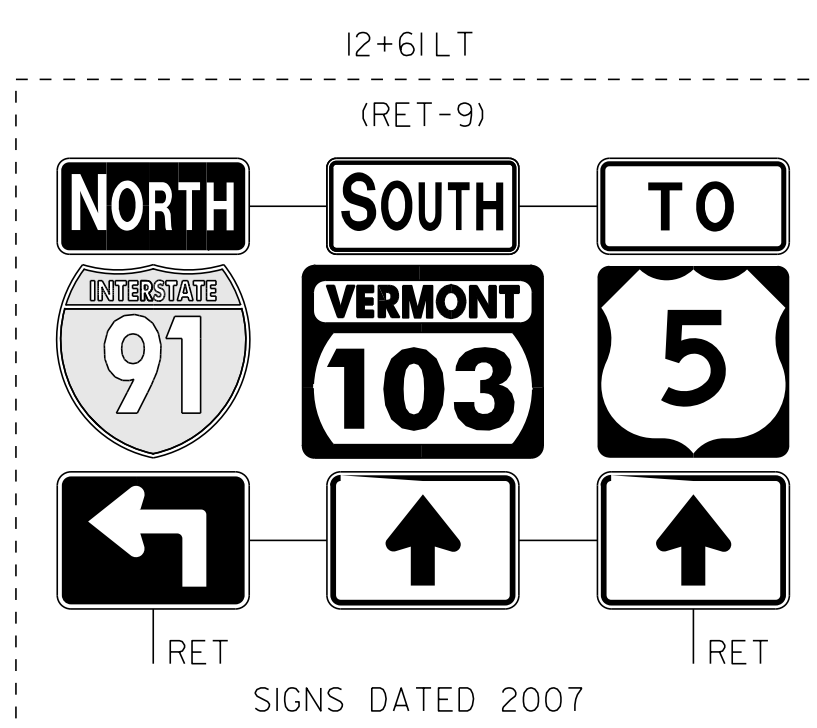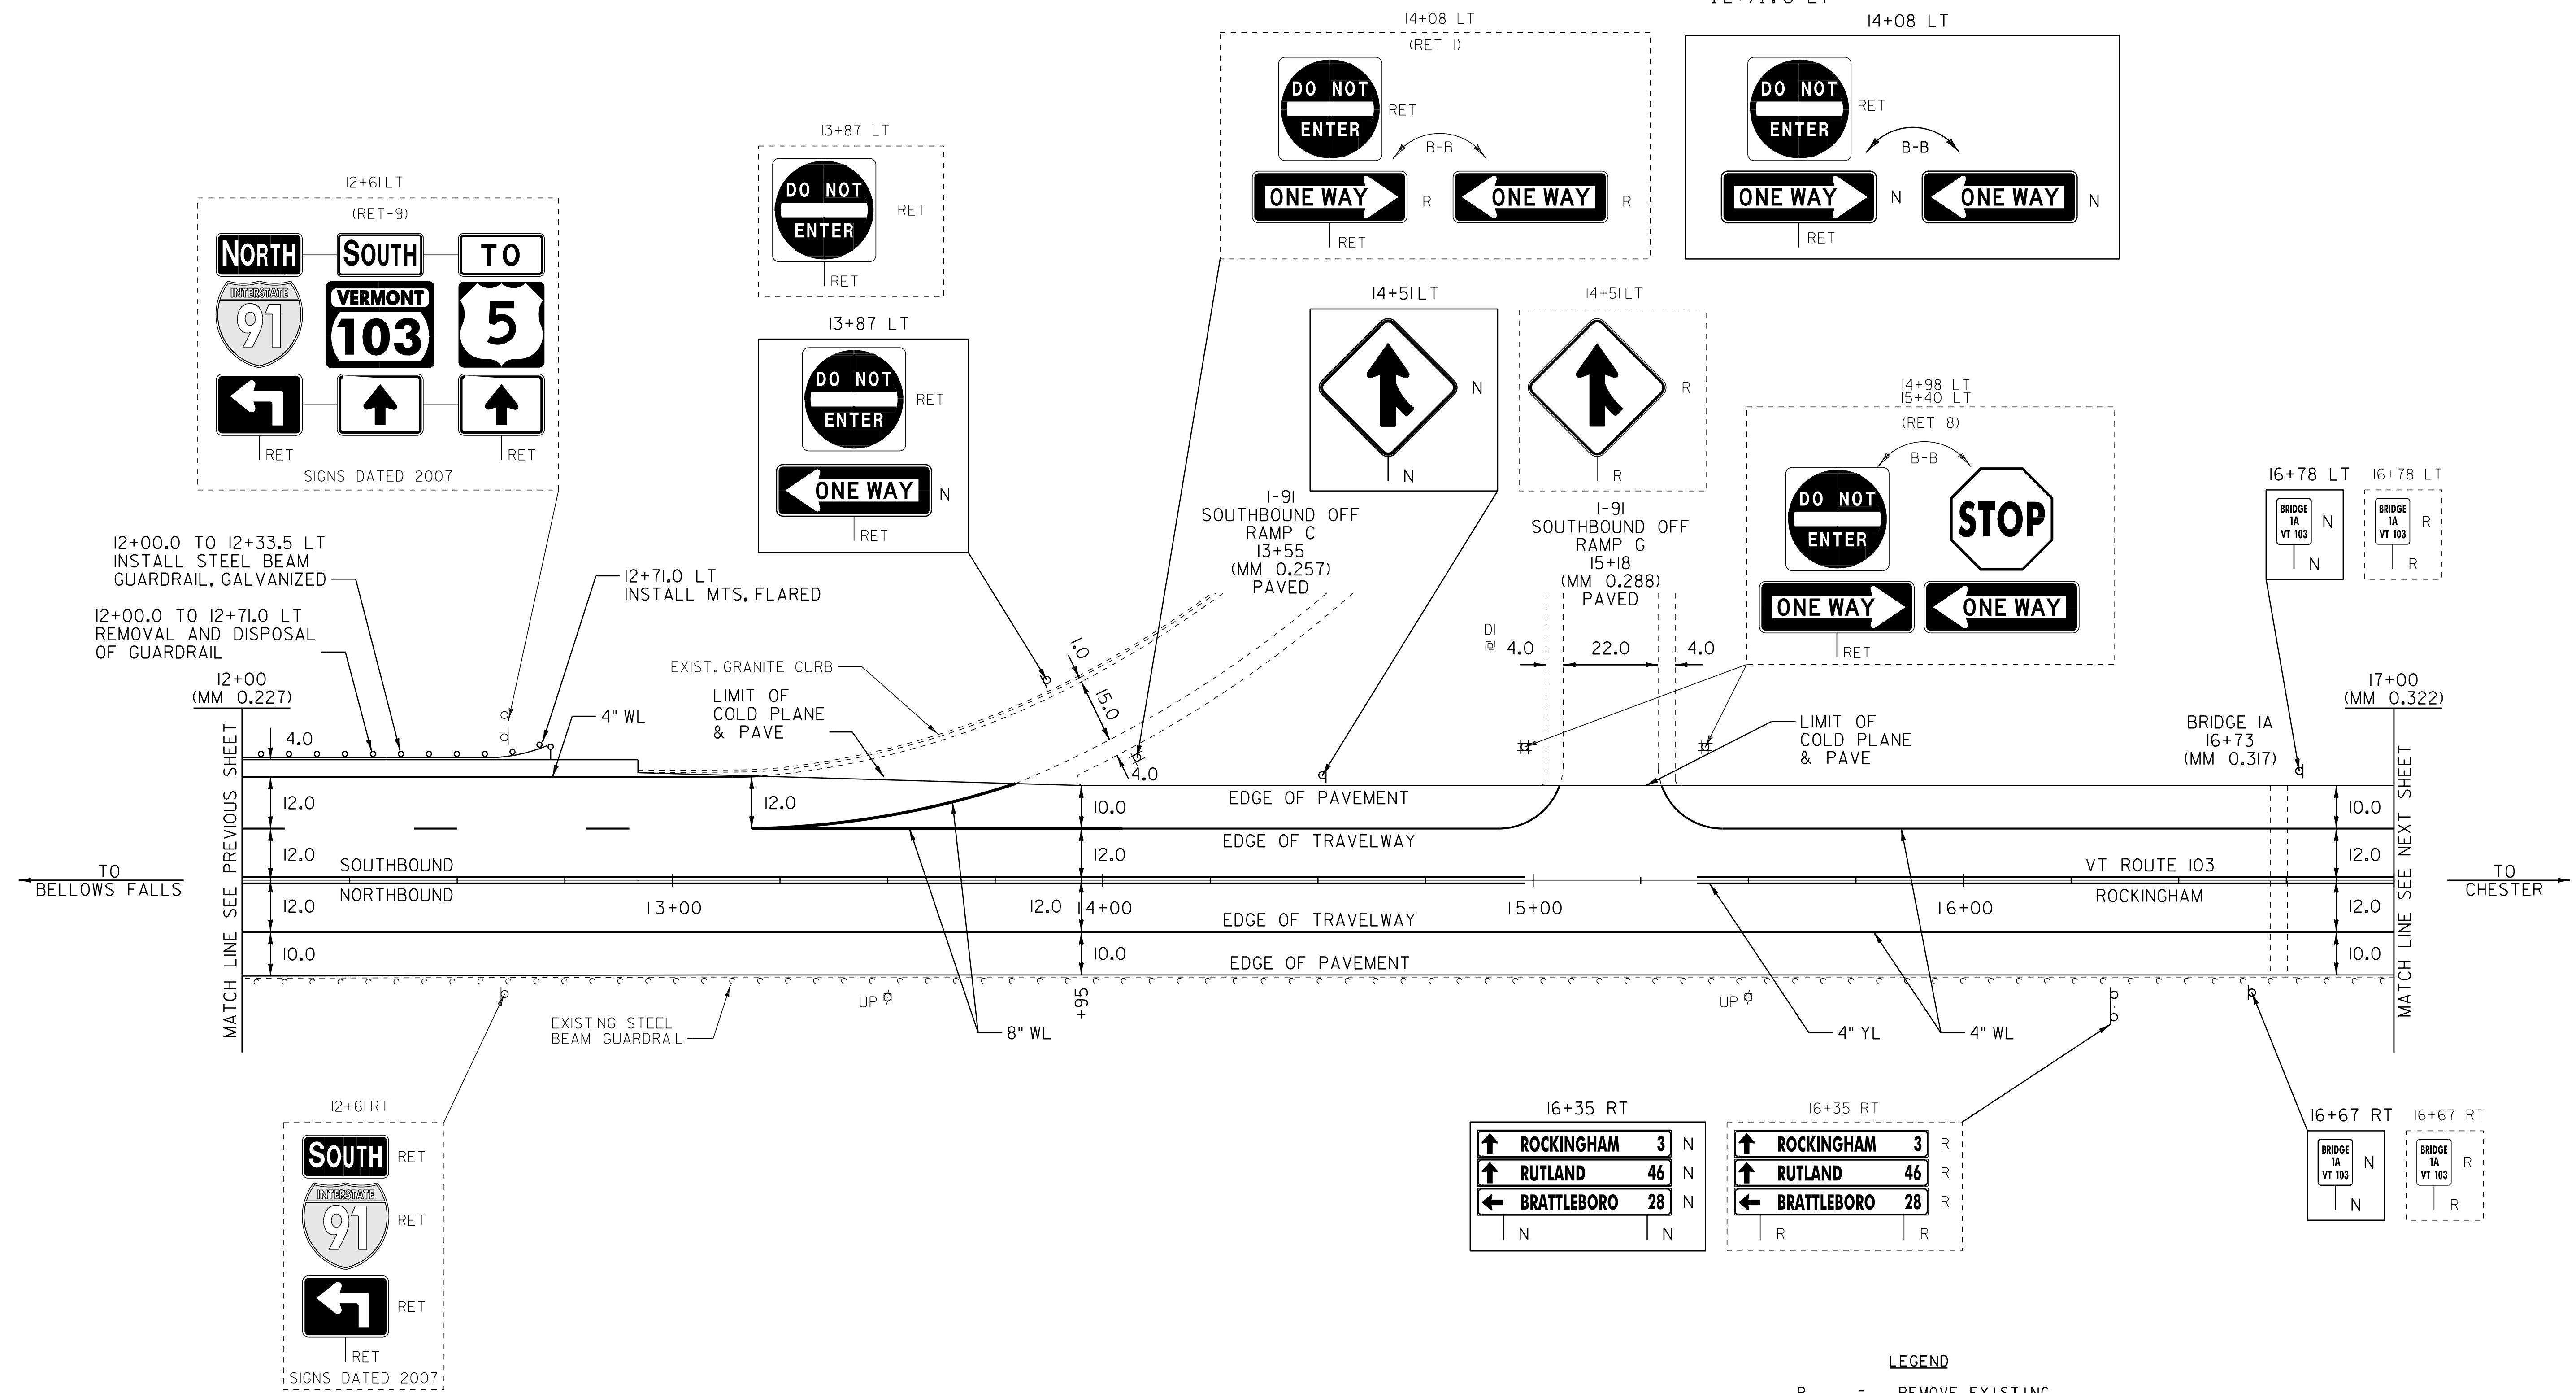

- LEGEND**
- R = REMOVE EXISTING
 - S = SALVAGE
 - R&S = REMOVE AND SALVAGE
 - N = NEW
 - RET = RETAIN
 - B-B = BACK TO BACK
 - = EXISTING GUARDRAIL
 - = PROPOSED GUARDRAIL
 - YL = YELLOW LINE
 - WL = WHITE LINE
 - ⊙ = TYPE I DELINEATOR, WHITE

NOT TO SCALE

PAVING LAYOUT 4

PROJECT NAME: ROCKINGHAM-CHESTER
 PROJECT NUMBER: NH 2628(I)

FILE NAME: 06B224
 PROJECT LEADER: PTS
 DESIGNED BY: NULL
 IPARM FILE NAME: pb224i04.i

PLOT DATE: 31-AUG-2012 14:01
 DRAWN BY: MRS
 CHECKED BY: PTS
 SHEET 18 OF 82