

TEMPORARY 4" WHITE LINE, PAINT
 DURABLE 4" YELLOW LINE, THERMOPLASTIC
 87+00 TO 98+00 SOLID LT & RT

TEMPORARY 4" YELLOW LINE, PAINT
 DURABLE 4" YELLOW LINE, THERMOPLASTIC
 87+00 TO 94+00 SOLID LT, DASHED RT
 94+00 TO 97+30 DASHED RT
 97+30 TO 98+00 DASHED LT, SOLID RT


REMOVAL AND DISPOSAL OF GUARDRAIL
 92+73.0 TO 98+00.0 LT
 93+21.0 TO 98+00.0 RT

STEEL BEAM GUARDRAIL, GALVANIZED
 93+13.5 TO 98+00.0 LT
 93+57.5 TO 98+00.0 RT

REHAB. DROP INLETS, CATCH BASINS,
 OR MANHOLES, CLASS I, CLASS II OR CLASS III
 93+47 LT (DI)
 95+85 LT (DI)
 95+85 RT (DI)

BITUMINOUS CONCRETE
 CURB, TYPE A
 93+42 TO 97+48 LT
 95+85 TO 97+64 RT

REMOVING SIGNS
 AS SHOWN - 4

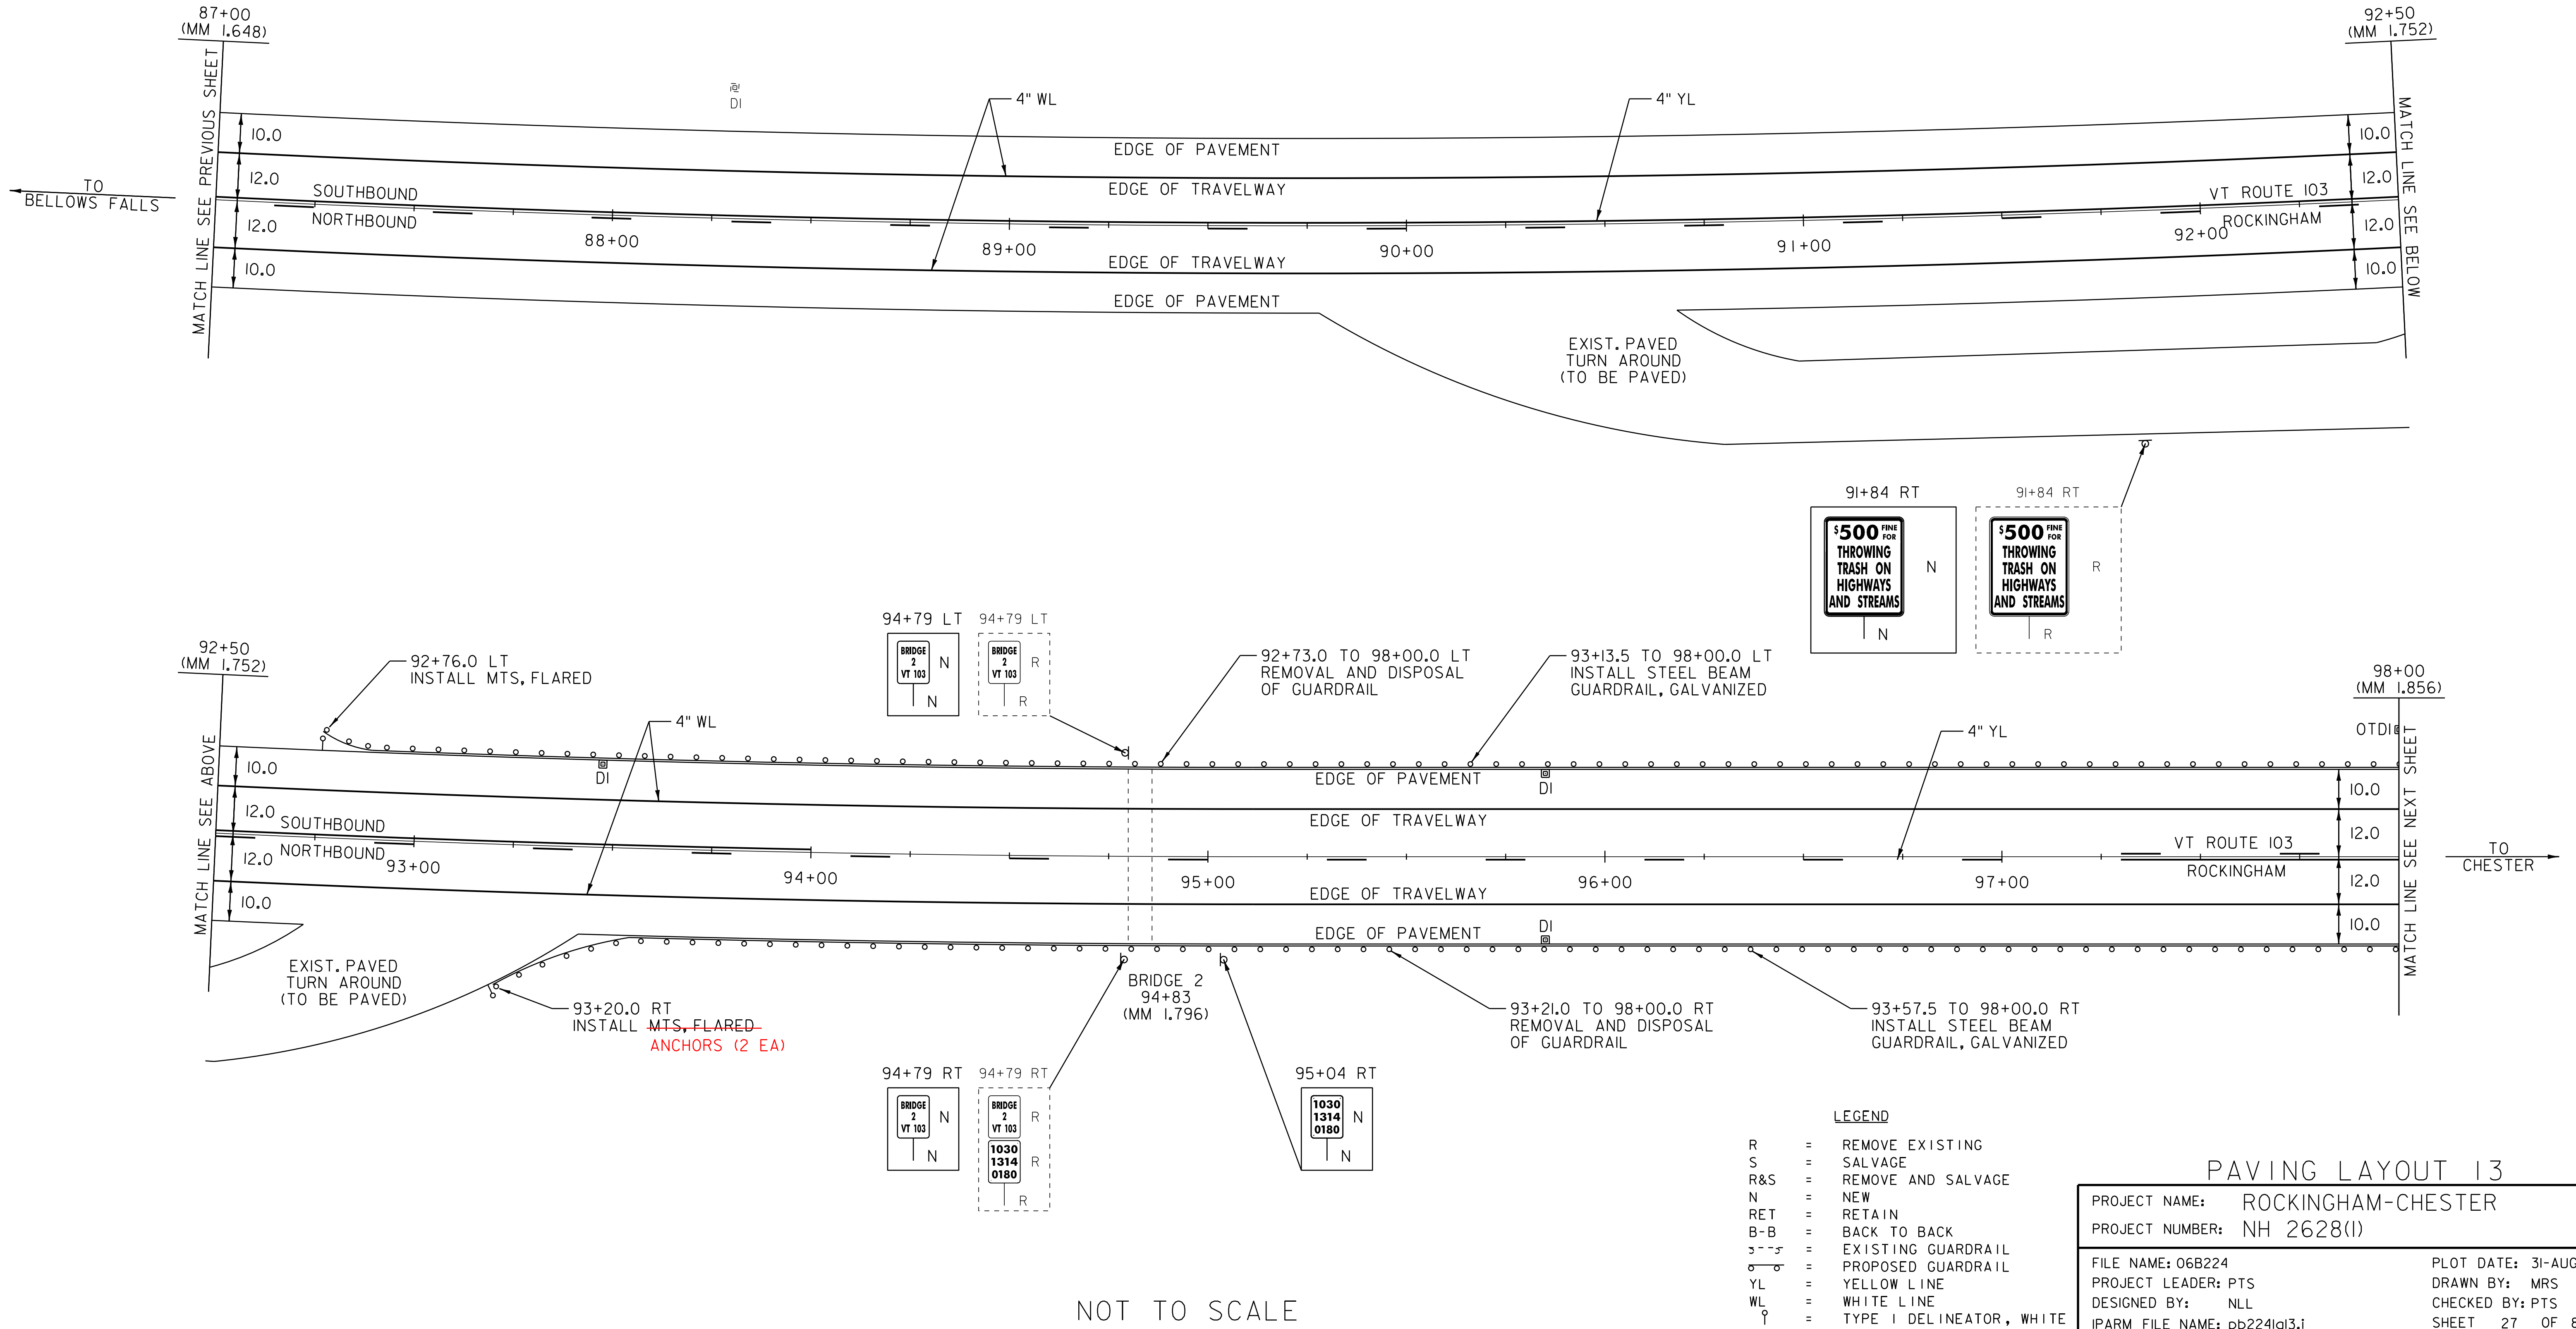

NOT TO SCALE

- LEGEND**
- R = REMOVE EXISTING
 - S = SALVAGE
 - R&S = REMOVE AND SALVAGE
 - N = NEW
 - RET = RETAIN
 - B-B = BACK TO BACK
 - = EXISTING GUARDRAIL
 - = PROPOSED GUARDRAIL
 - YL = YELLOW LINE
 - WL = WHITE LINE
 - ⊙ = TYPE I DELINEATOR, WHITE

PAVING LAYOUT 13

PROJECT NAME: ROCKINGHAM-CHESTER
 PROJECT NUMBER: NH 2628(I)

FILE NAME: 06B224
 PROJECT LEADER: PTS
 DESIGNED BY: NLL
 IPARM FILE NAME: pb2241a13.1

PLOT DATE: 31-AUG-2012 14:02
 DRAWN BY: MRS
 CHECKED BY: PTS
 SHEET 27 OF 82