

TEMPORARY 4" WHITE LINE, PAINT  
 DURABLE 4" WHITE LINE, THERMOPLASTIC  
 130+50 TO 141+50 SOLID LT & RT


TEMPORARY 4" YELLOW LINE, PAINT  
 DURABLE 4" YELLOW LINE, THERMOPLASTIC  
 130+50 TO 141+50 SOLID LT & RT

REMOVAL AND DISPOSAL OF GUARDRAIL  
 130+50.0 TO 132+43.0 RT  
 130+50.0 TO 132+54.0 LT

REMOVING SIGNS  
 AS SHOWN - 2

STEEL BEAM GUARDRAIL, GALVANIZED  
 130+50.0 TO 132+08.0 RT  
 130+50.0 TO 132+15.5 LT

MANUFACTURED TERMINAL SECTION, FLARED  
 DELINEATOR WITH STEEL POST  
 132+45.5 RT  
 132+53.0 LT

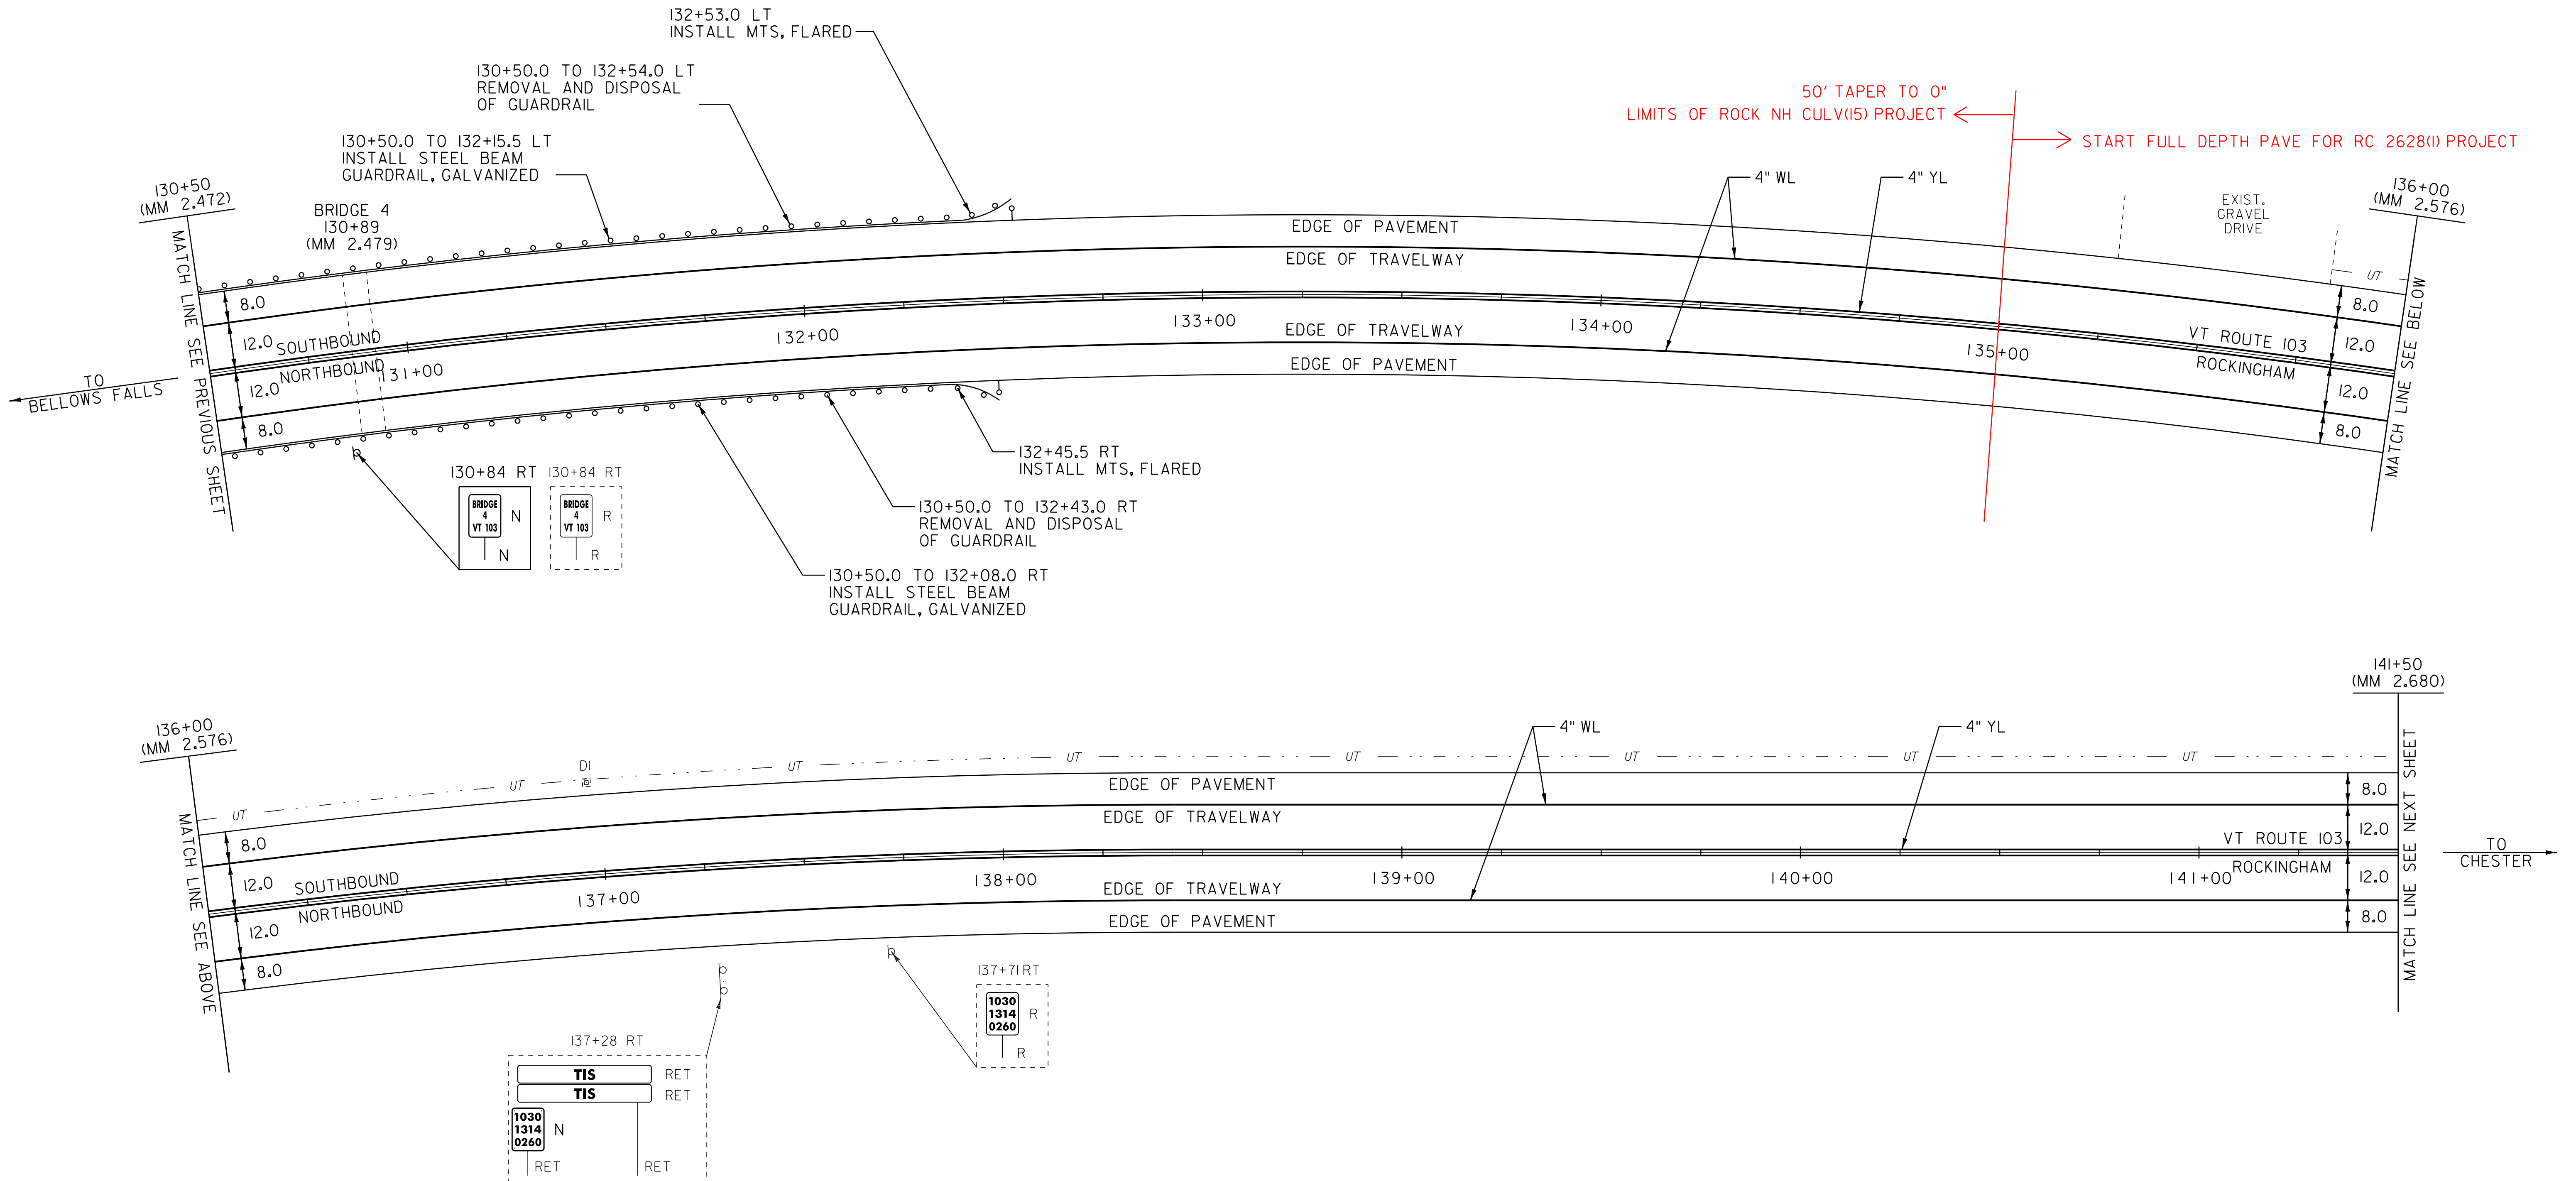

LEGEND

- R = REMOVE EXISTING
- S = SALVAGE
- R&S = REMOVE AND SALVAGE
- N = NEW
- RET = RETAIN
- B-B = BACK TO BACK
- = EXISTING GUARDRAIL
- o-o = PROPOSED GUARDRAIL
- YL = YELLOW LINE
- WL = WHITE LINE
- ⊙ = TYPE I DELINEATOR, WHITE

PAVING LAYOUT 17

PROJECT NAME: ROCKINGHAM-CHESTER  
 PROJECT NUMBER: NH 2628(I)

FILE NAME: 06B224  
 PROJECT LEADER: PTS  
 DESIGNED BY: NLL  
 IPARM FILE NAME: pb2241a17.i

PLOT DATE: 31-AUG-2012 14:02  
 DRAWN BY: MRS  
 CHECKED BY: PTS  
 SHEET 31 OF 82

NOT TO SCALE