

TEMPORARY 4" WHITE LINE, PAINT
 DURABLE 4" WHITE LINE, THERMOPLASTIC
 196+50 TO 207+50 SOLID LT & RT

TEMPORARY 4" YELLOW LINE, PAINT
 DURABLE 4" YELLOW LINE, THERMOPLASTIC
 196+50 TO 201+80 SOLID LT, DASHED RT
 201+80 TO 207+50 DASHED RT


REMOVAL AND DISPOSAL OF GUARDRAIL
 196+50.0 TO 197+96.0 RT
 203+78.0 TO 207+50.0 RT
 206+41.0 TO 207+50.0 LT

BITUMINOUS CONCRETE
 CURB, TYPE A
 204+50 TO 207+50 RT

REMOVING SIGNS
 AS SHOWN - 3

STEEL BEAM GUARDRAIL, GALVANIZED
 196+50.0 TO 197+58.5 RT
 204+14.5 TO 207+50.0 RT
 206+77.5 TO 207+50.0 LT

MANUFACTURED TERMINAL SECTION, FLARED
 DELINEATOR WITH STEEL POST
 197+96.0 RT
 203+77.0 RT
 206+40.0 LT

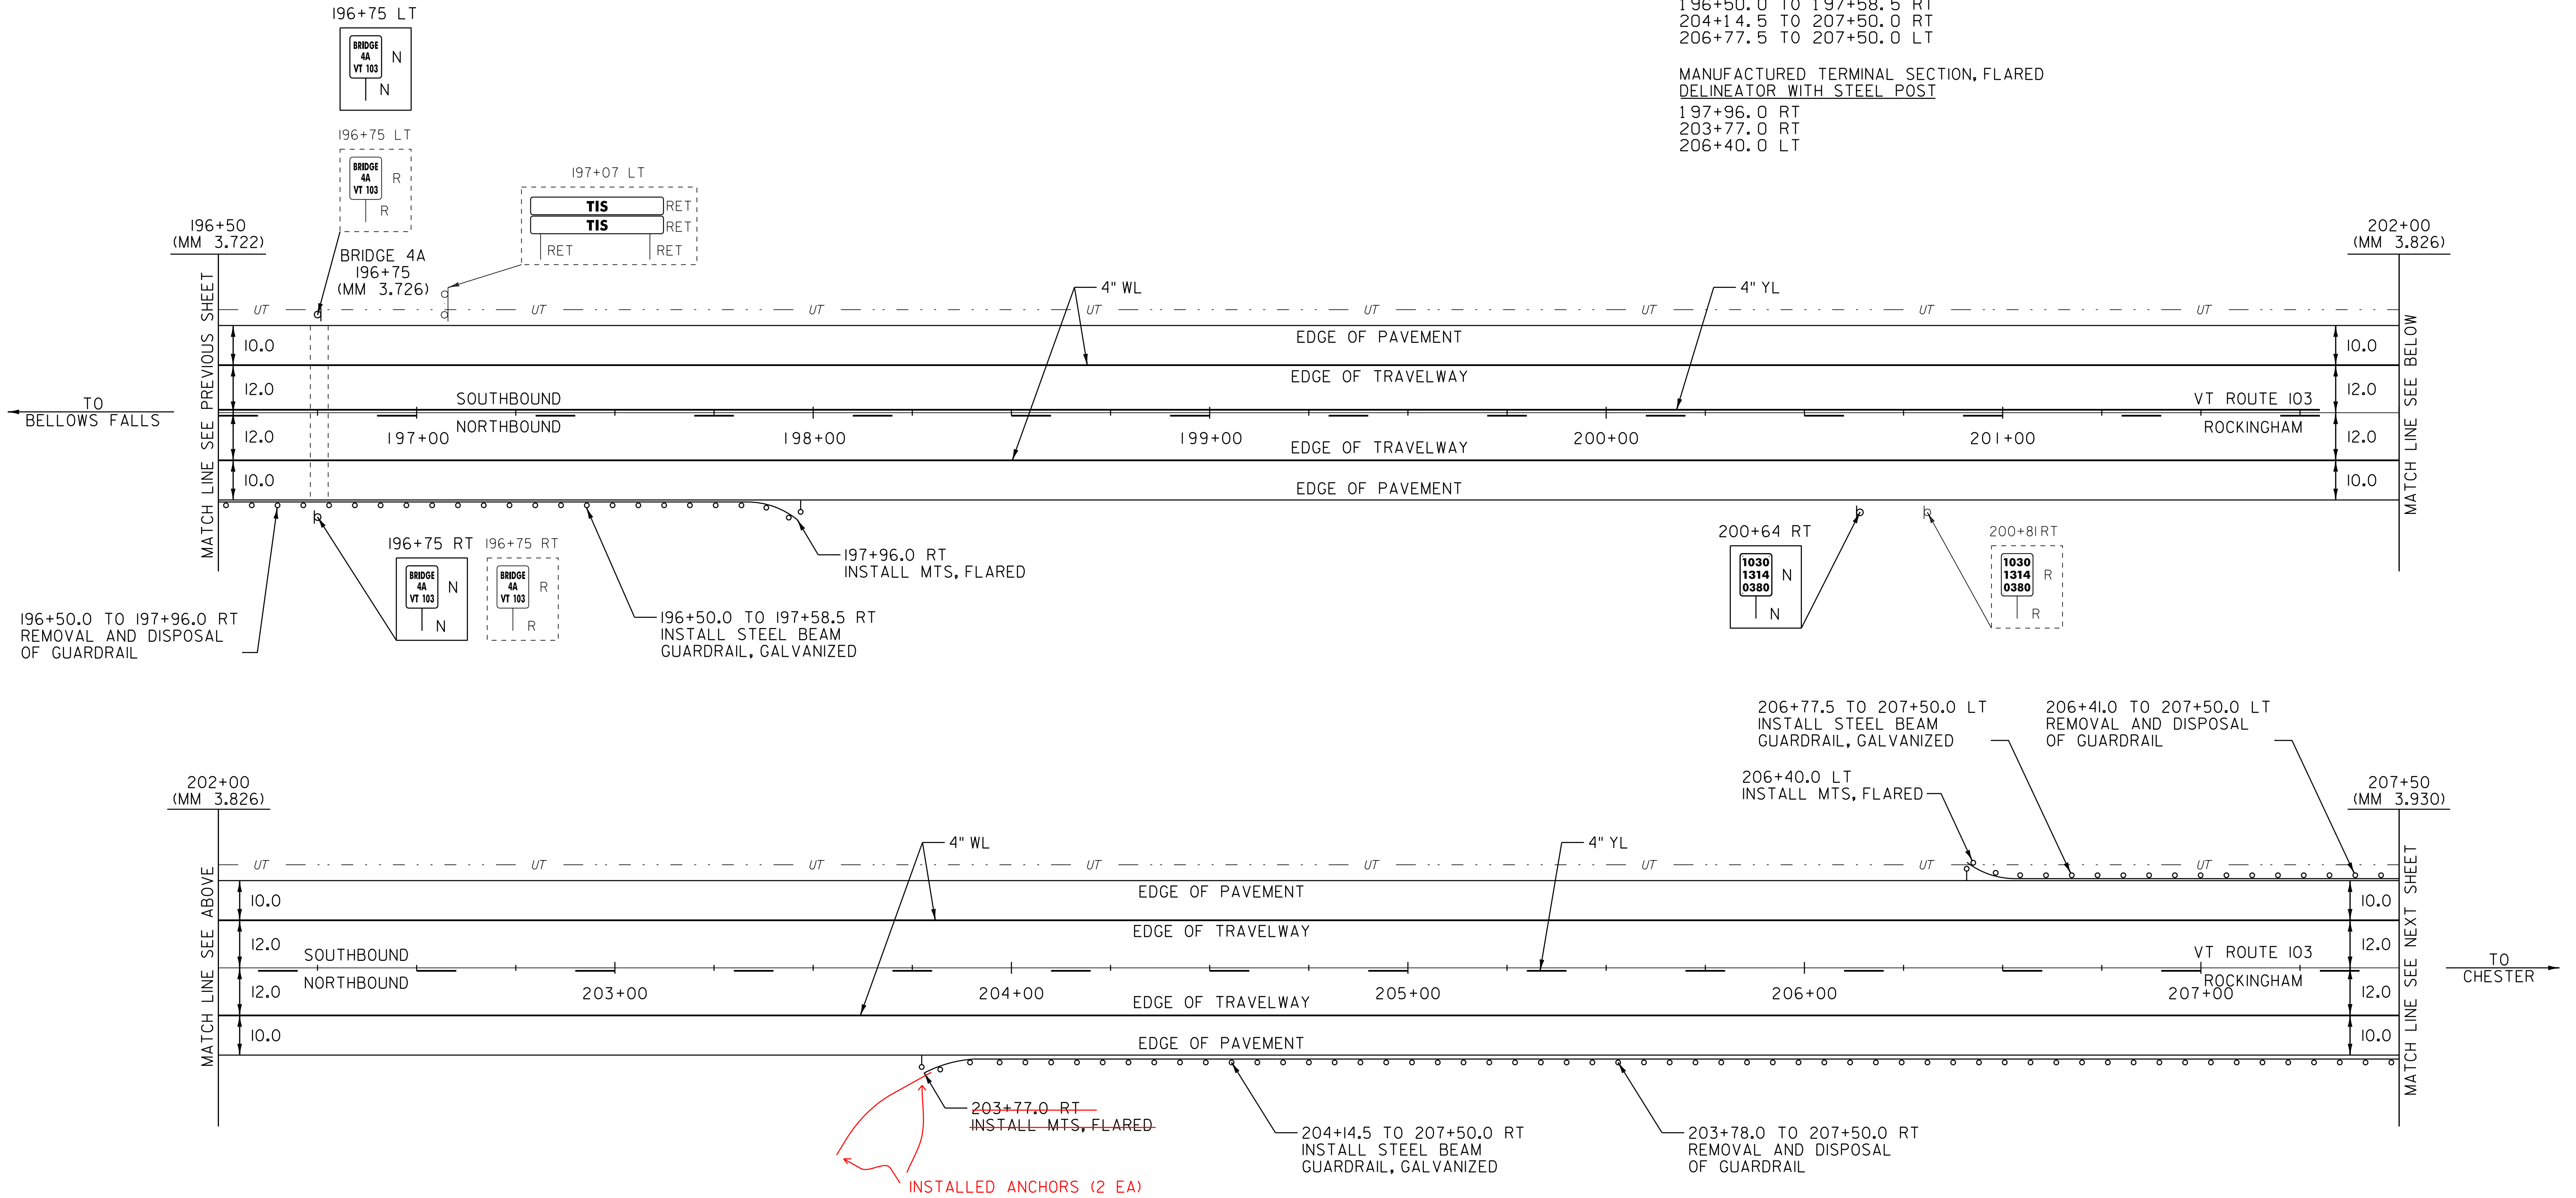

196+50.0 TO 197+96.0 RT
 REMOVAL AND DISPOSAL
 OF GUARDRAIL

196+50.0 TO 197+58.5 RT
 INSTALL STEEL BEAM
 GUARDRAIL, GALVANIZED

203+77.0 RT
 INSTALL MTS, FLARED
 INSTALLED ANCHORS (2 EA)

204+14.5 TO 207+50.0 RT
 INSTALL STEEL BEAM
 GUARDRAIL, GALVANIZED

206+77.5 TO 207+50.0 LT
 INSTALL STEEL BEAM
 GUARDRAIL, GALVANIZED

206+41.0 TO 207+50.0 LT
 REMOVAL AND DISPOSAL
 OF GUARDRAIL

206+40.0 LT
 INSTALL MTS, FLARED

203+78.0 TO 207+50.0 RT
 REMOVAL AND DISPOSAL
 OF GUARDRAIL

LEGEND

- R = REMOVE EXISTING
- S = SALVAGE
- R&S = REMOVE AND SALVAGE
- N = NEW
- RET = RETAIN
- B-B = BACK TO BACK
- = EXISTING GUARDRAIL
- o-o = PROPOSED GUARDRAIL
- YL = YELLOW LINE
- WL = WHITE LINE
- ⊙ = TYPE I DELINEATOR, WHITE

PAVING LAYOUT 23

PROJECT NAME: ROCKINGHAM-CHESTER
 PROJECT NUMBER: NH 2628(I)

FILE NAME: 06B224
 PROJECT LEADER: PTS
 DESIGNED BY: NLL
 IPARM FILE NAME: pb224la23.i

PLOT DATE: 31-AUG-2012 14:02
 DRAWN BY: MRS
 CHECKED BY: PTS
 SHEET 37 OF 82

NOT TO SCALE