
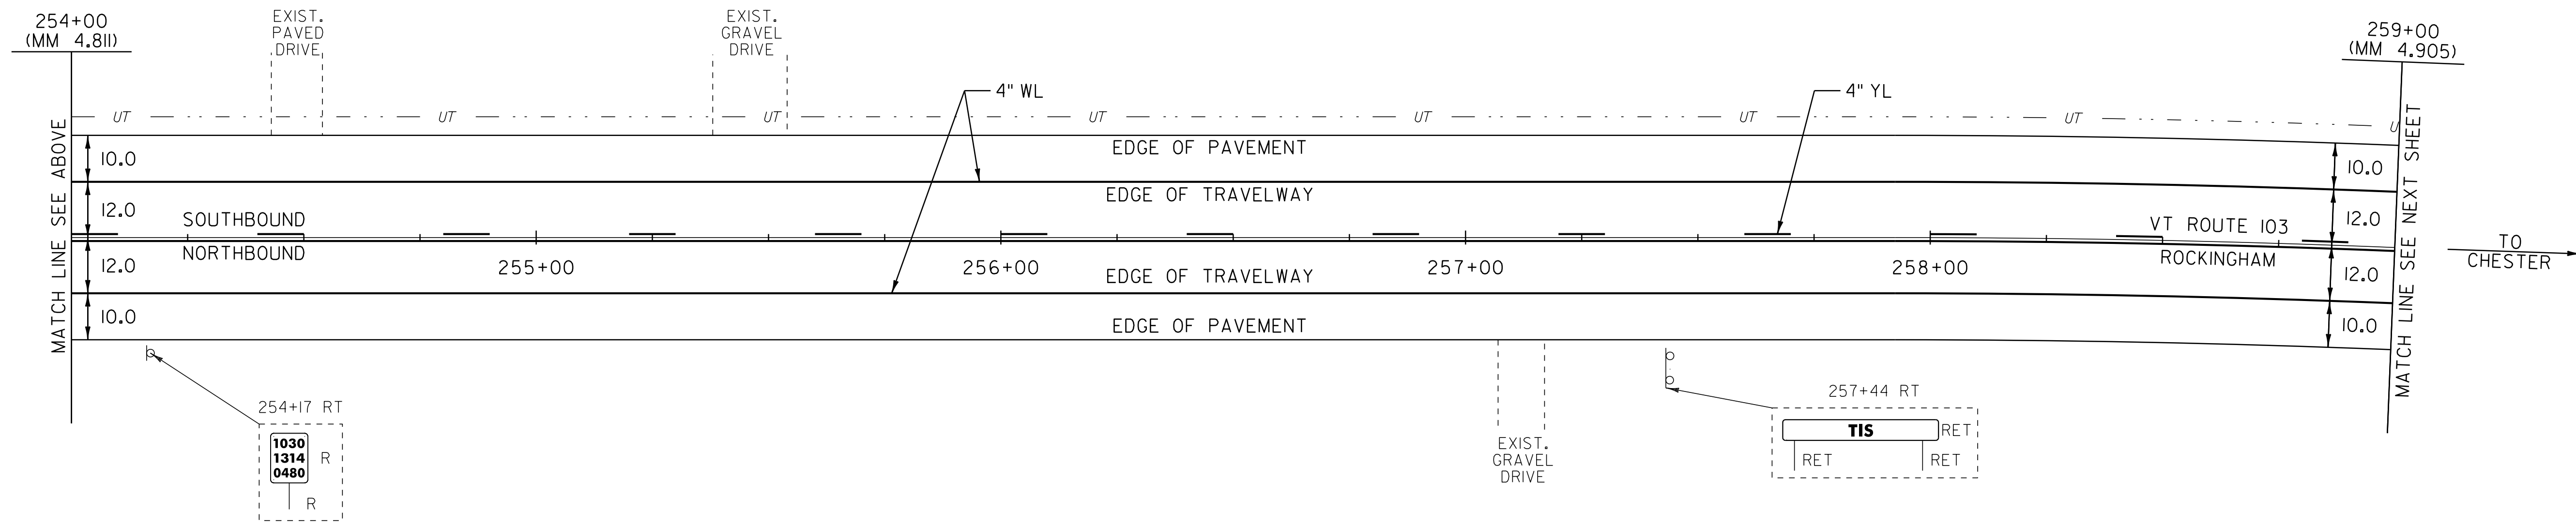


TEMPORARY 4" WHITE LINE, PAINT
 DURABLE 4" WHITE LINE, THERMOPLASTIC
 249+00 TO 259+00 SOLID LT & RT

TEMPORARY 4" YELLOW LINE, PAINT
 DURABLE 4" YELLOW LINE, THERMOPLASTIC
 249+00 TO 249+20 SOLID LT, DASHED RT
 249+20 TO 252+90 DASHED RT
 252+90 TO 259+00 DASHED LT, SOLID RT

REMOVING SIGNS
 AS SHOWN - 1

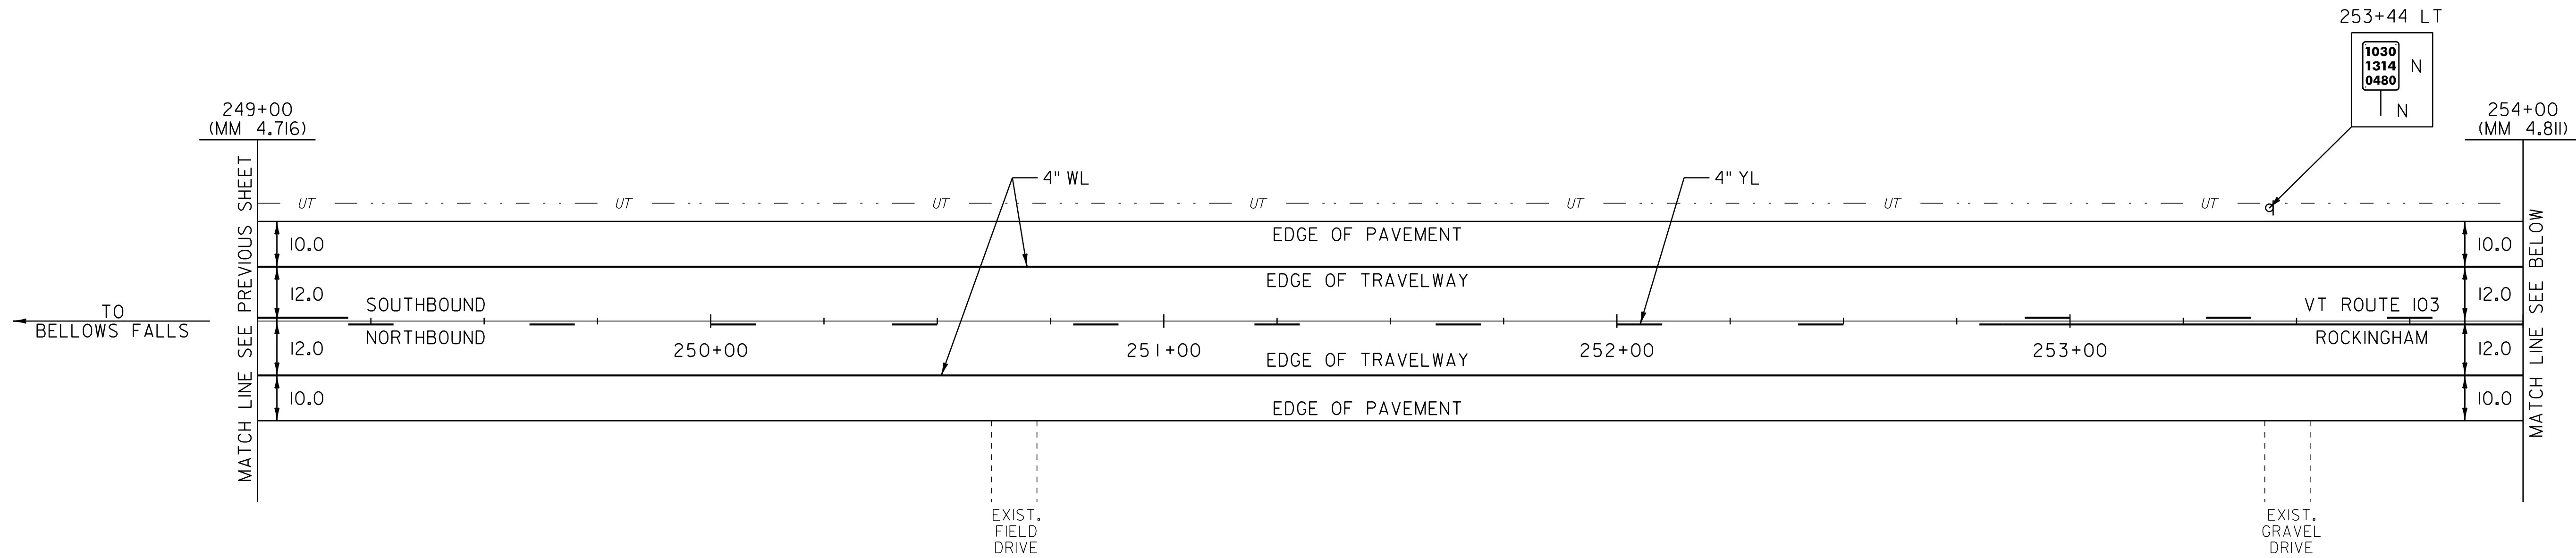

- LEGEND**
- R = REMOVE EXISTING
 - S = SALVAGE
 - R&S = REMOVE AND SALVAGE
 - N = NEW
 - RET = RETAIN
 - B-B = BACK TO BACK
 - = EXISTING GUARDRAIL
 - = PROPOSED GUARDRAIL
 - YL = YELLOW LINE
 - WL = WHITE LINE
 - ⊙ = TYPE I DELINEATOR, WHITE

NOT TO SCALE

PAVING LAYOUT 28

PROJECT NAME: ROCKINGHAM-CHESTER
 PROJECT NUMBER: NH 2628(I)

FILE NAME: 06B224
 PROJECT LEADER: PTS
 DESIGNED BY: NLL
 IPARM FILE NAME: pb224ia28.i

PLOT DATE: 31-AUG-2012 14:03
 DRAWN BY: MRS
 CHECKED BY: PTS
 SHEET 42 OF 82