

TEMPORARY 4" WHITE LINE, PAINT  
 DURABLE 4" WHITE LINE, THERMOPLASTIC  
 280+00 TO 282+98 SOLID RT  
 280+00 TO 291+00 SOLID LT  
 282+98 TO 283+47 SOLID RT (TH 8)  
 283+99 TO 284+28 SOLID RT (TH 8)  
 284+28 TO 291+00 SOLID RT


TEMPORARY 4" YELLOW LINE, PAINT  
 DURABLE 4" YELLOW LINE, THERMOPLASTIC  
 280+00 TO 282+25 DASHED LT, SOLID RT  
 282+25 TO 283+52 SOLID LT & RT  
 283+72 DOUBLE SOLID RT (TH 8)  
 283+92 TO 291+00 SOLID LT & RT

TEMPORARY LETTER OR SYMBOL, PAINT  
 DURABLE LETTER OR SYMBOL, THERMOPLASTIC  
 283+86 RT - "STOP" (TH 8)  
 TEMPORARY 24" STOP BAR, PAINT  
 DURABLE 24" STOP BAR, THERMOPLASTIC  
 283+72 TO 284+03 RT (TH 8)

REMOVAL AND DISPOSAL OF GUARDRAIL  
 280+00.0 TO 283+25.0 RT  
 284+20.0 TO 291+00.0 RT  
 284+78.0 TO 288+63.0 LT  
 STEEL BEAM GUARDRAIL, GALVANIZED  
 280+00.0 TO 283+33.0 RT  
 284+57.5 TO 291+00.0 RT  
 285+13.0 TO 288+25.5 LT

BITUMINOUS CONCRETE  
 CURB, TYPE A  
 285+09 TO 287+63 LT

REMOVING SIGNS  
 AS SHOWN - 5  
 ERECTING SALVAGED SIGNS  
 AS SHOWN - 1

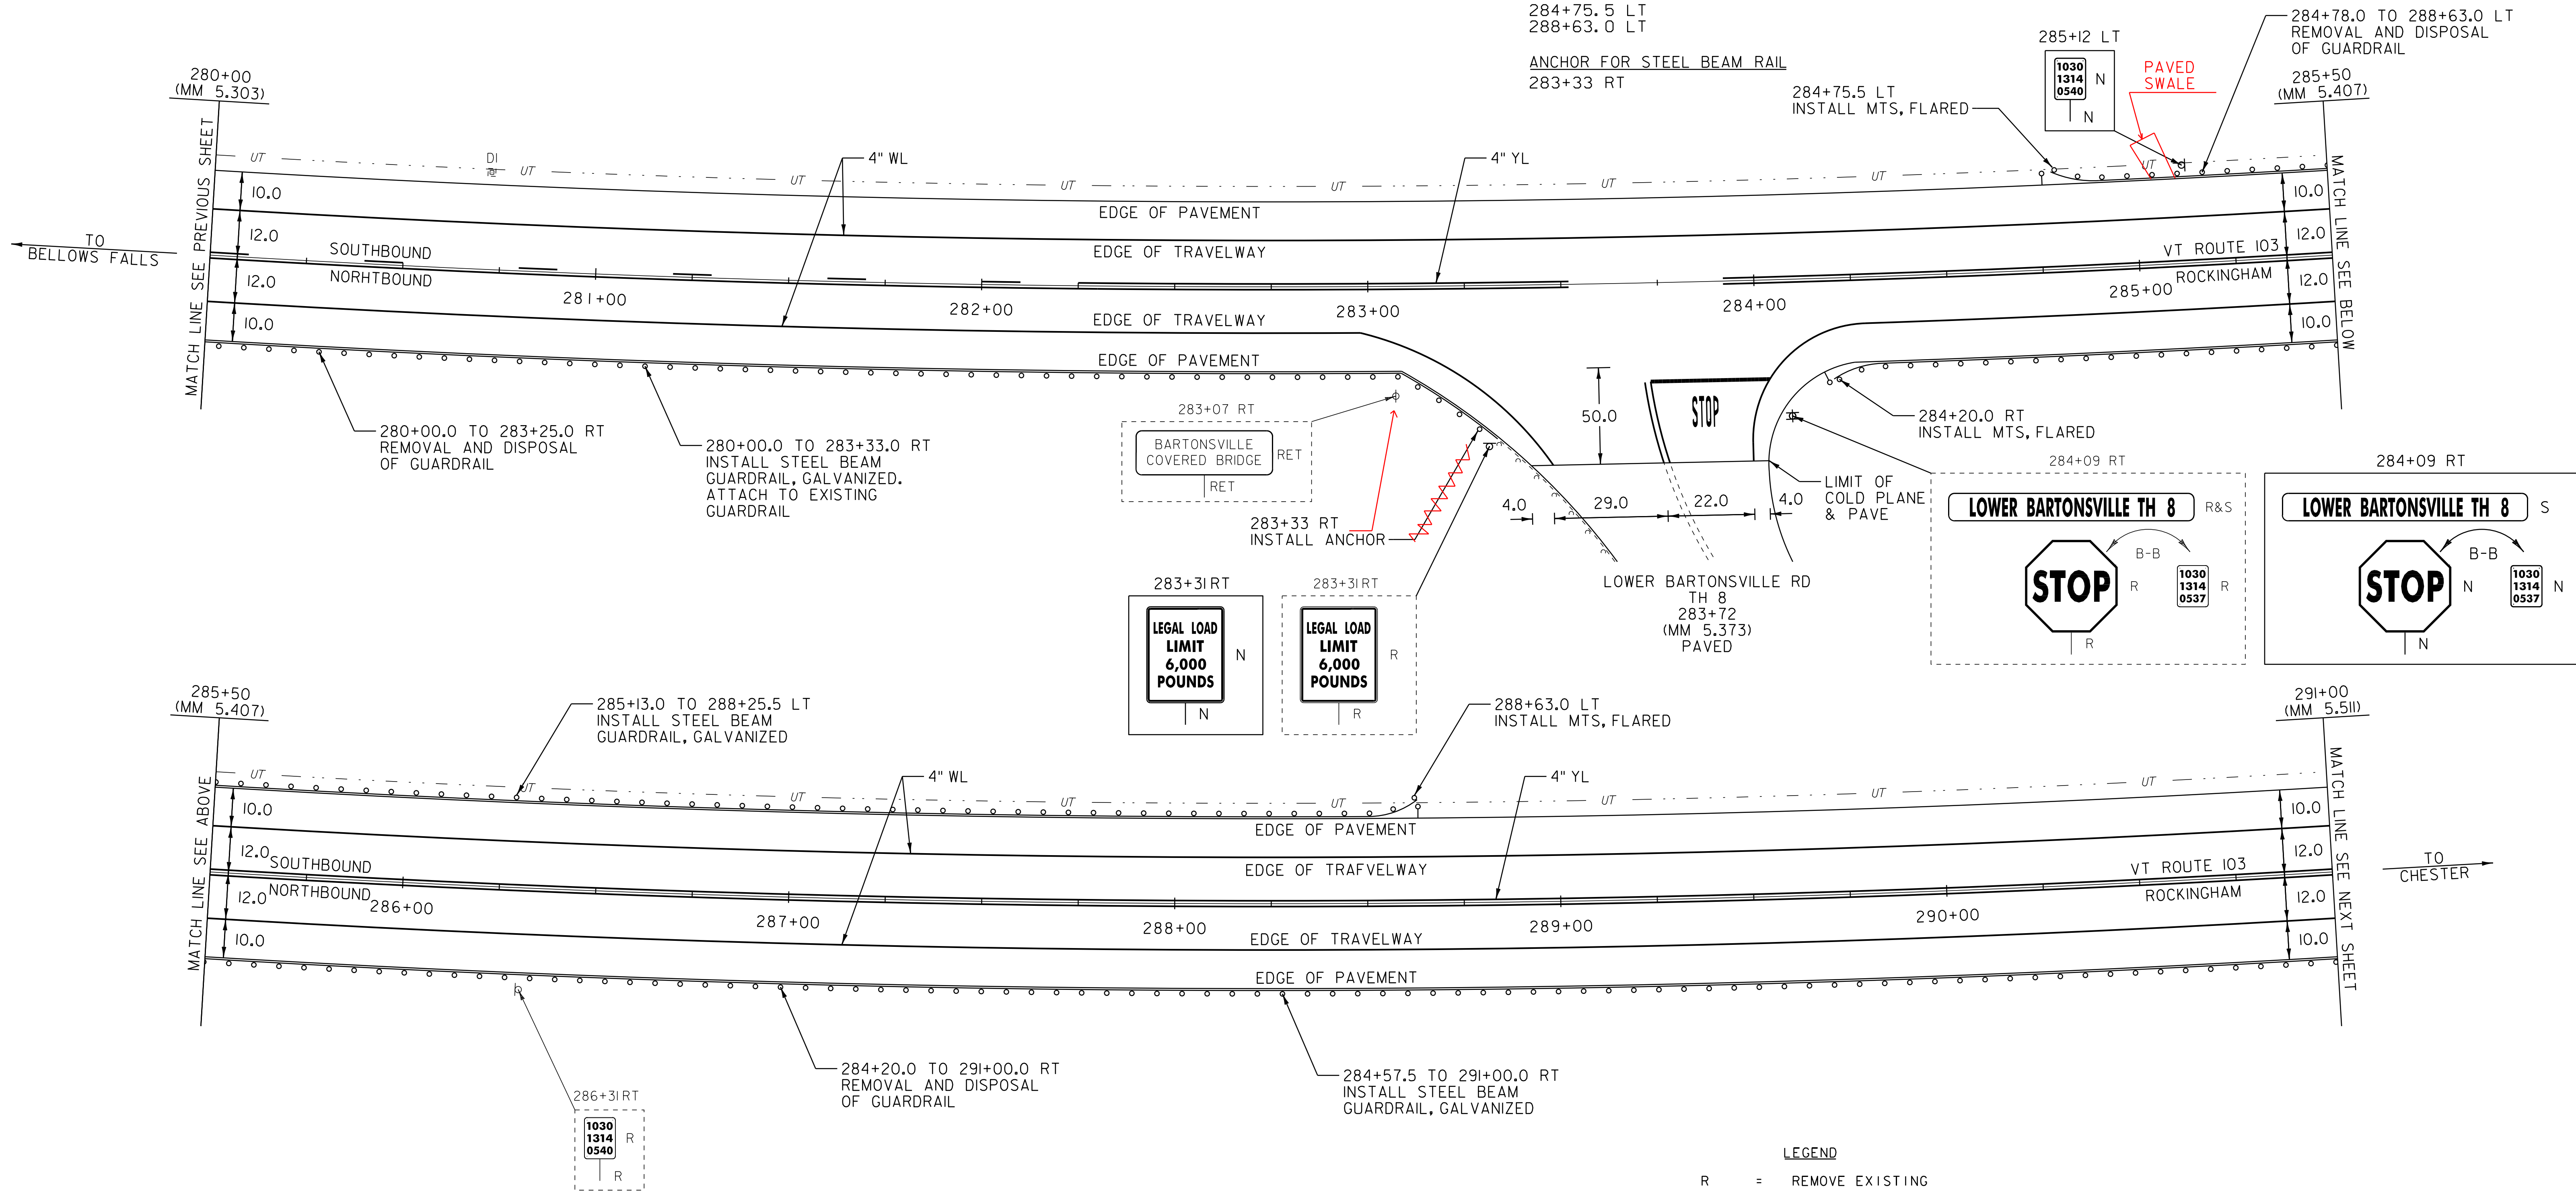

LEGEND

- R = REMOVE EXISTING
- S = SALVAGE
- R&S = REMOVE AND SALVAGE
- N = NEW
- RET = RETAIN
- B-B = BACK TO BACK
- = EXISTING GUARDRAIL
- o-o = PROPOSED GUARDRAIL
- YL = YELLOW LINE
- WL = WHITE LINE
- ⊙ = TYPE I DELINEATOR, WHITE

PAVING LAYOUT 31

PROJECT NAME: ROCKINGHAM-CHESTER  
 PROJECT NUMBER: NH 2628(1)

FILE NAME: 06B224  
 PROJECT LEADER: PTS  
 DESIGNED BY: NLL  
 IPARM FILE NAME: pb2241a31.i

PLOT DATE: 31-AUG-2012 14:03  
 DRAWN BY: MRS  
 CHECKED BY: PTS  
 SHEET 45 OF 82

NOT TO SCALE