

TEMPORARY 4" WHITE LINE, PAINT
 DURABLE 4" WHITE LINE, THERMOPLASTIC
 291+00 TO 302+00 SOLID LT & RT

TEMPORARY 4" YELLOW LINE, PAINT
 DURABLE 4" YELLOW LINE, THERMOPLASTIC
 291+00 TO 295+30 SOLID LT & RT
 295+30 TO 302+00 SOLID LT, DASHED RT

REMOVAL AND DISPOSAL OF GUARDRAIL
 291+00.0 TO 293+06.0 RT
 296+81.0 TO 302+00.0 RT
 299+29.0 TO 302+00.0 LT

BITUMINOUS CONCRETE
 CURB, TYPE A
 299+55 TO 302+00 LT


REMOVING SIGNS
 AS SHOWN - 2

STEEL BEAM GUARDRAIL, GALVANIZED

291+00.0 TO 292+70.0 RT
 297+15.5 TO 302+00.0 RT
 299+70.0 TO 302+00.0 LT

MANUFACTURED TERMINAL SECTION, FLARED
 DELINEATOR WITH STEEL POST

293+07.5 RT
 296+78.0 RT
 299+32.5 LT

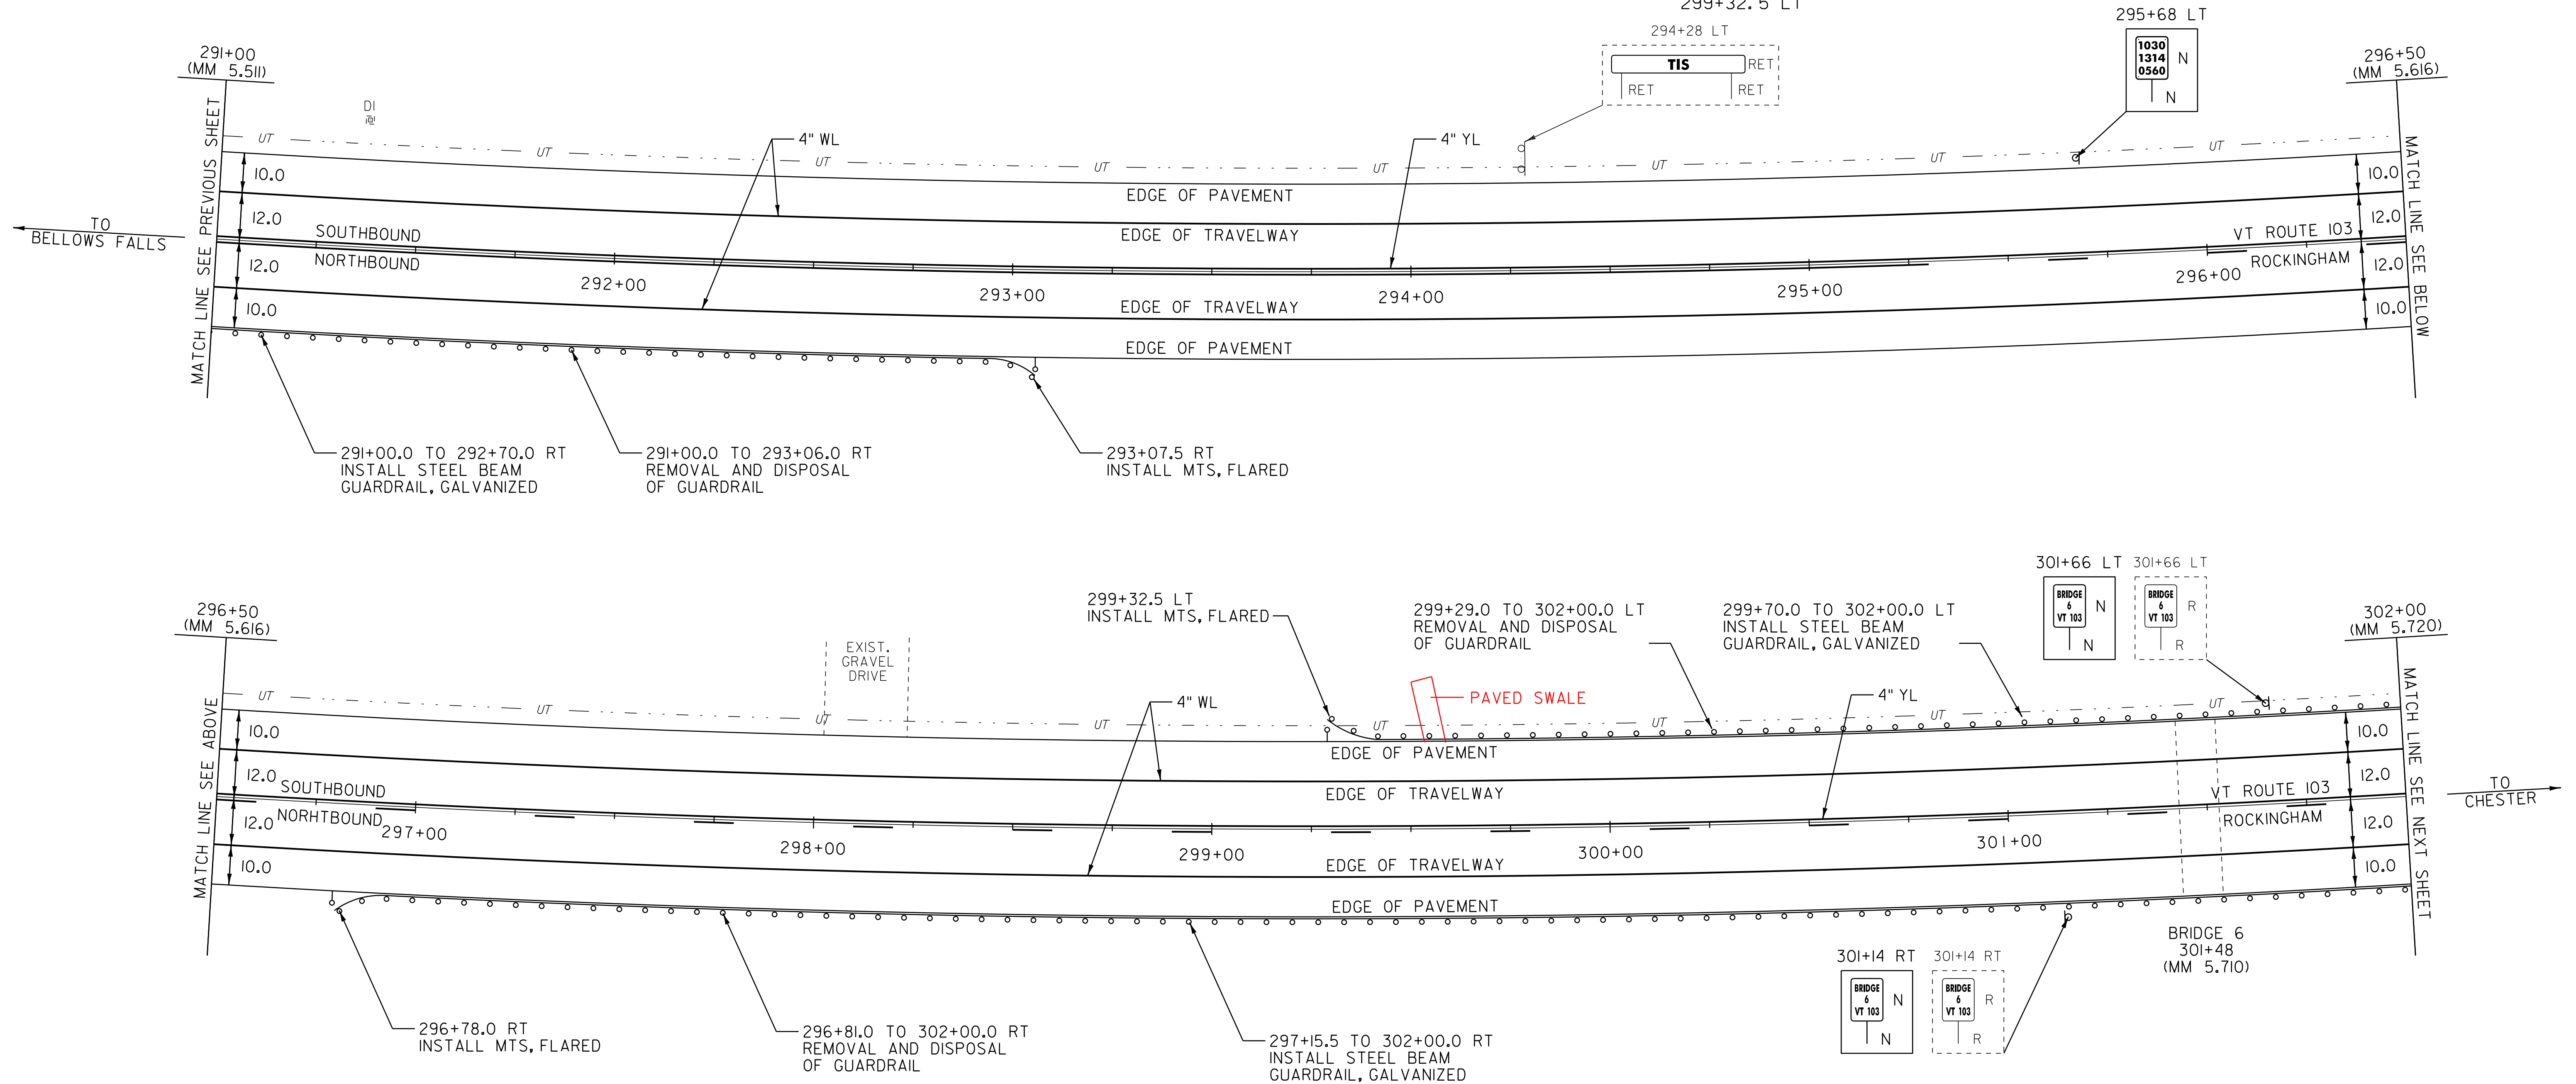

NOT TO SCALE

PAVING LAYOUT 32

PROJECT NAME: ROCKINGHAM-CHESTER
 PROJECT NUMBER: NH 2628(1)

FILE NAME: 06B224
 PROJECT LEADER: PTS
 DESIGNED BY: NLL
 IPARM FILE NAME: pb2241a32.i

PLOT DATE: 31-AUG-2012 14:03
 DRAWN BY: MRS
 CHECKED BY: PTS
 SHEET 46 OF 82