

TEMPORARY 4" WHITE LINE, PAINT  
 DURABLE 4" YELLOW LINE, THERMOPLASTIC  
 302+00 TO 311+96 SOLID LT  
 302+00 TO 313+00 SOLID RT  
 311+96 TO 312+26 SOLID LT (TH 81)  
 312+48 TO 312+78 SOLID LT (TH 81)  
 312+78 TO 313+00 SOLID LT

TEMPORARY 4" YELLOW LINE, PAINT  
 DURABLE 4" YELLOW LINE, THERMOPLASTIC  
 302+00 TO 303+20 SOLID LT, DASHED RT  
 303+20 TO 310+70 DASHED LT, SOLID RT  
 310+70 TO 312+17 SOLID LT & RT  
 312+37 DOUBLE SOLID LT (TH 81)  
 312+57 TO 313+00 SOLID LT & RT


TEMPORARY LETTER OR SYMBOL, PAINT  
 DURABLE LETTER OR SYMBOL, THERMOPLASTIC  
 312+30 LT - "STOP" (TH 81)  
 TEMPORARY 24" STOP BAR, PAINT  
 DURABLE 24" STOP BAR, THERMOPLASTIC  
 312+21 TO 312+37 LT (TH 81)

REMOVAL AND DISPOSAL OF GUARDRAIL  
 302+00.0 TO 302+90.0 RT  
 302+00.0 TO 305+20.0 LT  
 STEEL BEAM GUARDRAIL, GALVANIZED  
 302+00.0 TO 302+53.0 RT  
 302+00.0 TO 304+82.5 LT







BITUMINOUS CONCRETE CURB, TYPE A  
 302+00 TO 304+30 LT

REMOVING SIGNS AS SHOWN - 6  
 ERECTING SALVAGED SIGNS AS SHOWN - 1

MANUFACTURED TERMINAL SECTION, FLARED  
 DELINEATOR WITH STEEL POST  
 302+90.5 RT  
 305+20.0 LT

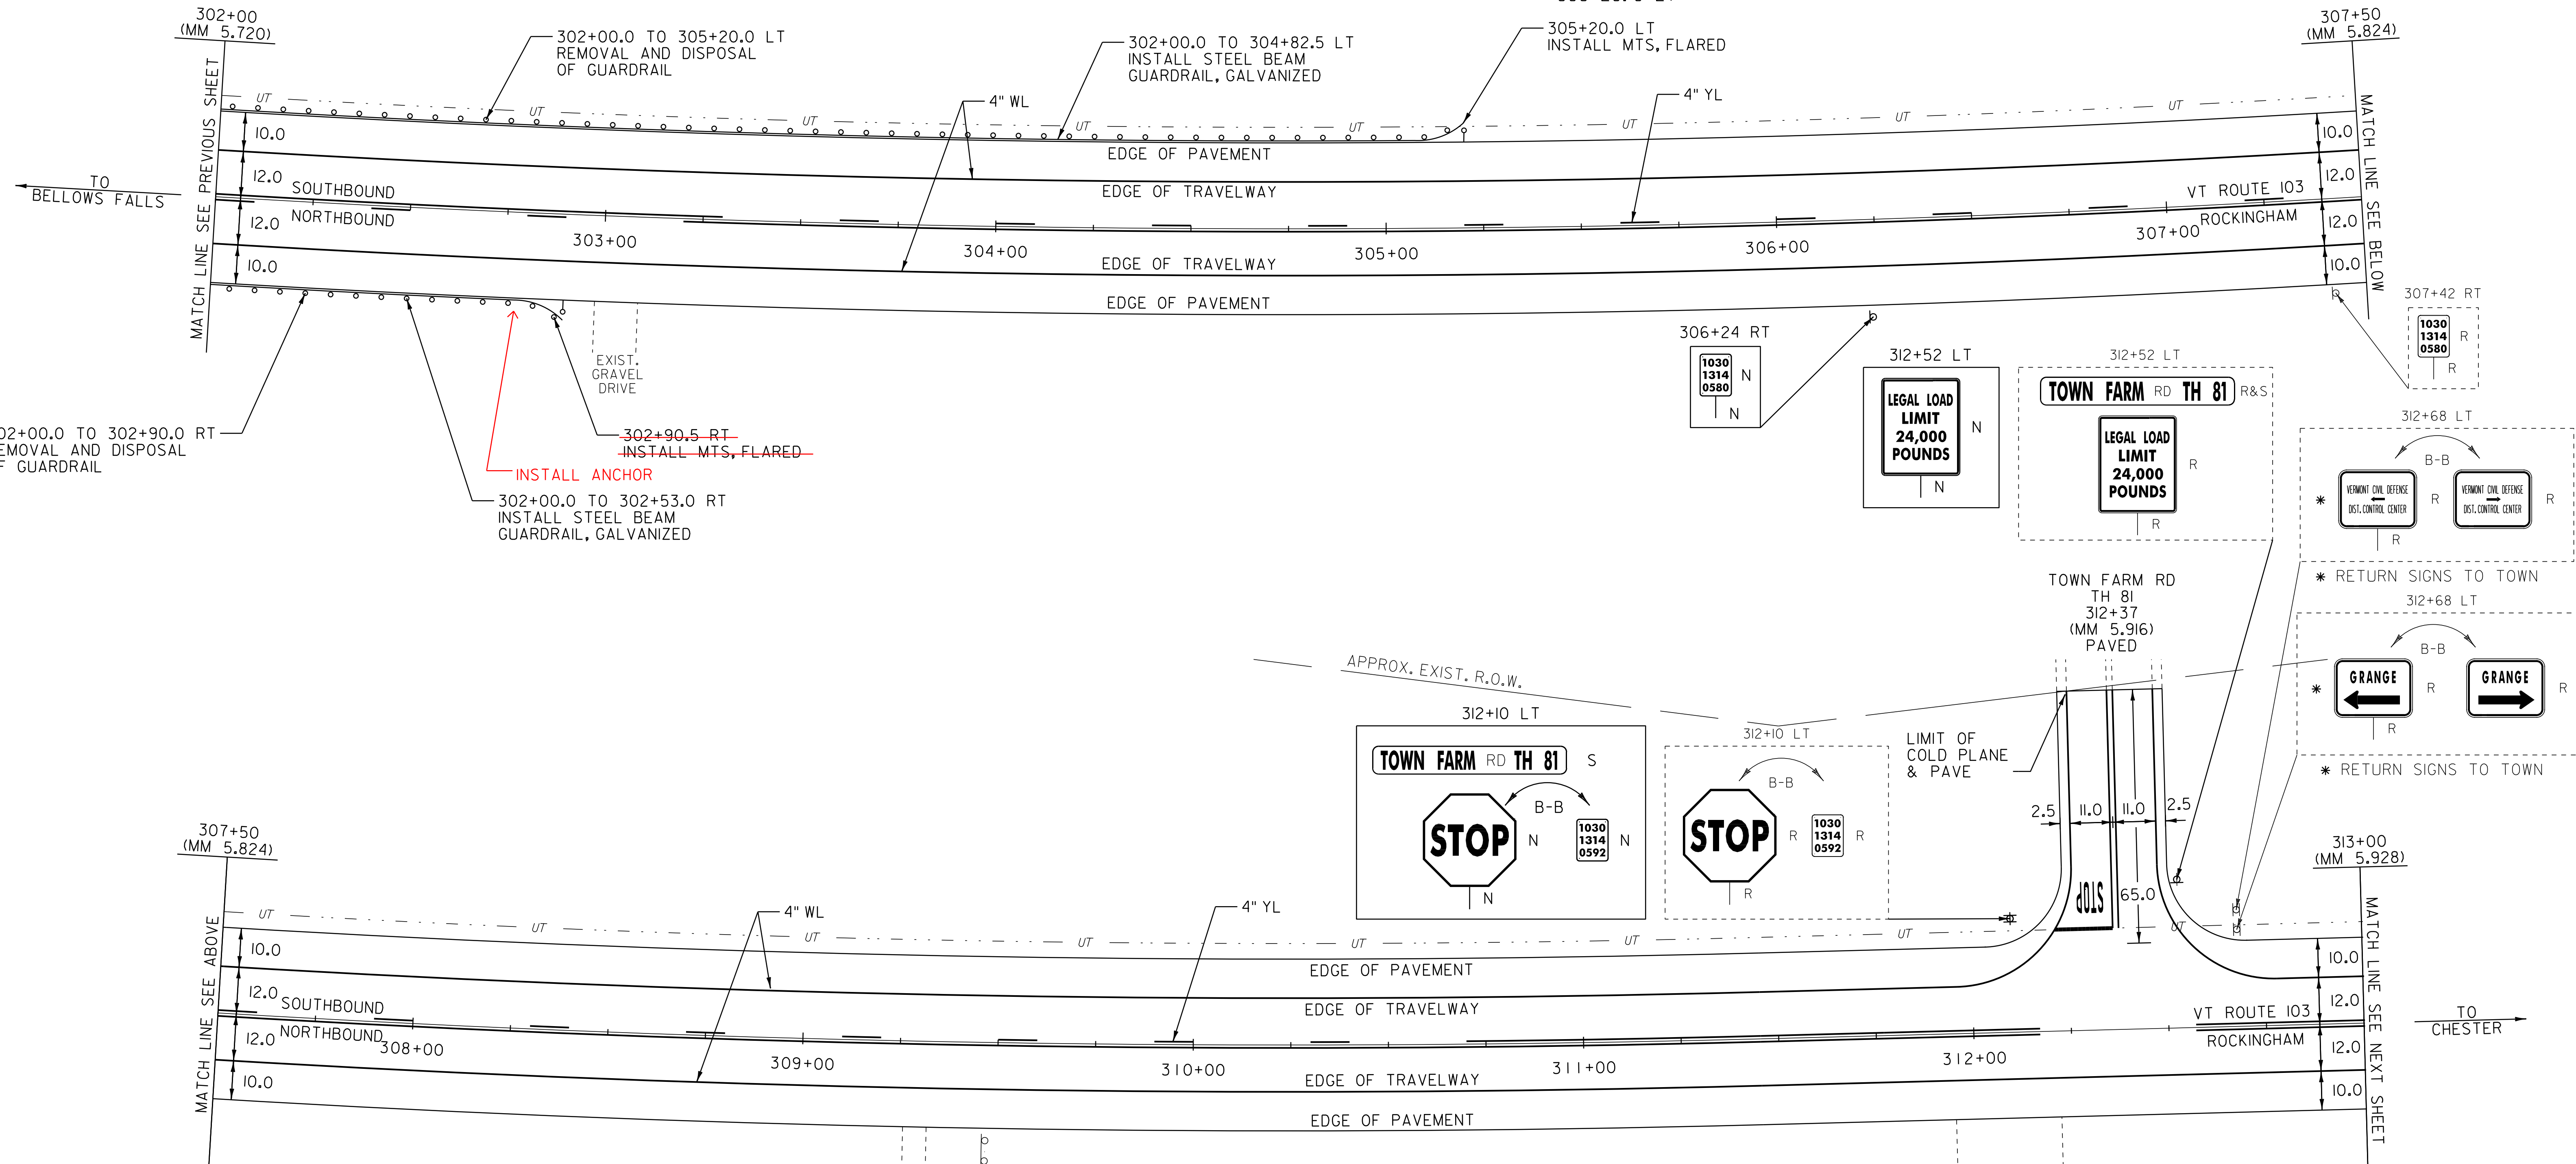

302+00.0 TO 302+90.0 RT  
 REMOVAL AND DISPOSAL  
 OF GUARDRAIL  
 302+90.5 RT  
 INSTALL MTS, FLARED  
 302+00.0 TO 302+53.0 RT  
 INSTALL STEEL BEAM  
 GUARDRAIL, GALVANIZED  
 302+00.0 TO 305+20.0 LT  
 REMOVAL AND DISPOSAL  
 OF GUARDRAIL  
 302+00.0 TO 304+82.5 LT  
 INSTALL STEEL BEAM  
 GUARDRAIL, GALVANIZED  
 305+20.0 LT  
 INSTALL MTS, FLARED

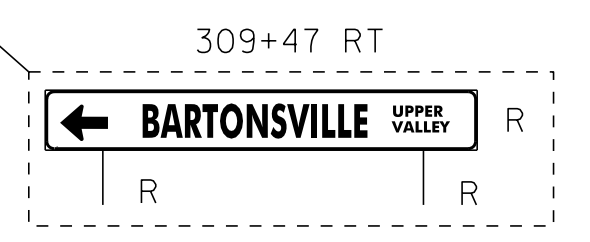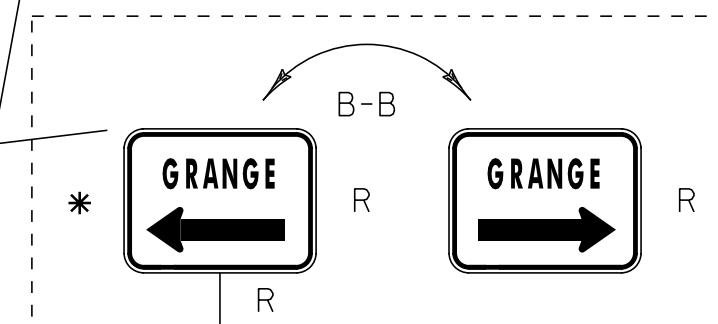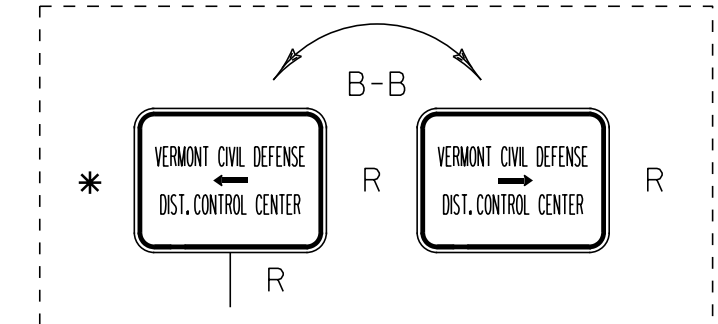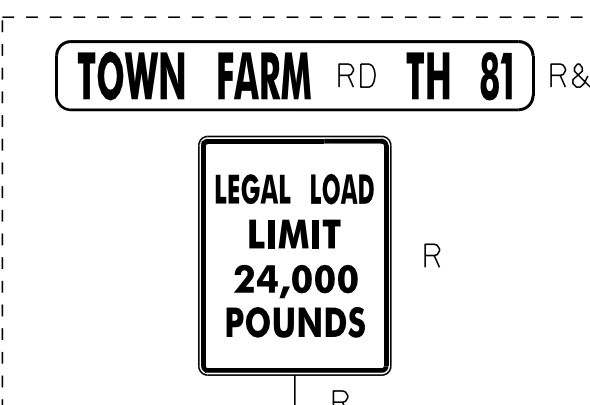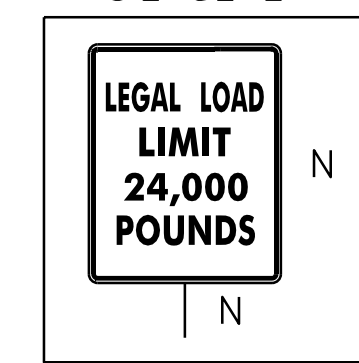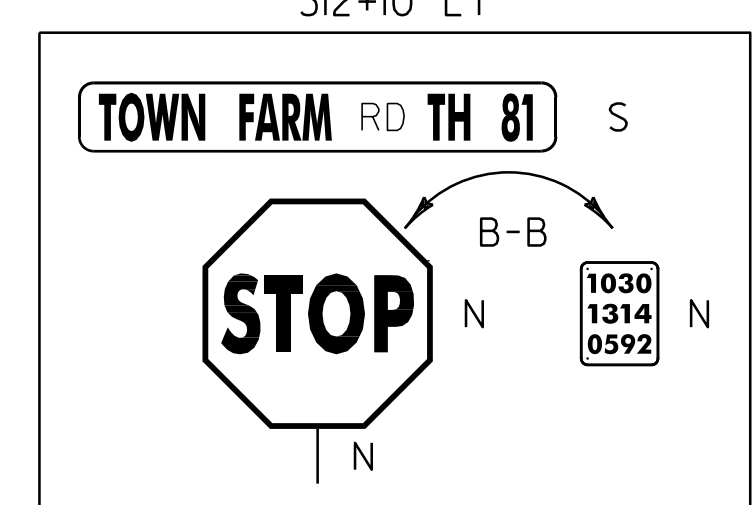

- LEGEND**
- R = REMOVE EXISTING
  - S = SALVAGE
  - R&S = REMOVE AND SALVAGE
  - N = NEW
  - RET = RETAIN
  - B-B = BACK TO BACK
  - = EXISTING GUARDRAIL
  - = PROPOSED GUARDRAIL
  - YL = YELLOW LINE
  - WL = WHITE LINE
  - ⊙ = TYPE I DELINEATOR, WHITE

VERMONT STATE POLICE

**PAVING LAYOUT 33**

PROJECT NAME: ROCKINGHAM-CHESTER  
 PROJECT NUMBER: NH 2628(I)

FILE NAME: 06B224  
 PROJECT LEADER: PTS  
 DESIGNED BY: NULL  
 IPARM FILE NAME: pb224ia33.i

PLOT DATE: 31-AUG-2012 14:03  
 DRAWN BY: MRS  
 CHECKED BY: PTS  
 SHEET 47 OF 82

NOT TO SCALE