

TEMPORARY 4" WHITE LINE, PAINT
 DURABLE 4" YELLOW LINE, THERMOPLASTIC
 313+00 TO 322+50 SOLID LT & RT

TEMPORARY 4" YELLOW LINE, PAINT
 DURABLE 4" YELLOW LINE, THERMOPLASTIC
 313+00 TO 322+10 SOLID LT, DASHED RT
 322+10 TO 322+50 DASHED RT

REMOVAL AND DISPOSAL OF GUARDRAIL
 318+17.0 TO 320+44.0 LT
 318+17.0 TO 322+13.0 RT

STEEL BEAM GUARDRAIL, GALVANIZED
 318+52.5 TO 322+40.0 RT
 318+55.5 TO 319+18.0 LT
 320+43.0 TO 320+93.0 LT


STEEL BEAM GUARDRAIL,
 GALVANIZED W/8' POSTS
 319+18.0 TO 320+43.0 LT

12" CSP .064 (2-2/3 X 1/2)
 320+68 TO 321+18 LT
 322+00 TO 322+50 RT

REMOVING SIGNS
 AS SHOWN - 4

MANUFACTURED TERMINAL SECTION, FLARED
 DELINEATOR WITH STEEL POST
 318+15 RT
 318+18 LT

ANCHOR FOR STEEL BEAM RAIL
 320+93 LT
 322+40 RT

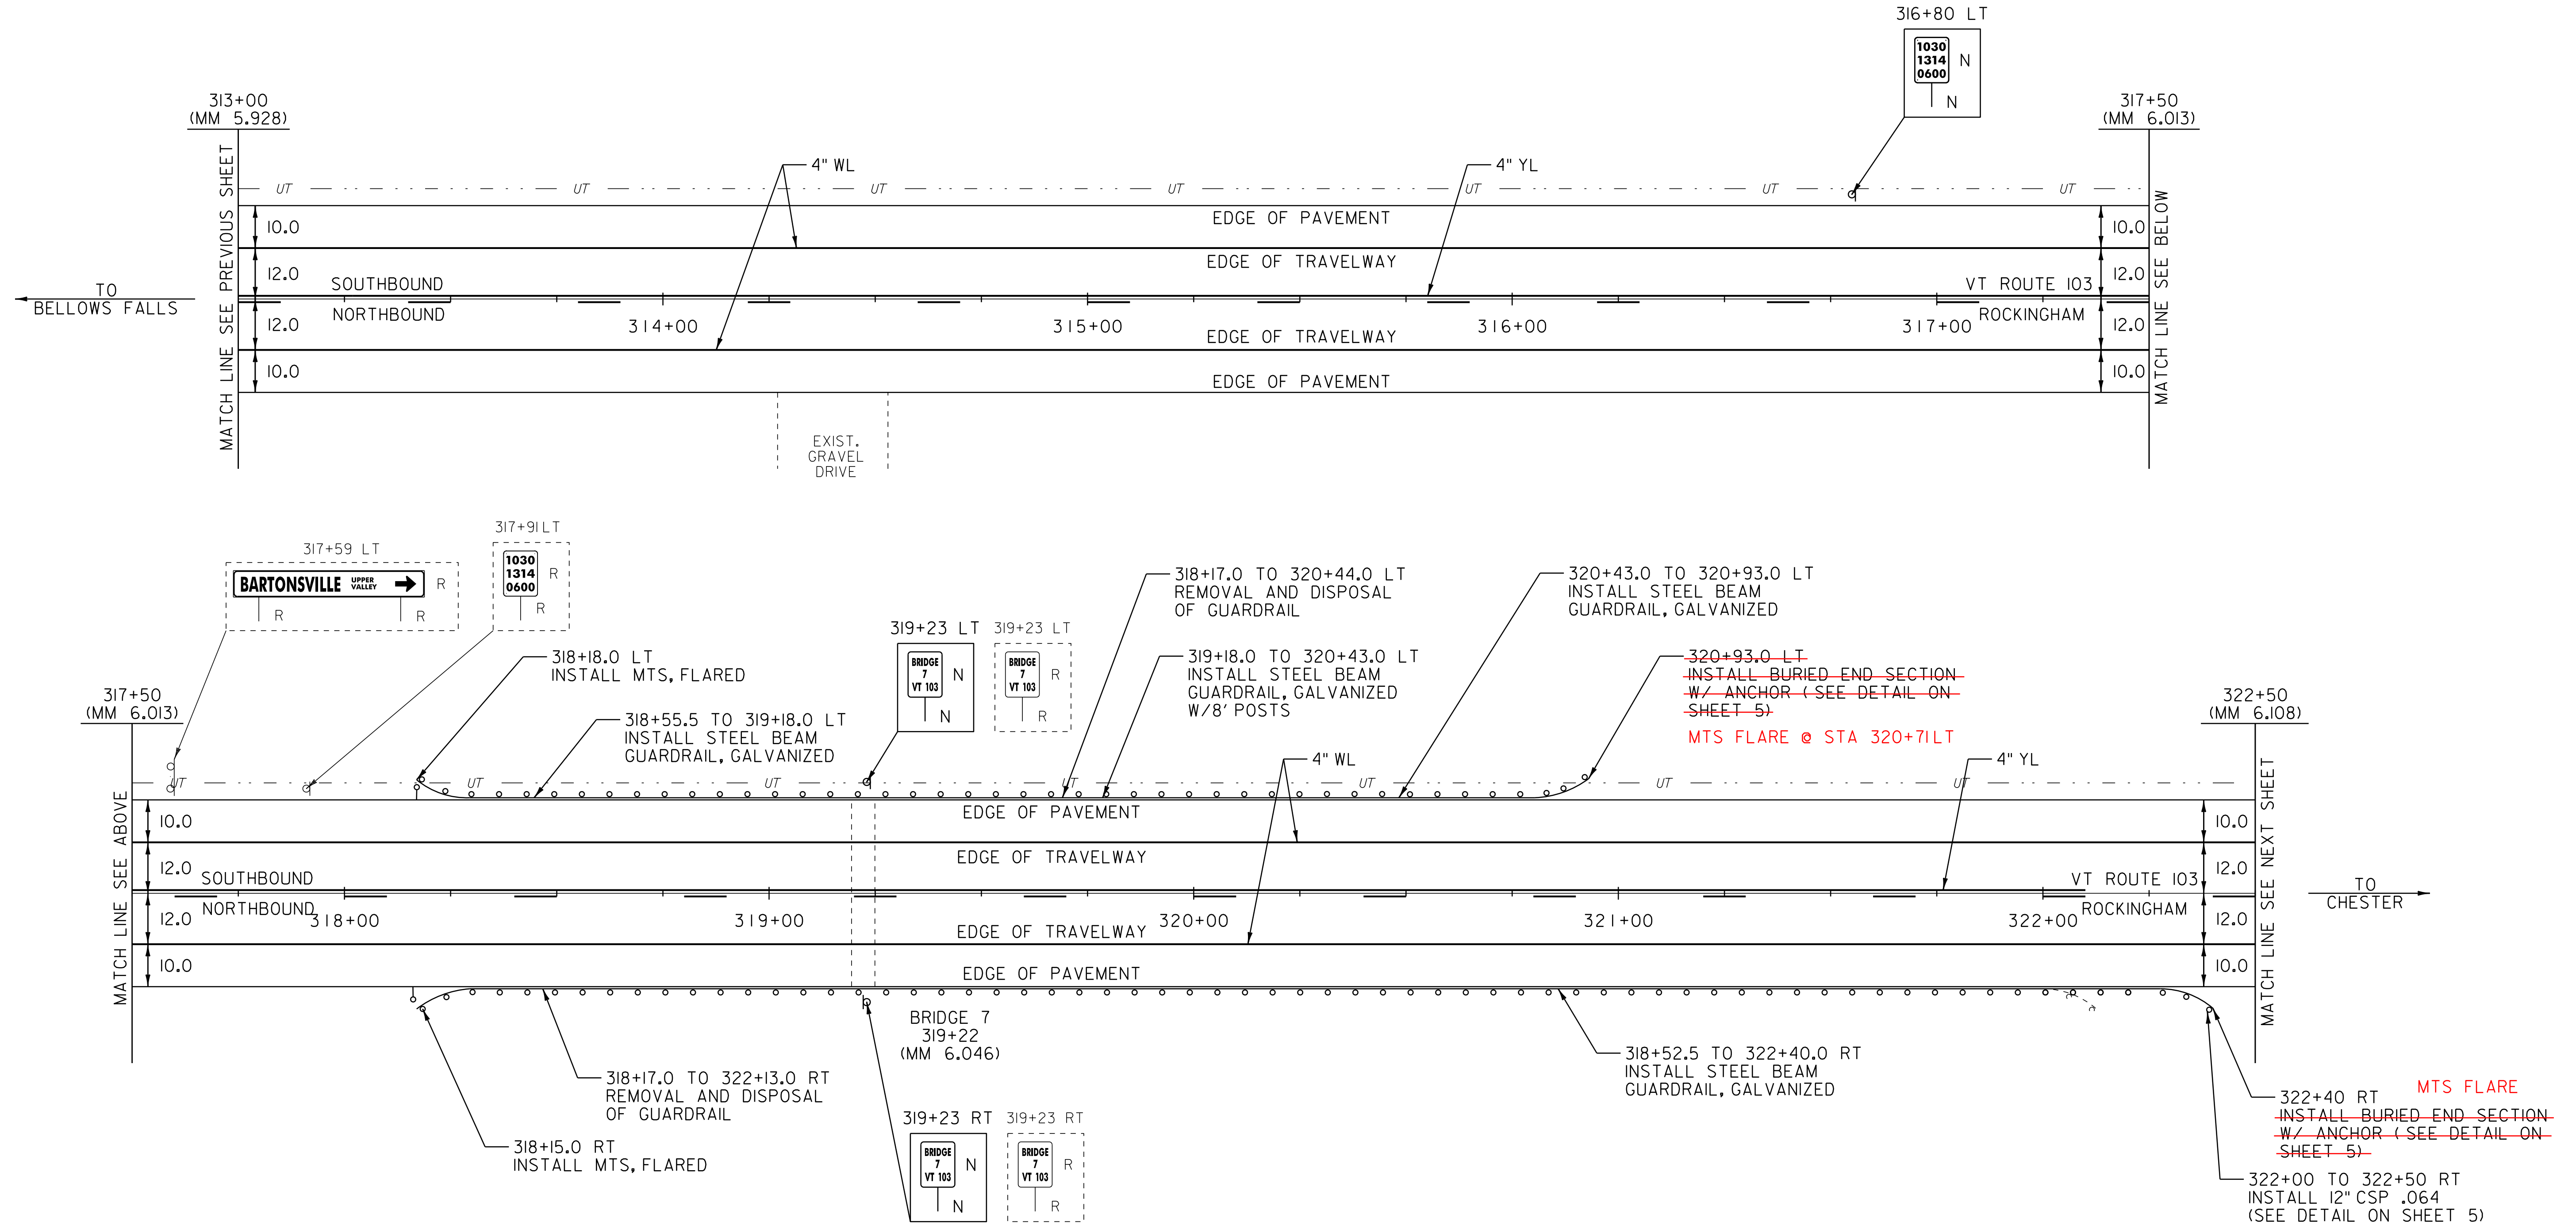

LEGEND

- R = REMOVE EXISTING
- S = SALVAGE
- R&S = REMOVE AND SALVAGE
- N = NEW
- RET = RETAIN
- B-B = BACK TO BACK
- = EXISTING GUARDRAIL
- = PROPOSED GUARDRAIL
- YL = YELLOW LINE
- WL = WHITE LINE
- ⊙ = TYPE I DELINEATOR, WHITE

NOT TO SCALE

PAVING LAYOUT 34

PROJECT NAME: ROCKINGHAM-CHESTER
 PROJECT NUMBER: NH 2628(1)

FILE NAME: 06B224
 PROJECT LEADER: PTS
 DESIGNED BY: NLL
 IPARM FILE NAME: pb2241a34.i

PLOT DATE: 31-AUG-2012 14:03
 DRAWN BY: MRS
 CHECKED BY: PTS
 SHEET 48 OF 82