


TEMPORARY 4" WHITE LINE, PAINT
 DURABLE 4" WHITE LINE, THERMOPLASTIC
 333+50 TO 335+95 SOLID LT
 333+50 TO 344+50 SOLID RT
 335+95 TO 336+25 SOLID LT (TH 12)
 336+49 TO 336+79 SOLID LT (TH 12)
 336+79 TO 344+50 SOLID LT

TEMPORARY 4" YELLOW LINE, PAINT
 DURABLE 4" YELLOW LINE, THERMOPLASTIC
 333+50 TO 335+50 DASHED LT, SOLID RT
 335+50 TO 336+17 SOLID LT & RT
 336+37 DOUBLE SOLID LT (TH 12)
 336+57 TO 344+50 SOLID LT & RT

TEMPORARY LETTER OR SYMBOL, PAINT
 DURABLE LETTER OR SYMBOL, THERMOPLASTIC
 336+30 LT - "STOP" (TH 12)
 TEMPORARY 24" STOP BAR, PAINT
 DURABLE 24" STOP BAR, THERMOPLASTIC
 336+20 TO 336+37 LT (TH 12)

REMOVAL AND DISPOSAL OF GUARDRAIL
 344+23 TO 344+50 RT
 MANUFACTURED TERMINAL SECTION, TANGENT
 344+22.5 RT

REMOVING SIGNS
 AS SHOWN - 6
 ERECTING SALVAGED SIGNS
 AS SHOWN - 1

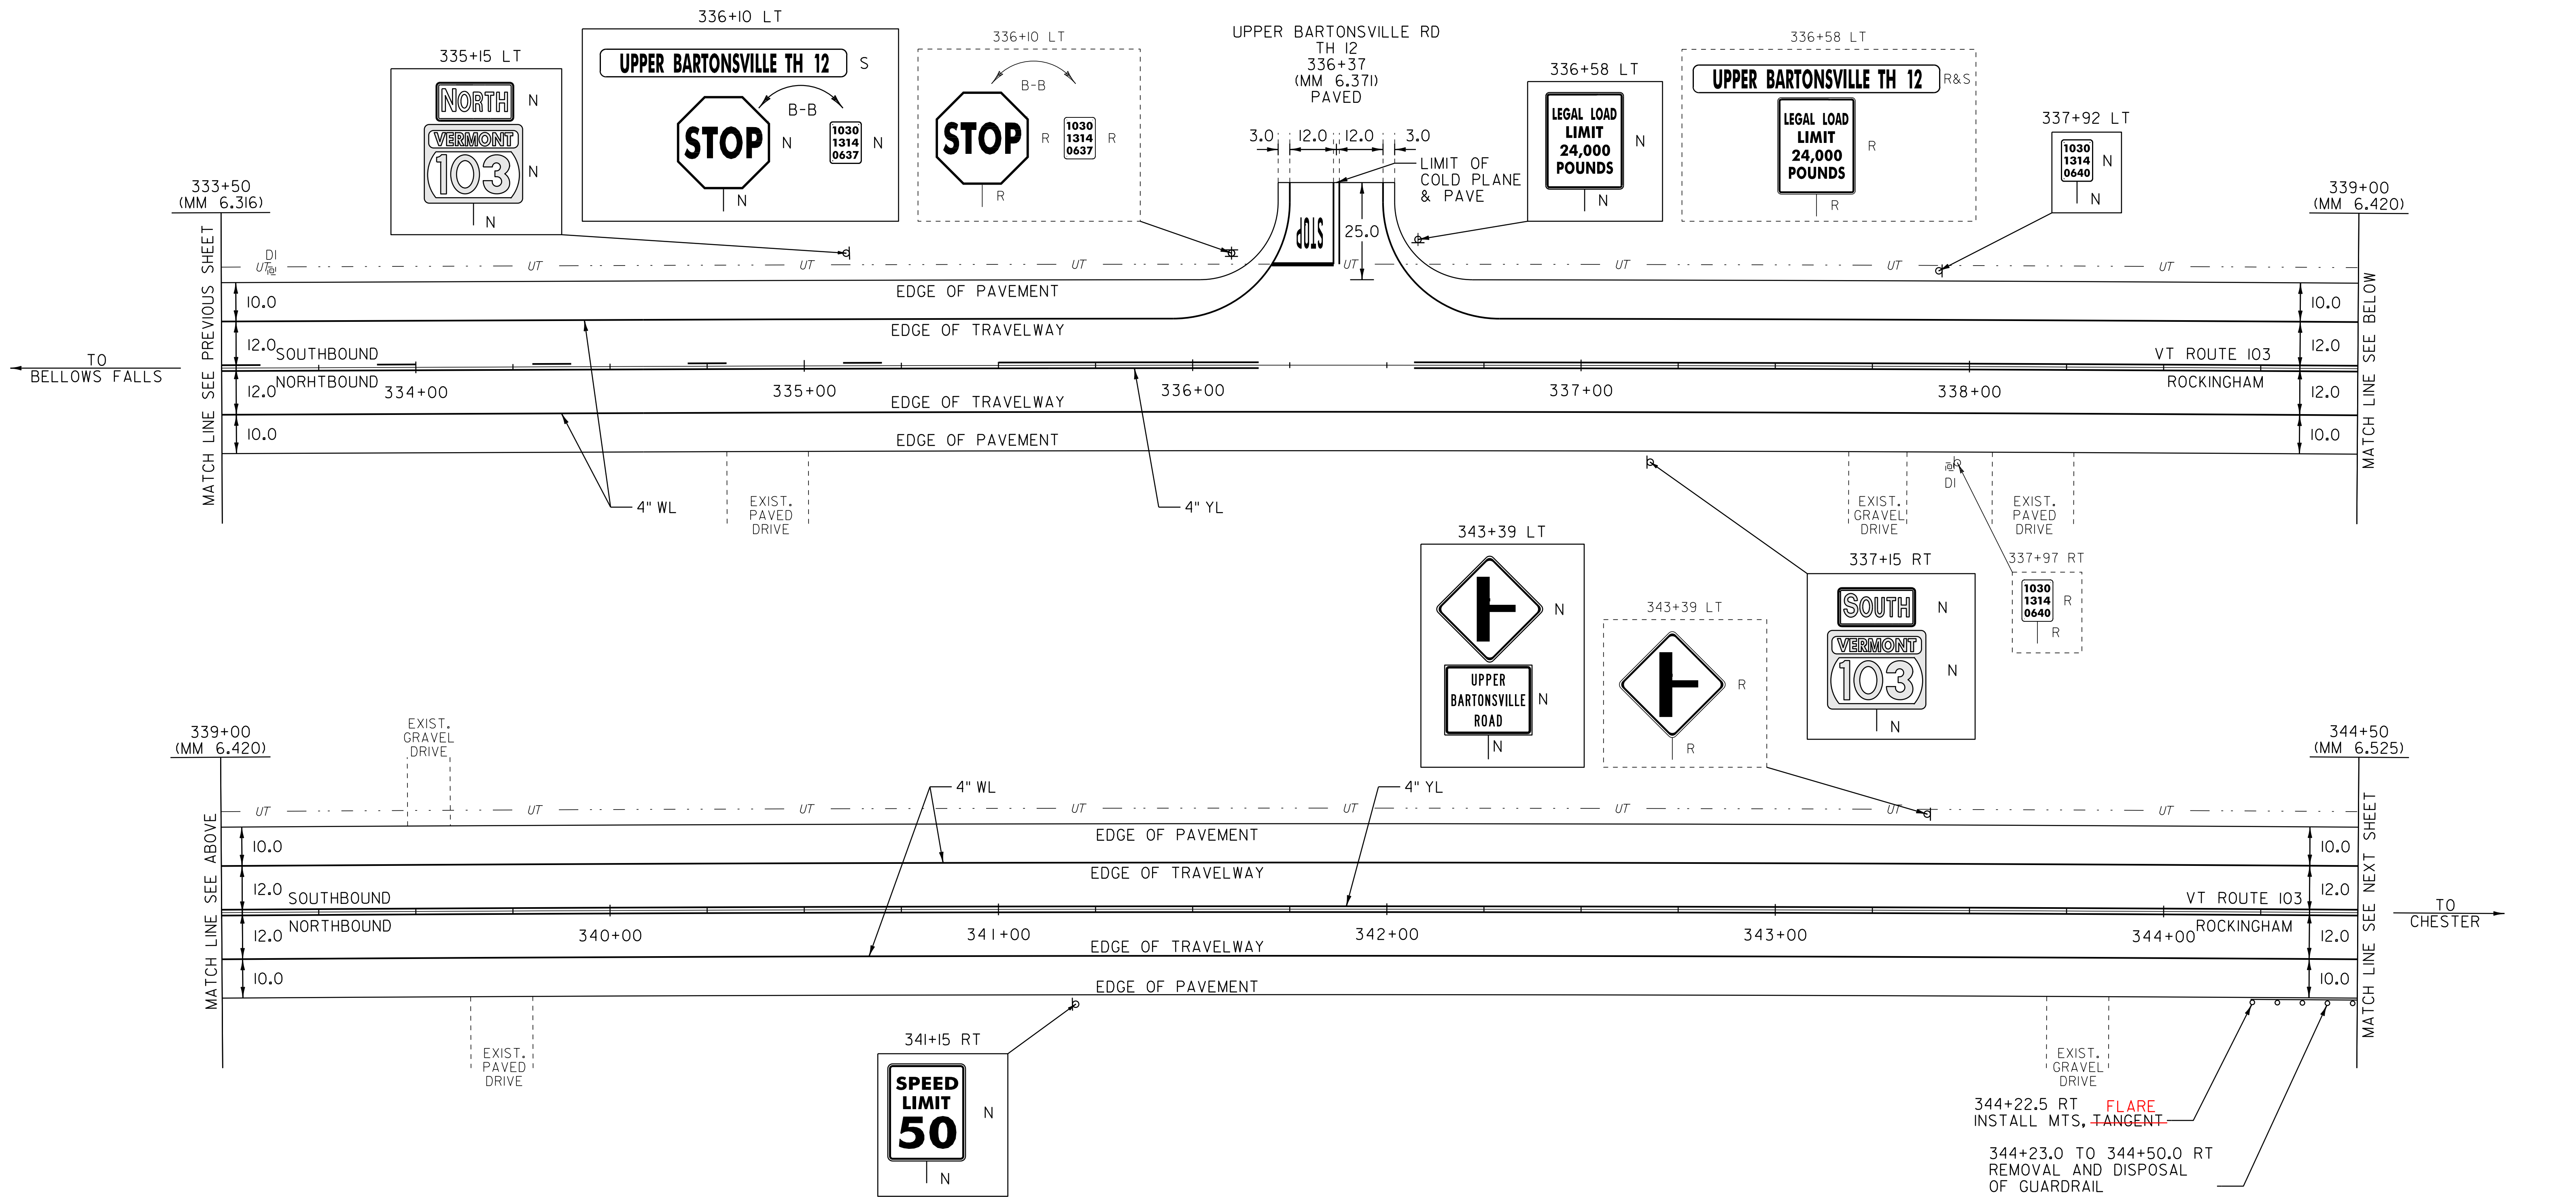

NOT TO SCALE

LEGEND

- R = REMOVE EXISTING
- S = SALVAGE
- R&S = REMOVE AND SALVAGE
- N = NEW
- RET = RETAIN
- B-B = BACK TO BACK
- = EXISTING GUARDRAIL
- = PROPOSED GUARDRAIL
- YL = YELLOW LINE
- WL = WHITE LINE
- ⊙ = TYPE 1 DELINEATOR, WHITE

PAVING LAYOUT 36

PROJECT NAME: ROCKINGHAM-CHESTER
 PROJECT NUMBER: NH 2628(I)

FILE NAME: 06B224
 PROJECT LEADER: PTS
 DESIGNED BY: NULL
 IPARM FILE NAME: pb2241a36.i
 PLOT DATE: 31-AUG-2012 14:03
 DRAWN BY: MRS
 CHECKED BY: PTS
 SHEET 50 OF 82