

TEMPORARY 4" WHITE LINE, PAINT  
 DURABLE 4" WHITE LINE, THERMOPLASTIC  
 344+50 TO 355+00 SOLID LT & RT

TEMPORARY 4" YELLOW LINE, PAINT  
 DURABLE 4" YELLOW LINE, THERMOPLASTIC  
 344+50 TO 352+90 SOLID LT & RT  
 352+90 TO 355+00 SOLID LT, DASHED RT

REMOVAL AND DISPOSAL OF GUARDRAIL  
 344+50 TO 348+82 RT  
 351+67 TO 355+00 RT


STEEL BEAM GUARDRAIL,  
 GALVANIZED W/8' POSTS  
 354+04 TO 355+00 RT

REMOVING SIGNS  
 AS SHOWN - 1

STEEL BEAM GUARDRAIL, GALVANIZED  
 344+72.5 TO 348+47.5 RT  
 352+04.5 TO 354+04.0 RT

MANUFACTURED TERMINAL SECTION, FLARED  
 DELINEATOR WITH STEEL POST  
 348+85.0 RT  
 351+67.0 RT

MARTINS MAPLE FARM

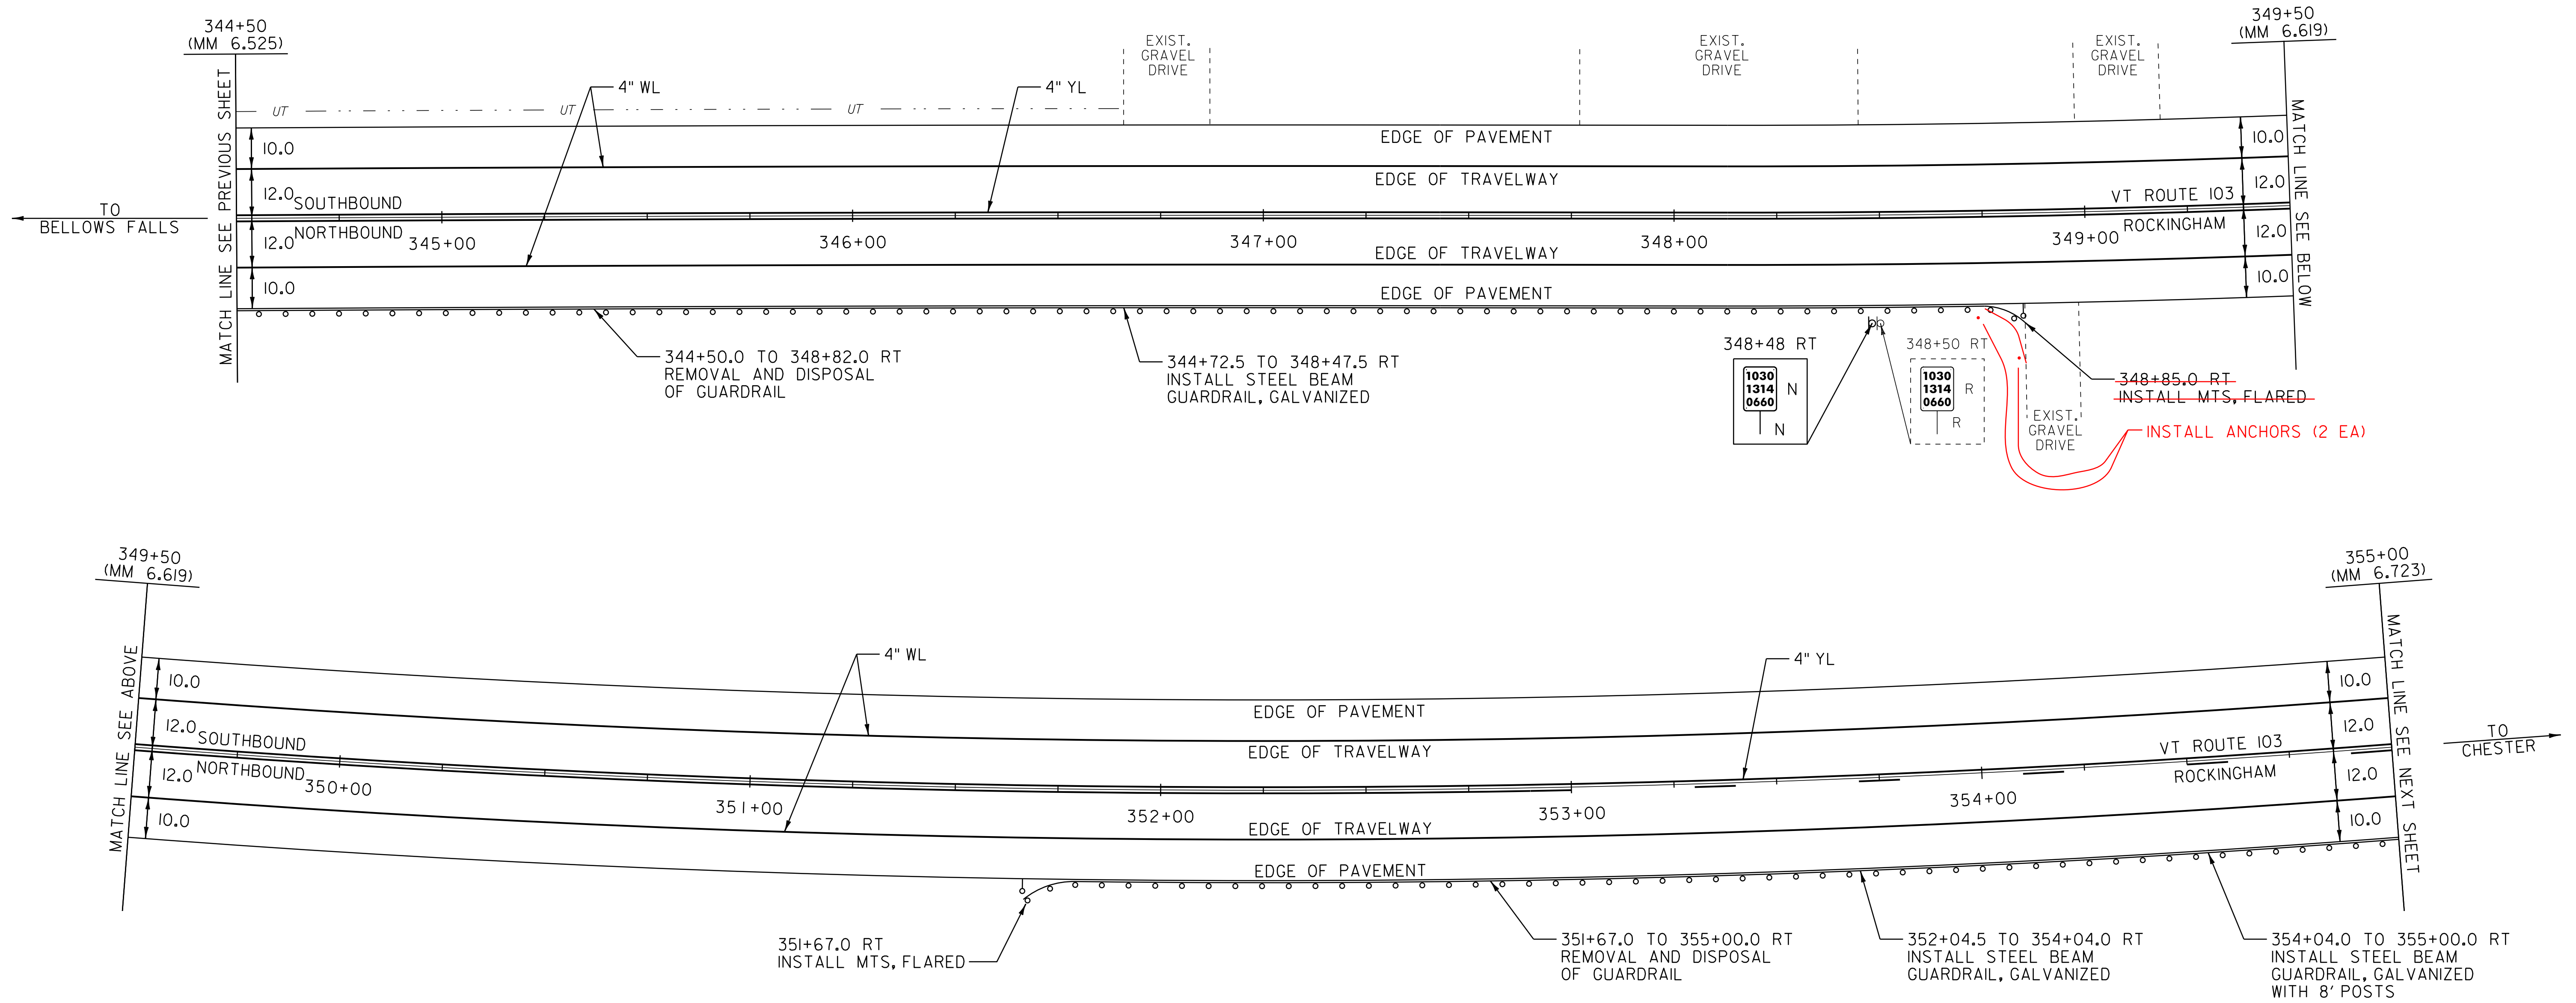

LEGEND

- R = REMOVE EXISTING
- S = SALVAGE
- R&S = REMOVE AND SALVAGE
- N = NEW
- RET = RETAIN
- B-B = BACK TO BACK
- = EXISTING GUARDRAIL
- o-o = PROPOSED GUARDRAIL
- YL = YELLOW LINE
- WL = WHITE LINE
- ? = TYPE I DELINEATOR, WHITE

PAVING LAYOUT 37

PROJECT NAME: ROCKINGHAM-CHESTER  
 PROJECT NUMBER: NH 2628(I)

FILE NAME: 06B224  
 PROJECT LEADER: PTS  
 DESIGNED BY: NLL  
 IPARM FILE NAME: pb224ia37.i

PLOT DATE: 31-AUG-2012 14:03  
 DRAWN BY: MRS  
 CHECKED BY: PTS  
 SHEET 51 OF 82

NOT TO SCALE