

TEMPORARY 4" WHITE LINE, PAINT
 DURABLE 4" YELLOW LINE, THERMOPLASTIC
 355+00 TO C 9+50 SOLID LT & RT

TEMPORARY 4" YELLOW LINE, PAINT
 DURABLE 4" YELLOW LINE, THERMOPLASTIC
 355+00 TO C 5+30 SOLID LT, DASHED RT
 C 5+30 TO C 9+50 DASHED RT

REMOVAL AND DISPOSAL OF GUARDRAIL
 355+00 TO C 5+95 RT
 C 0+47 TO C 4+63 LT

MANUFACTURED TERMINAL SECTION, FLARED
 DELINEATOR WITH STEEL POST

356+30.0 LT
 C 4+63.5 LT
 C 6+38.0 RT

BITUMINOUS CONCRETE
 CURB, TYPE A

C 0+63 TO C 4+42 LT
 C 1+94 TO C 5+64 RT

REMOVING SIGNS
 AS SHOWN - 4

STEEL BEAM GUARDRAIL, GALVANIZED

C 0+00 TO C 2+00.0 RT
 C 5+75 TO C 6+00.5 RT
 C 9+37.5 TO C 9+50 RT

STEEL BEAM GUARDRAIL,
 GALVANIZED W/8' POSTS

355+00.0 TO 356+54.0 RT
 C 0+13.5 TO C 4+26.0 LT
 C 2+00.0 TO C 5+75.0 RT

ANCHOR FOR STEEL BEAM RAIL


C 9+37.5 RT

BITUMINOUS CONCRETE GUTTERS
 AND TRAFFIC ISLANDS

C 4+44 LT

12" CSP .064 (2-2/3 X 1/2)

C 9+25 TO C 9+50 RT

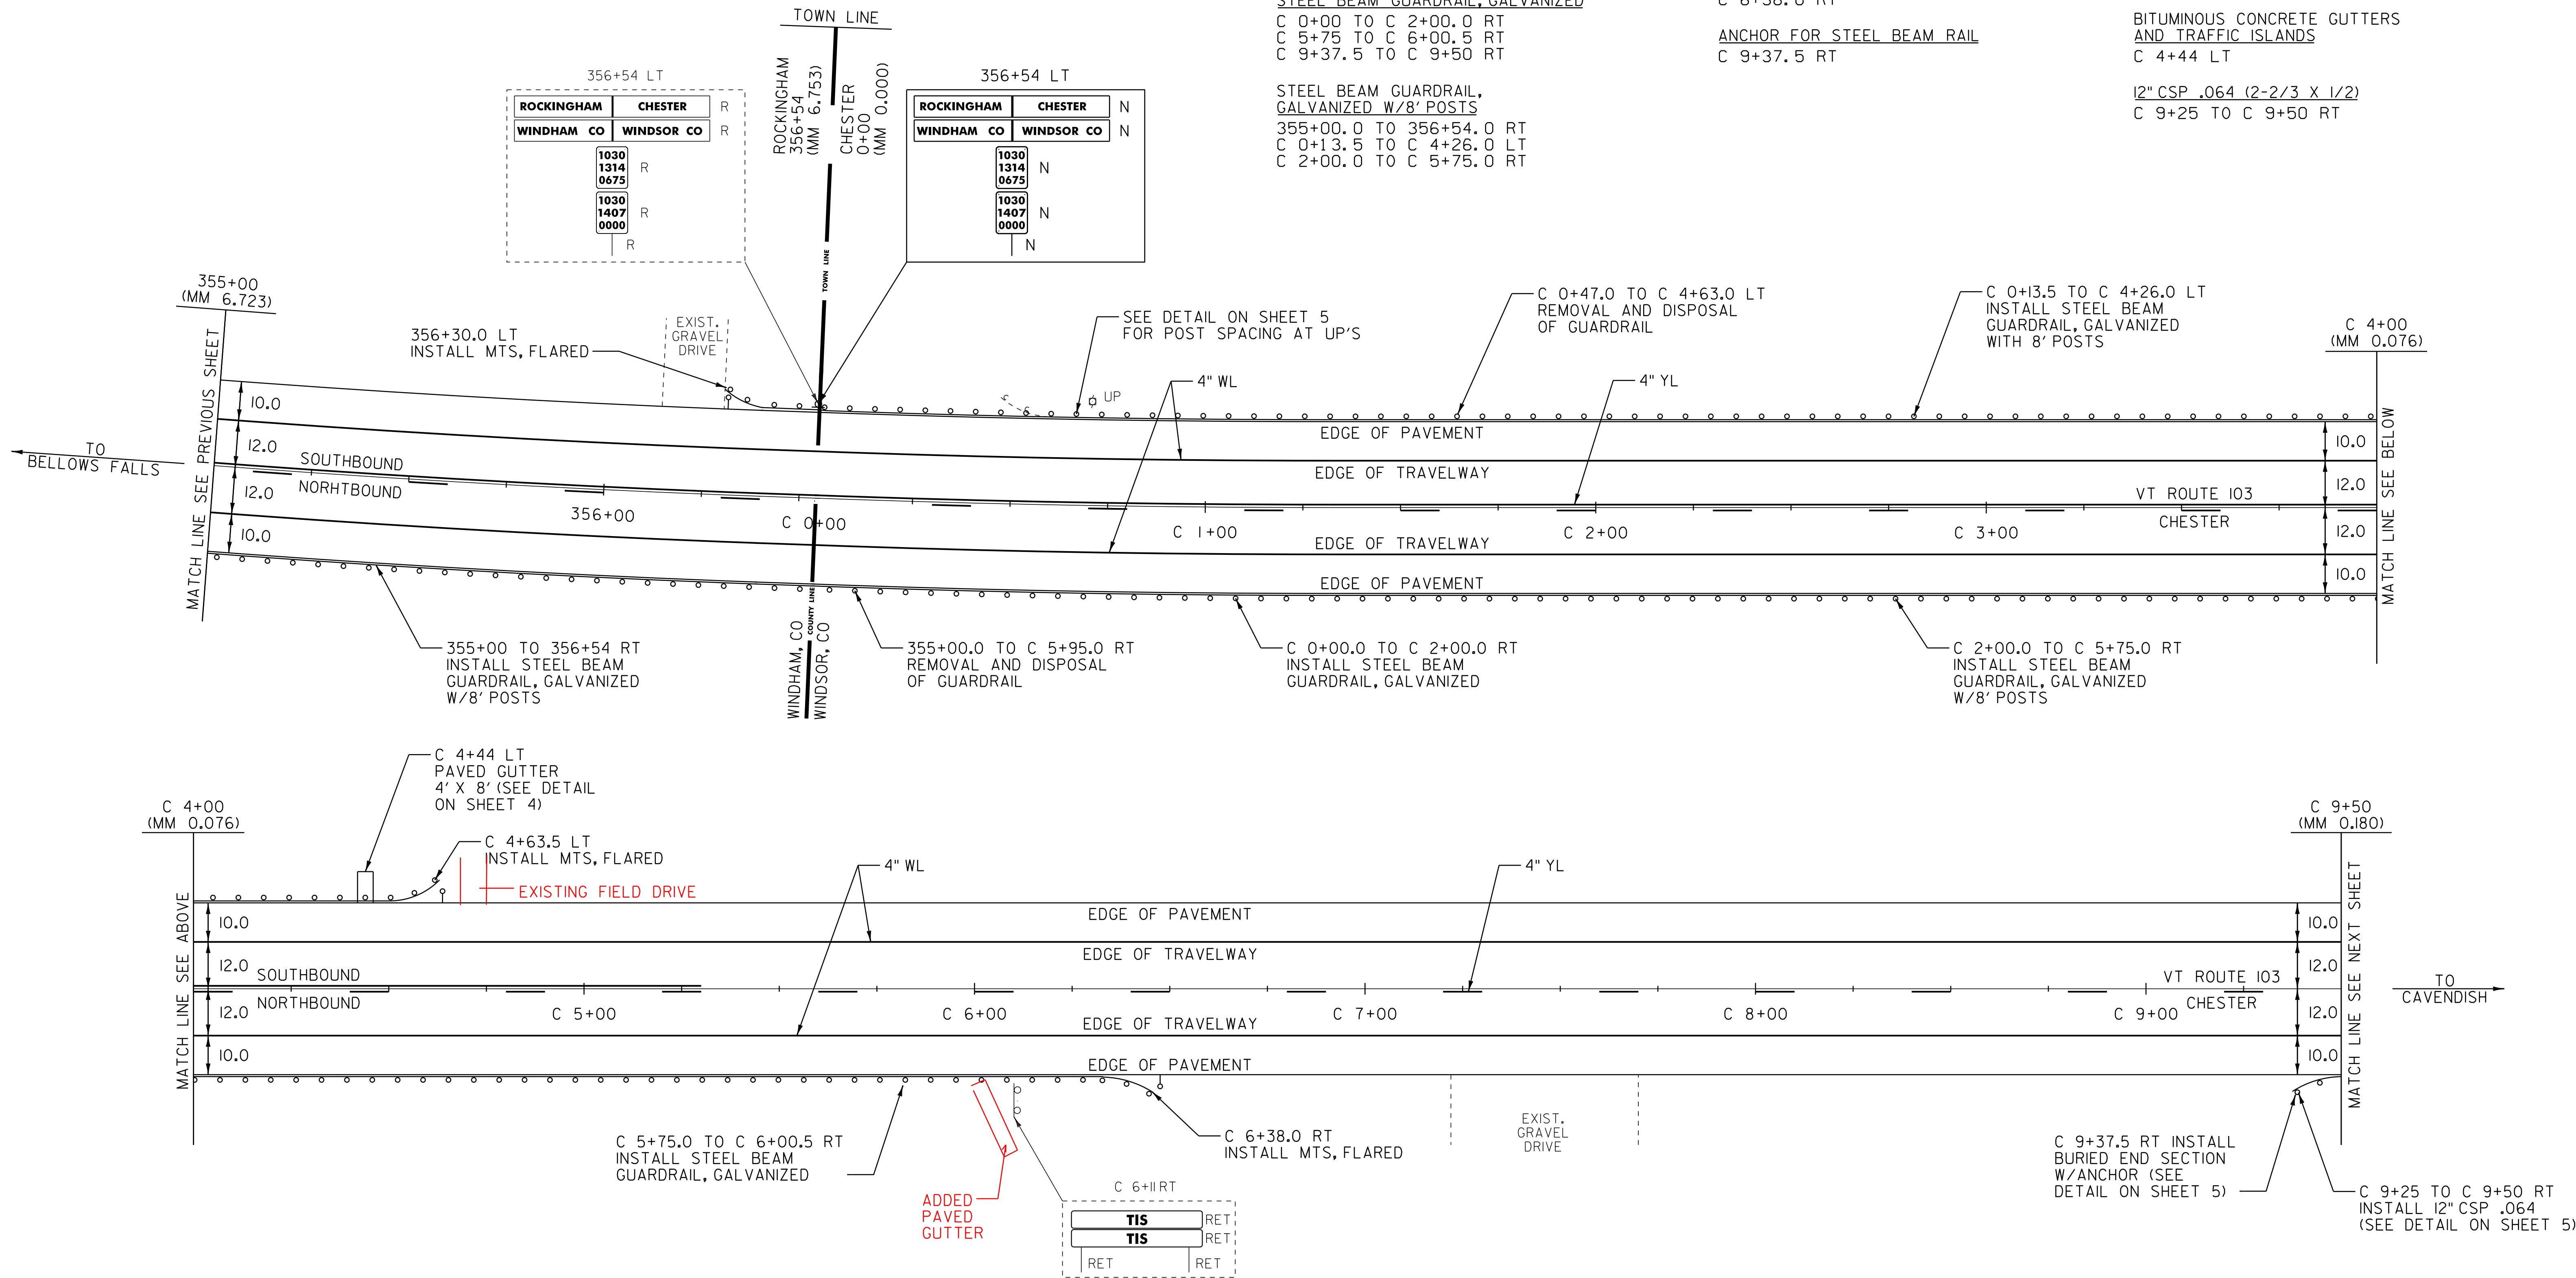

356+54 LT		
ROCKINGHAM	CHESTER	R
WINDHAM CO	WINDSOR CO	R
1030		R
1314		R
0675		R
1030		R
1407		R
0000		R

356+54 LT		
ROCKINGHAM	CHESTER	N
WINDHAM CO	WINDSOR CO	N
1030		N
1314		N
0675		N
1030		N
1407		N
0000		N

NOT TO SCALE

- LEGEND**
- R = REMOVE EXISTING
 - S = SALVAGE
 - R&S = REMOVE AND SALVAGE
 - N = NEW
 - RET = RETAIN
 - B-B = BACK TO BACK
 - = EXISTING GUARDRAIL
 - o-o = PROPOSED GUARDRAIL
 - YL = YELLOW LINE
 - WL = WHITE LINE
 - ⊙ = TYPE I DELINEATOR, WHITE

PAVING LAYOUT 38

PROJECT NAME: ROCKINGHAM-CHESTER
 PROJECT NUMBER: NH 2628(I)

FILE NAME: 06B224
 PROJECT LEADER: PTS
 DESIGNED BY: NLL
 IPARM FILE NAME: pb224ia38.i

PLOT DATE: 31-AUG-2012 14:03
 DRAWN BY: MRS
 CHECKED BY: PTS
 SHEET 52 OF 82