

TEMPORARY 4" WHITE LINE, PAINT  
DURABLE 4" YELLOW LINE, THERMOPLASTIC

C 20+50 TO C 29+43 SOLID RT  
C 20+50 TO C 31+00 SOLID LT  
C 29+43 TO C 29+71 SOLID RT (TH 6)  
C 29+95 TO C 30+25 SOLID RT (TH 6)  
C 30+25 TO C 31+00 SOLID RT

TEMPORARY 4" YELLOW LINE, PAINT  
DURABLE 4" YELLOW LINE, THERMOPLASTIC

C 20+50 TO C 21+60 SOLID LT, DASHED RT  
C 21+60 TO C 24+70 DASHED RT  
C 24+70 TO C 29+10 DASHED LT, SOLID RT  
C 29+10 TO C 29+63 SOLID LT & RT  
C 29+83 DOUBLE SOLID RT (TH 6)  
C 30+03 TO C 31+00 SOLID LT & RT

TEMPORARY LETTER OR SYMBOL, PAINT  
DURABLE LETTER OR SYMBOL, THERMOPLASTIC

C 29+90 RT - "STOP" (TH 6)

TEMPORARY 24" STOP BAR, PAINT  
DURABLE 24" STOP BAR, THERMOPLASTIC  
C 29+82 TO C 30+32 RT (TH 6)

REMOVAL AND DISPOSAL OF GUARDRAIL

C 20+50 TO C 23+38 RT  
C 21+11 TO C 23+16 LT

STEEL BEAM GUARDRAIL, GALVANIZED



C 20+50.0 TO C 23+00.0 RT  
C 21+50.5 TO C 22+75.5 LT

MANUFACTURED TERMINAL SECTION, FLARED  
DELINEATOR WITH STEEL POST

C 21+13.0 LT  
C 23+13.0 LT  
C 23+37.5 RT

REMOVING SIGNS  
AS SHOWN - 10

ERECTING SALVAGED SIGNS  
AS SHOWN - 1

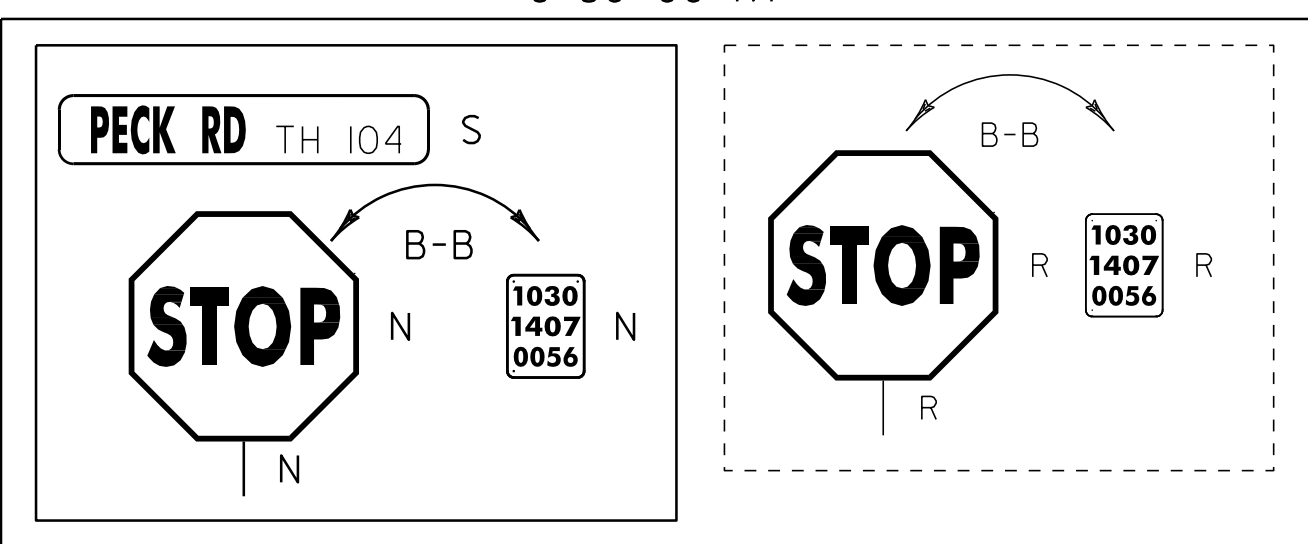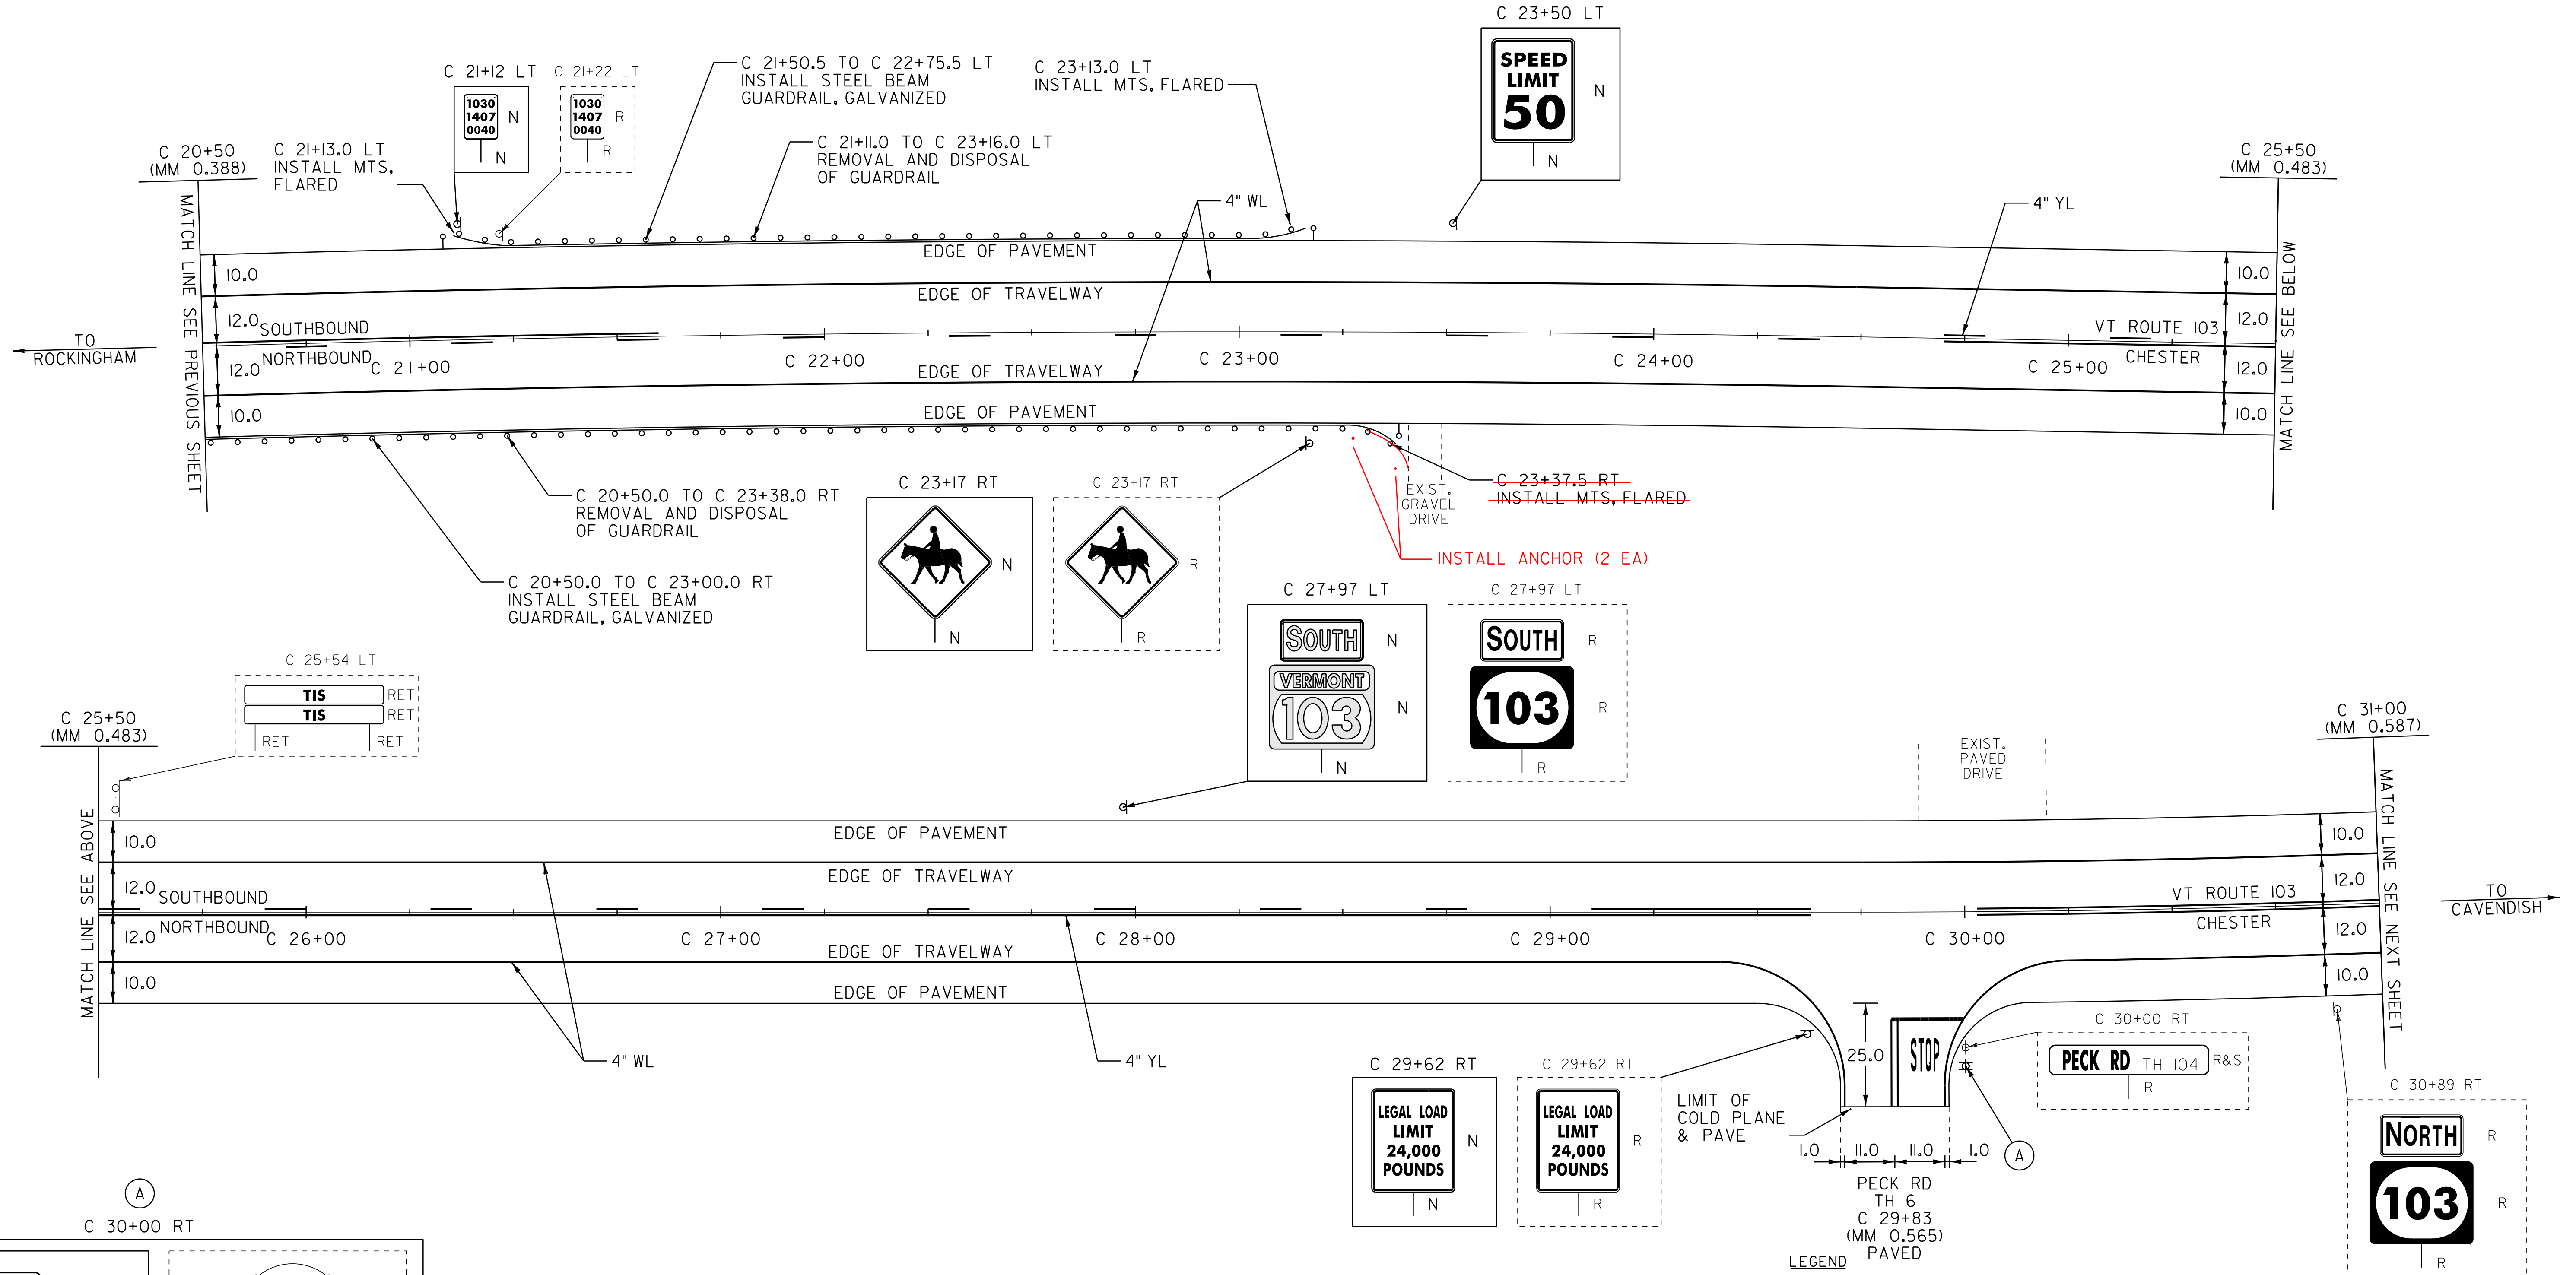

- LEGEND
- R = REMOVE EXISTING
  - S = SALVAGE
  - R&S = REMOVE AND SALVAGE
  - N = NEW
  - RET = RETAIN
  - B-B = BACK TO BACK
  - = EXISTING GUARDRAIL
  - = PROPOSED GUARDRAIL
  - YL = YELLOW LINE
  - WL = WHITE LINE
  - ⊙ = TYPE I DELINEATOR, WHITE

**PAVING LAYOUT 40**

PROJECT NAME: ROCKINGHAM-CHESTER  
PROJECT NUMBER: NH 2628(1)

FILE NAME: 06B224  
PROJECT LEADER: PTS  
DESIGNED BY: NULL  
IPARM FILE NAME: pb2241a40.i

PLOT DATE: 31-AUG-2012 14:03  
DRAWN BY: MRS  
CHECKED BY: PTS  
SHEET 54 OF 82

NOT TO SCALE