

TEMPORARY 4" WHITE LINE, PAINT
 DURABLE 4" WHITE LINE, THERMOPLASTIC
 C 63+00 TO C 74+00 SOLID LT & RT


TEMPORARY 4" YELLOW LINE, PAINT
 DURABLE 4" YELLOW LINE, THERMOPLASTIC
 C 63+00 TO C 68+30 DASHED LT, SOLID RT
 C 68+30 TO C 74+00 SOLID LT & RT

REMOVAL AND DISPOSAL OF GUARDRAIL
 C 63+61 TO C 66+56 RT

STEEL BEAM GUARDRAIL, GALVANIZED
 C 63+96 TO C 66+21 RT

MANUFACTURED TERMINAL
 SECTION, FLARED
 DELINEATOR WITH STEEL POST
 C 63+58.5 RT
 C 66+58.5 RT

REMOVING SIGNS
 AS SHOWN - 2

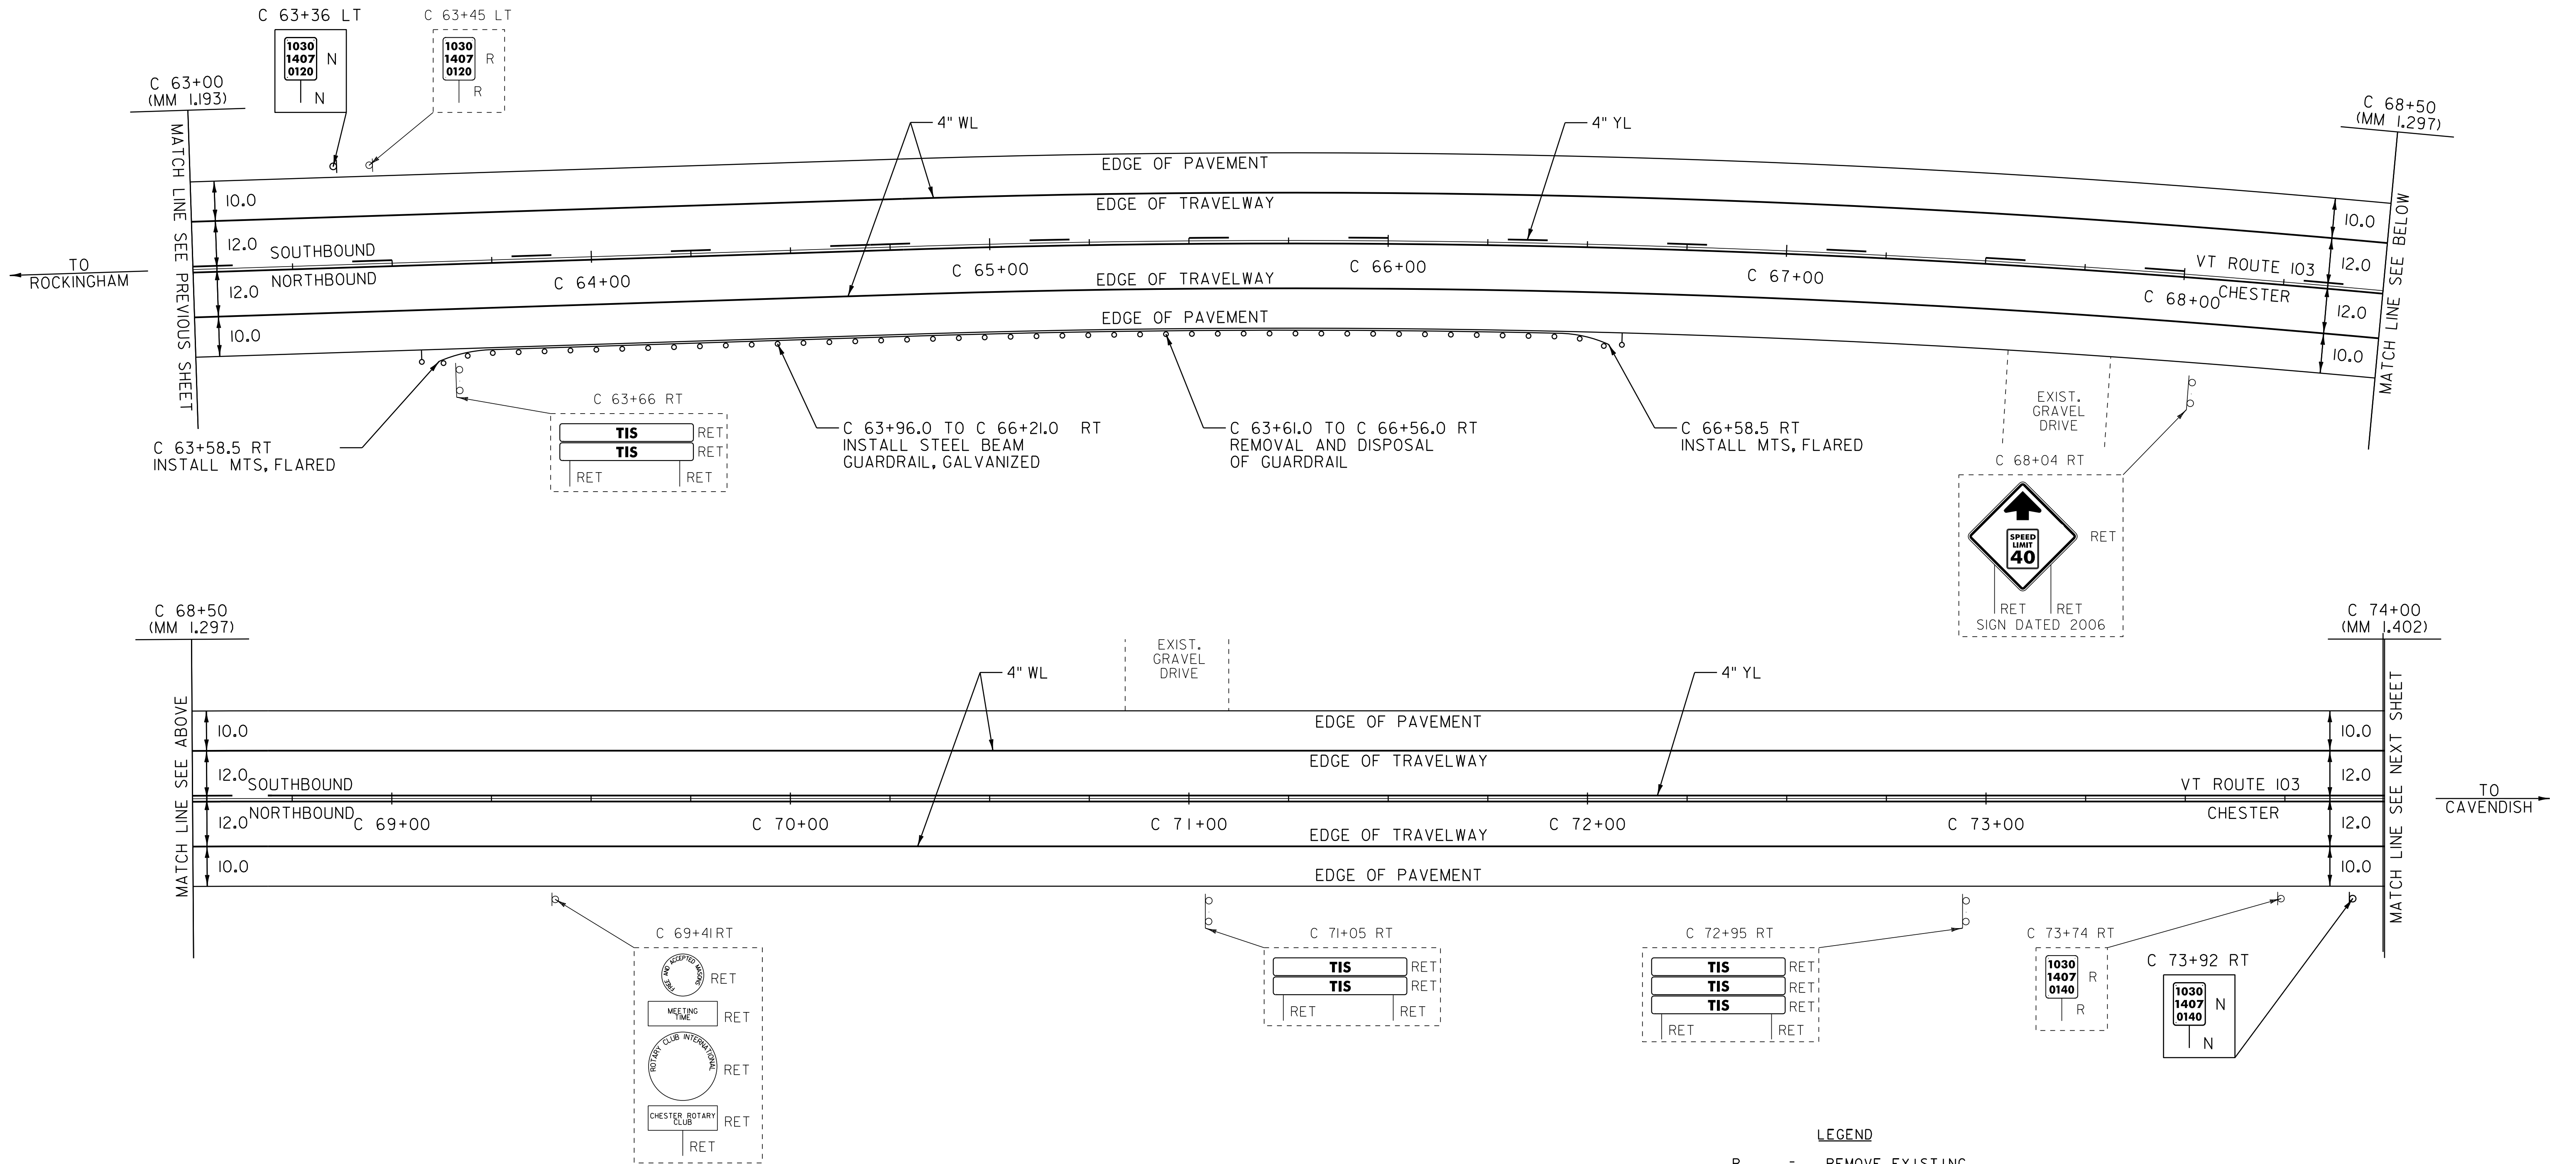

NOT TO SCALE

- LEGEND**
- R = REMOVE EXISTING
 - S = SALVAGE
 - R&S = REMOVE AND SALVAGE
 - N = NEW
 - RET = RETAIN
 - B-B = BACK TO BACK
 - = EXISTING GUARDRAIL
 - o--- = PROPOSED GUARDRAIL
 - YL = YELLOW LINE
 - WL = WHITE LINE
 - ⊙ = TYPE I DELINEATOR, WHITE

PAVING LAYOUT 44

PROJECT NAME: ROCKINGHAM-CHESTER
 PROJECT NUMBER: NH 2628(I)

FILE NAME: 06B224
 PROJECT LEADER: PTS
 DESIGNED BY: NLL
 IPARM FILE NAME: pb2241a44.i

PLOT DATE: 31-AUG-2012 14:03
 DRAWN BY: MRS
 CHECKED BY: PTS
 SHEET 58 OF 82