



PROFILE: U.S. ROUTE 7

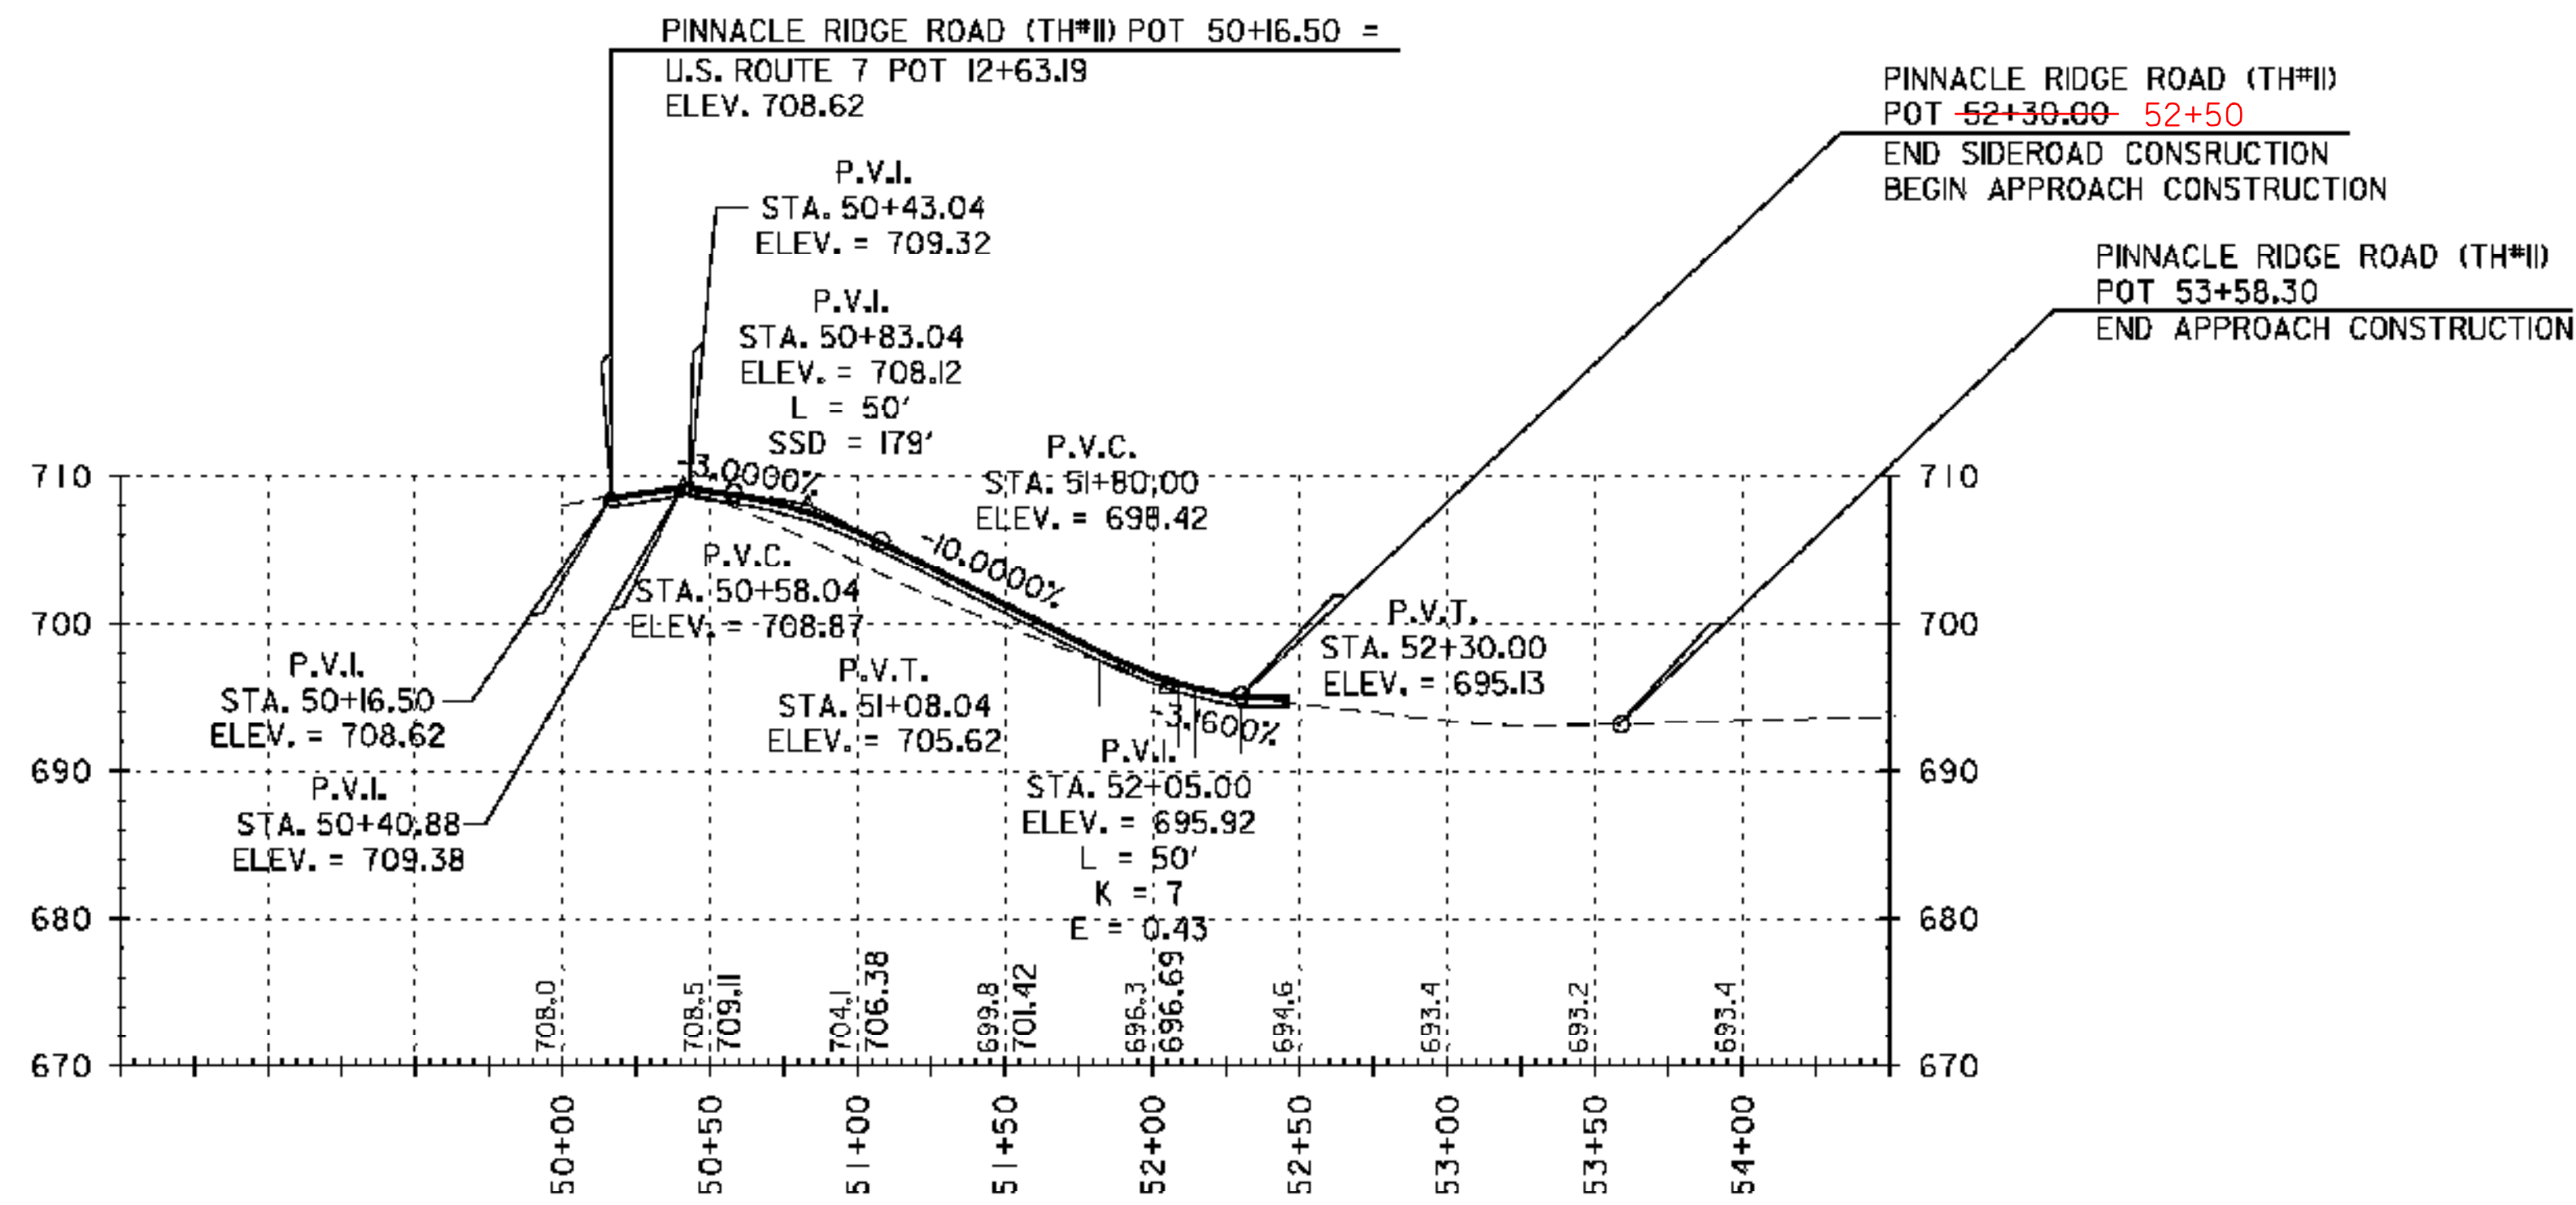

PROFILE: PINNACLE RIDGE ROAD

DATUM
 VERTICAL NAVD 88
 HORIZONTAL NAD 83(1992)

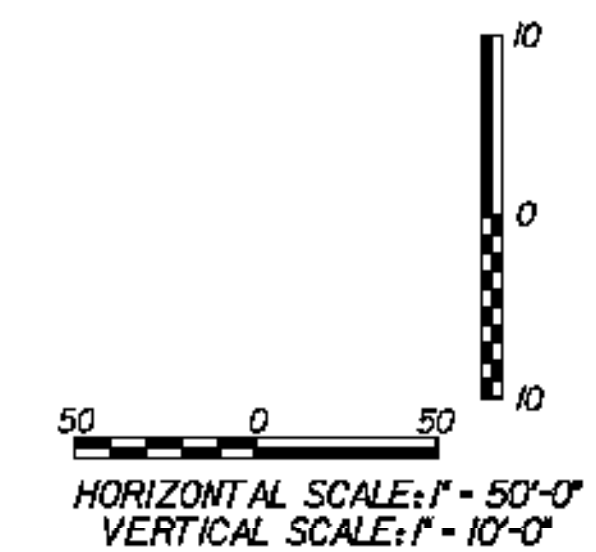

PROJECT NAME: RUTLAND TOWN	PLOT DATE: 3/3/2009
PROJECT NUMBER: HES INTS(4)	DRAWN BY: TSK
FILE NAME: z05k114PR1.dgn	CHECKED BY: DWB
PROJECT LEADER: DWB	SHEET NO. 13 OF 36
DESIGNED BY: TSK	
PROFILE SHEET	