

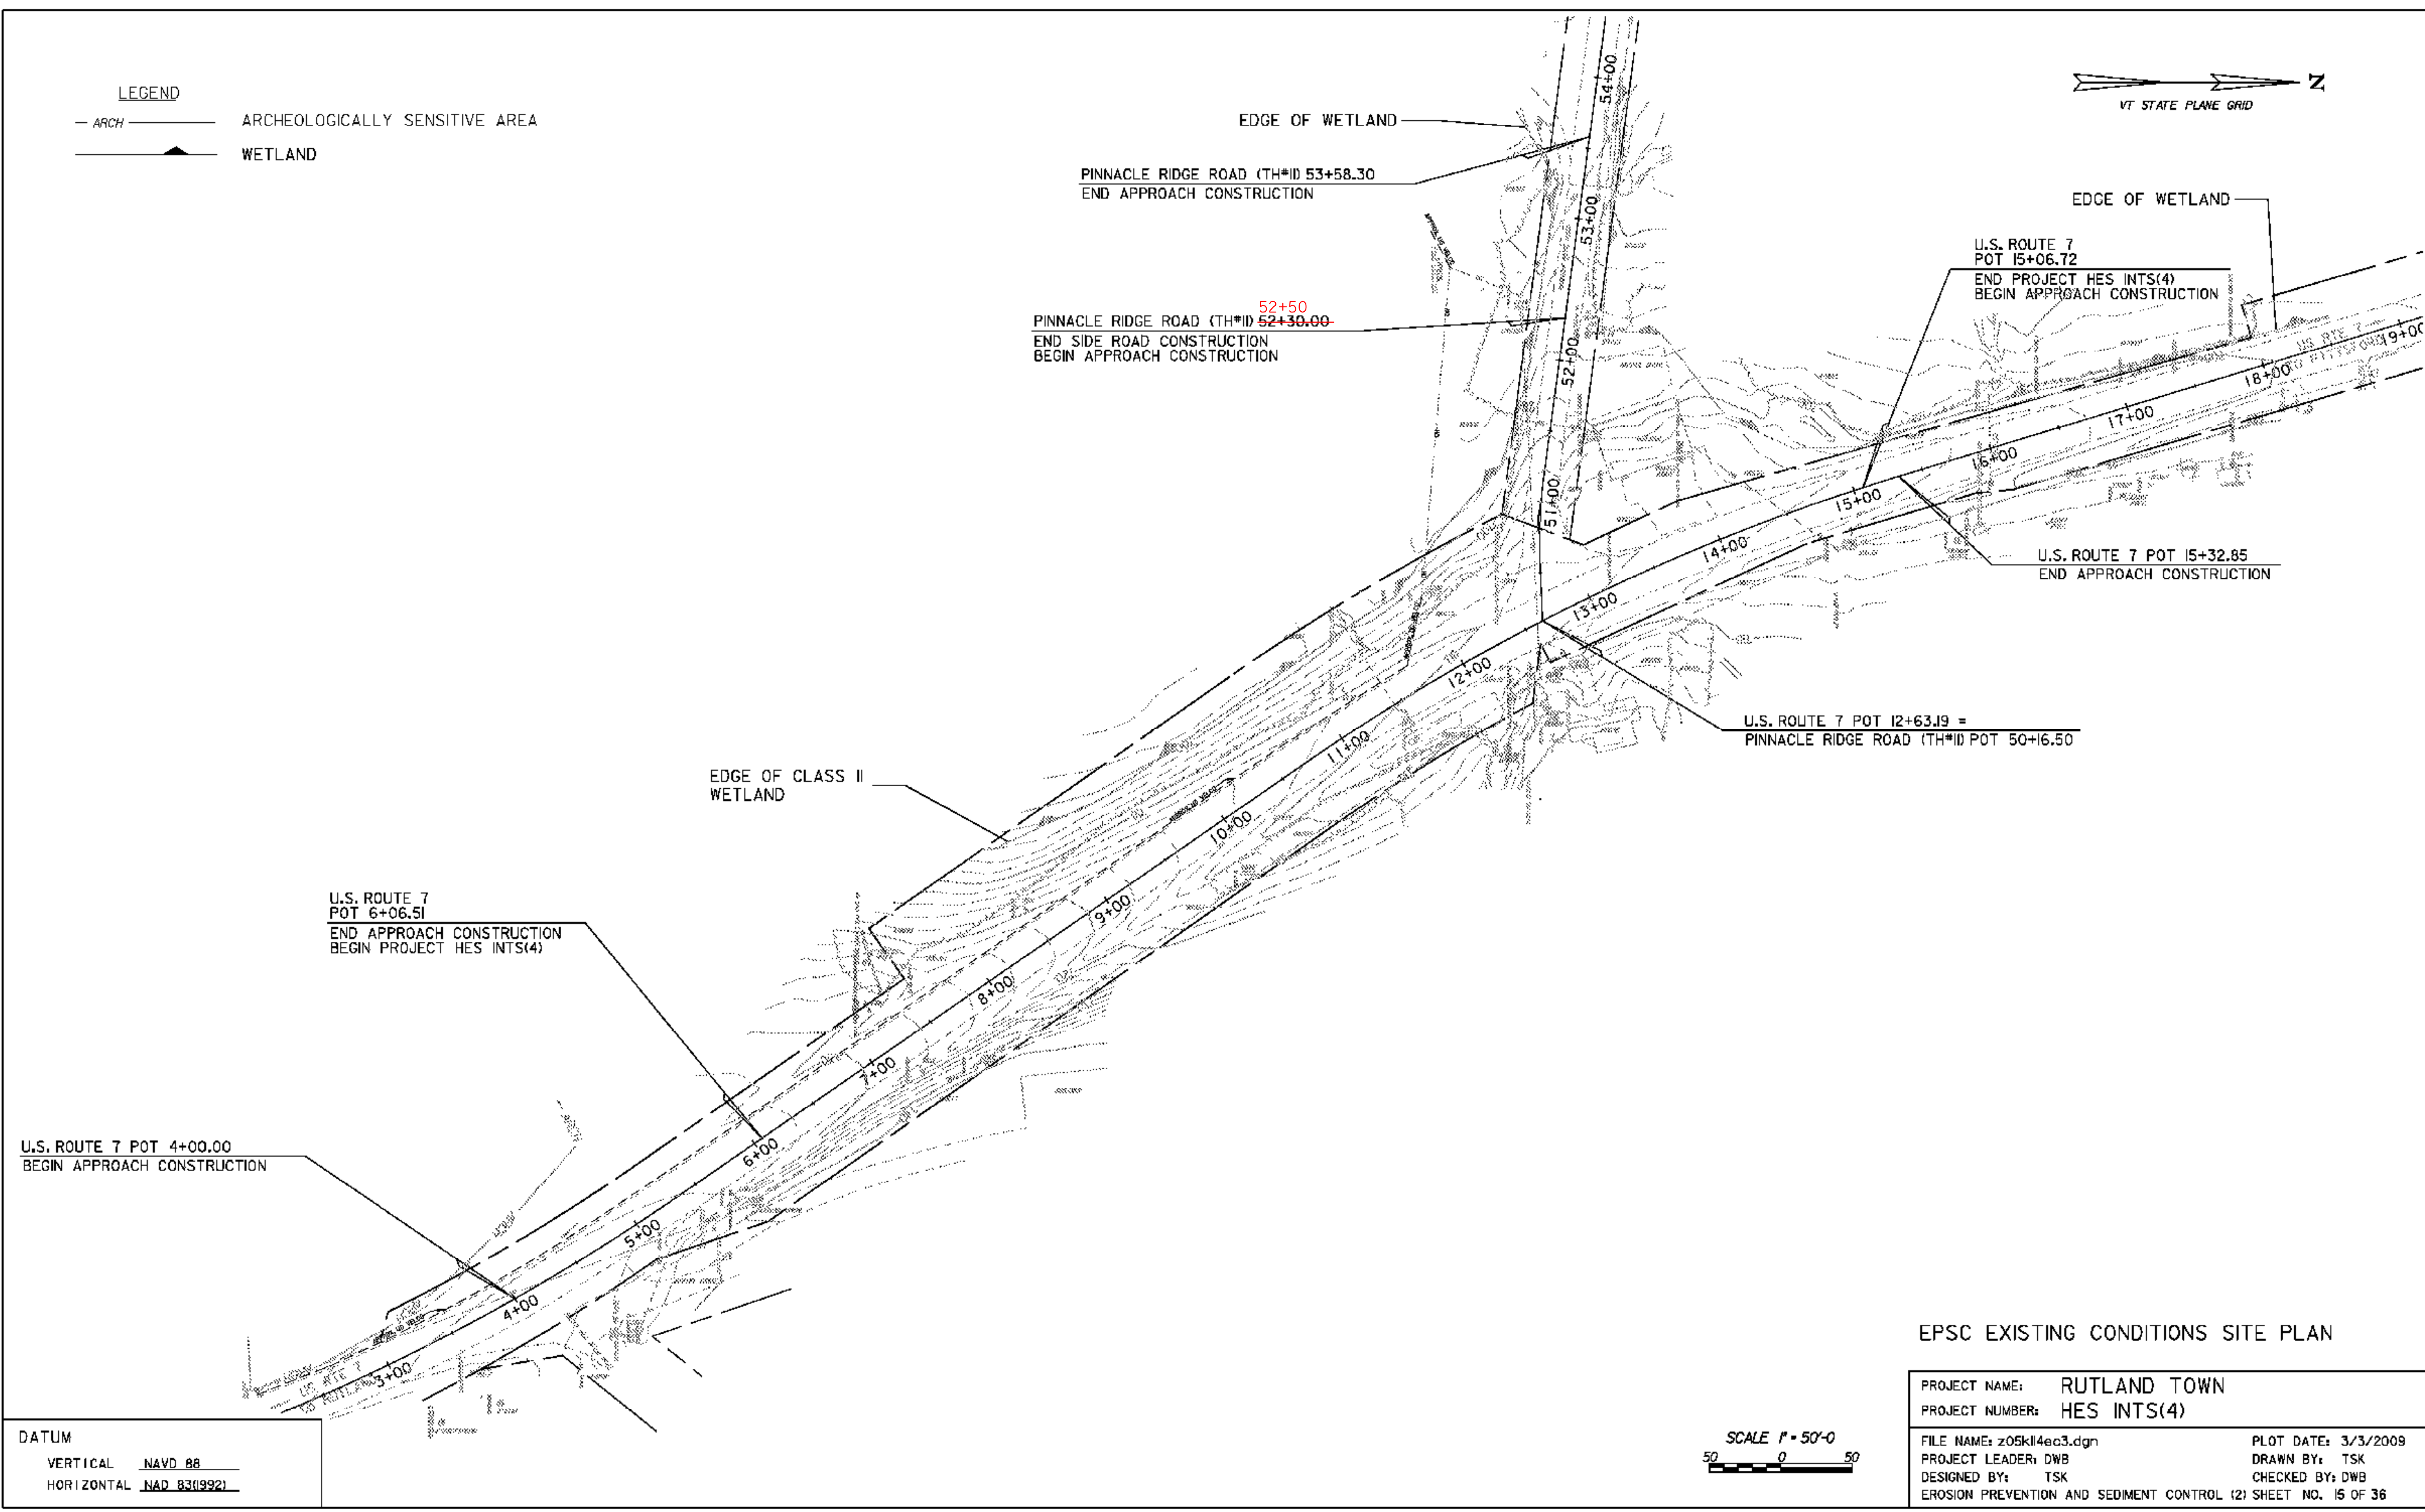


LEGEND

- ARCH - ARCHEOLOGICALLY SENSITIVE AREA
- WETLAND

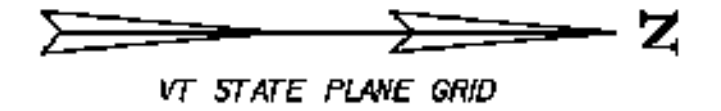

DATUM
 VERTICAL NAVD 88
 HORIZONTAL NAD 83(9921)

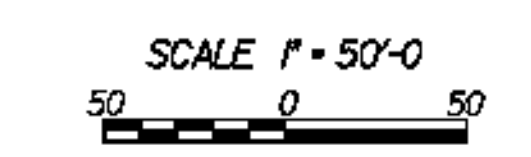

EPSC EXISTING CONDITIONS SITE PLAN

PROJECT NAME:	RUTLAND TOWN	PLOT DATE:	3/3/2009
PROJECT NUMBER:	HES INTS(4)	DRAWN BY:	TSK
FILE NAME:	z05kl4ec3.dgn	CHECKED BY:	DWB
PROJECT LEADER:	DWB	EROSION PREVENTION AND SEDIMENT CONTROL (2)	SHEET NO. 15 OF 36