



LEGEND

- ARCH ——— ARCH ARCHEOLOGICALLY SENSITIVE AREA
- WETLAND
- ██████████ DISTURBED AREAS REQUIRING RE-VEGETATION

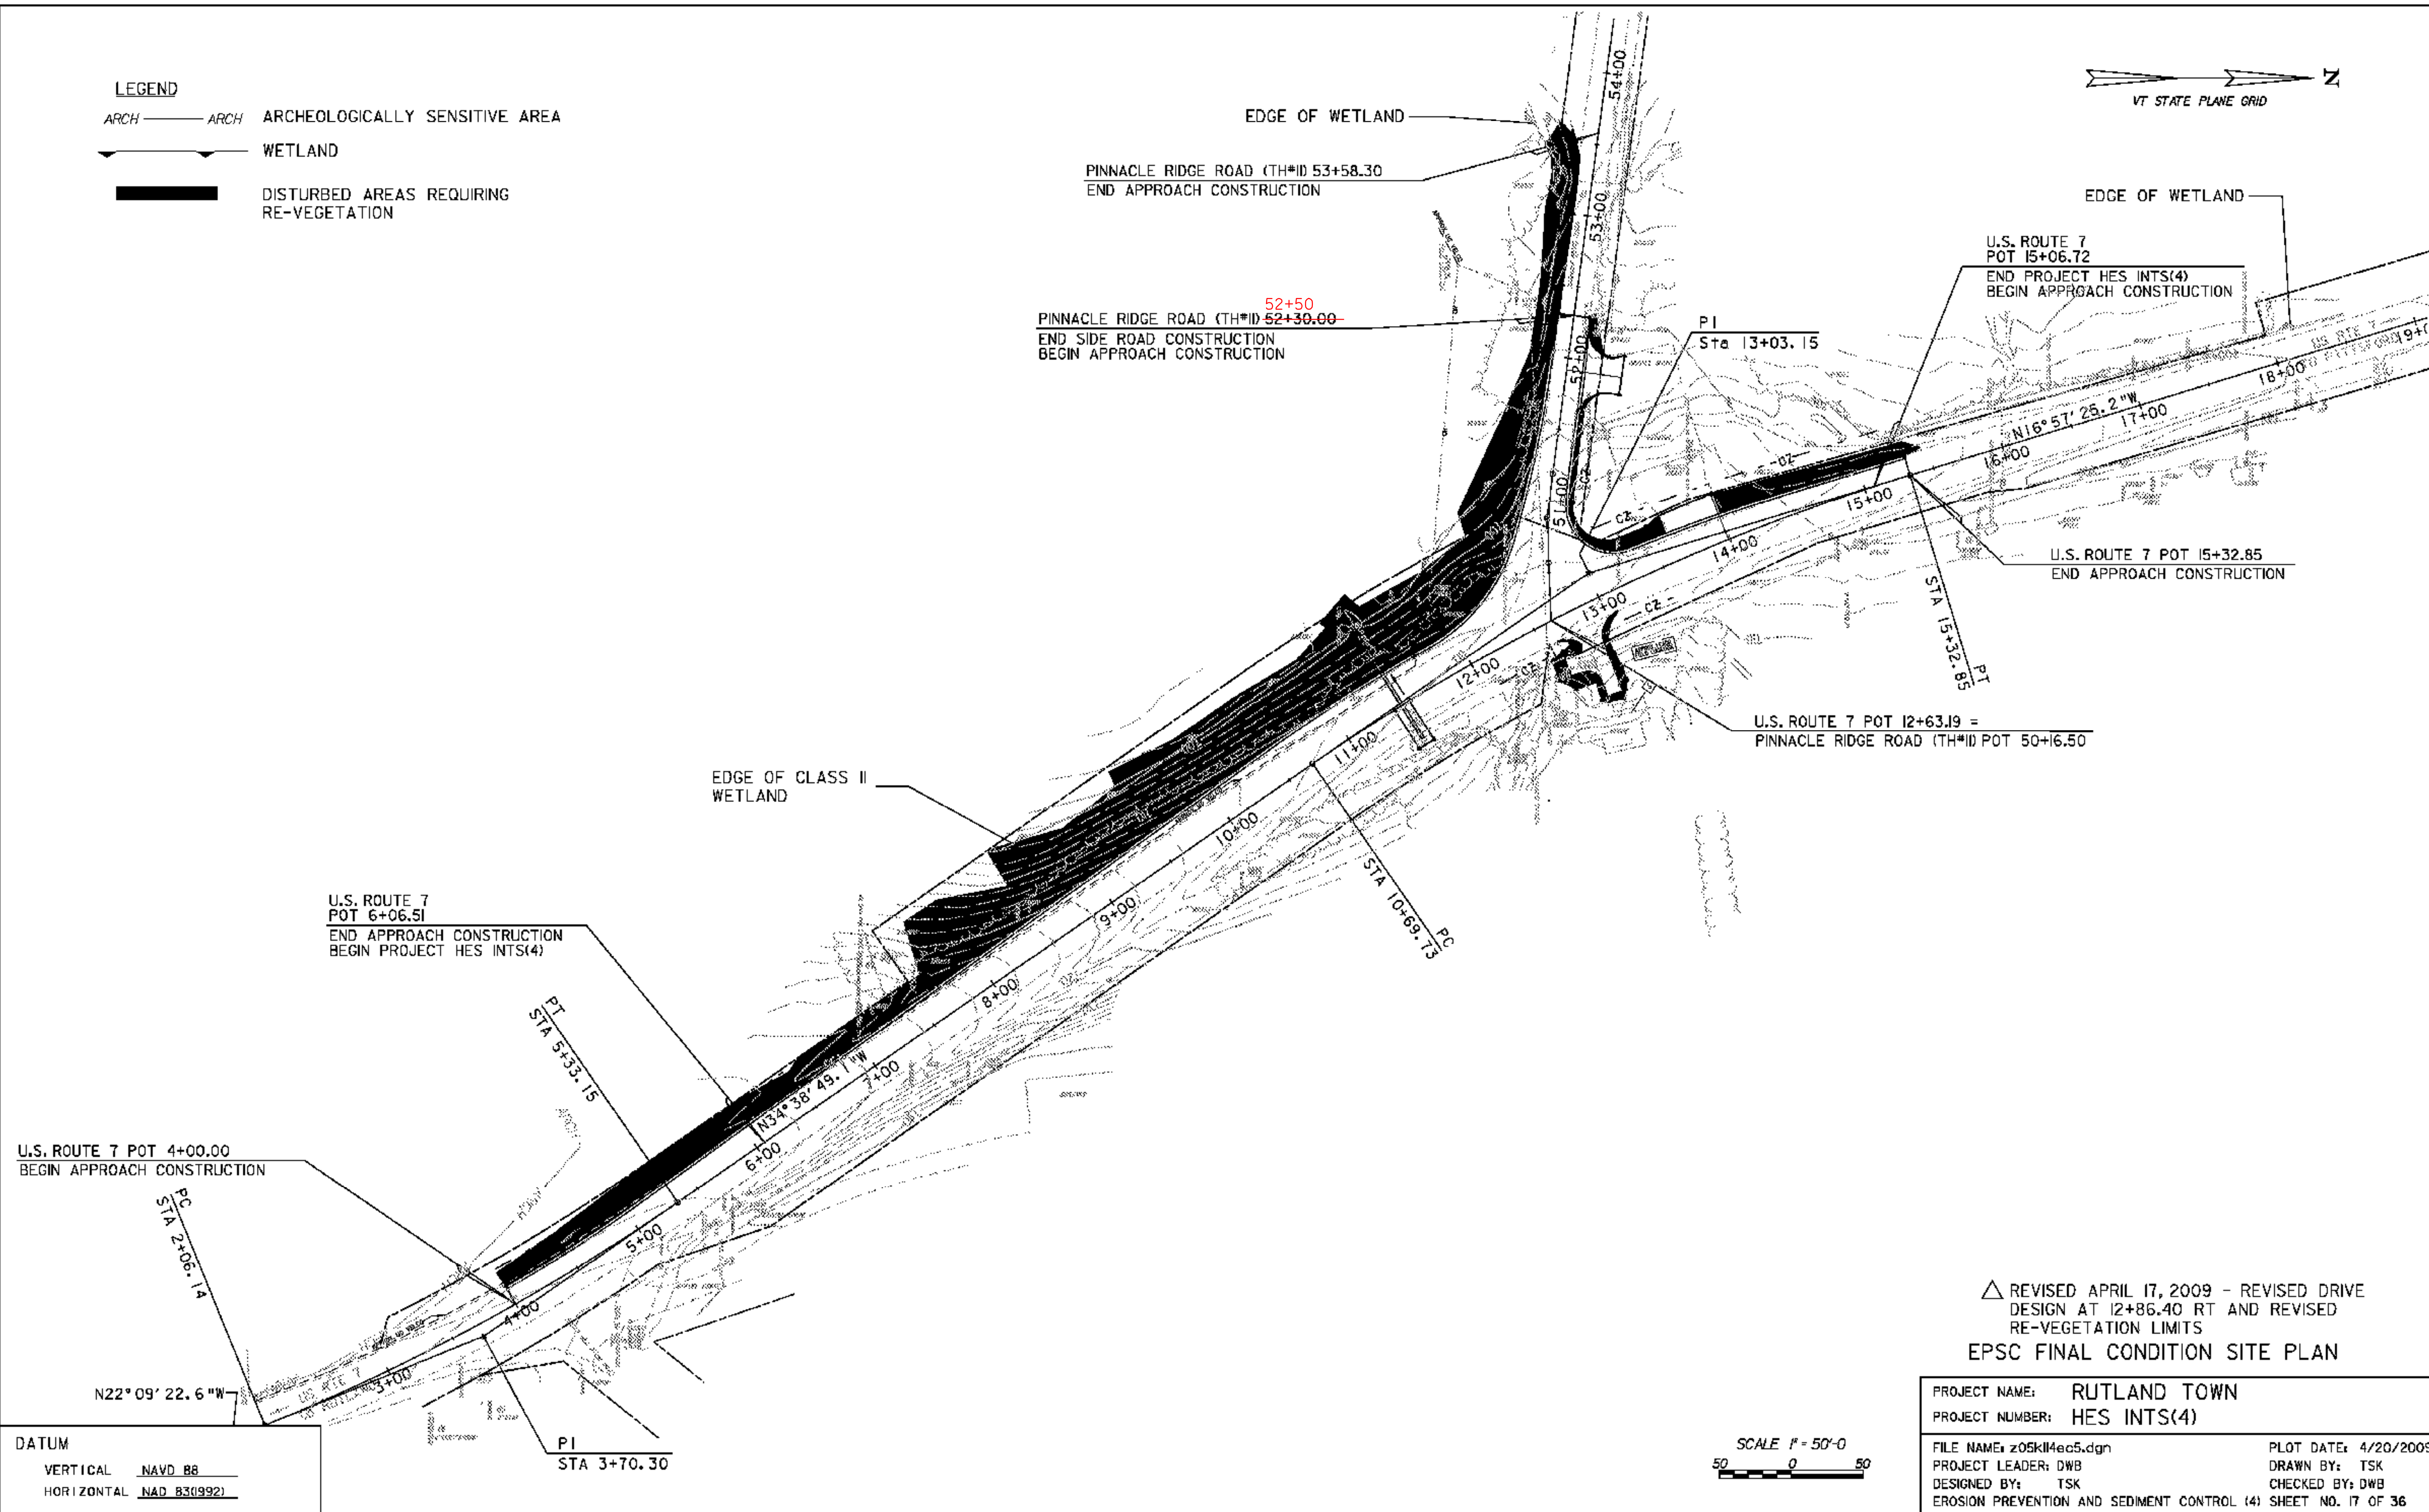

△ REVISED APRIL 17, 2009 - REVISED DRIVE DESIGN AT 12+86.40 RT AND REVISED RE-VEGETATION LIMITS
EPSC FINAL CONDITION SITE PLAN

PROJECT NAME:	RUTLAND TOWN	PLOT DATE:	4/20/2009
PROJECT NUMBER:	HES INTS(4)	DRAWN BY:	TSK
FILE NAME:	z05kl14ec5.dgn	CHECKED BY:	DWB
PROJECT LEADER:	DWB	EROSION PREVENTION AND SEDIMENT CONTROL (4)	SHEET NO. 17 OF 36
DESIGNED BY:	TSK		

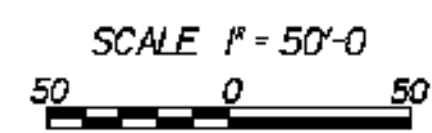

DATUM
 VERTICAL NAVD 88
 HORIZONTAL NAD 83(1992)