



LEGEND

PDF	PDF	PROJECT DEMARCATION FENCE
		WETLAND
DYL		DOUBLE YELLOW CENTER LINE
SWEL		SINGLE WHITE EDGE LINE

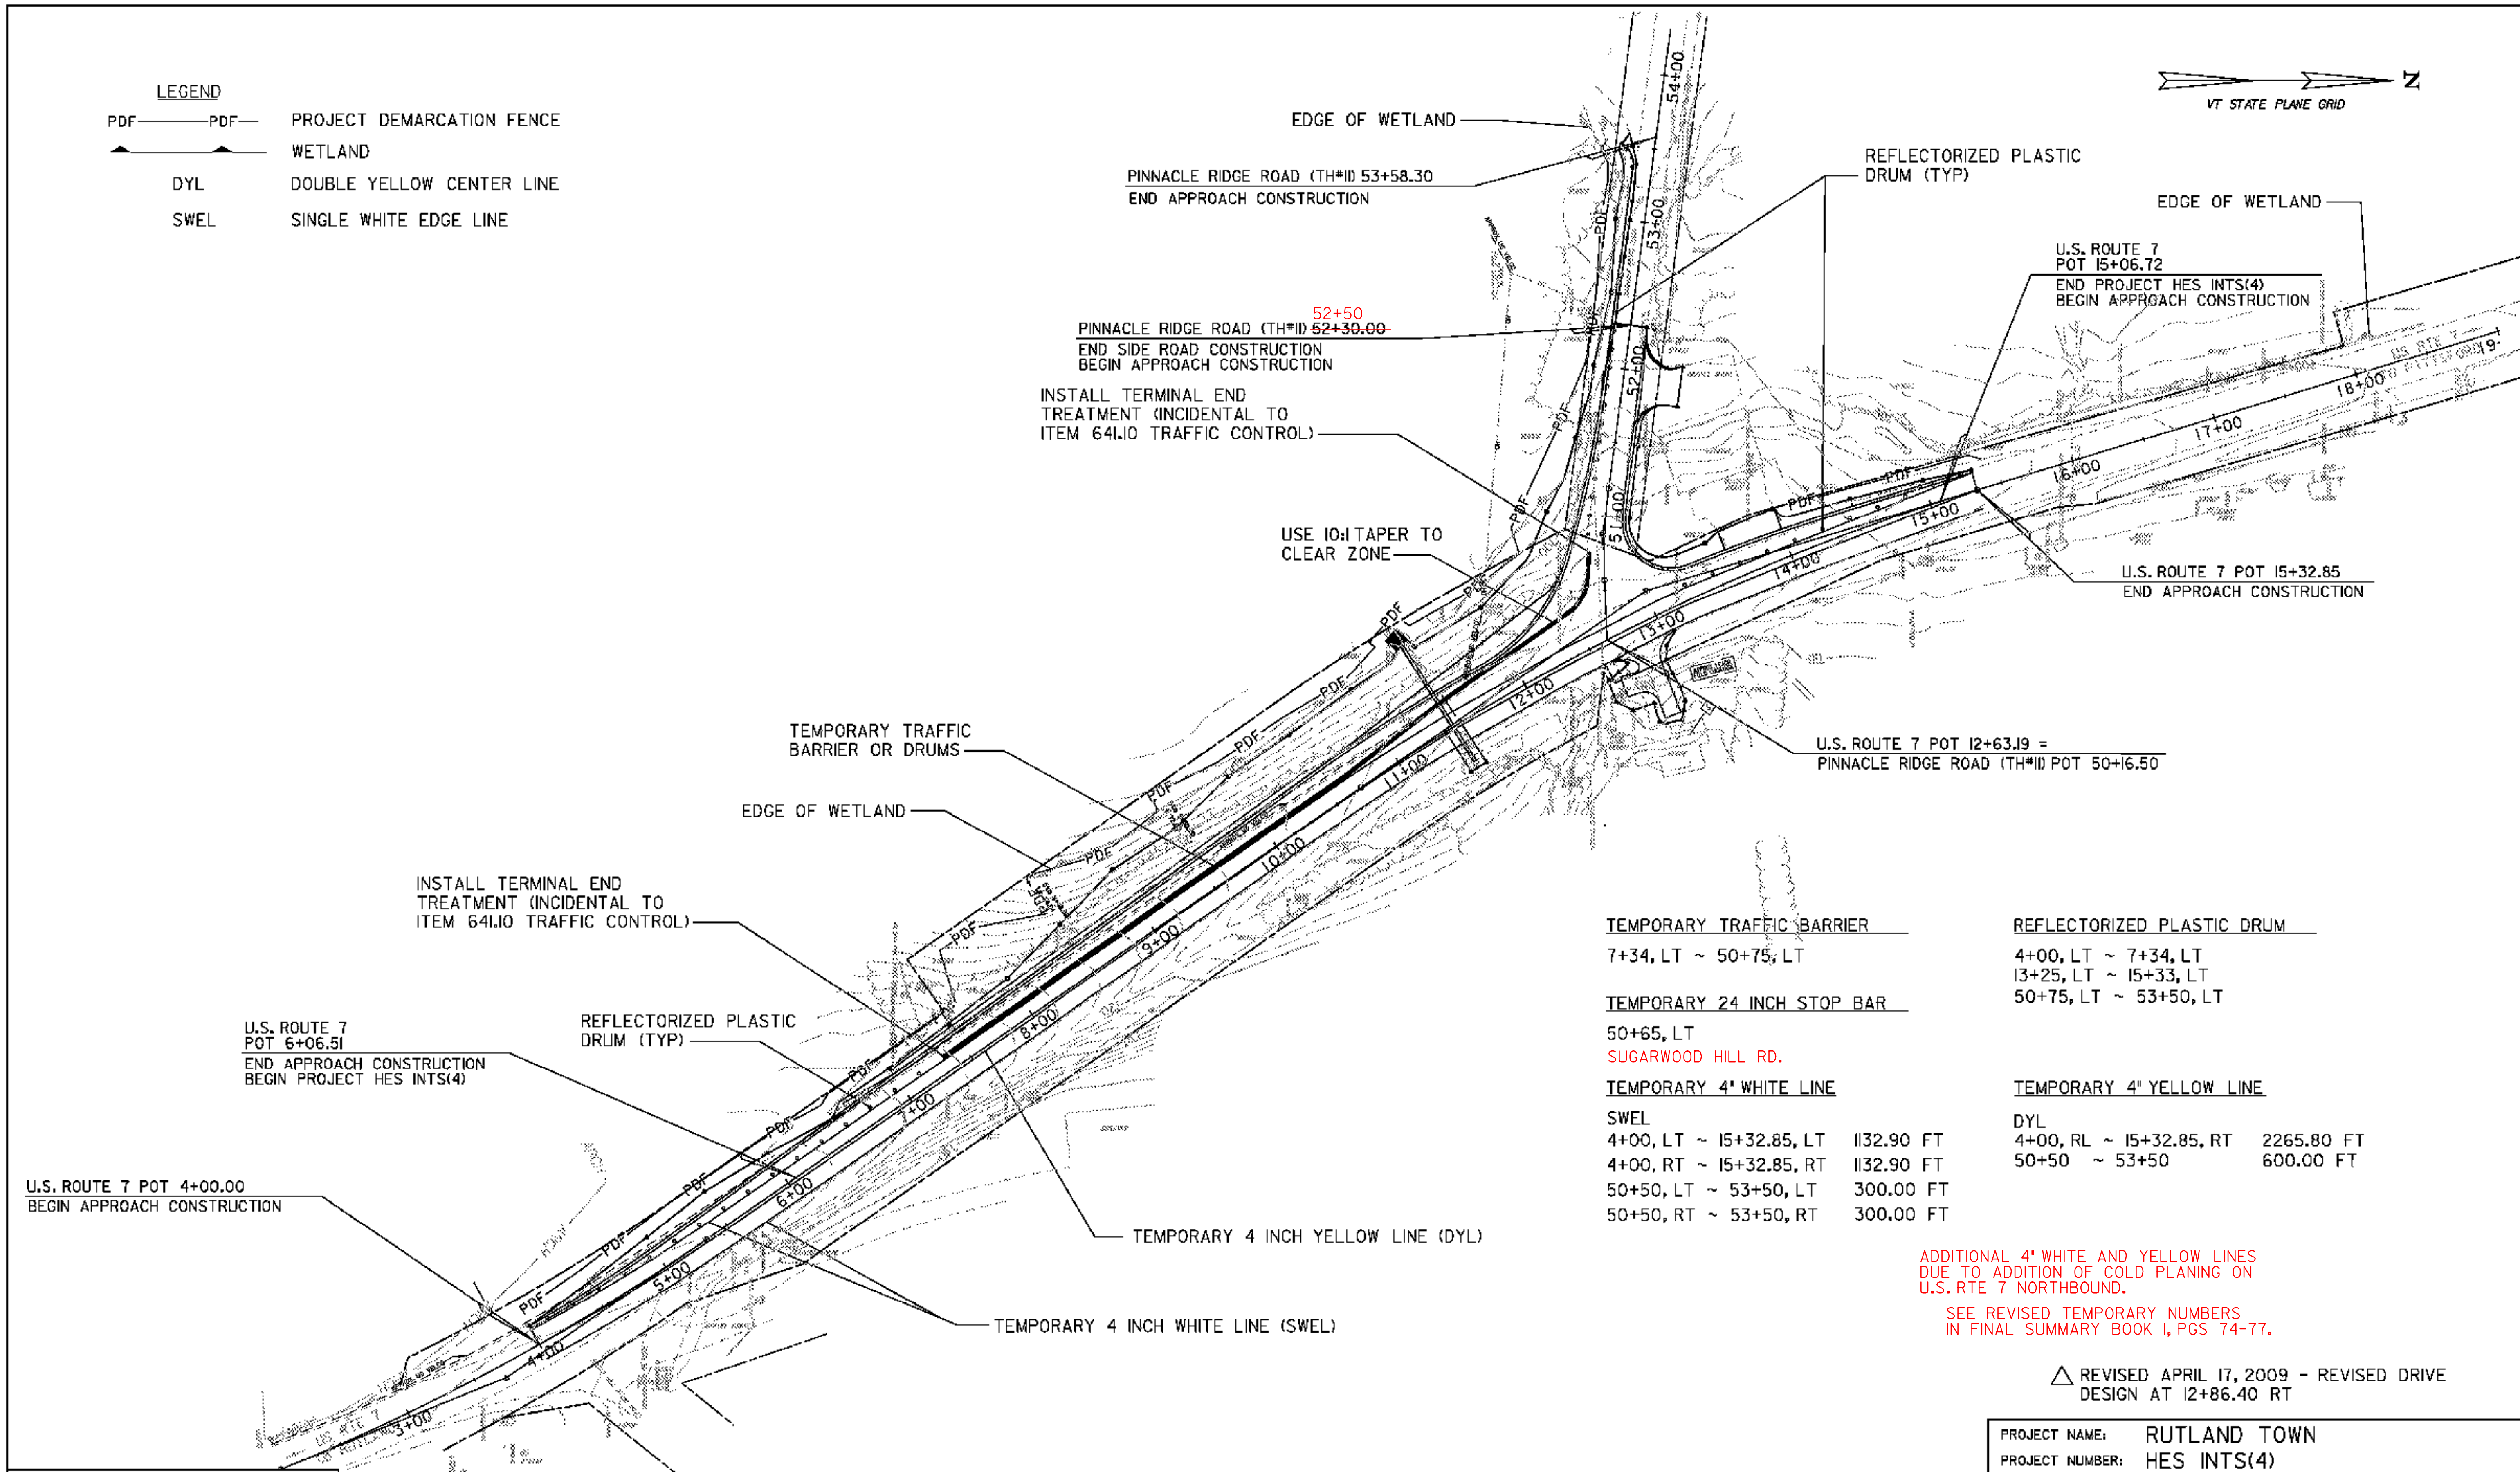

DATUM
 VERTICAL NAVD 88
 HORIZONTAL NAD 83(1992)

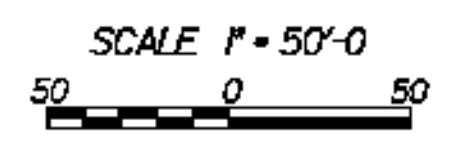

TEMPORARY TRAFFIC BARRIER	REFLECTORIZED PLASTIC DRUM
7+34, LT ~ 50+75, LT	4+00, LT ~ 7+34, LT
TEMPORARY 24 INCH STOP BAR	13+25, LT ~ 15+33, LT
50+65, LT	50+75, LT ~ 53+50, LT
TEMPORARY 4" WHITE LINE	TEMPORARY 4" YELLOW LINE
SWEL	DYL
4+00, LT ~ 15+32.85, LT 1132.90 FT	4+00, RL ~ 15+32.85, RT 2265.80 FT
4+00, RT ~ 15+32.85, RT 1132.90 FT	50+50 ~ 53+50 600.00 FT
50+50, LT ~ 53+50, LT 300.00 FT	
50+50, RT ~ 53+50, RT 300.00 FT	

ADDITIONAL 4" WHITE AND YELLOW LINES
 DUE TO ADDITION OF COLD PLANING ON
 U.S. RTE 7 NORTHBOUND.
 SEE REVISED TEMPORARY NUMBERS
 IN FINAL SUMMARY BOOK 1, PGS 74-77.

△ REVISED APRIL 17, 2009 - REVISED DRIVE
 DESIGN AT 12+86.40 RT

PROJECT NAME:	RUTLAND TOWN
PROJECT NUMBER:	HES INTS(4)
FILE NAME:	z05k114MT04.dgn
PROJECT LEADER:	DWB
DESIGNED BY:	TSK
MAINTENANCE OF TRAFFIC (3)	
PLOT DATE:	4/20/2009
DRAWN BY:	TSK
CHECKED BY:	DWB
SHEET NO.	23 OF 36