


EXISTING SIGNING

SIGN LEGEND

- R&S - REMOVE AND SALVAGE
- RET - RETAIN
- R - REMOVE
- [] - EXISTING SIGN ASSEMBLY

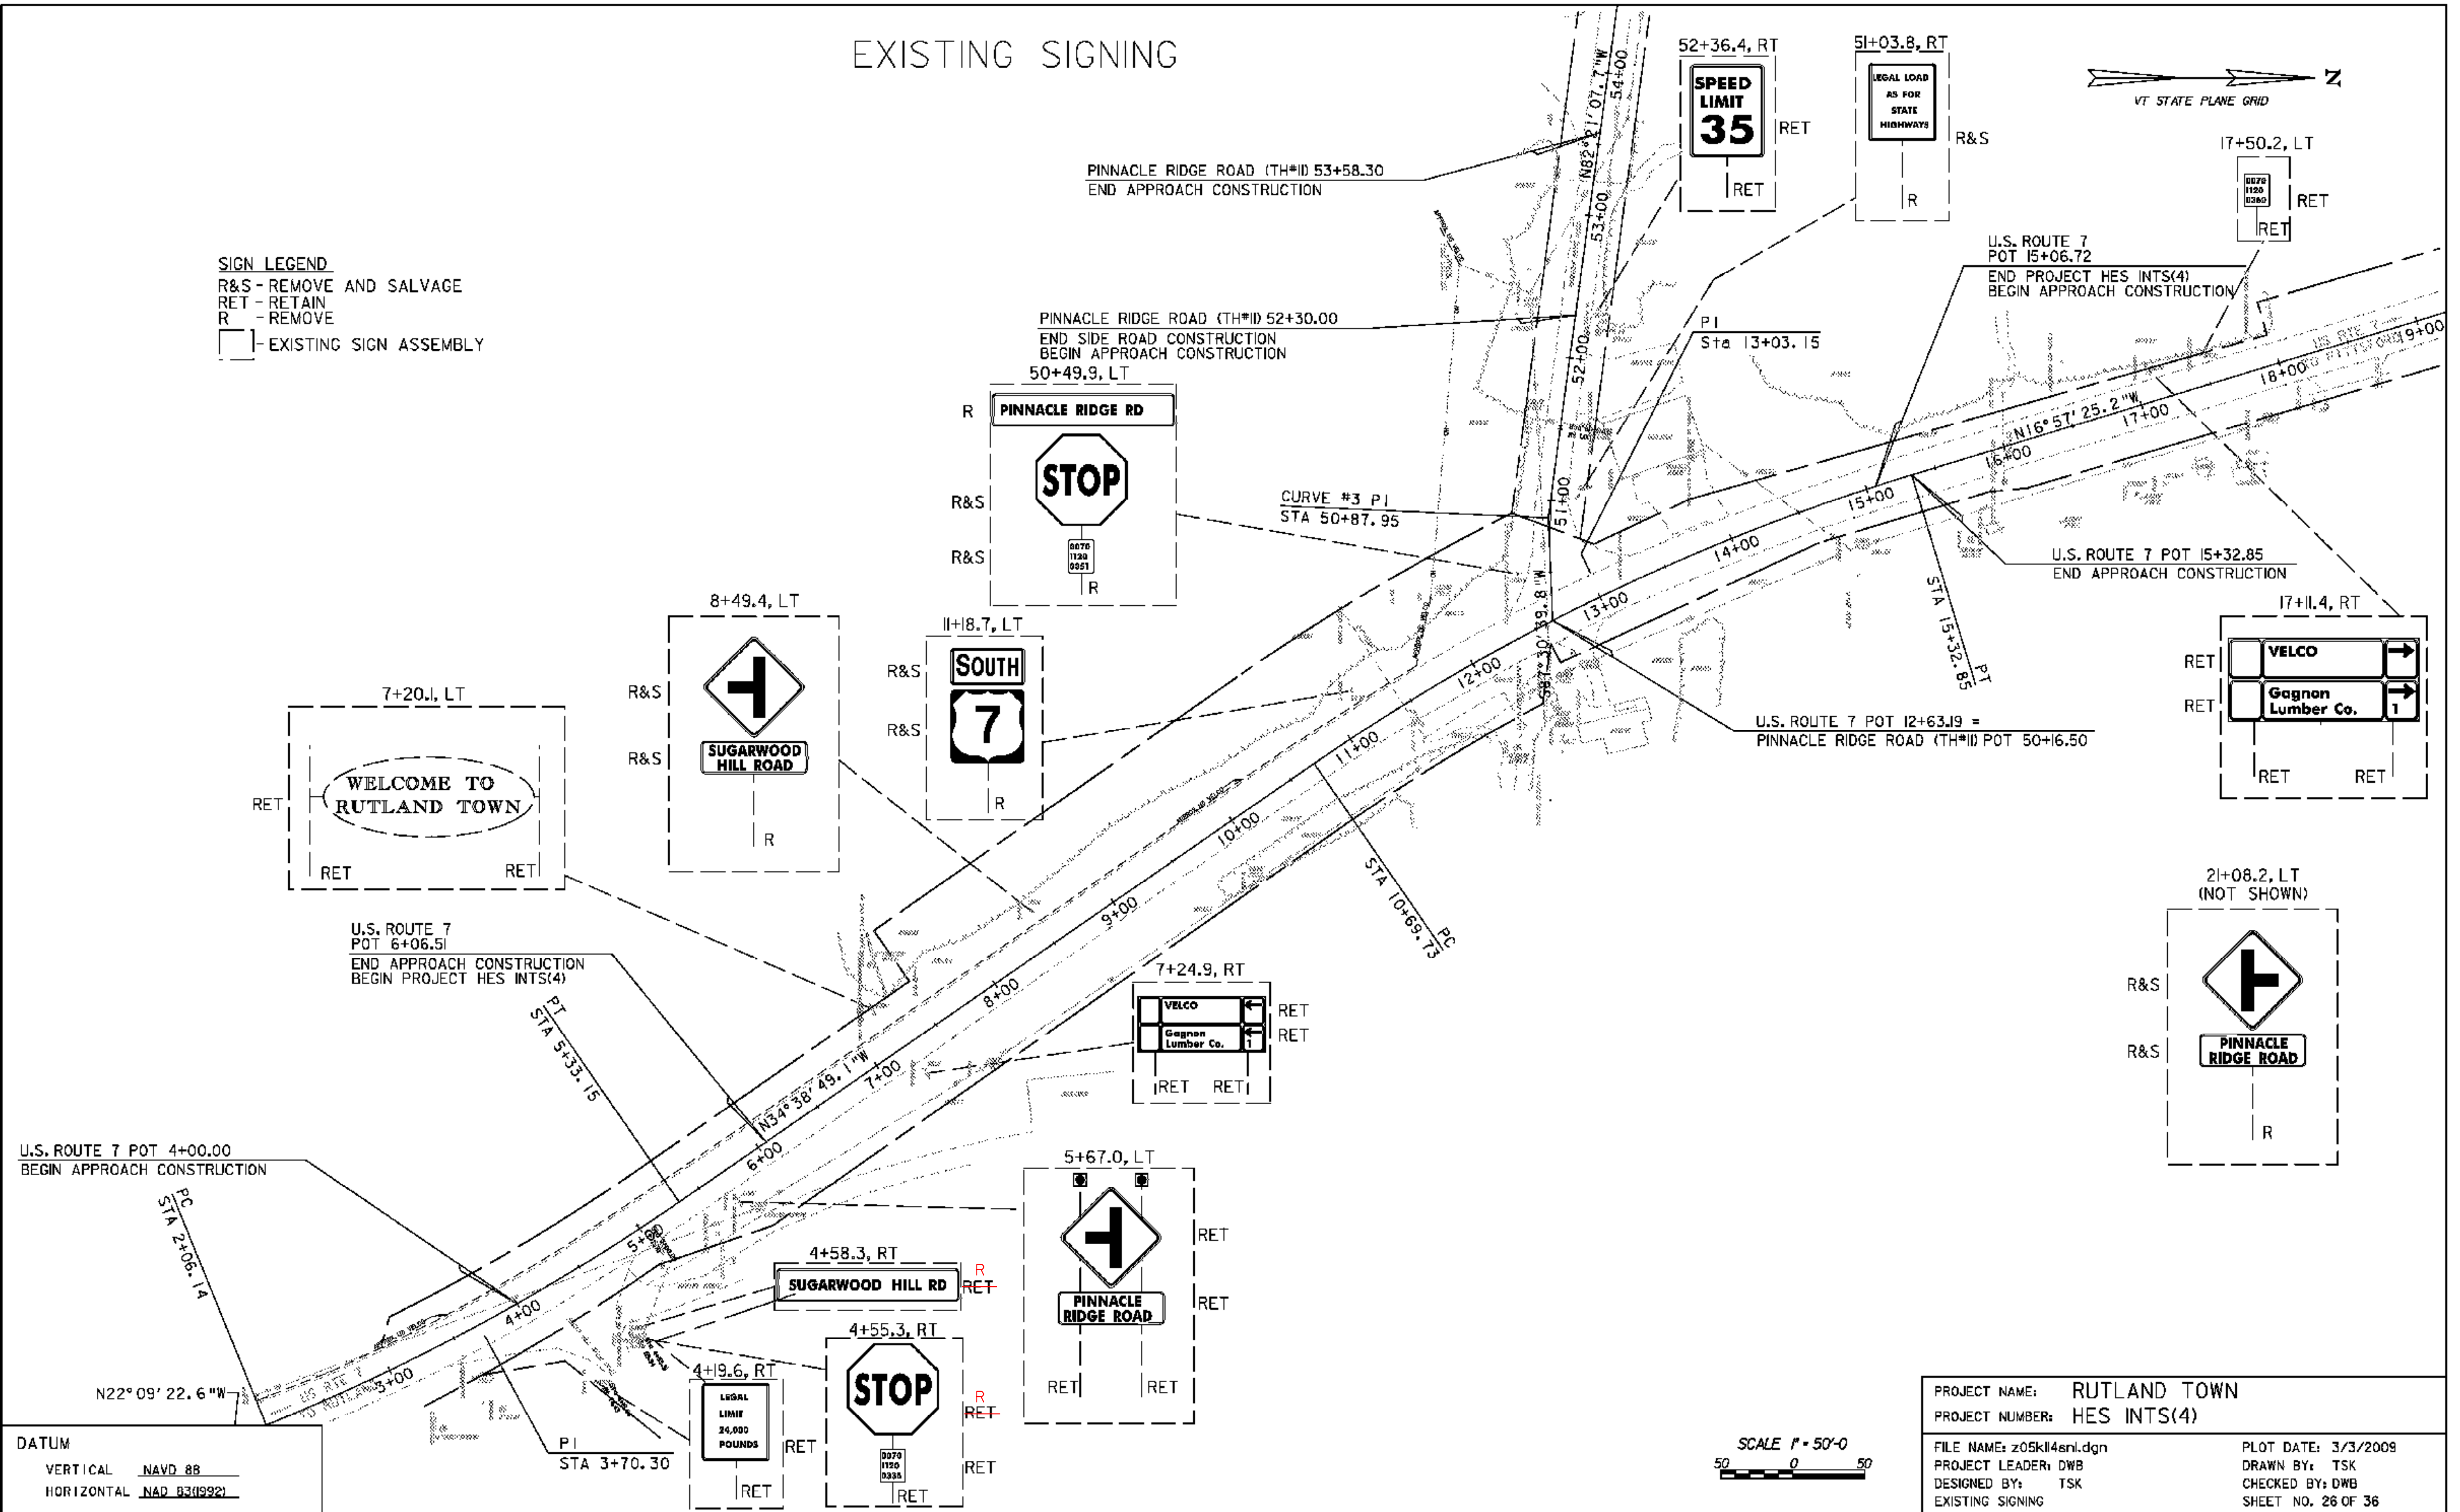

DATUM
 VERTICAL NAVD 88
 HORIZONTAL NAD 83(1992)

PROJECT NAME: RUTLAND TOWN
 PROJECT NUMBER: HES INTS(4)
 FILE NAME: z05kl4enl.dgn
 PROJECT LEADER: DWB
 DESIGNED BY: TSK
 EXISTING SIGNING

PLOT DATE: 3/3/2009
 DRAWN BY: TSK
 CHECKED BY: DWB
 SHEET NO. 26 OF 36

