

NEW AND SALVAGED SIGNING AND PAVEMENT MARKINGS


SIGN LEGEND

- S - SALVAGED
- RET - RETAINED
- N - NEW
- [] - NEW SIGN ASSEMBLY
- [] - EXISTING SIGN ASSEMBLY

ALL SIGNS NOTED TO BE REMOVED AND SALVAGED SHALL BE INSTALLED ON NEW POSTS

STRIPING LEGEND

- SWEL - 4" SOLID WHITE EDGE LINE
- SWLL - 4" SOLID WHITE LANE LINE
- SL - 24" STOP LINE
- YTL* - 8" YELLOW TRAVERSE LINE
- DYL - 4" DOUBLE YELLOW LINE
- DWLL - 4" DOTTED WHITE LANE LINE
- * 10' ON CENTER AT 45 DEGREES SEE STD. E-192

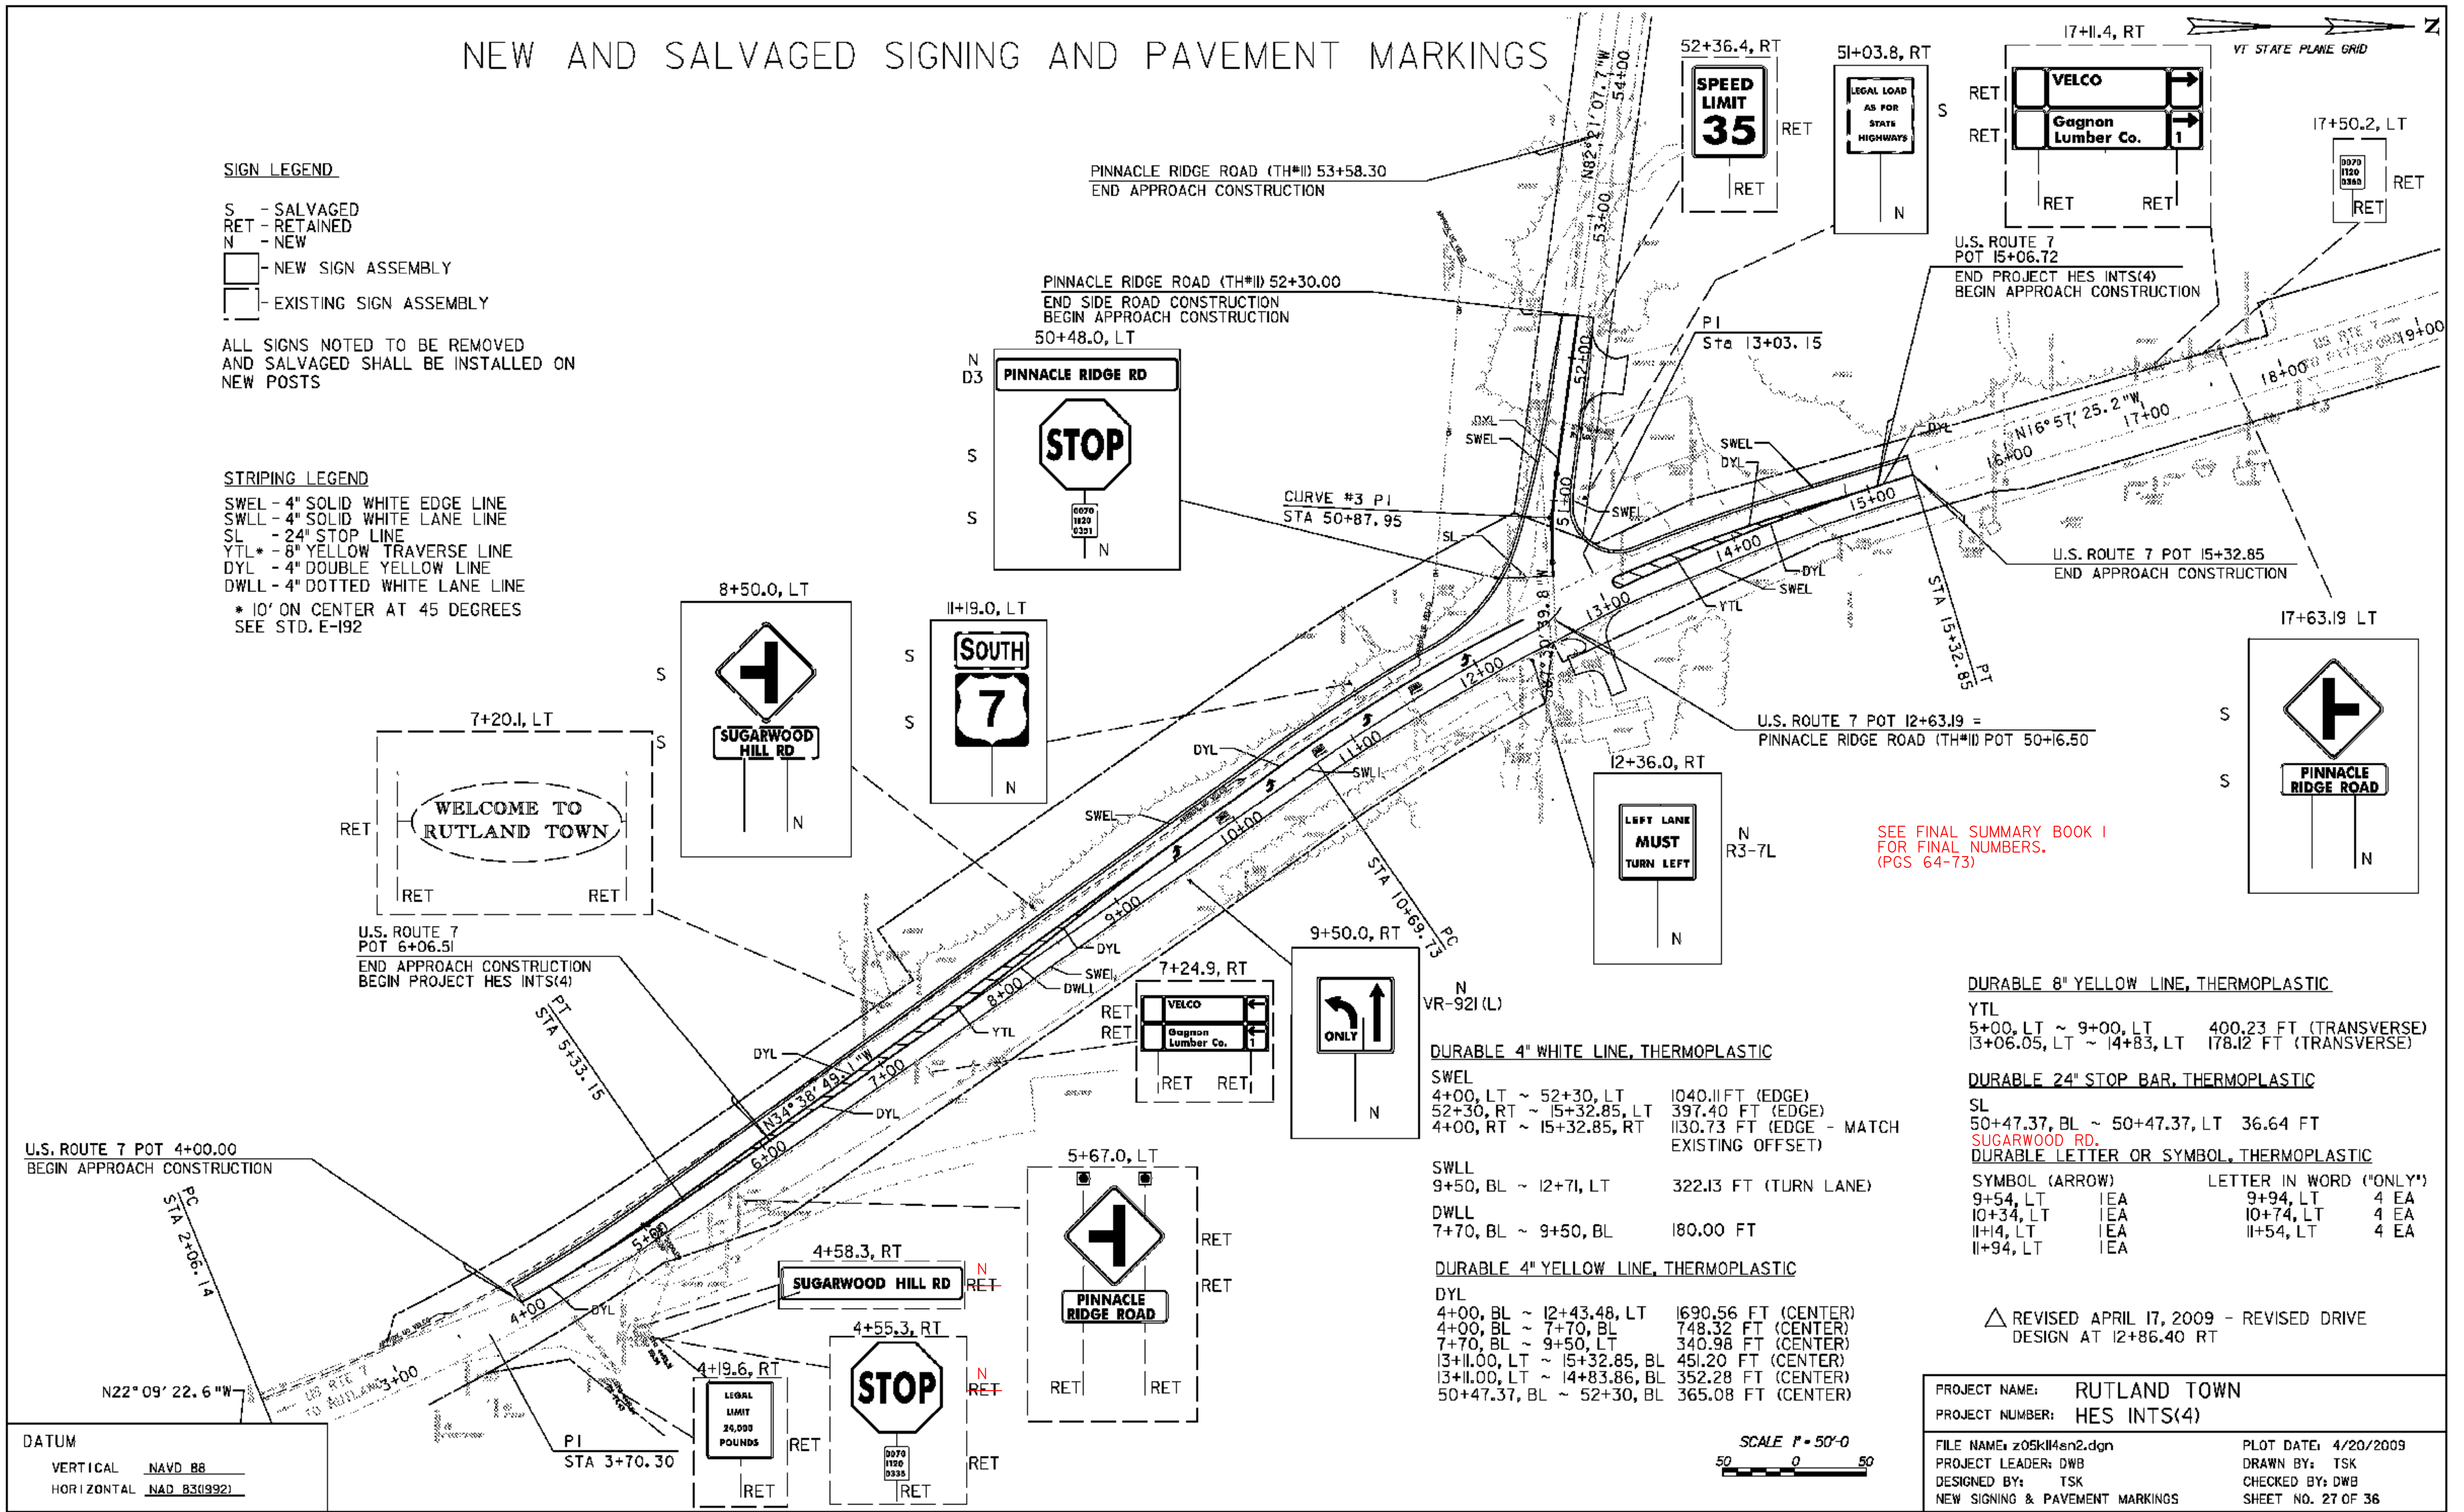

SEE FINAL SUMMARY BOOK 1 FOR FINAL NUMBERS. (PGS 64-73)

DURABLE 8" YELLOW LINE, THERMOPLASTIC	
YTL	
5+00, LT ~ 9+00, LT	400.23 FT (TRANSVERSE)
13+06.05, LT ~ 14+83, LT	178.12 FT (TRANSVERSE)
DURABLE 24" STOP BAR, THERMOPLASTIC	
SL	
50+47.37, BL ~ 50+47.37, LT	36.64 FT
DURABLE LETTER OR SYMBOL, THERMOPLASTIC	
SYMBOL (ARROW)	LETTER IN WORD ("ONLY")
9+54, LT	EA
10+34, LT	EA
11+14, LT	EA
11+94, LT	EA
9+94, LT	4 EA
10+74, LT	4 EA
11+54, LT	4 EA

DURABLE 4" WHITE LINE, THERMOPLASTIC	
SWEL	
4+00, LT ~ 52+30, LT	1040.11 FT (EDGE)
52+30, RT ~ 15+32.85, LT	397.40 FT (EDGE)
4+00, RT ~ 15+32.85, RT	1130.73 FT (EDGE - MATCH EXISTING OFFSET)
SWLL	
9+50, BL ~ 12+71, LT	322.13 FT (TURN LANE)
DWLL	
7+70, BL ~ 9+50, BL	180.00 FT

DURABLE 4" YELLOW LINE, THERMOPLASTIC	
DYL	
4+00, BL ~ 12+43.48, LT	1690.56 FT (CENTER)
4+00, BL ~ 7+70, BL	748.32 FT (CENTER)
7+70, BL ~ 9+50, LT	340.98 FT (CENTER)
13+11.00, LT ~ 15+32.85, BL	451.20 FT (CENTER)
13+11.00, LT ~ 14+83.86, BL	352.28 FT (CENTER)
50+47.37, BL ~ 52+30, BL	365.08 FT (CENTER)

△ REVISED APRIL 17, 2009 - REVISED DRIVE DESIGN AT 12+86.40 RT

PROJECT NAME:	RUTLAND TOWN	PLOT DATE:	4/20/2009
PROJECT NUMBER:	HES INTS(4)	DRAWN BY:	TSK
FILE NAME:	z05k14n2.dgn	CHECKED BY:	DWB
PROJECT LEADER:	DWB	DESIGNED BY:	TSK
NEW SIGNING & PAVEMENT MARKINGS		SHEET NO.	27 OF 36

DATUM
VERTICAL NAVD 88
HORIZONTAL NAD 83(1992)

