



U.S. ROUTE 7 CONSTRUCTION CENTERLINE
12+50 13+00

12+50

13+00

STA. 12+59.47,
26.52' RT
ELEV. 709.885

STA. 12+57.94,
40.47' RT
ELEV. 710.165

STA. 12+69.86,
28.22' RT

STA. 12+67.21,
41.98' RT

STA. 12+75.84,
52.83' RT

STA. 12+89.25,
30.88' RT

COMB
POLE
5' MIN NO
DISTURBANCE
AREA

DO NOT DISTURB
EXISTING TANK

PROpane TANK

GRAVEL
DRIVE

10' MIN NO
DISTURBANCE
AREA

APPROX. LEACH
FIELD LOCATION

WOODS

GRASS


- FINAL EXCAVATION AND DRIVEWAY CONSTRUCTION
LIMITS ADJUSTED IN THE FIELD DUE TO FIELD
CONDITIONS FROM PERCHED WATER DRAINAGE
AND LOCATION OF LEACH FIELD.

△ REVISED APRIL 17, 2009 - REVISED DRIVE
DESIGN AT 12+86.40 RT AND REMOVED
PRECAST CONCRETE GRAVITY RETAINING
WALL DETAILS AND NOTES

PROJECT NAME:	RUTLAND TOWN	FILE NAME:	z05k14RET.dgn	PLOT DATE:	4/20/2009
PROJECT NUMBER:	HES INTS(4)	PROJECT LEADER:	DWB	DRAWN BY:	DWB
		DESIGNED BY:	DWB	CHECKED BY:	JKO
		EUBER DRIVE LAYOUT - STA. 12+86.40 RT		SHEET	29 OF 36

DATUM
VERTICAL NAVD 88
HORIZONTAL NAD 83(1992)

SCALE 1" = 10'-0"

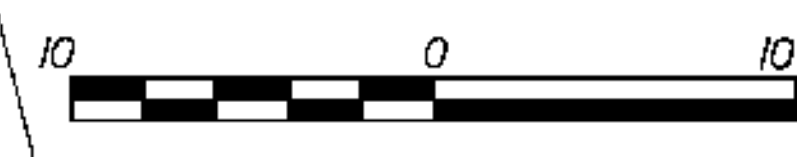

HOUSE

GRASS

MED
BOX
ELDER

