




- COLD PLANE 1 1/2" AND SUPERPAVE BITUMINOUS CONCRETE PAVEMENT FROM STA 6+50 RT TO 8+00 RT.
- EXTENDED LIMITS OF EXCAVATION, SAND BORROW, AND DENSE GRADED FROM STA 6+50 LT TO 8+00 LT.

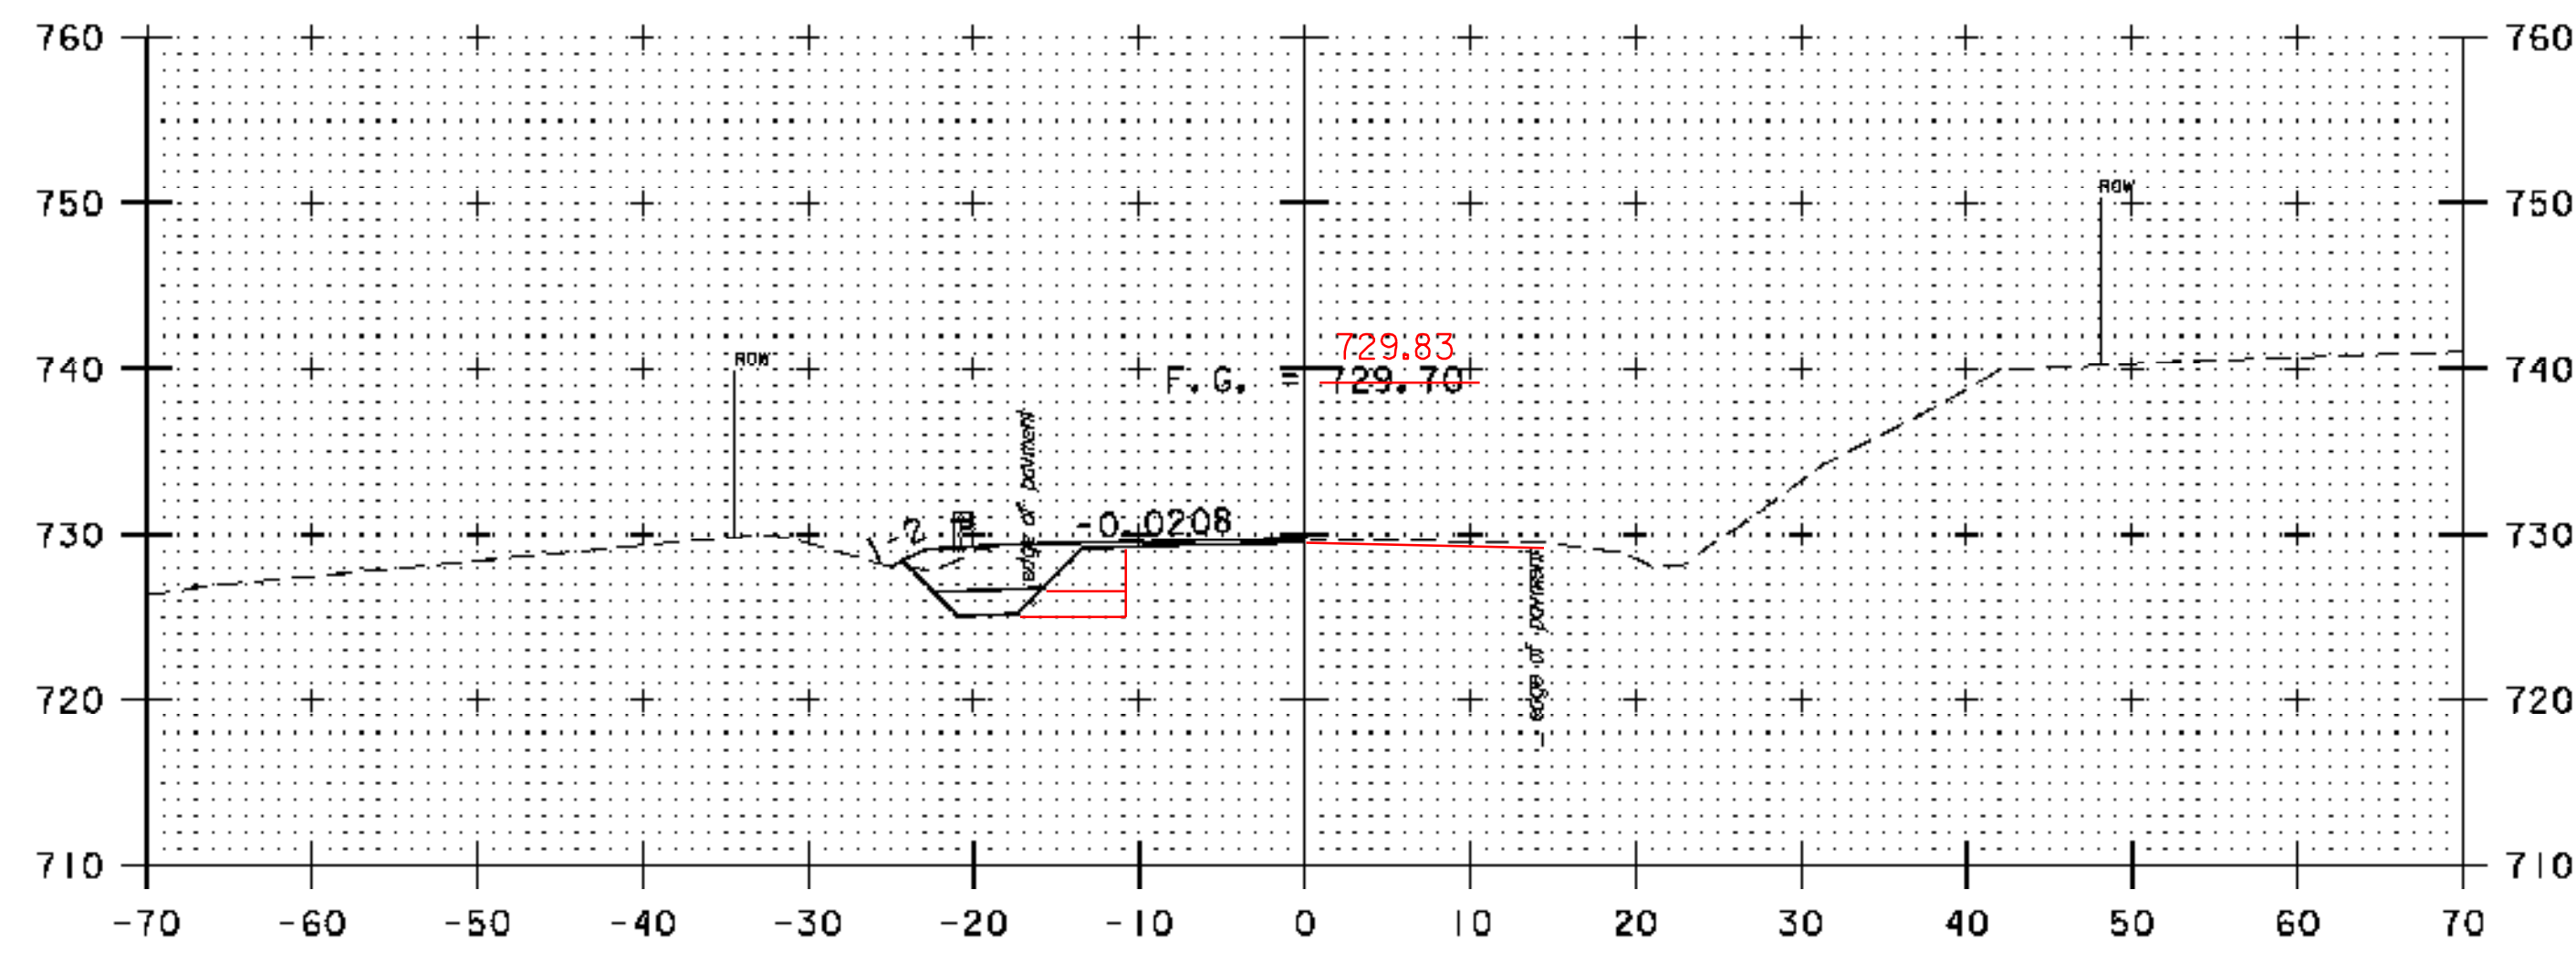


7+00

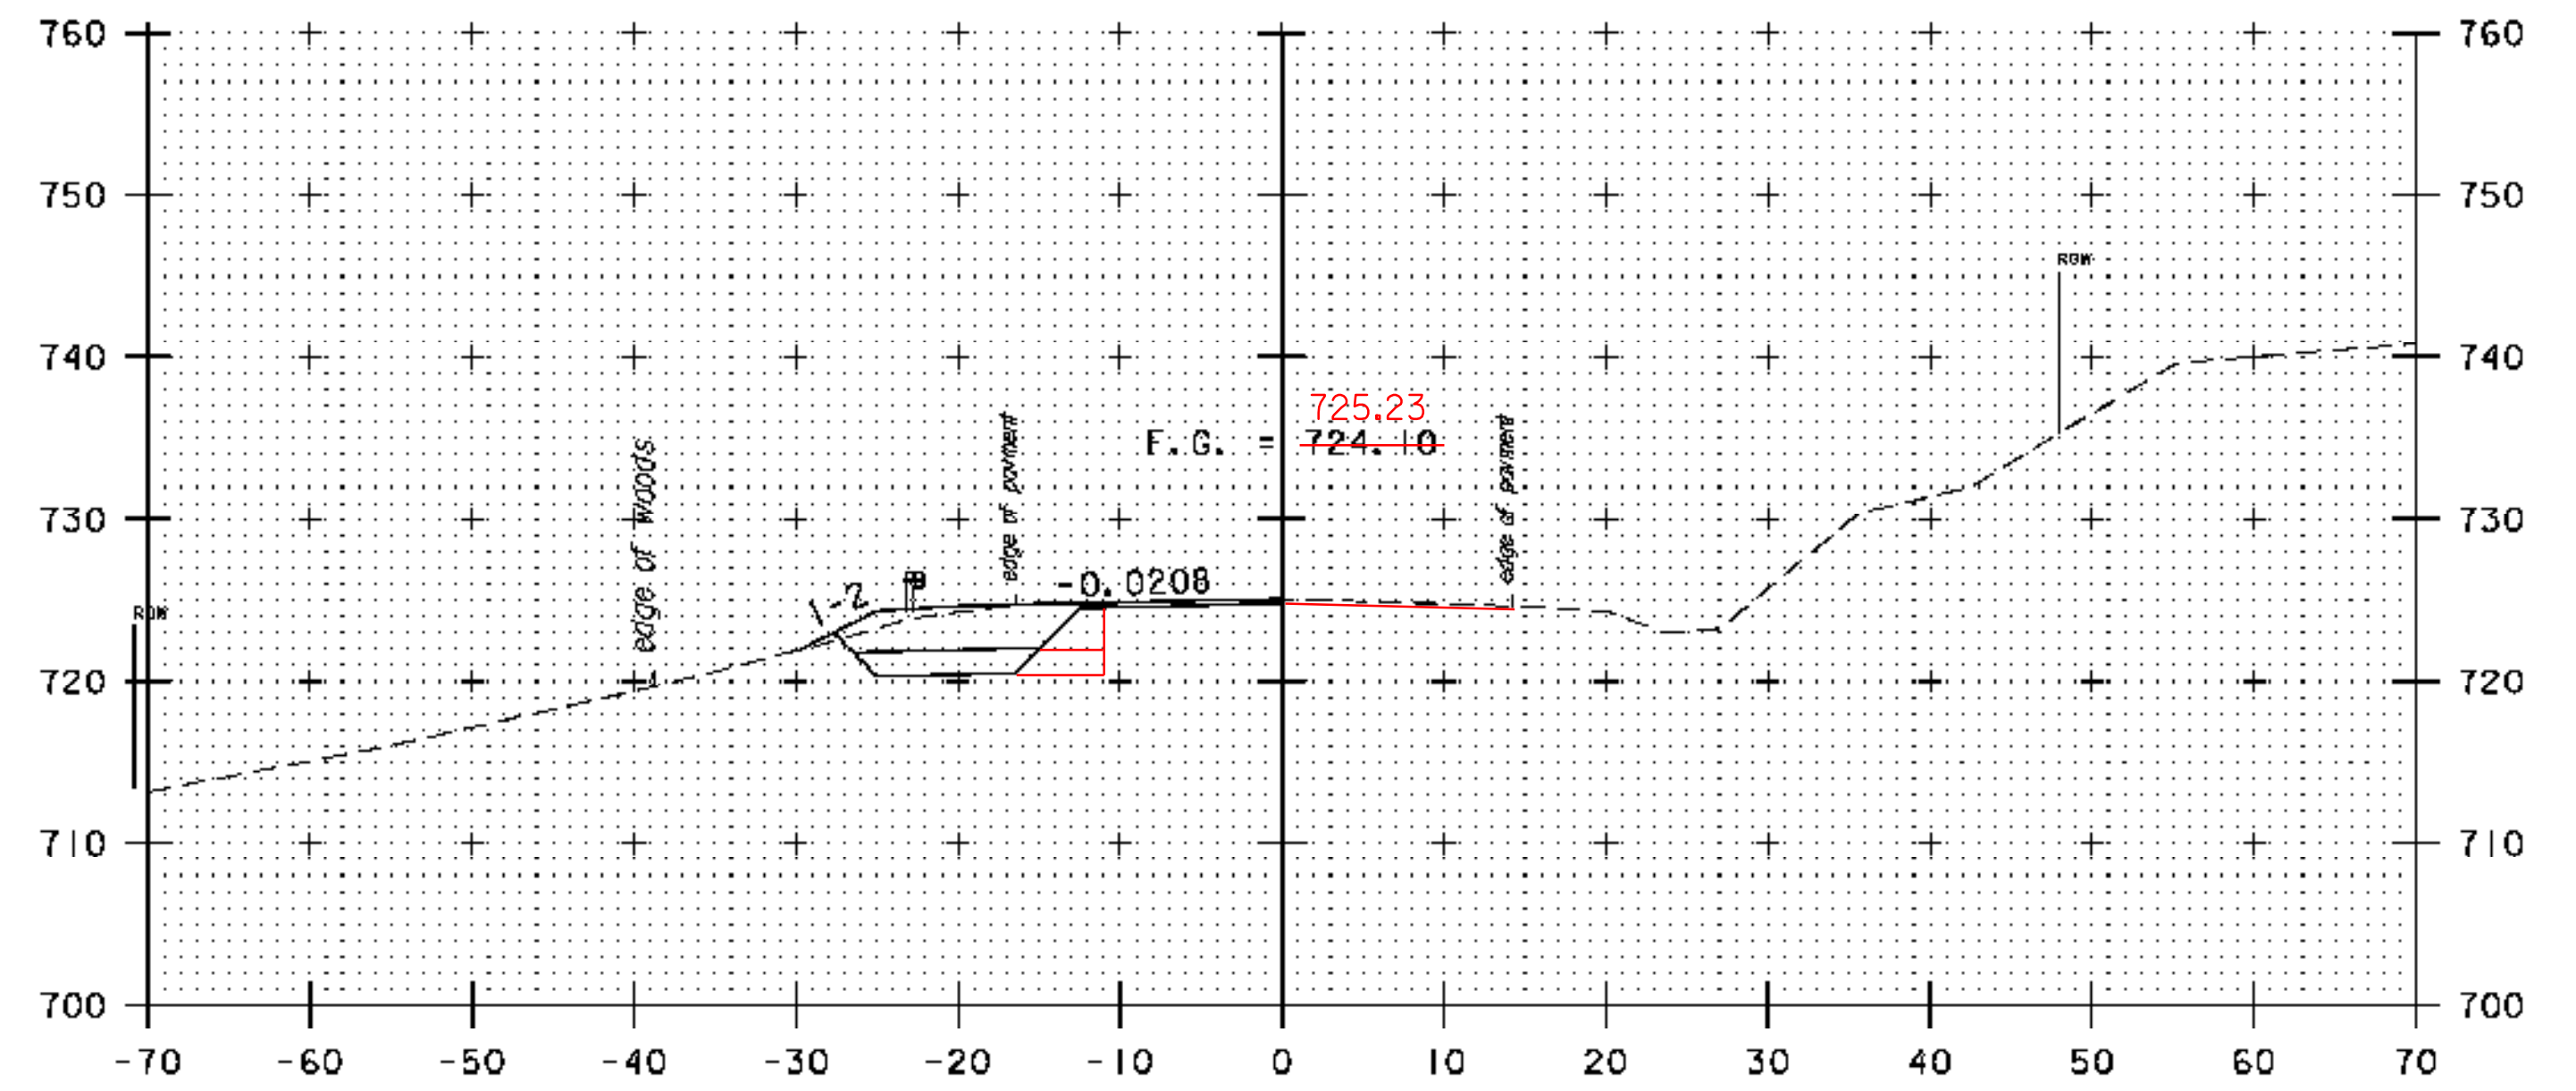

8+00

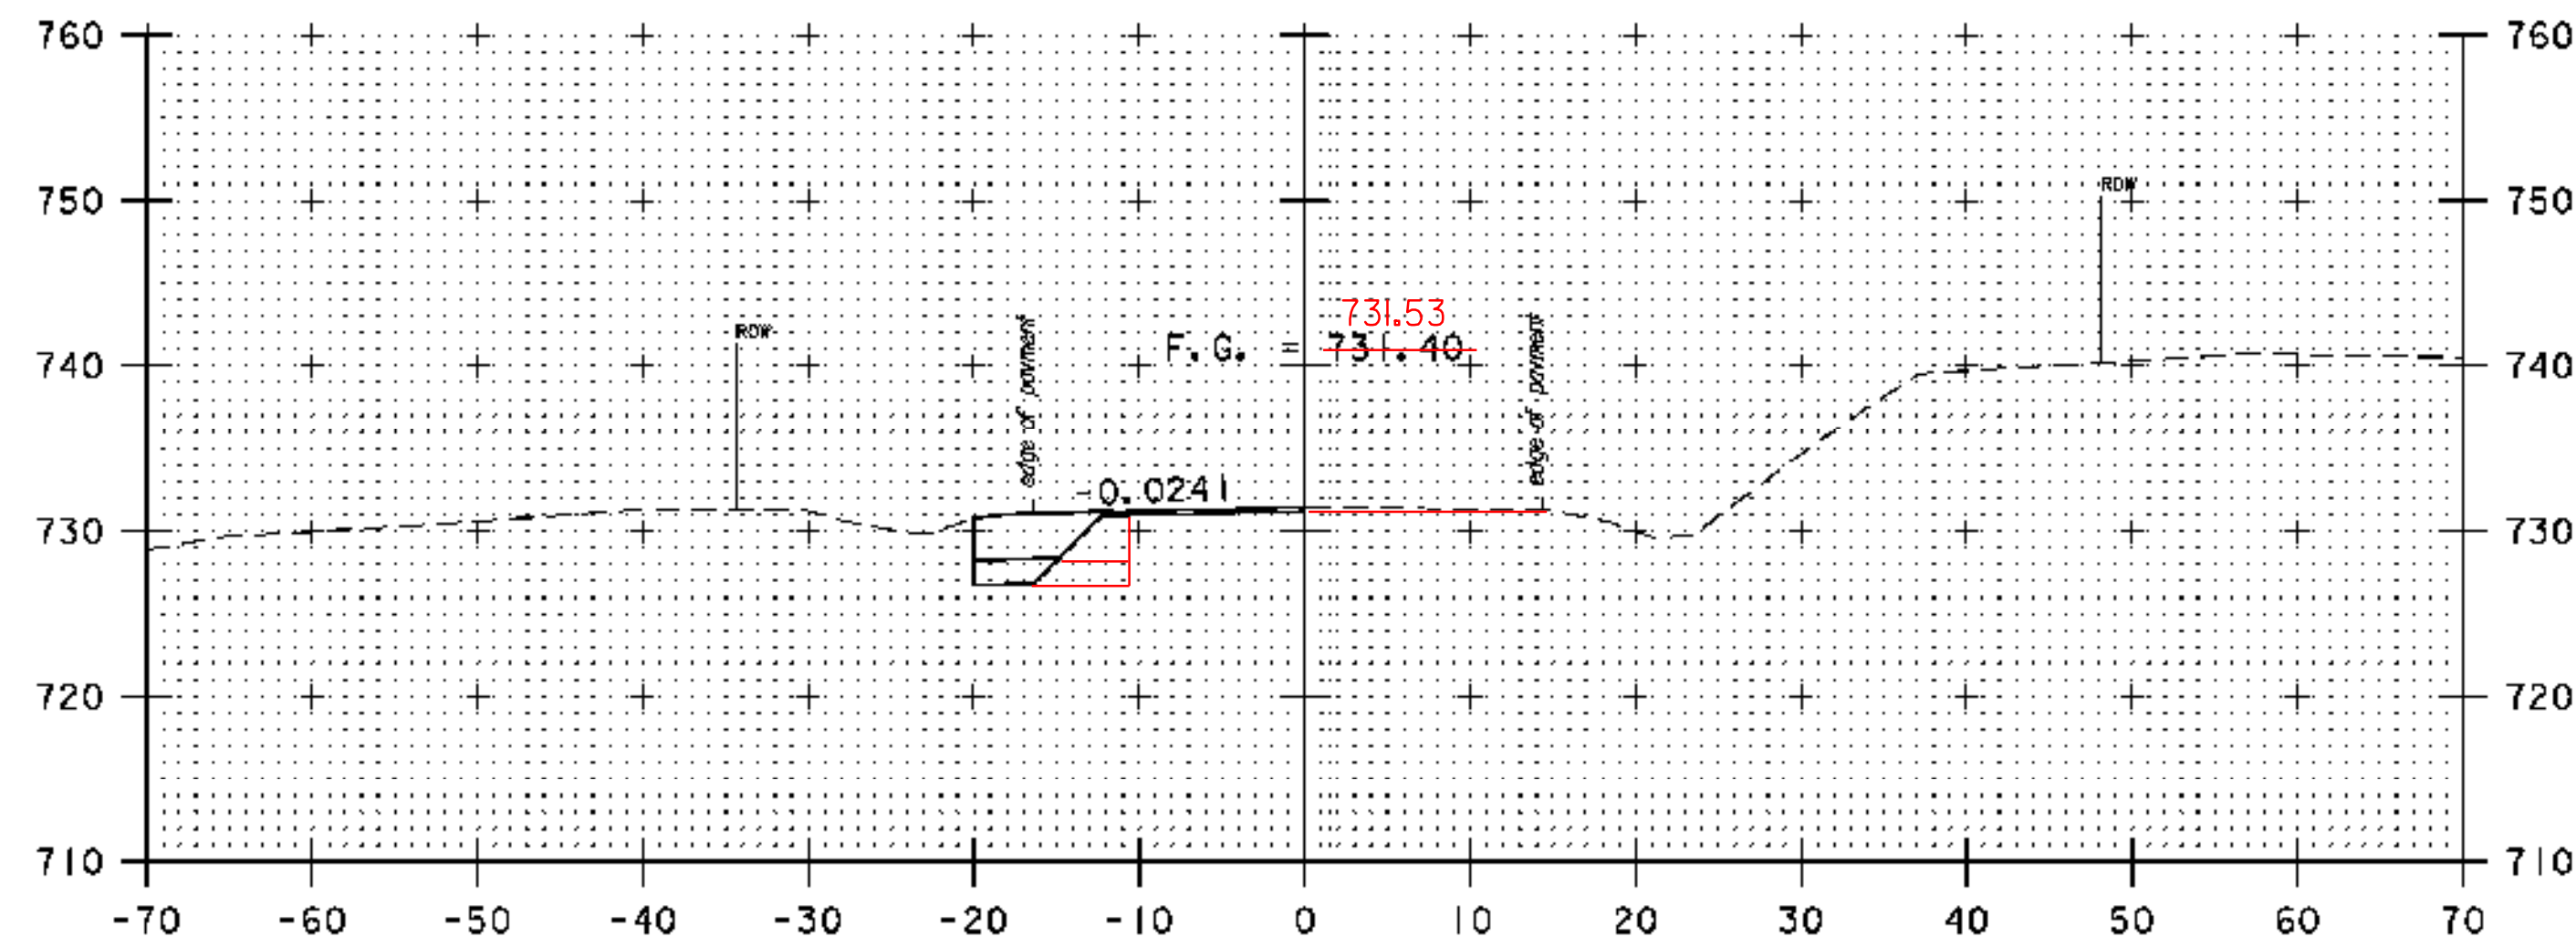

6+50

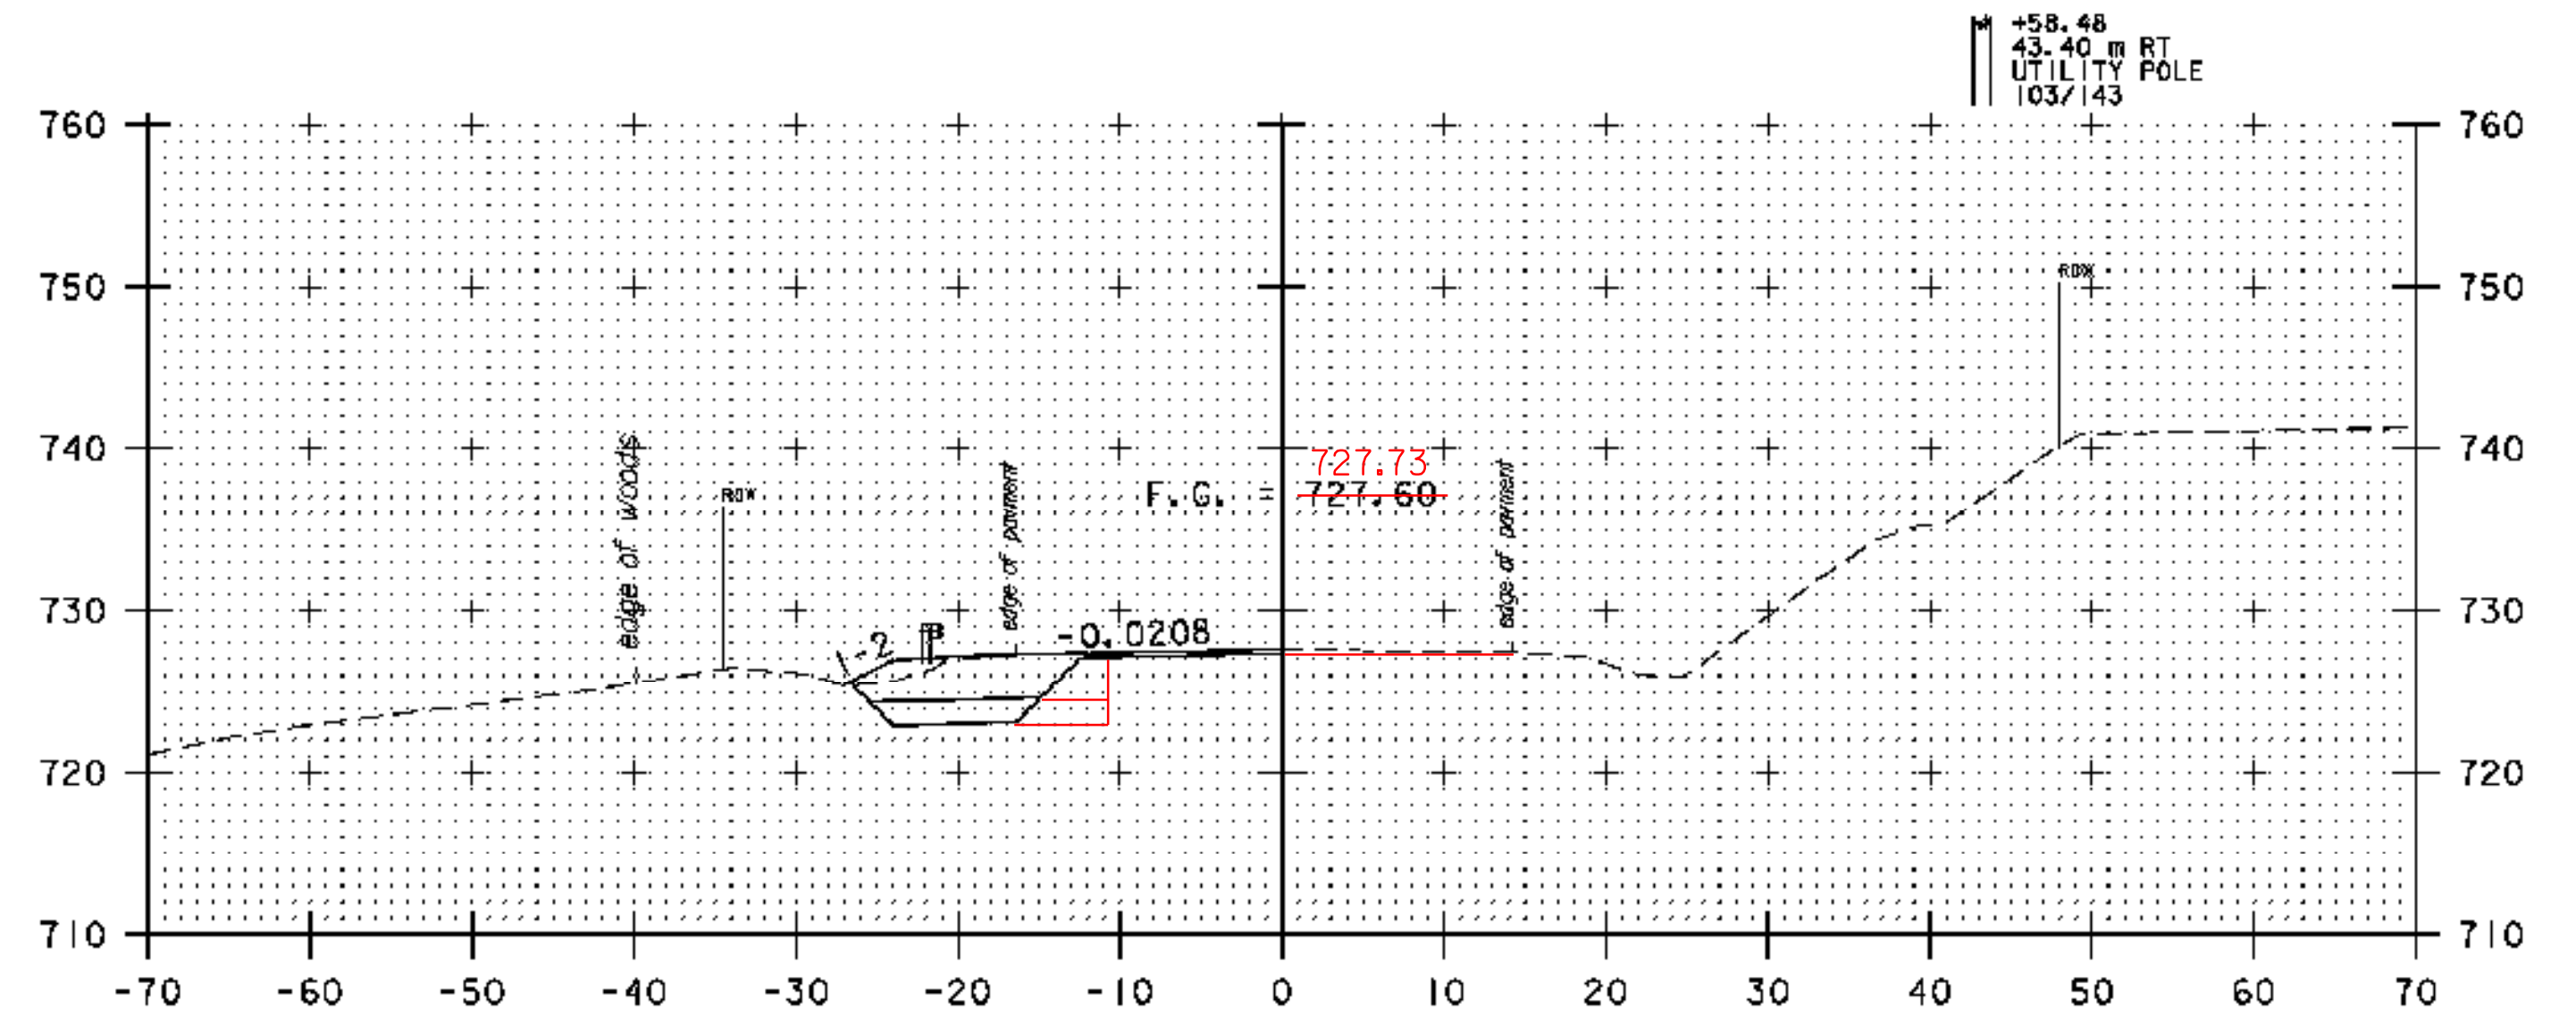

7+50

STA. 6+50 TO STA. 8+00	
PROJECT NAME:	RUTLAND TOWN
PROJECT NUMBER:	HES INTS(4)
FILE NAME: z05k14XS1.dgn	PLOT DATE: 3/3/2009
PROJECT LEADER: DWB	DRAWN BY: TSK
DESIGNED BY: TSK	CHECKED BY: DWB
CROSS SECTIONS, ROUTE 7 (2)	SHEET NO. 31 OF 36

