
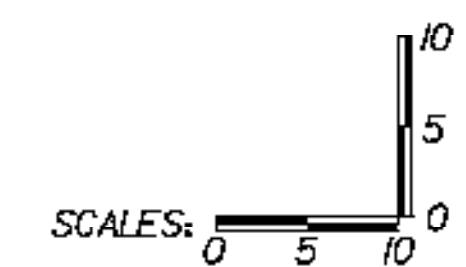
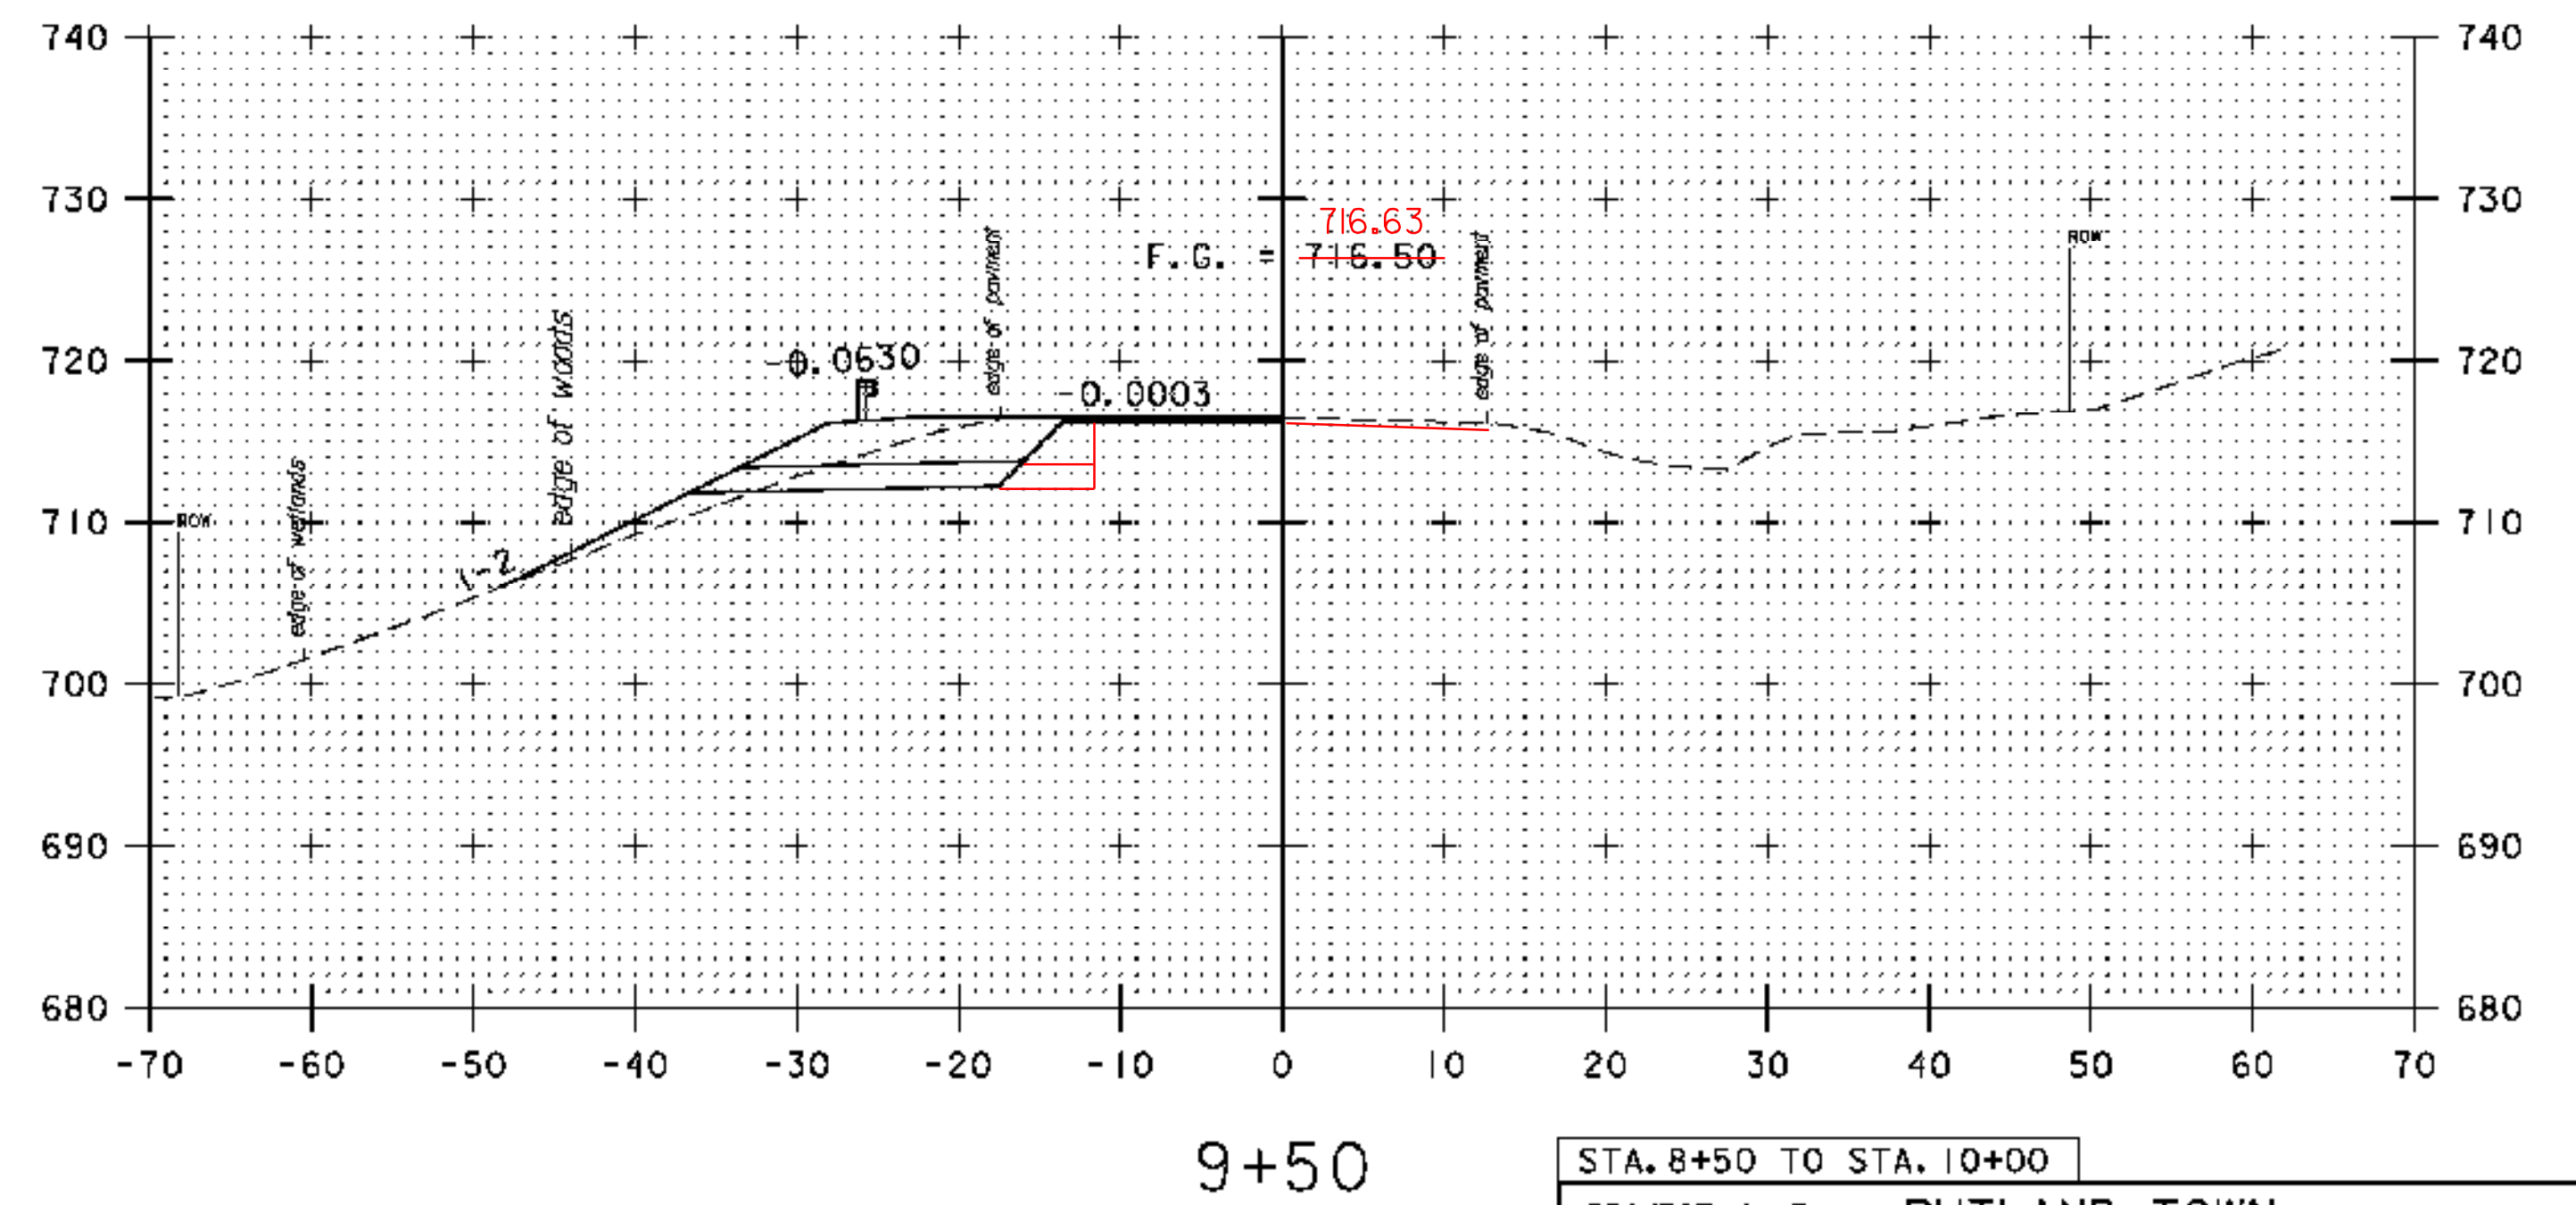
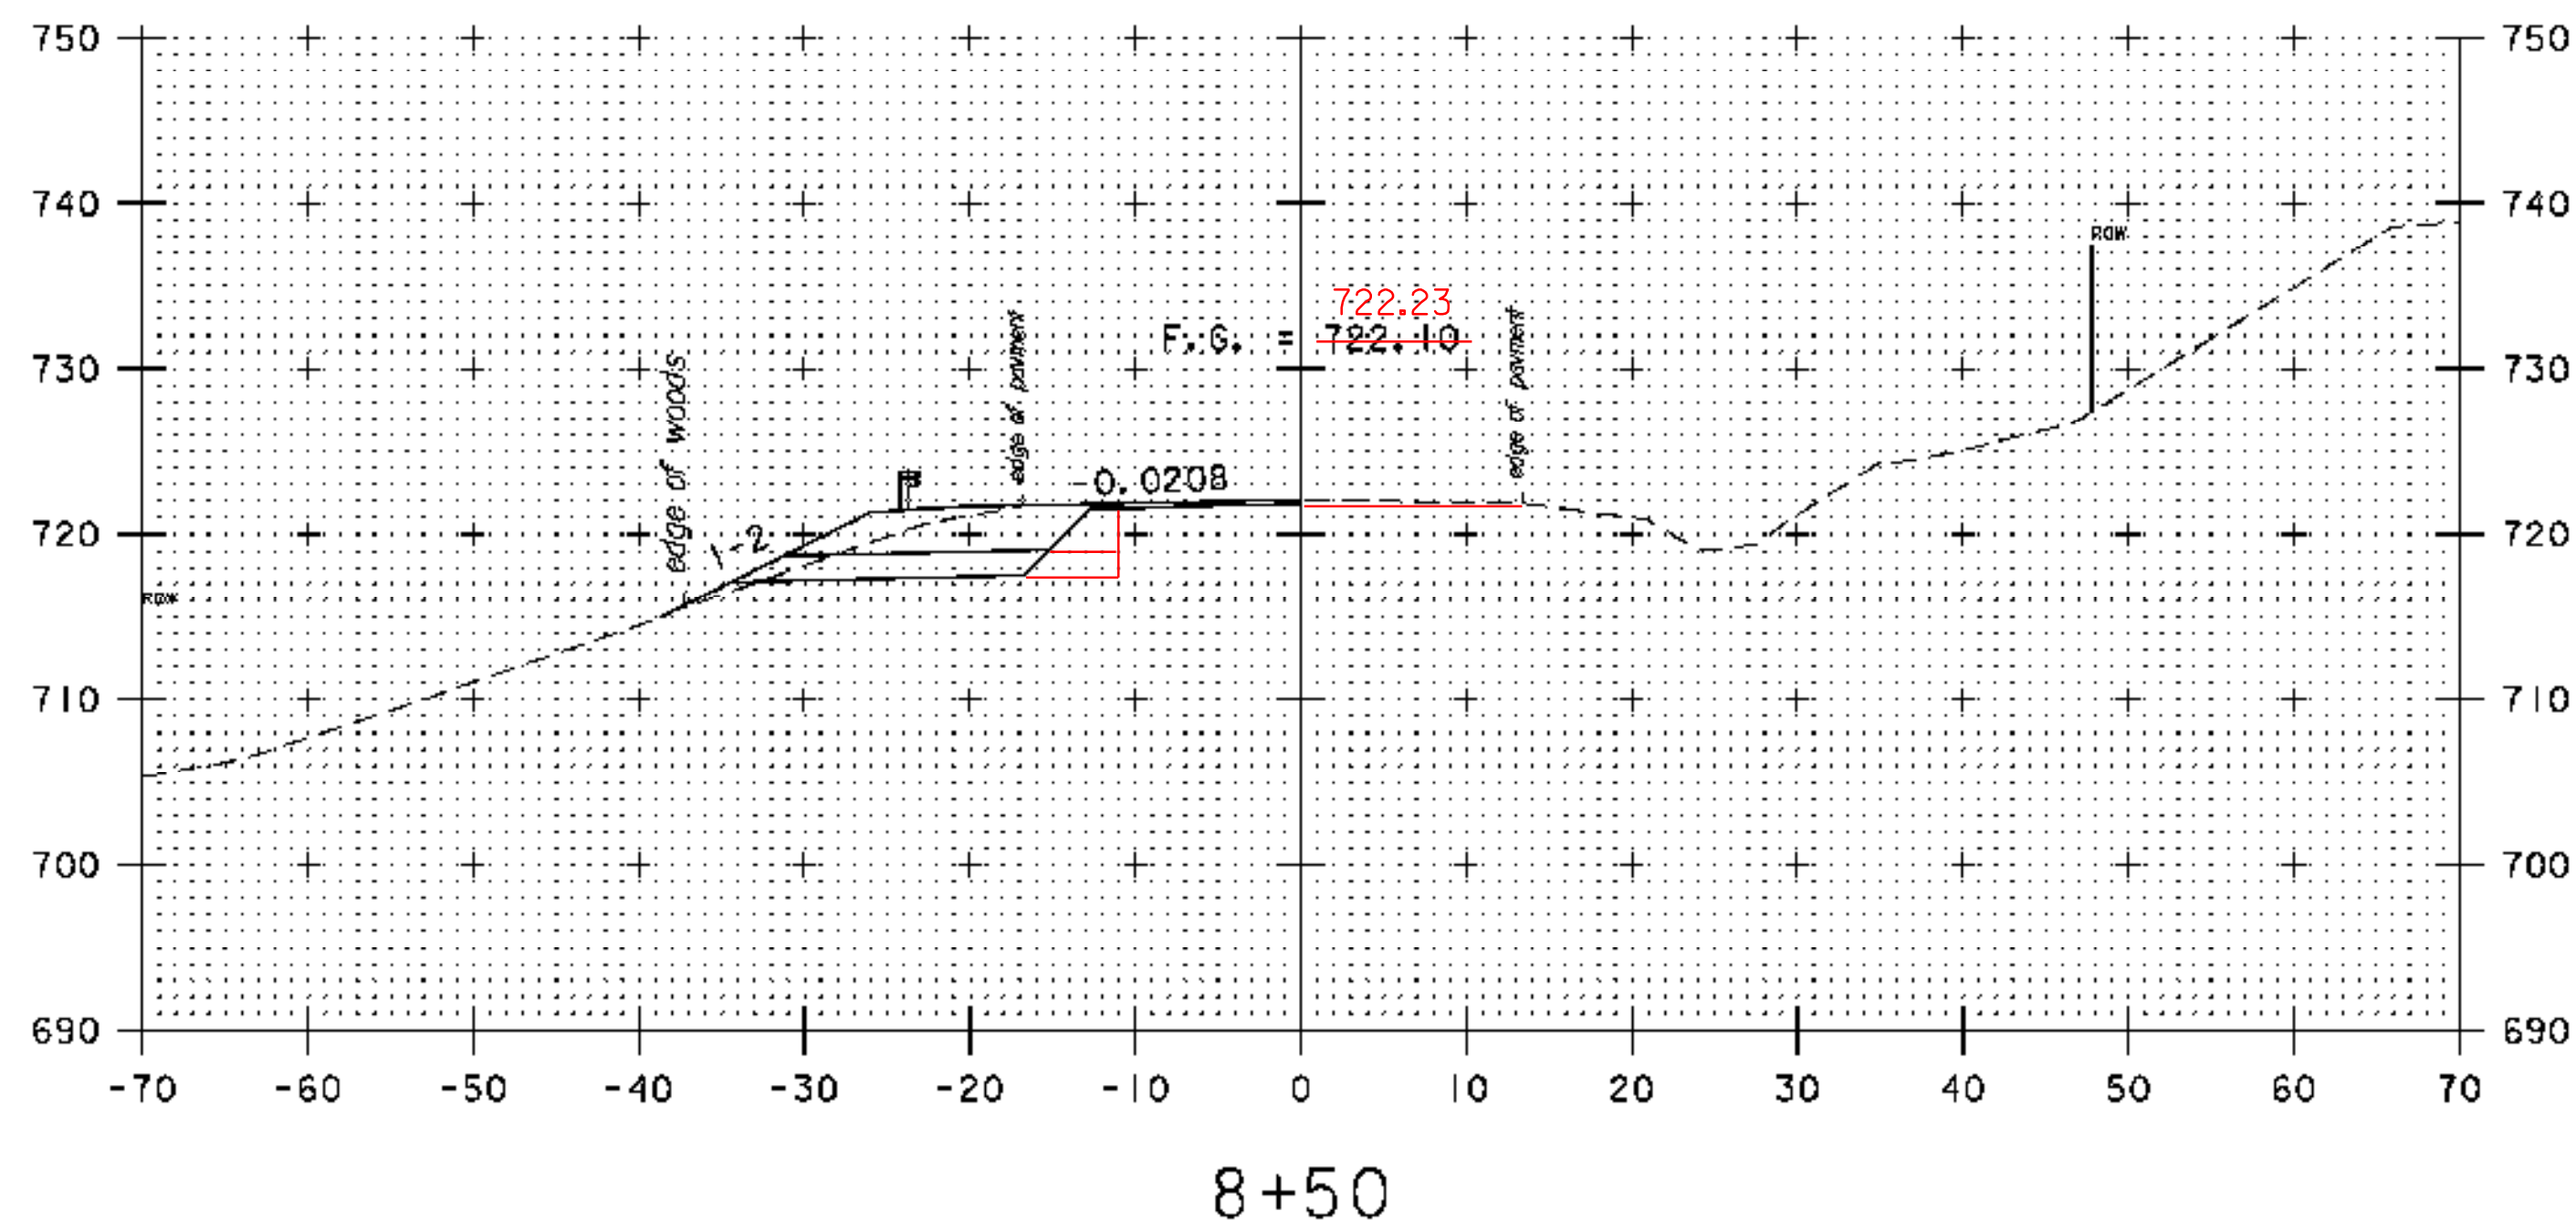
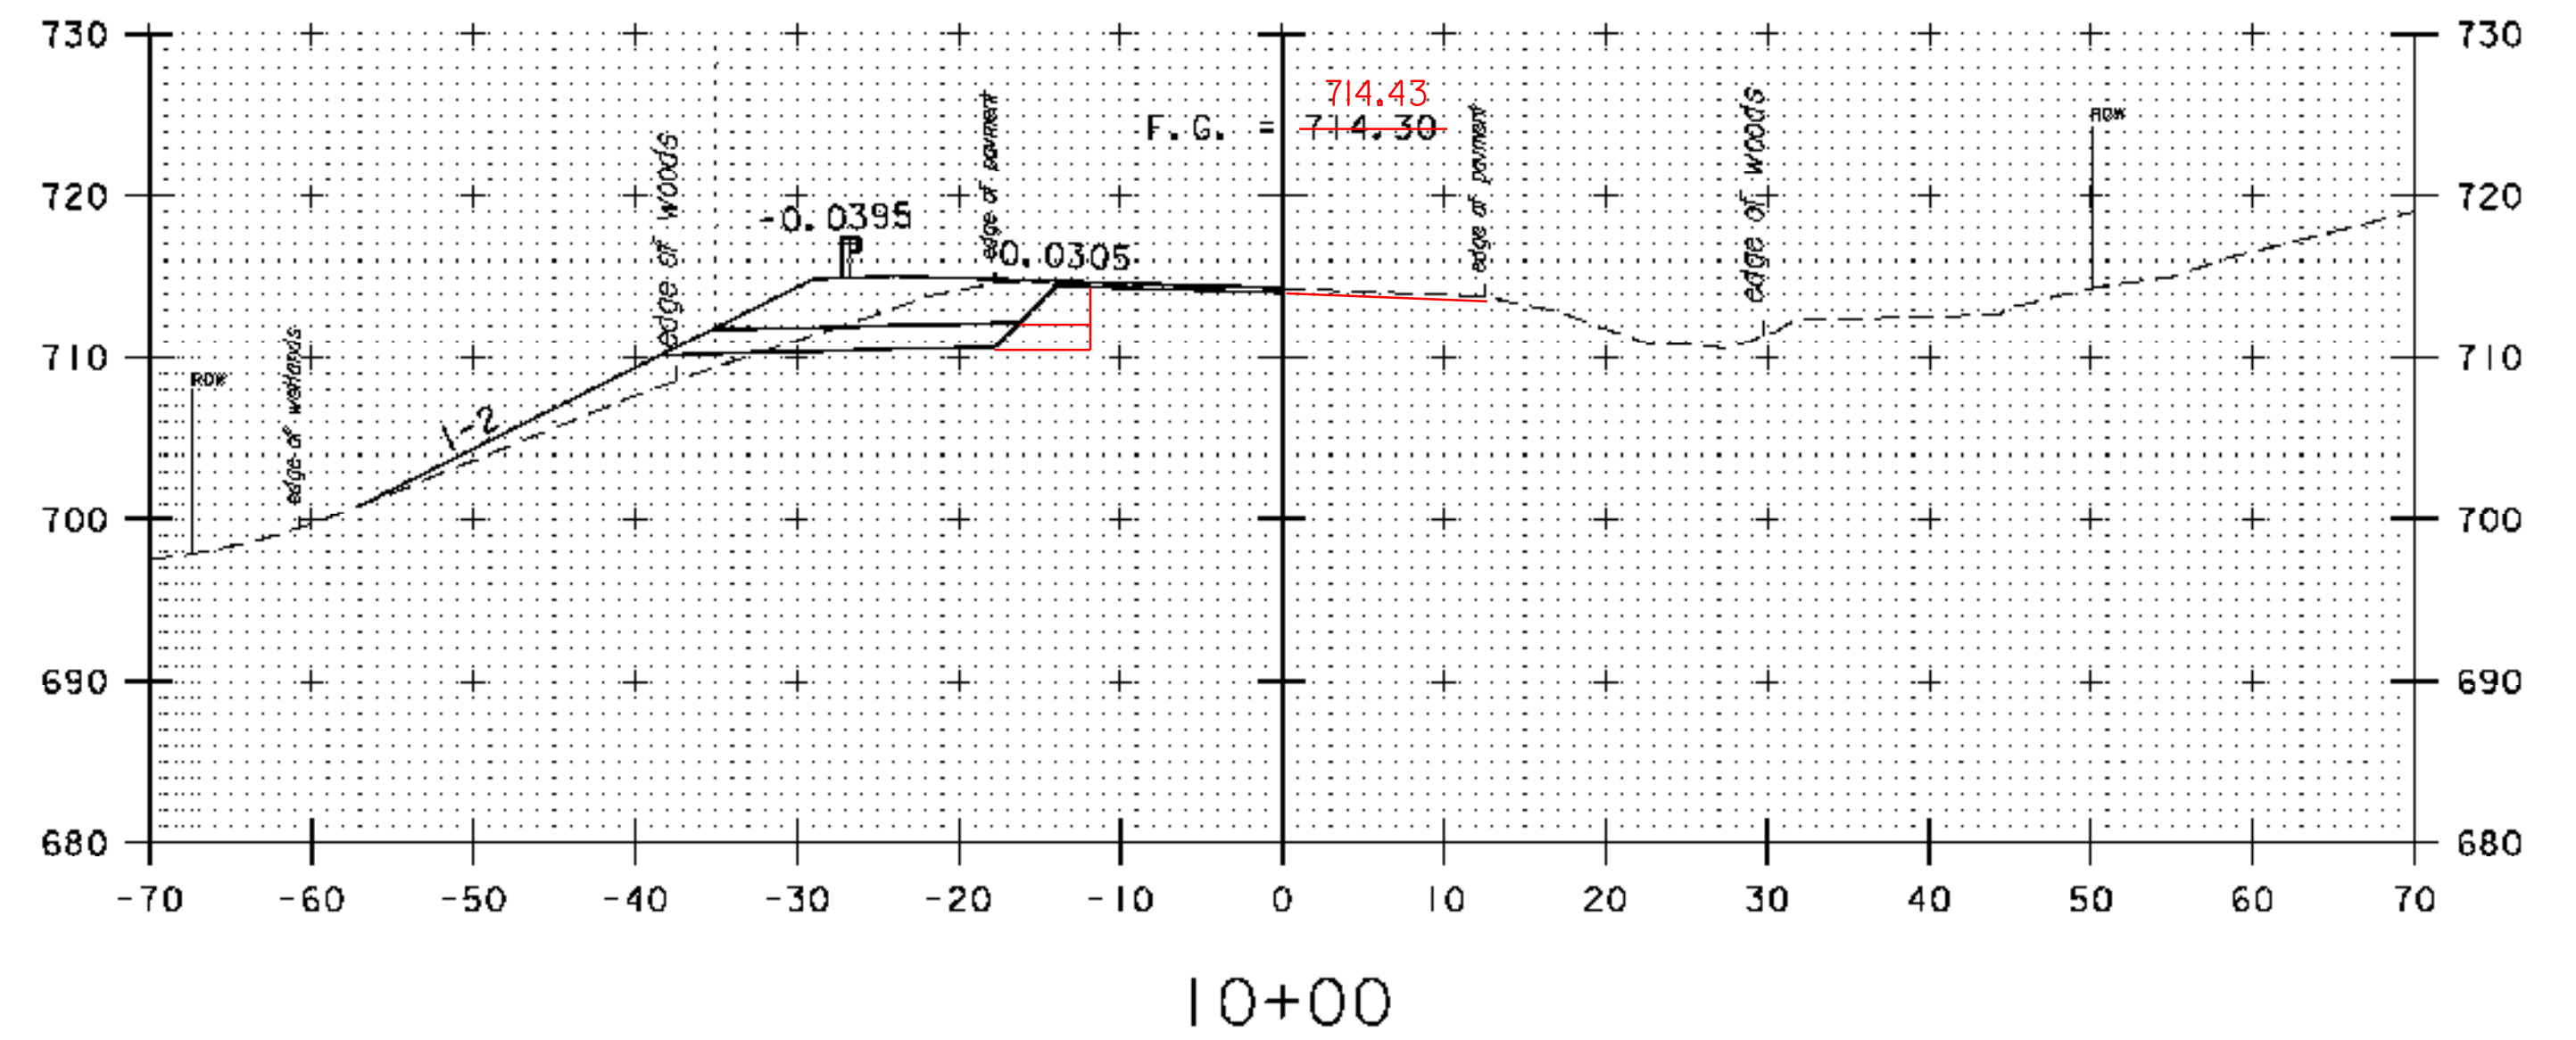


- COLD PLANE 1½" AND SUPERPAVE BITUMINOUS CONCRETE PAVEMENT FROM STA 8+50 RT TO 10+00 RT.
 - EXTENDED LIMITS OF EXCAVATION, SAND BORROW, AND DENSE GRADED FROM STA 8+50 LT TO 10+00 LT.

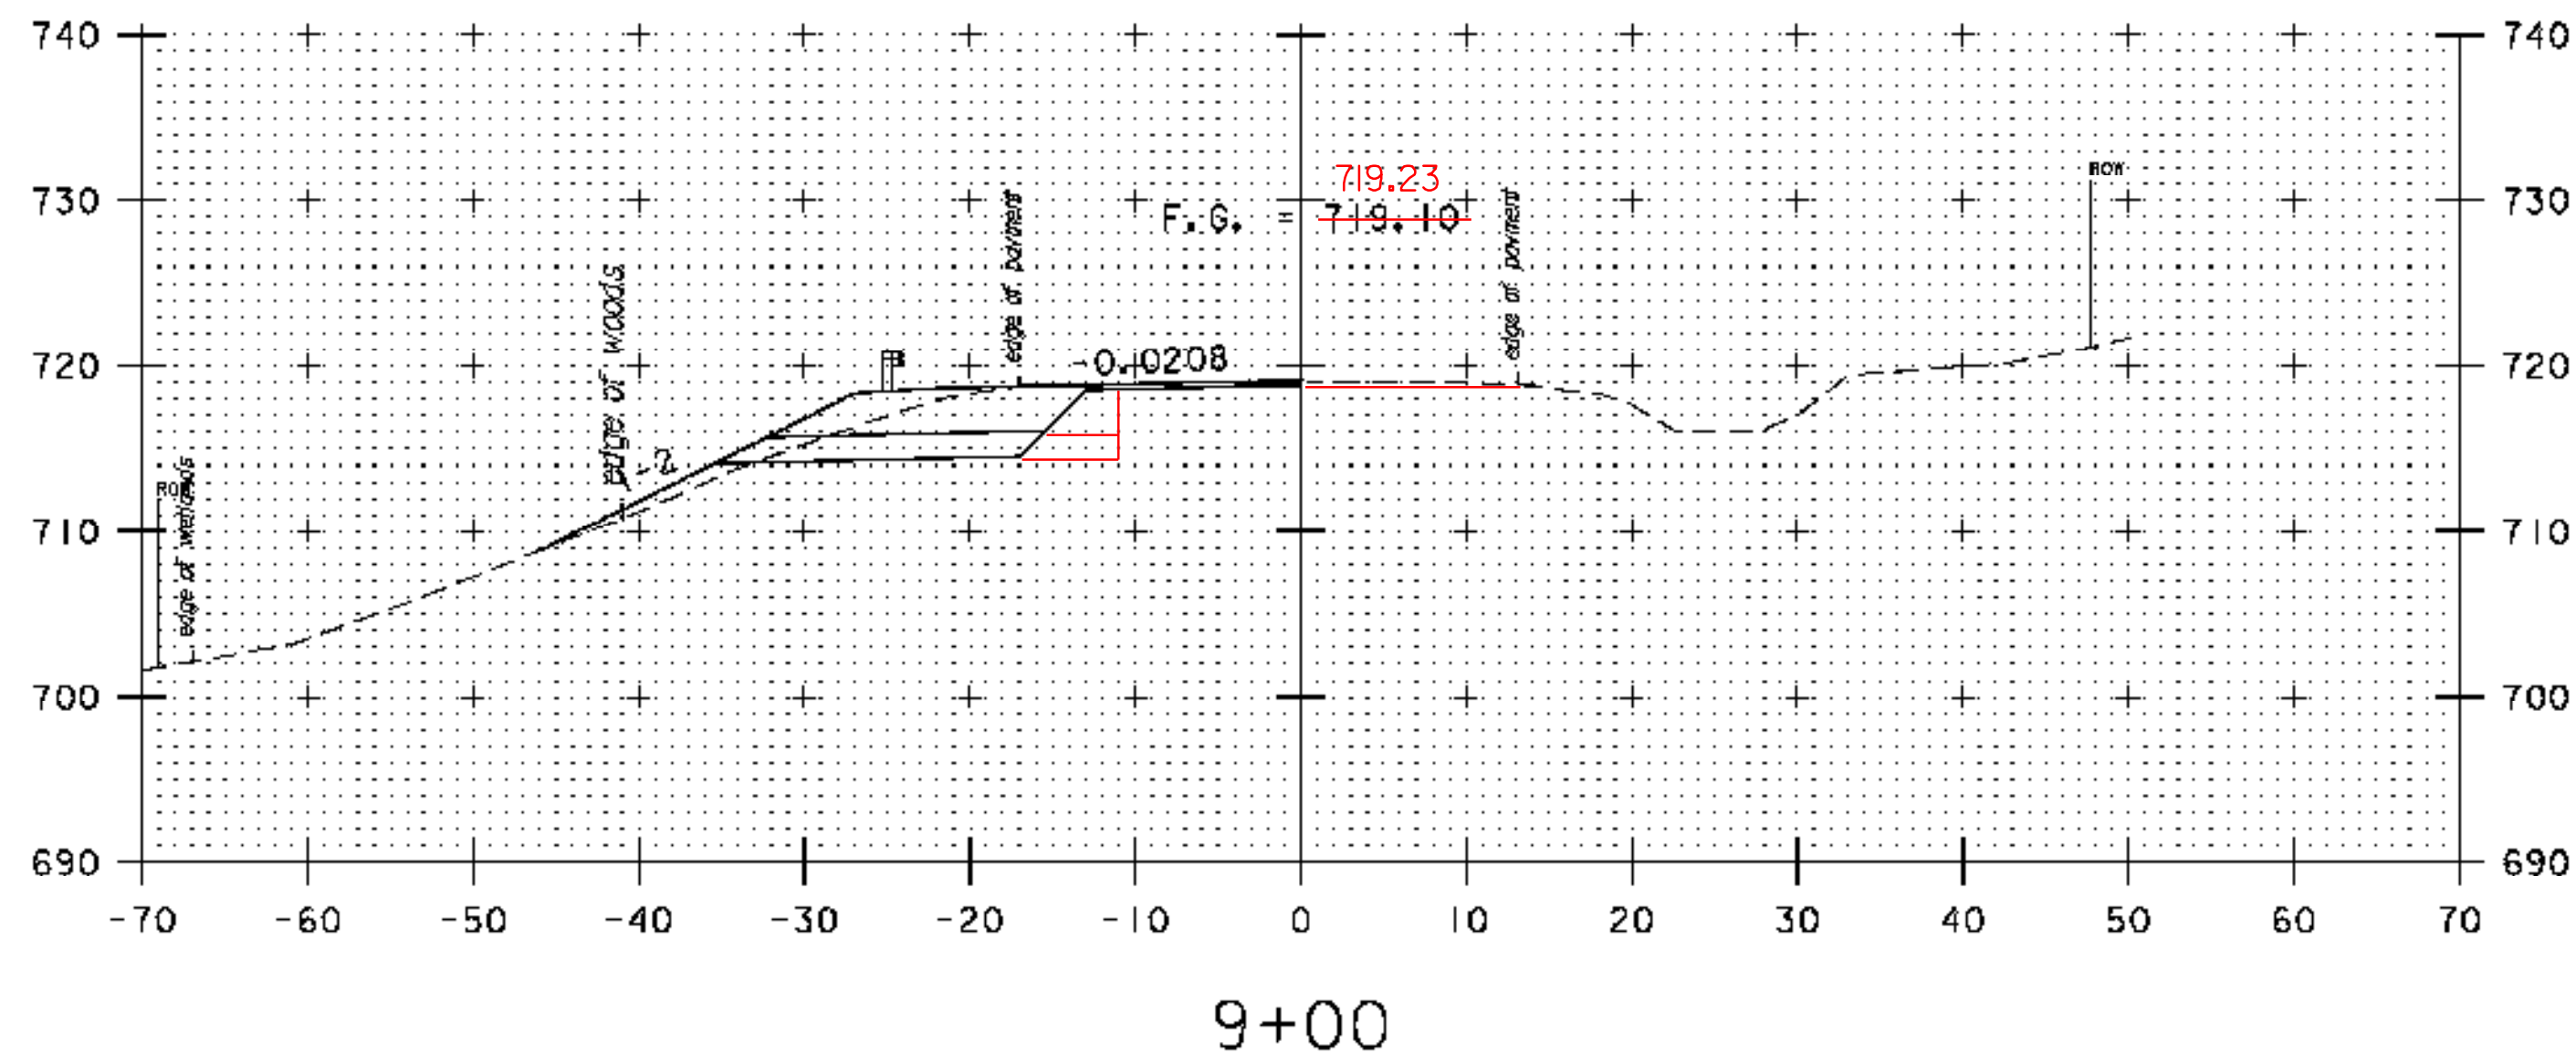

STA. 8+50 TO STA. 10+00	
PROJECT NAME:	RUTLAND TOWN
PROJECT NUMBER:	HES INTS(4)
FILE NAME:	z05kl14XSLdgn
PROJECT LEADER:	DWB
DESIGNED BY:	TSK
CROSS SECTIONS, ROUTE 7 (3)	
PLOT DATE:	3/3/2009
DRAWN BY:	TSK
CHECKED BY:	DWB
SHEET NO.	32 OF 36