



11+43

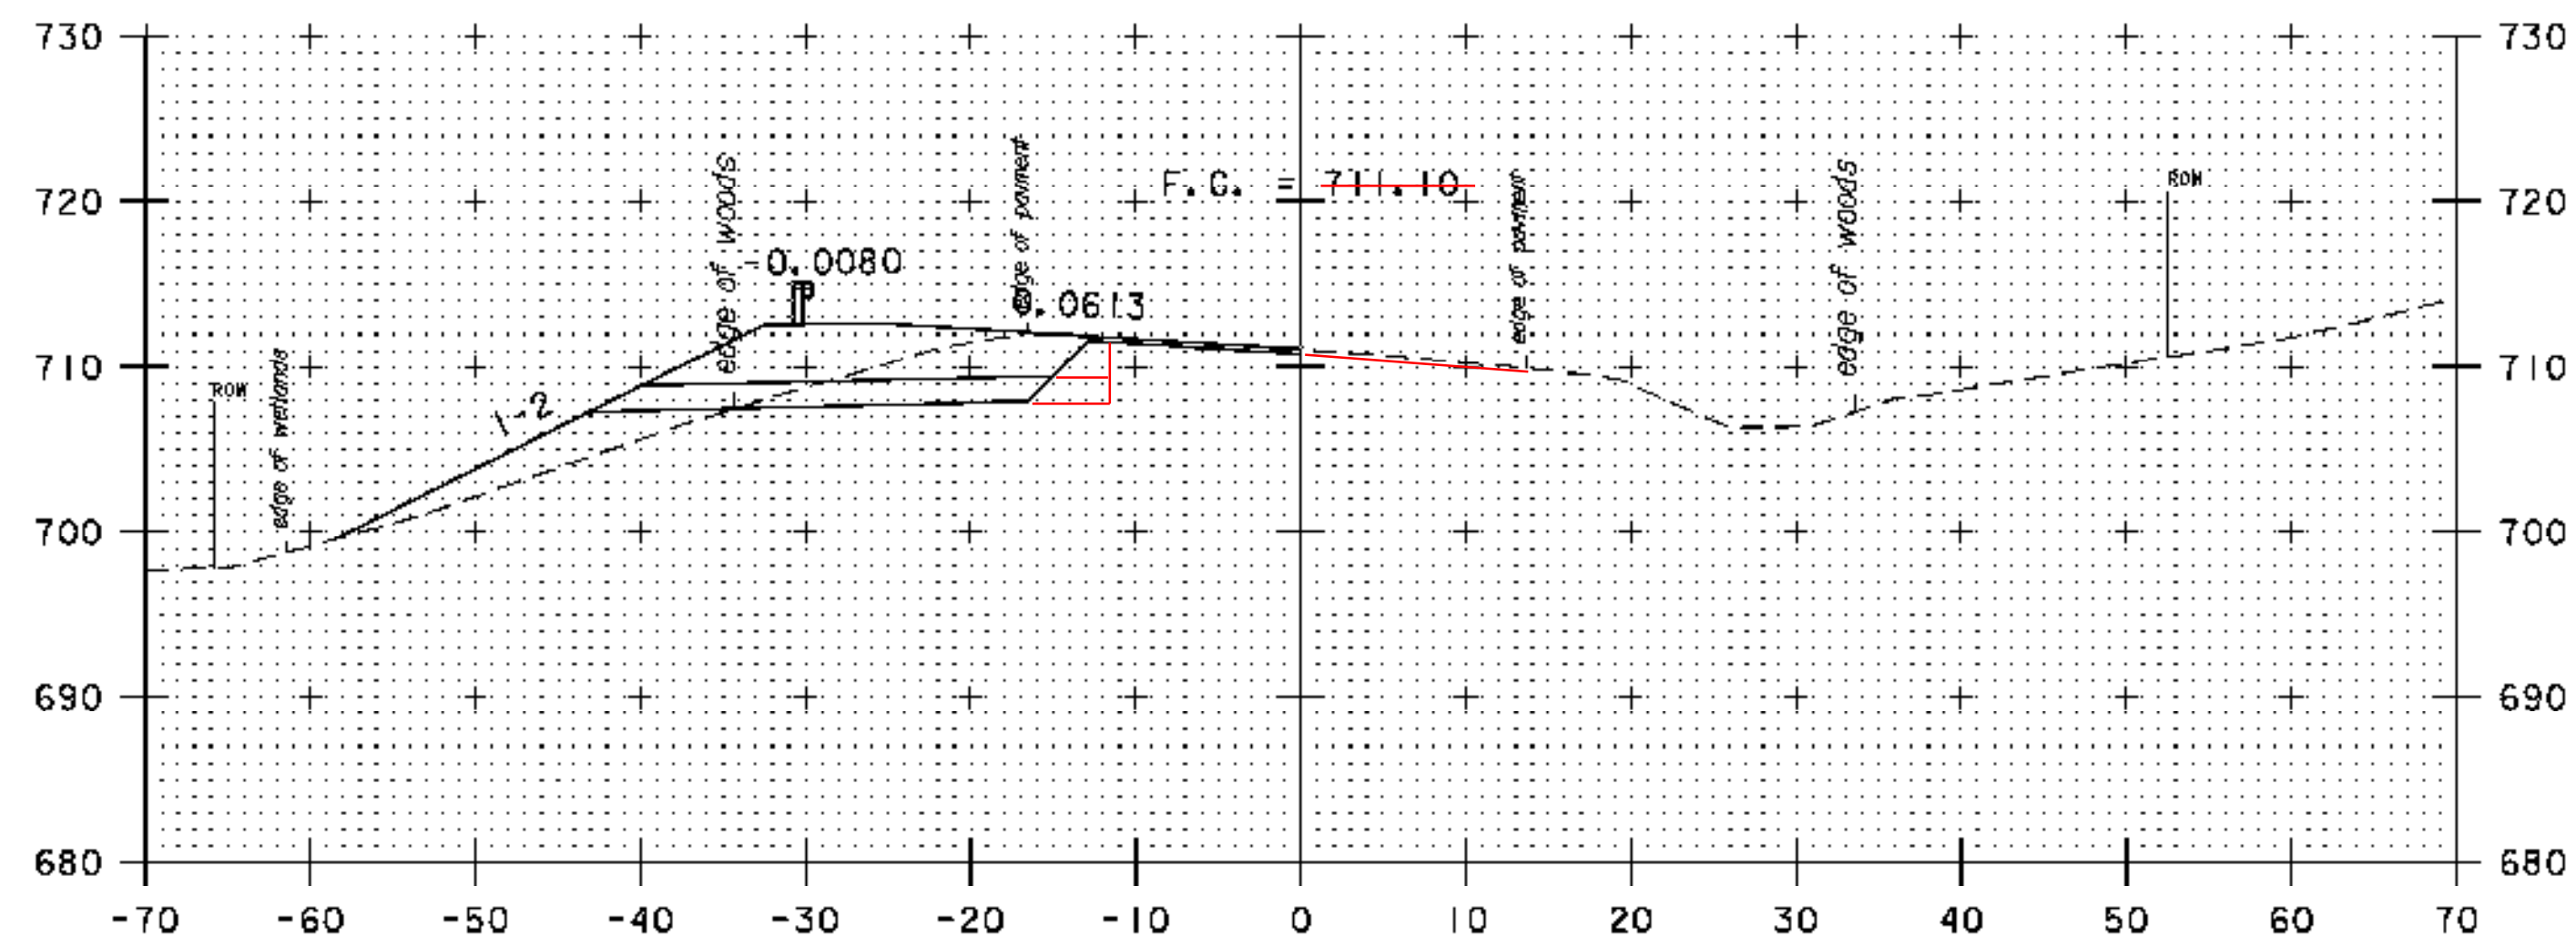


11+00

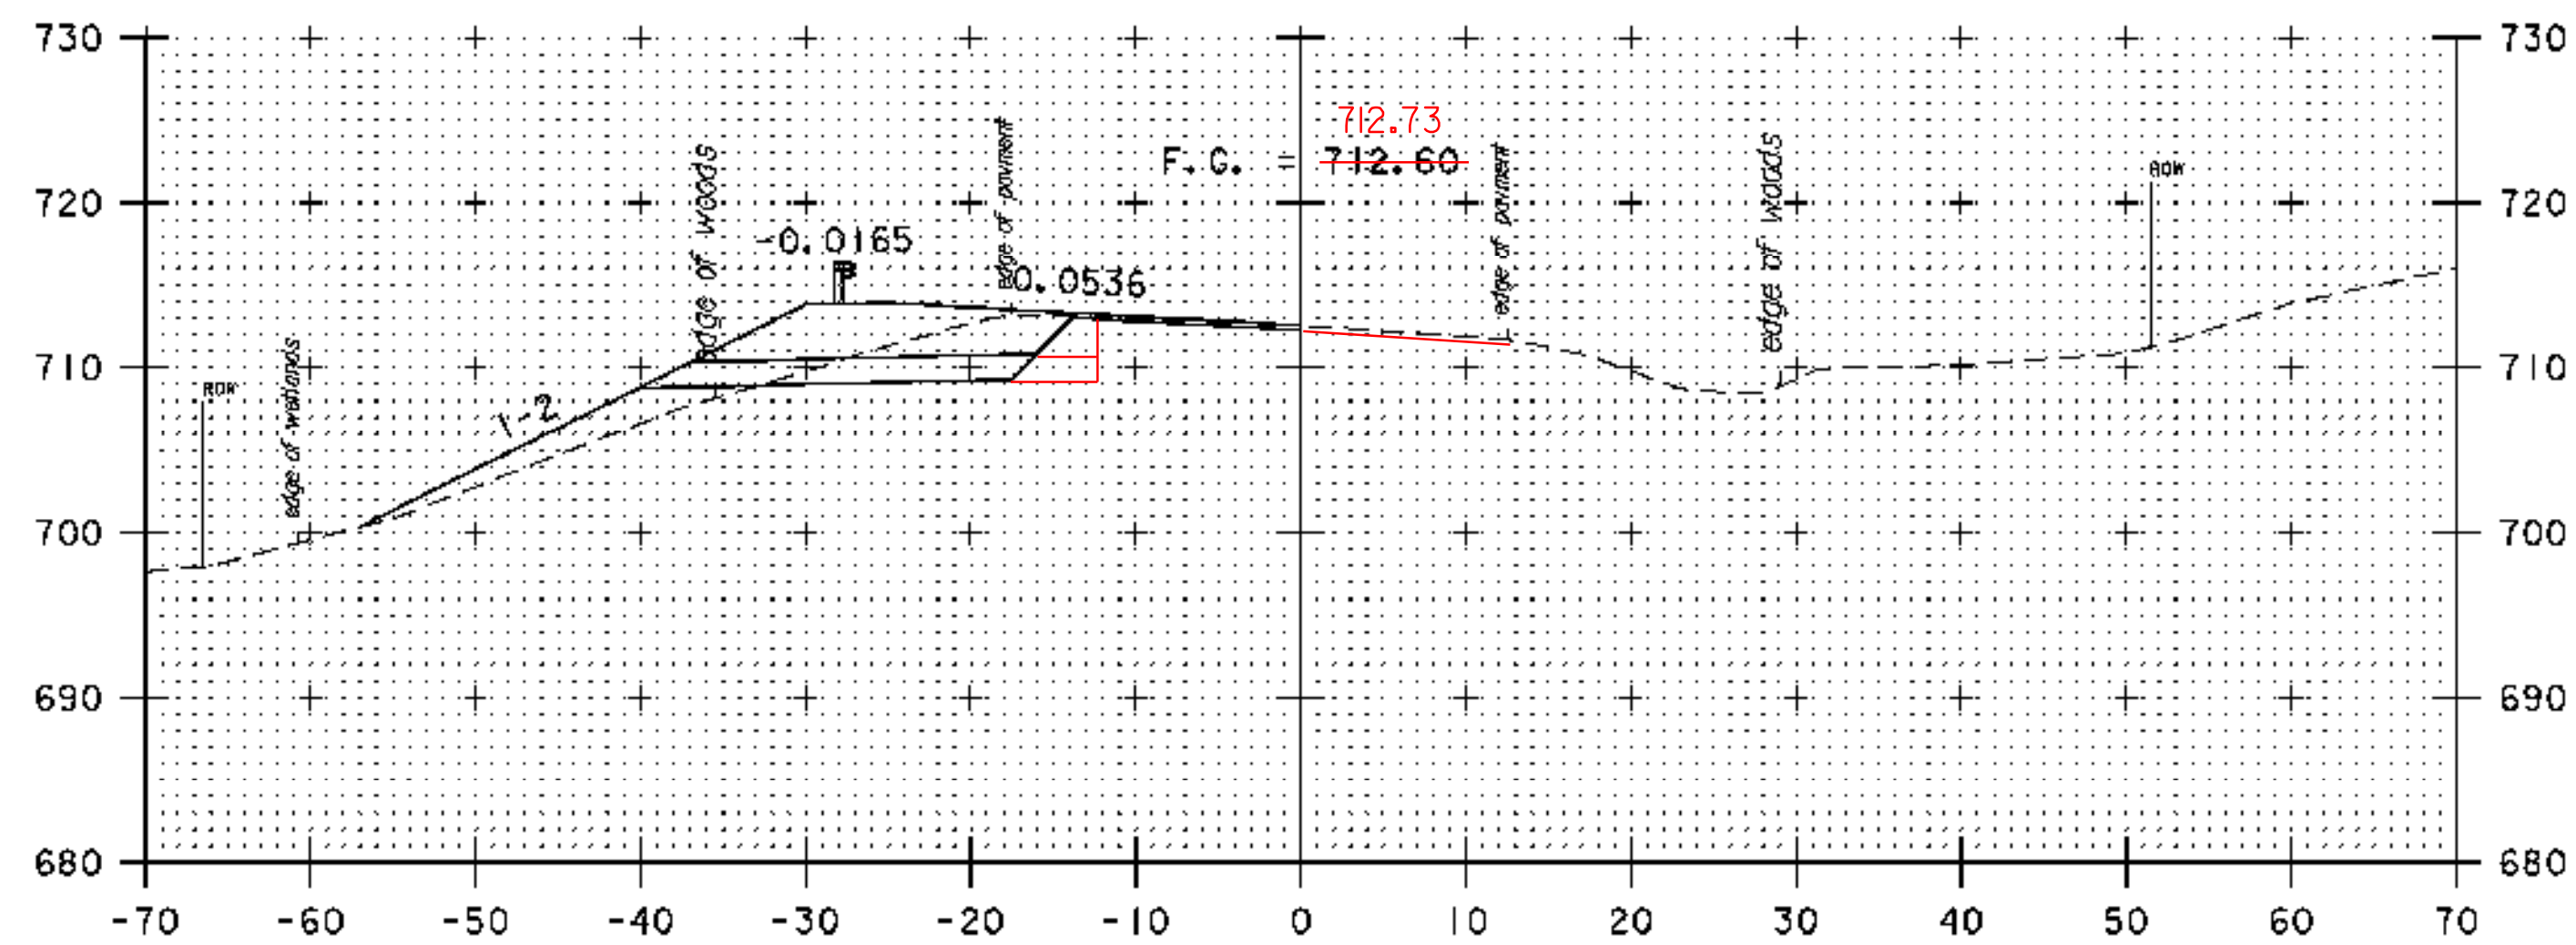


10+50


- COLD PLANE 1½" AND SUPERPAVE BITUMINOUS CONCRETE PAVEMENT FROM STA 10+50 RT TO 12+00 RT.
- EXTENDED LIMITS OF EXCAVATION, SAND BORROW, AND DENSE GRADED FROM STA 10+50 LT TO 12+00 LT.

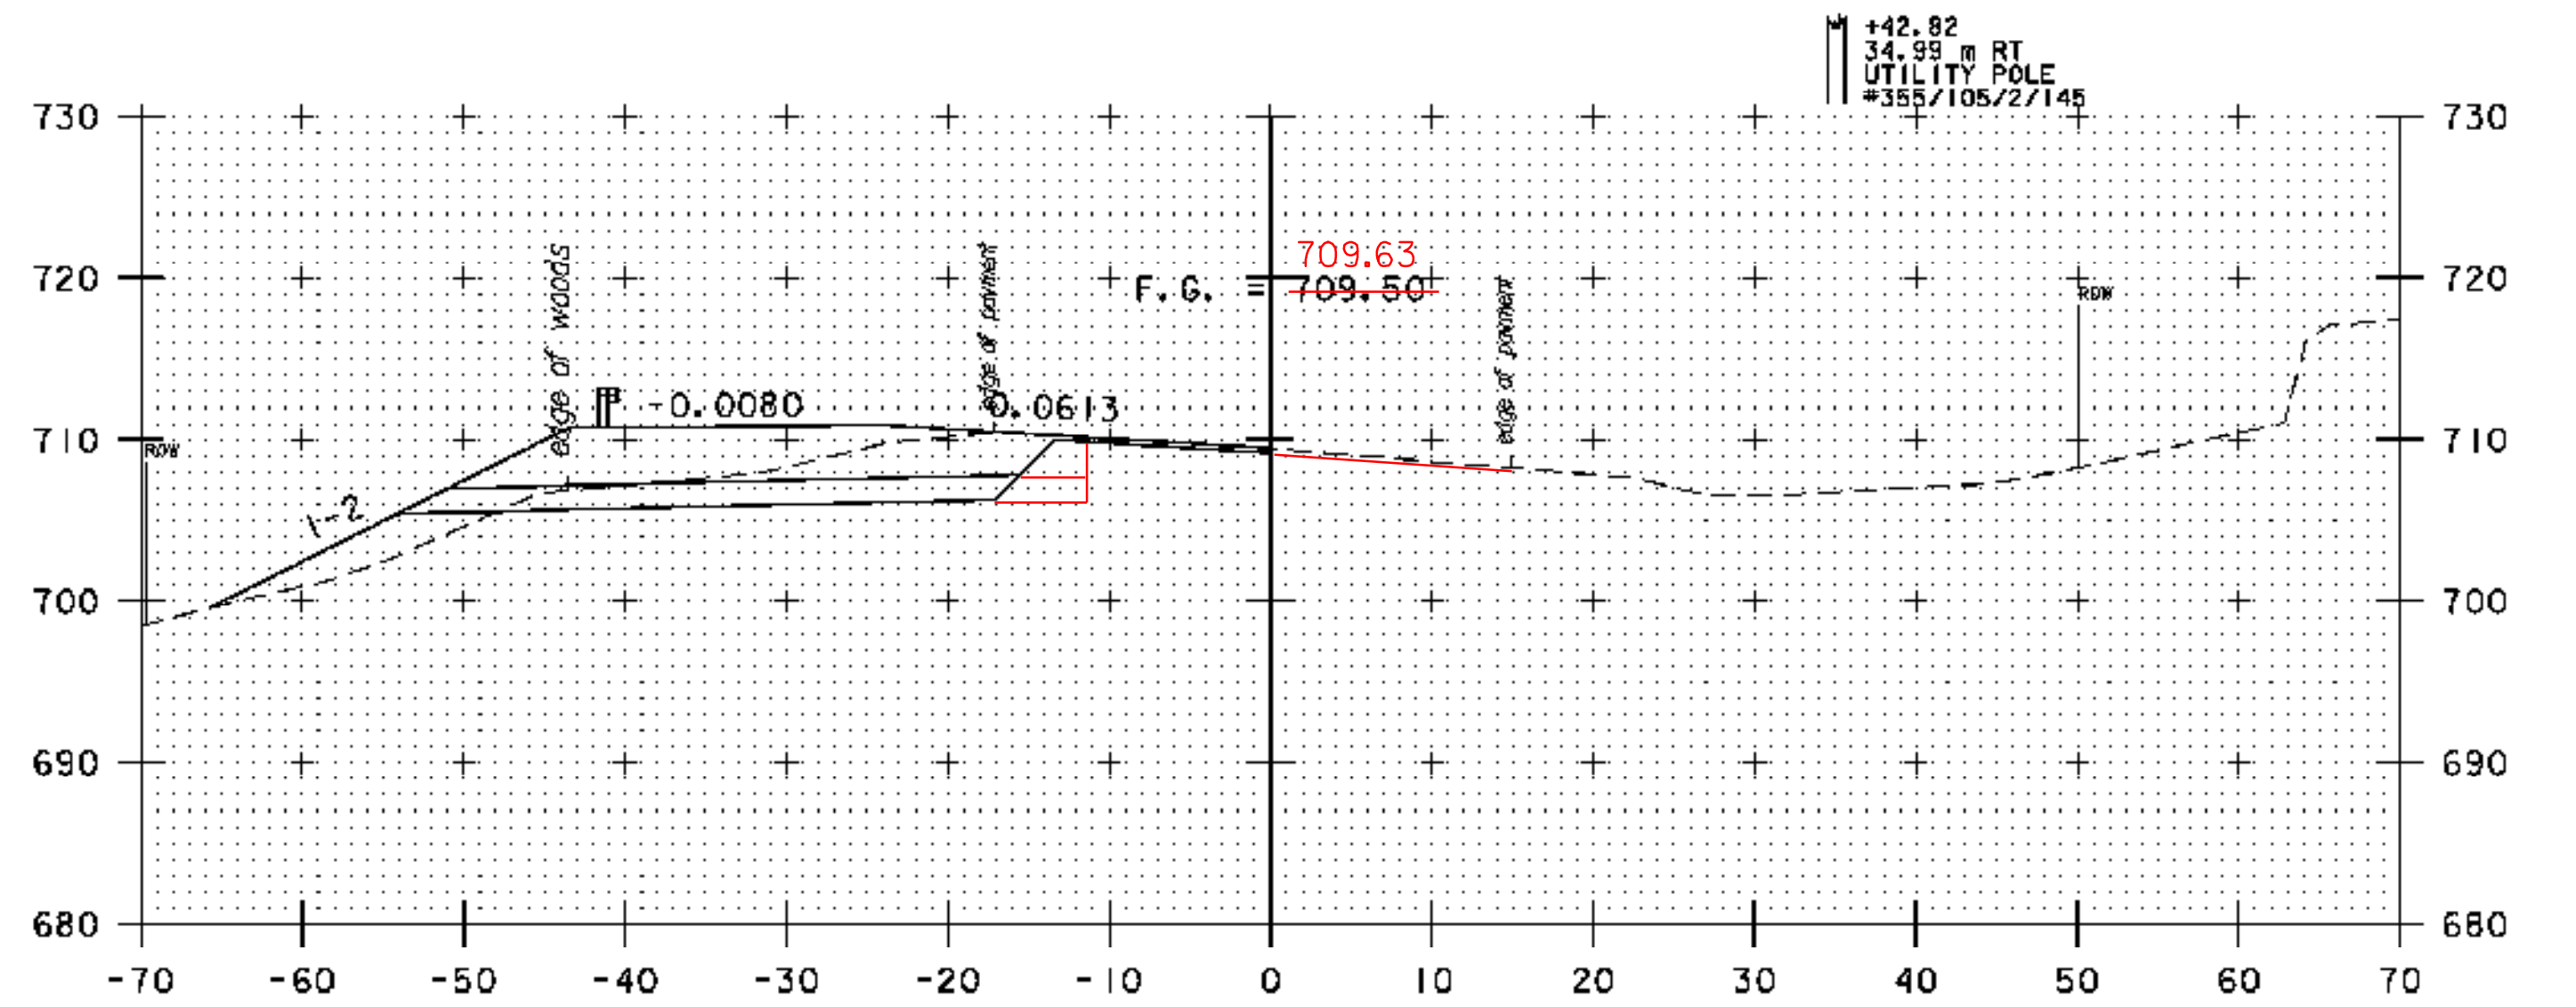

12+00

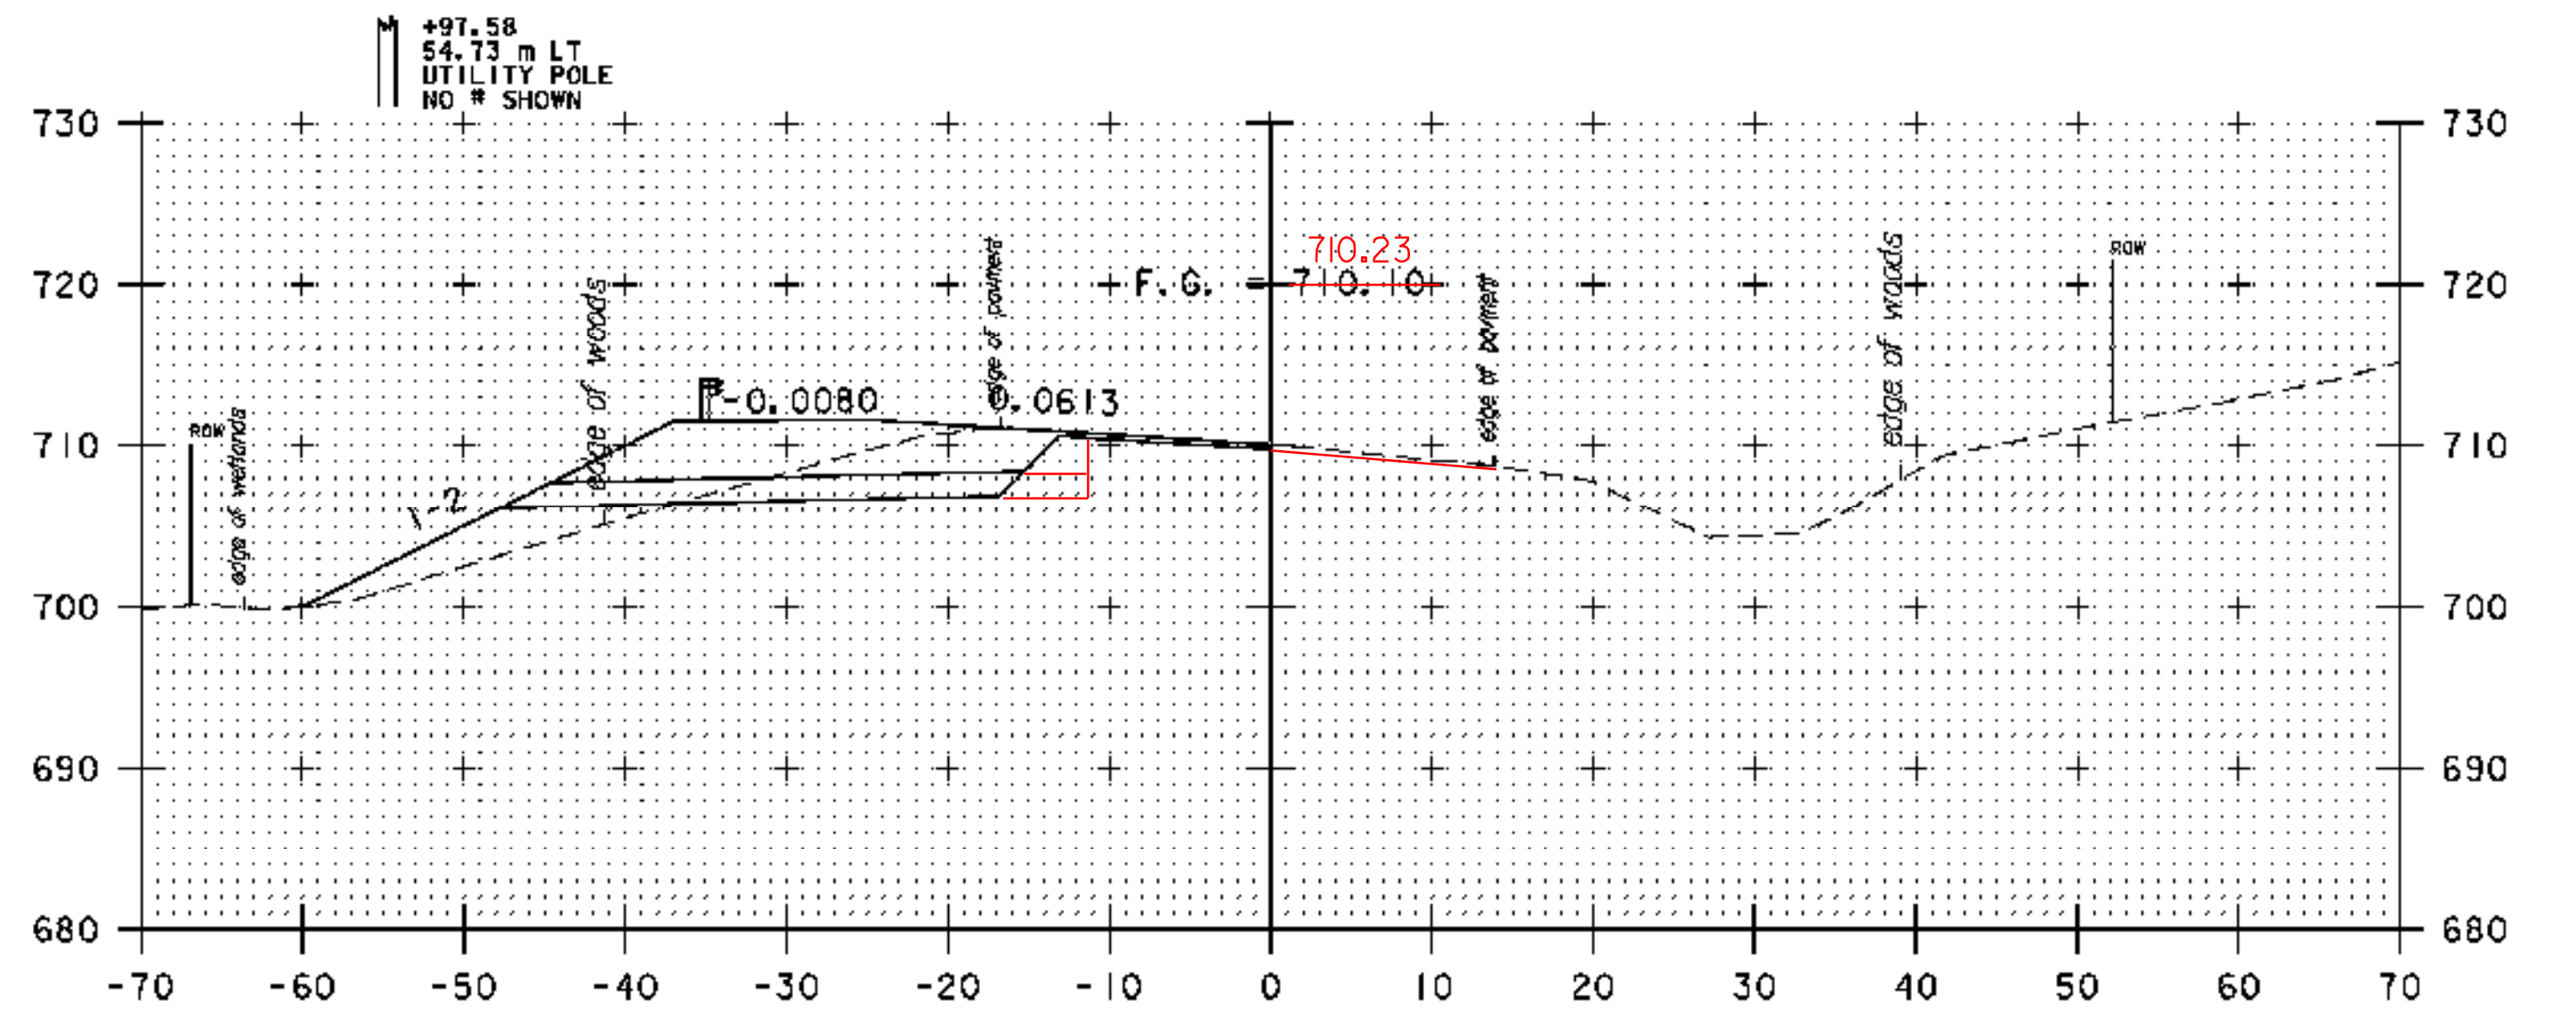

11+50

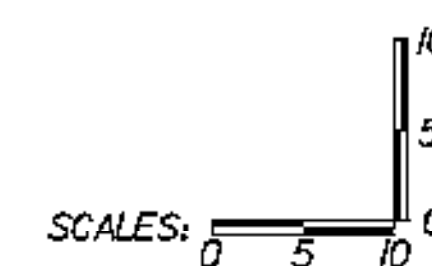

| | |
|-----------------------------|----------------|
| STA. 10+50 TO STA. 12+00 | |
| PROJECT NAME: | RUTLAND TOWN |
| PROJECT NUMBER: | HES INTS(4) |
| FILE NAME: | z05k114XSI.dgn |
| PROJECT LEADER: | DWB |
| DESIGNED BY: | TSK |
| CROSS SECTIONS, ROUTE 7 (4) | |
| PLOT DATE: | 3/3/2009 |
| DRAWN BY: | TSK |
| CHECKED BY: | DWB |
| SHEET NO. | 33 OF 36 |