




- COLD PLANE 1 1/2" AND SUPERPAVE BITUMINOUS CONCRETE PAVEMENT FROM STA 12+50 RT TO 14+00 RT.  
 - EXTENDED LIMITS OF EXCAVATION, SAND BORROW, AND DENSE GRADED FROM STA 12+50 LT TO 14+00 LT.

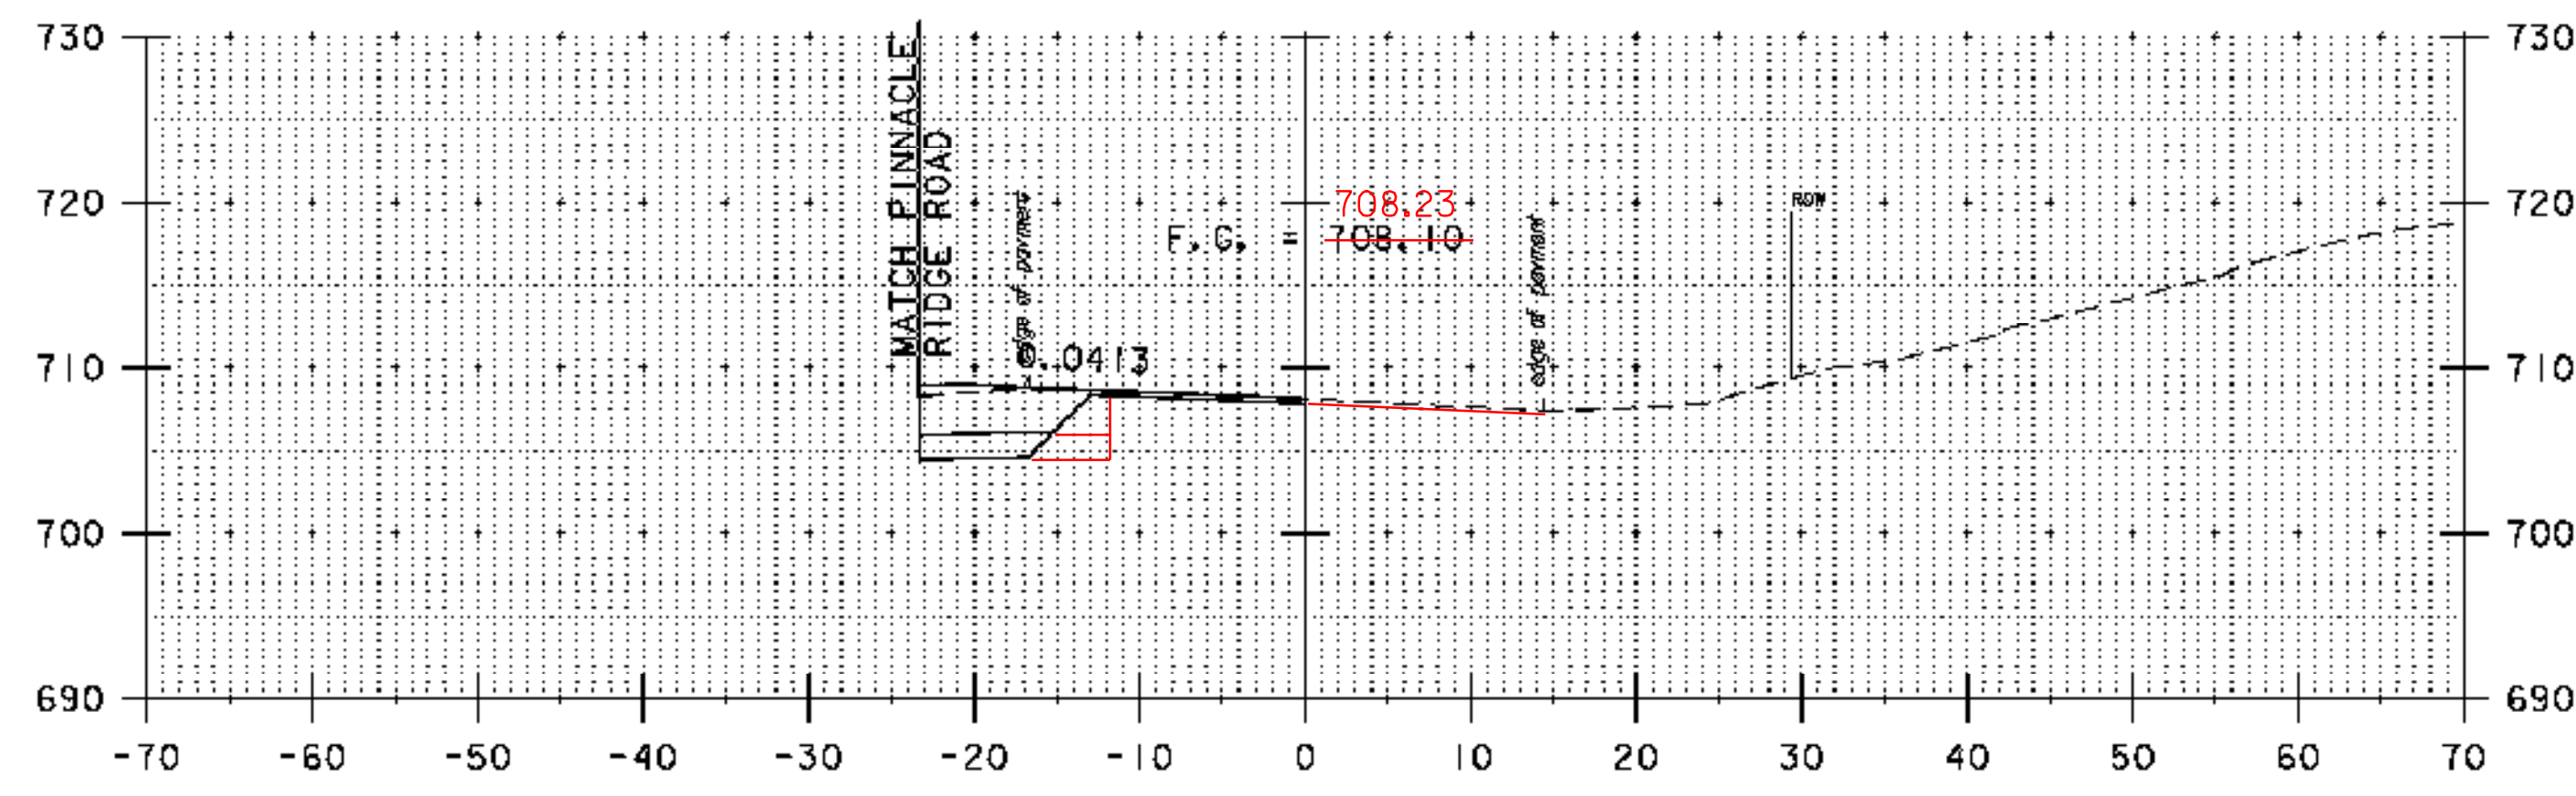


13+00

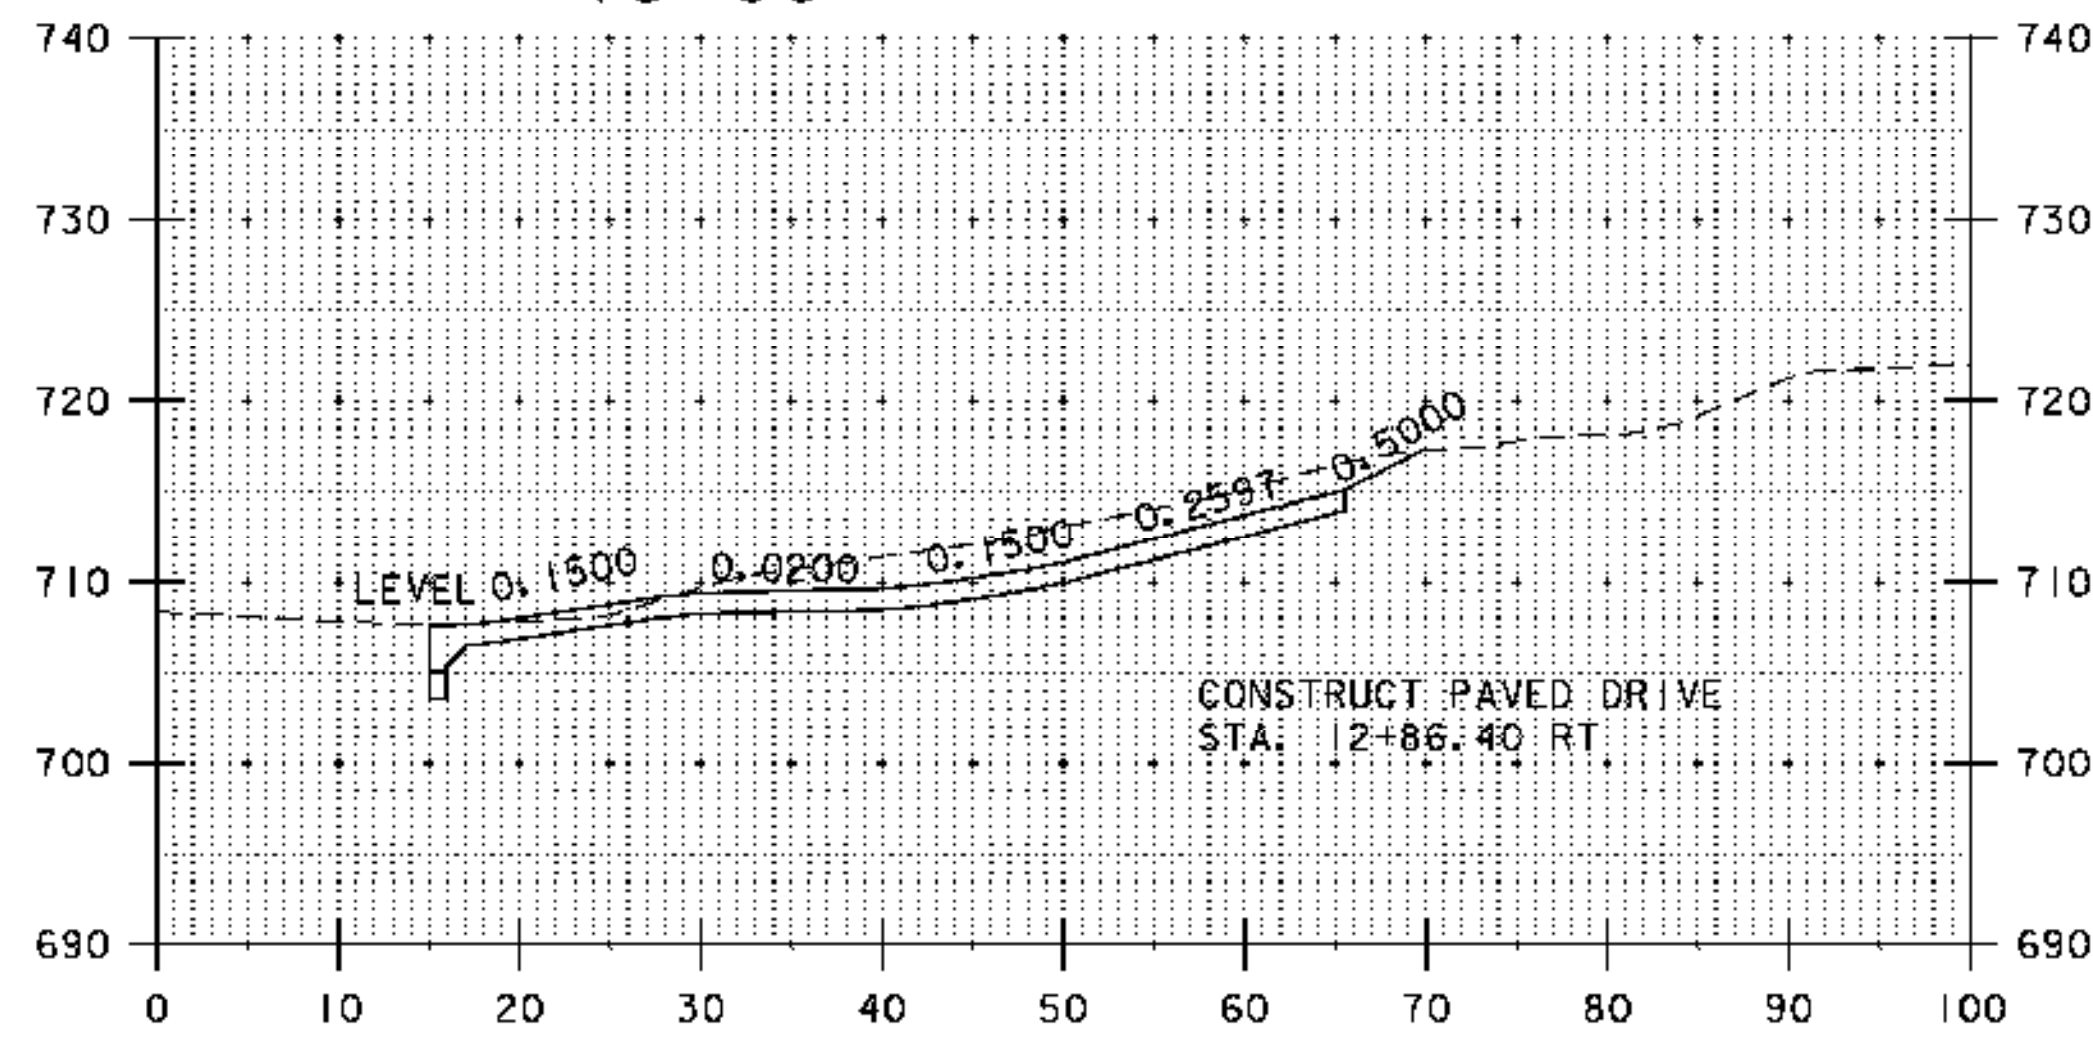


12+86

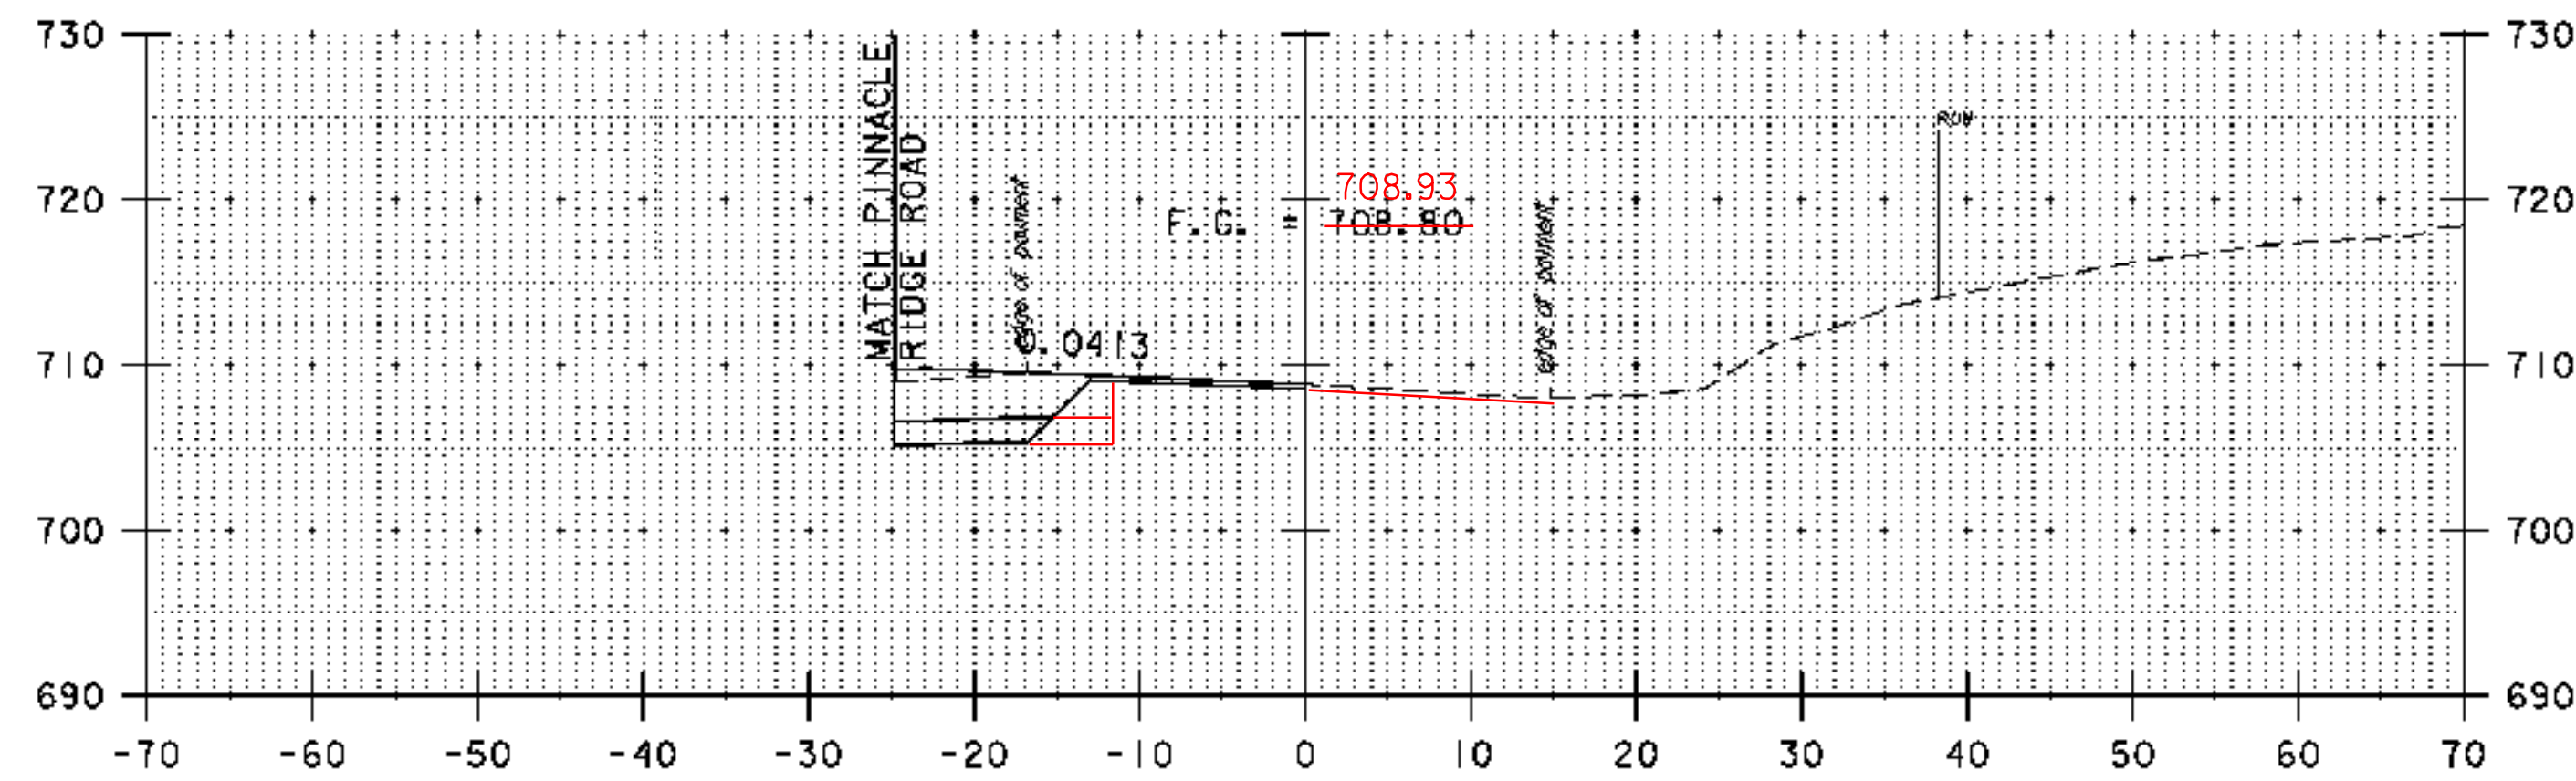


12+50

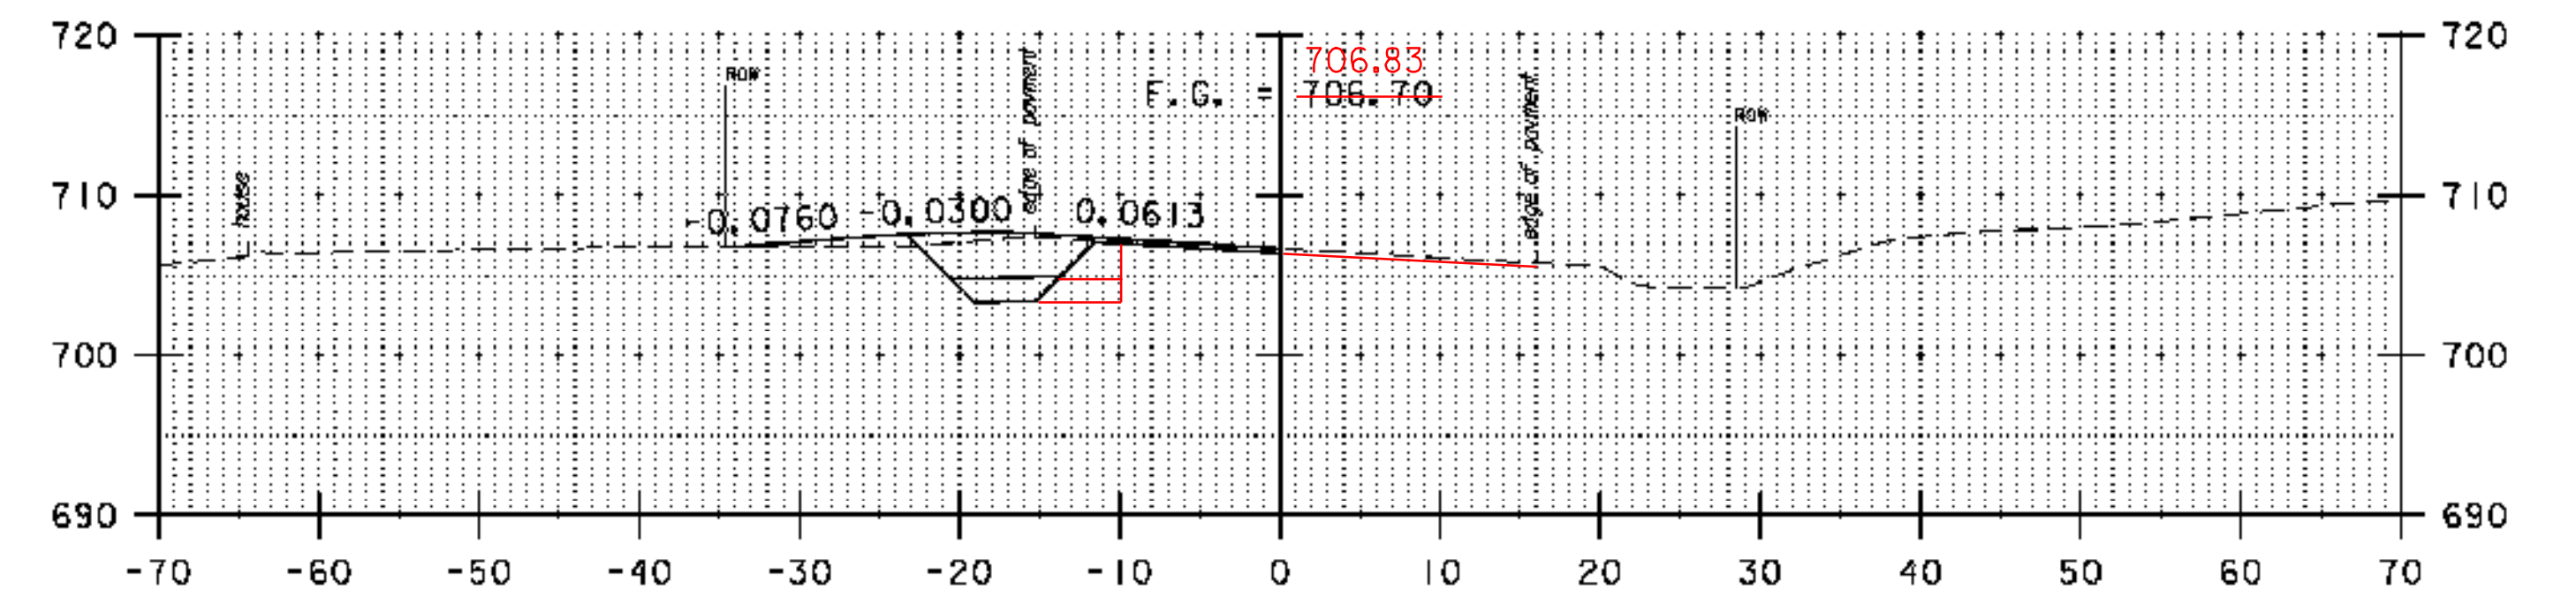

14+00

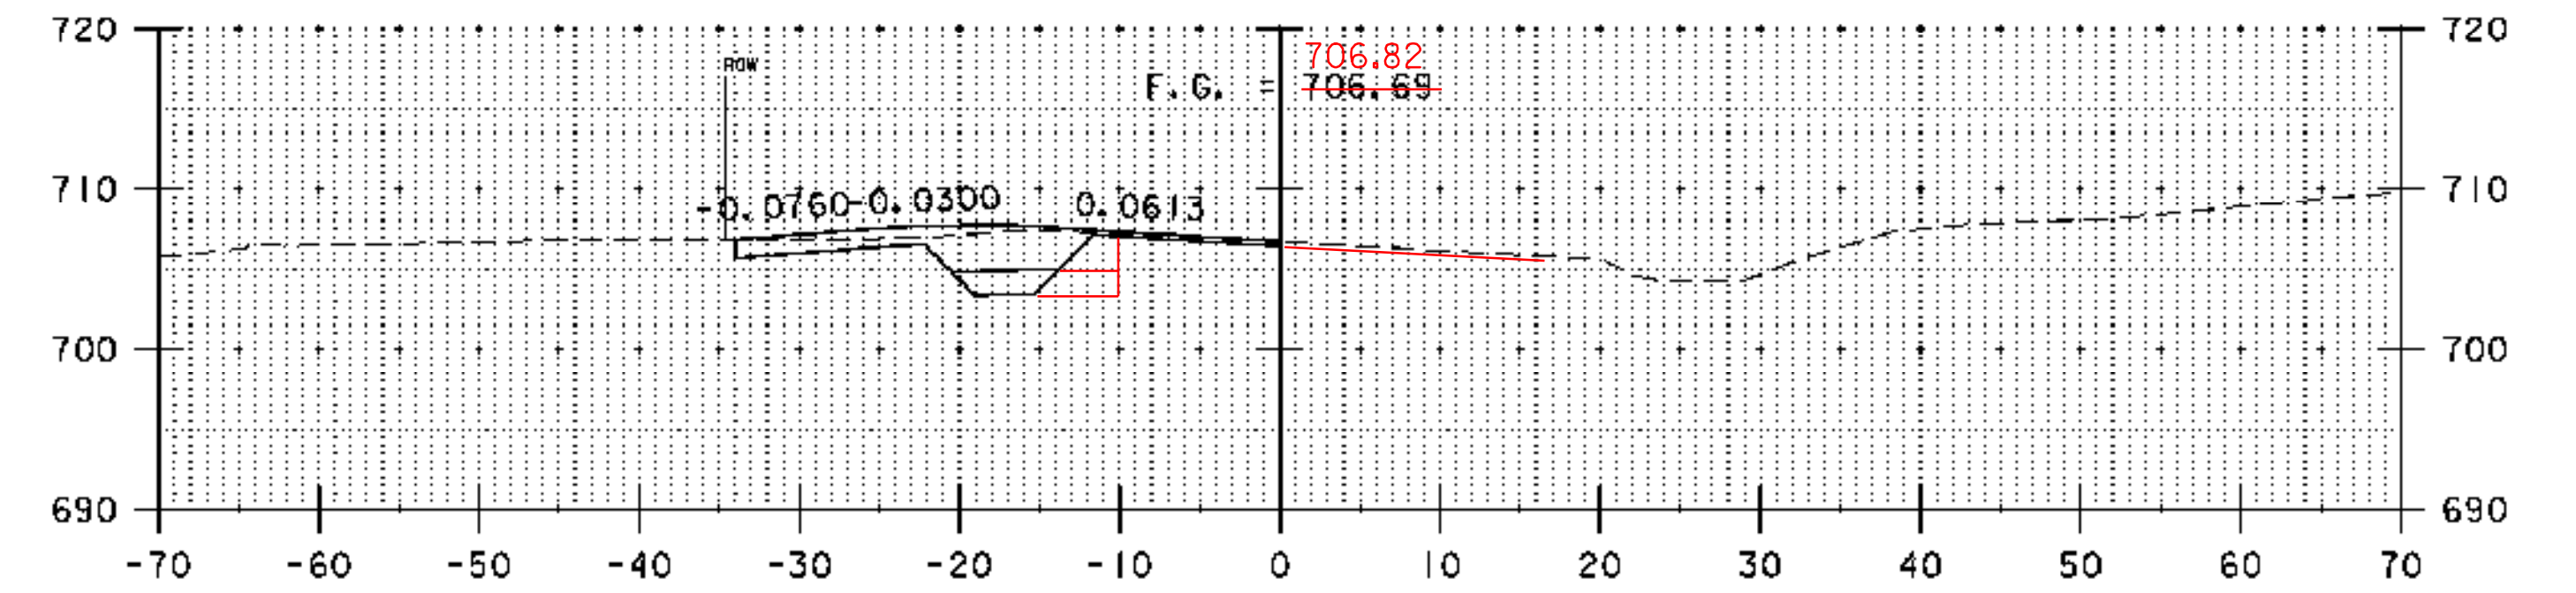


13+99

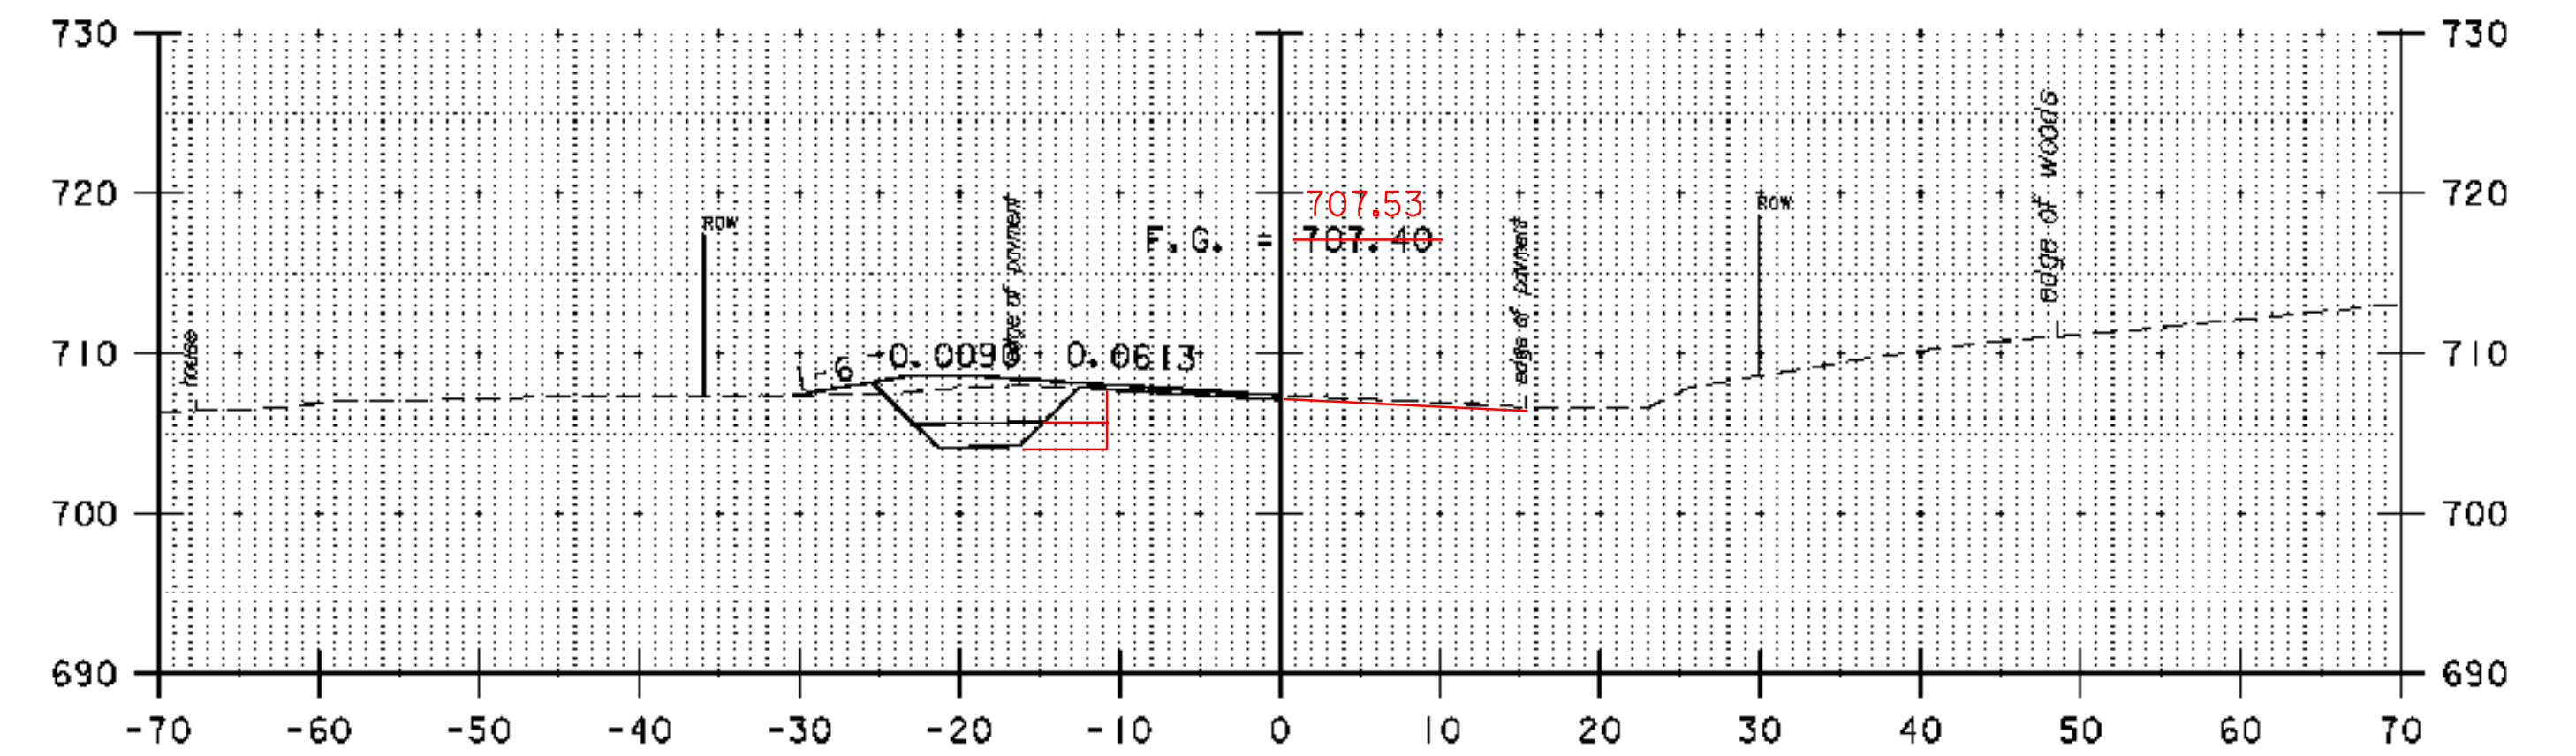

13+50

△ REVISED APRIL 17, 2009 - REVISED DRIVE CROSS SECTION AT 12+86.40 RT

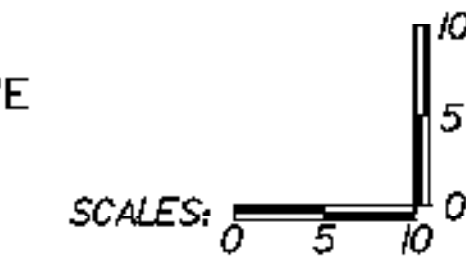

STA. 12+50 TO STA. 14+00	
PROJECT NAME:	RUTLAND TOWN
PROJECT NUMBER:	HES INTS(4)
FILE NAME:	z05k114XSL.dgn
PROJECT LEADER:	DWB
DESIGNED BY:	TSK
CROSS SECTIONS, ROUTE 7 (S)	
PLOT DATE:	4/20/2009
DRAWN BY:	TSK
CHECKED BY:	DWB
SHEET NO.	34 OF 36