



MAST ARM A  
LOOKING EAST ON  
VT ROUTE 15

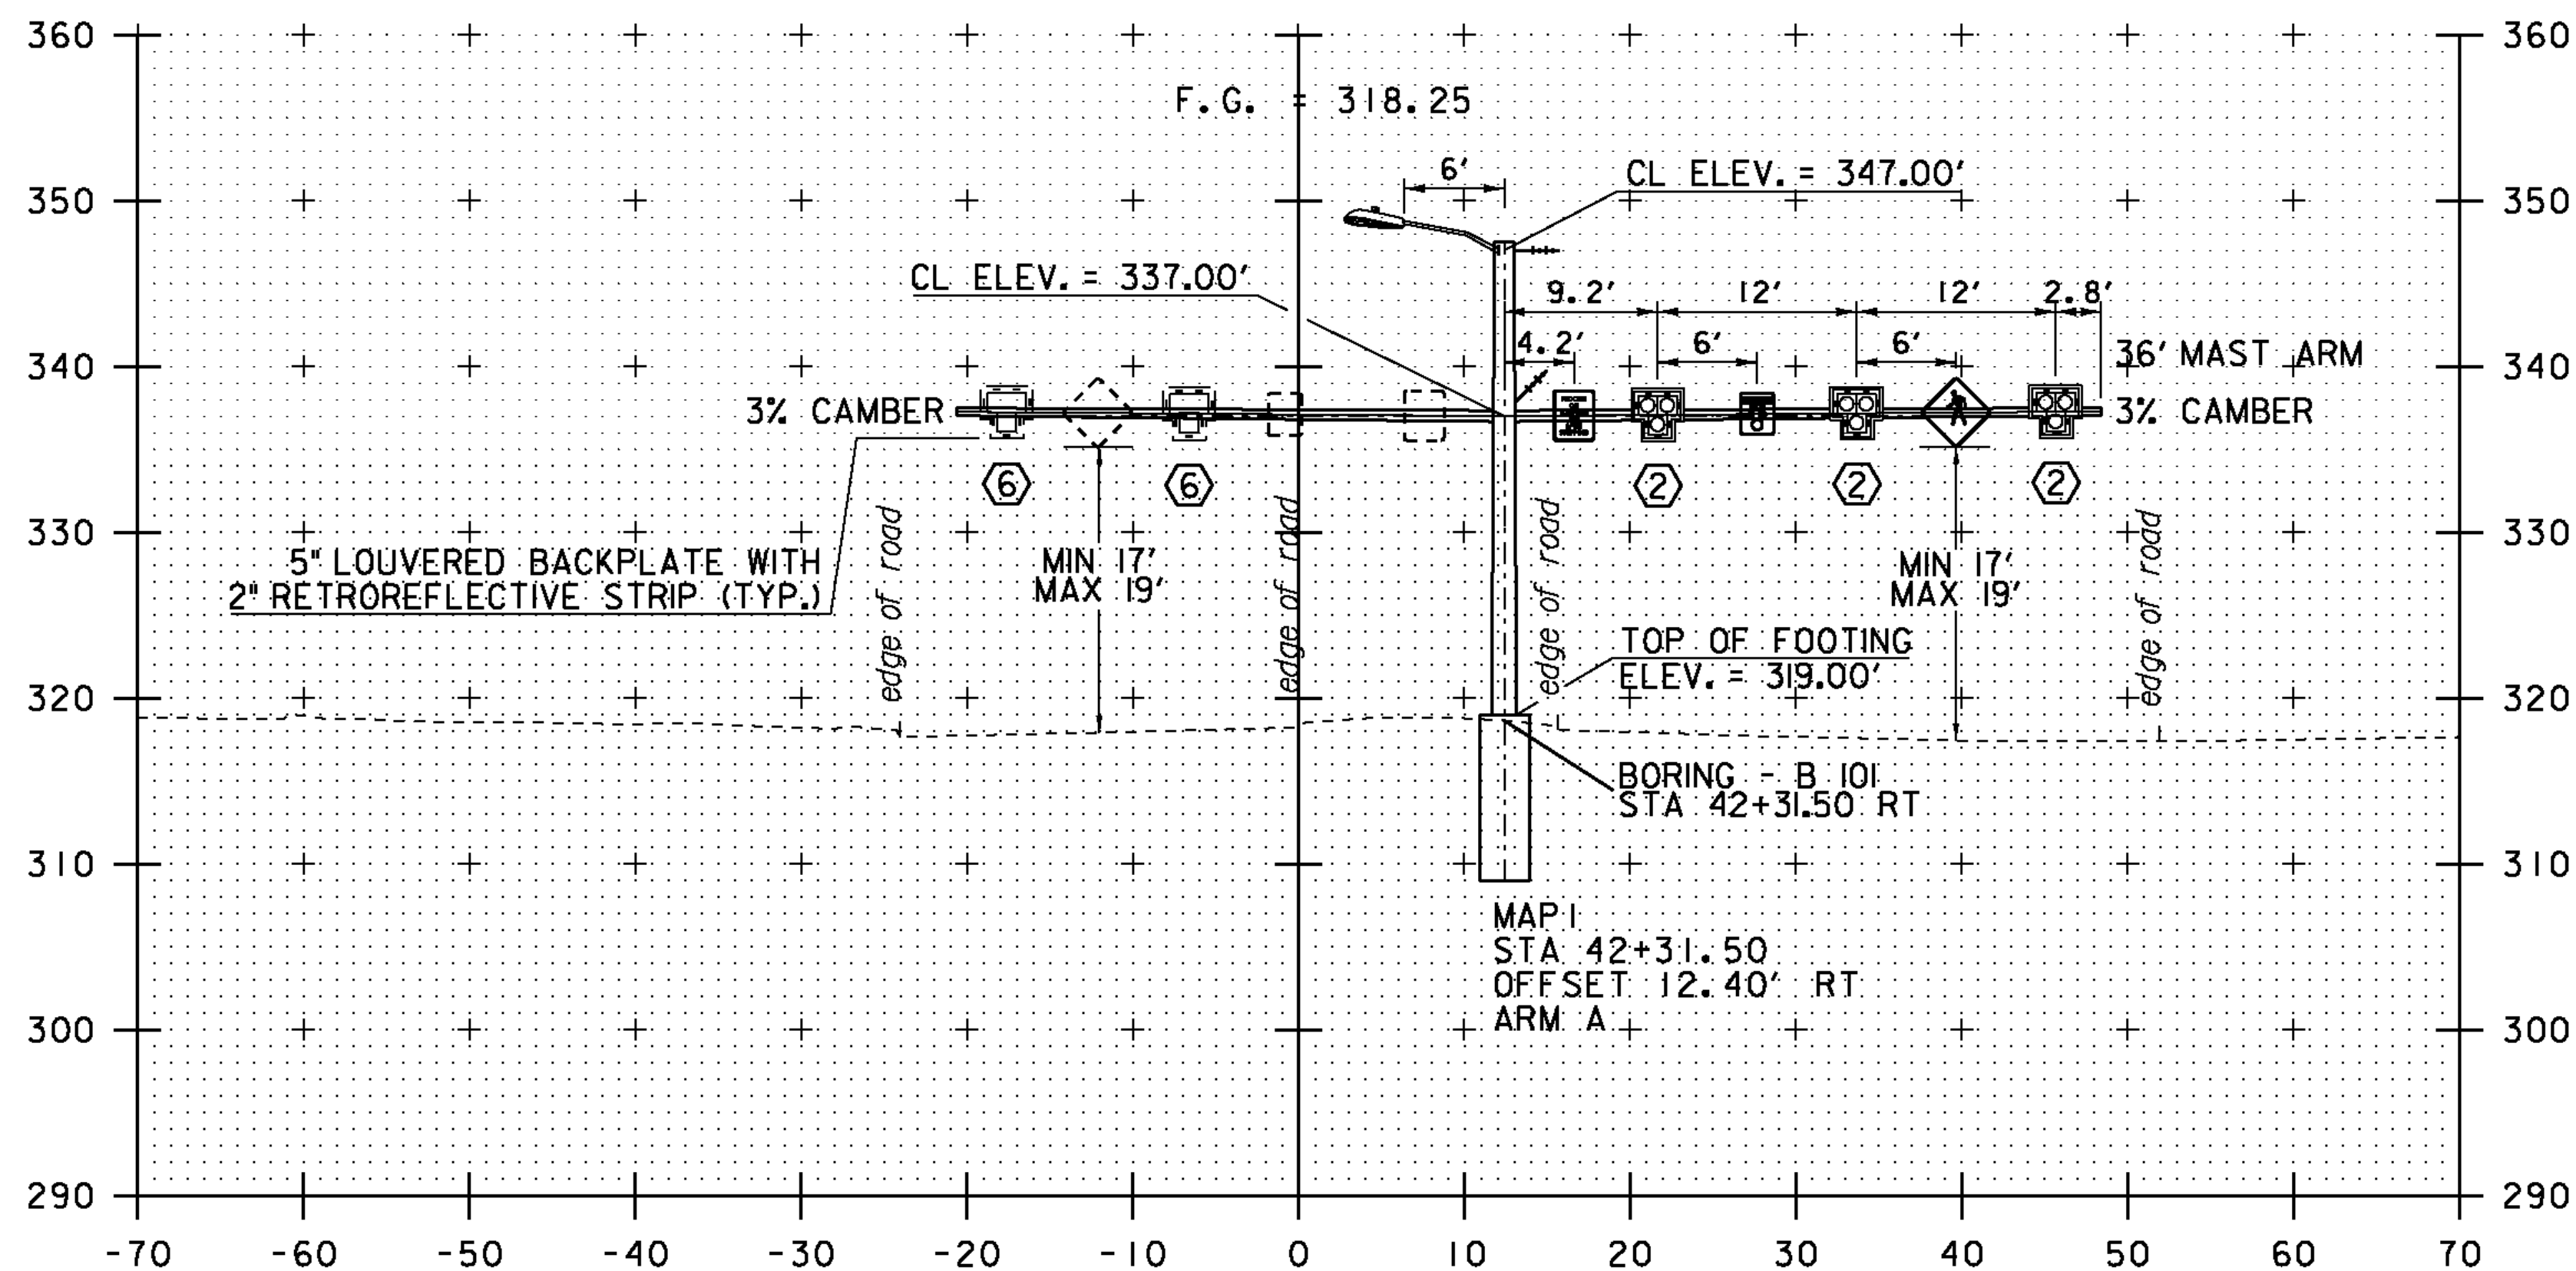

42+31.50 - VT ROUTE 15


MAST ARM B  
LOOKING WEST ON  
VT ROUTE 15

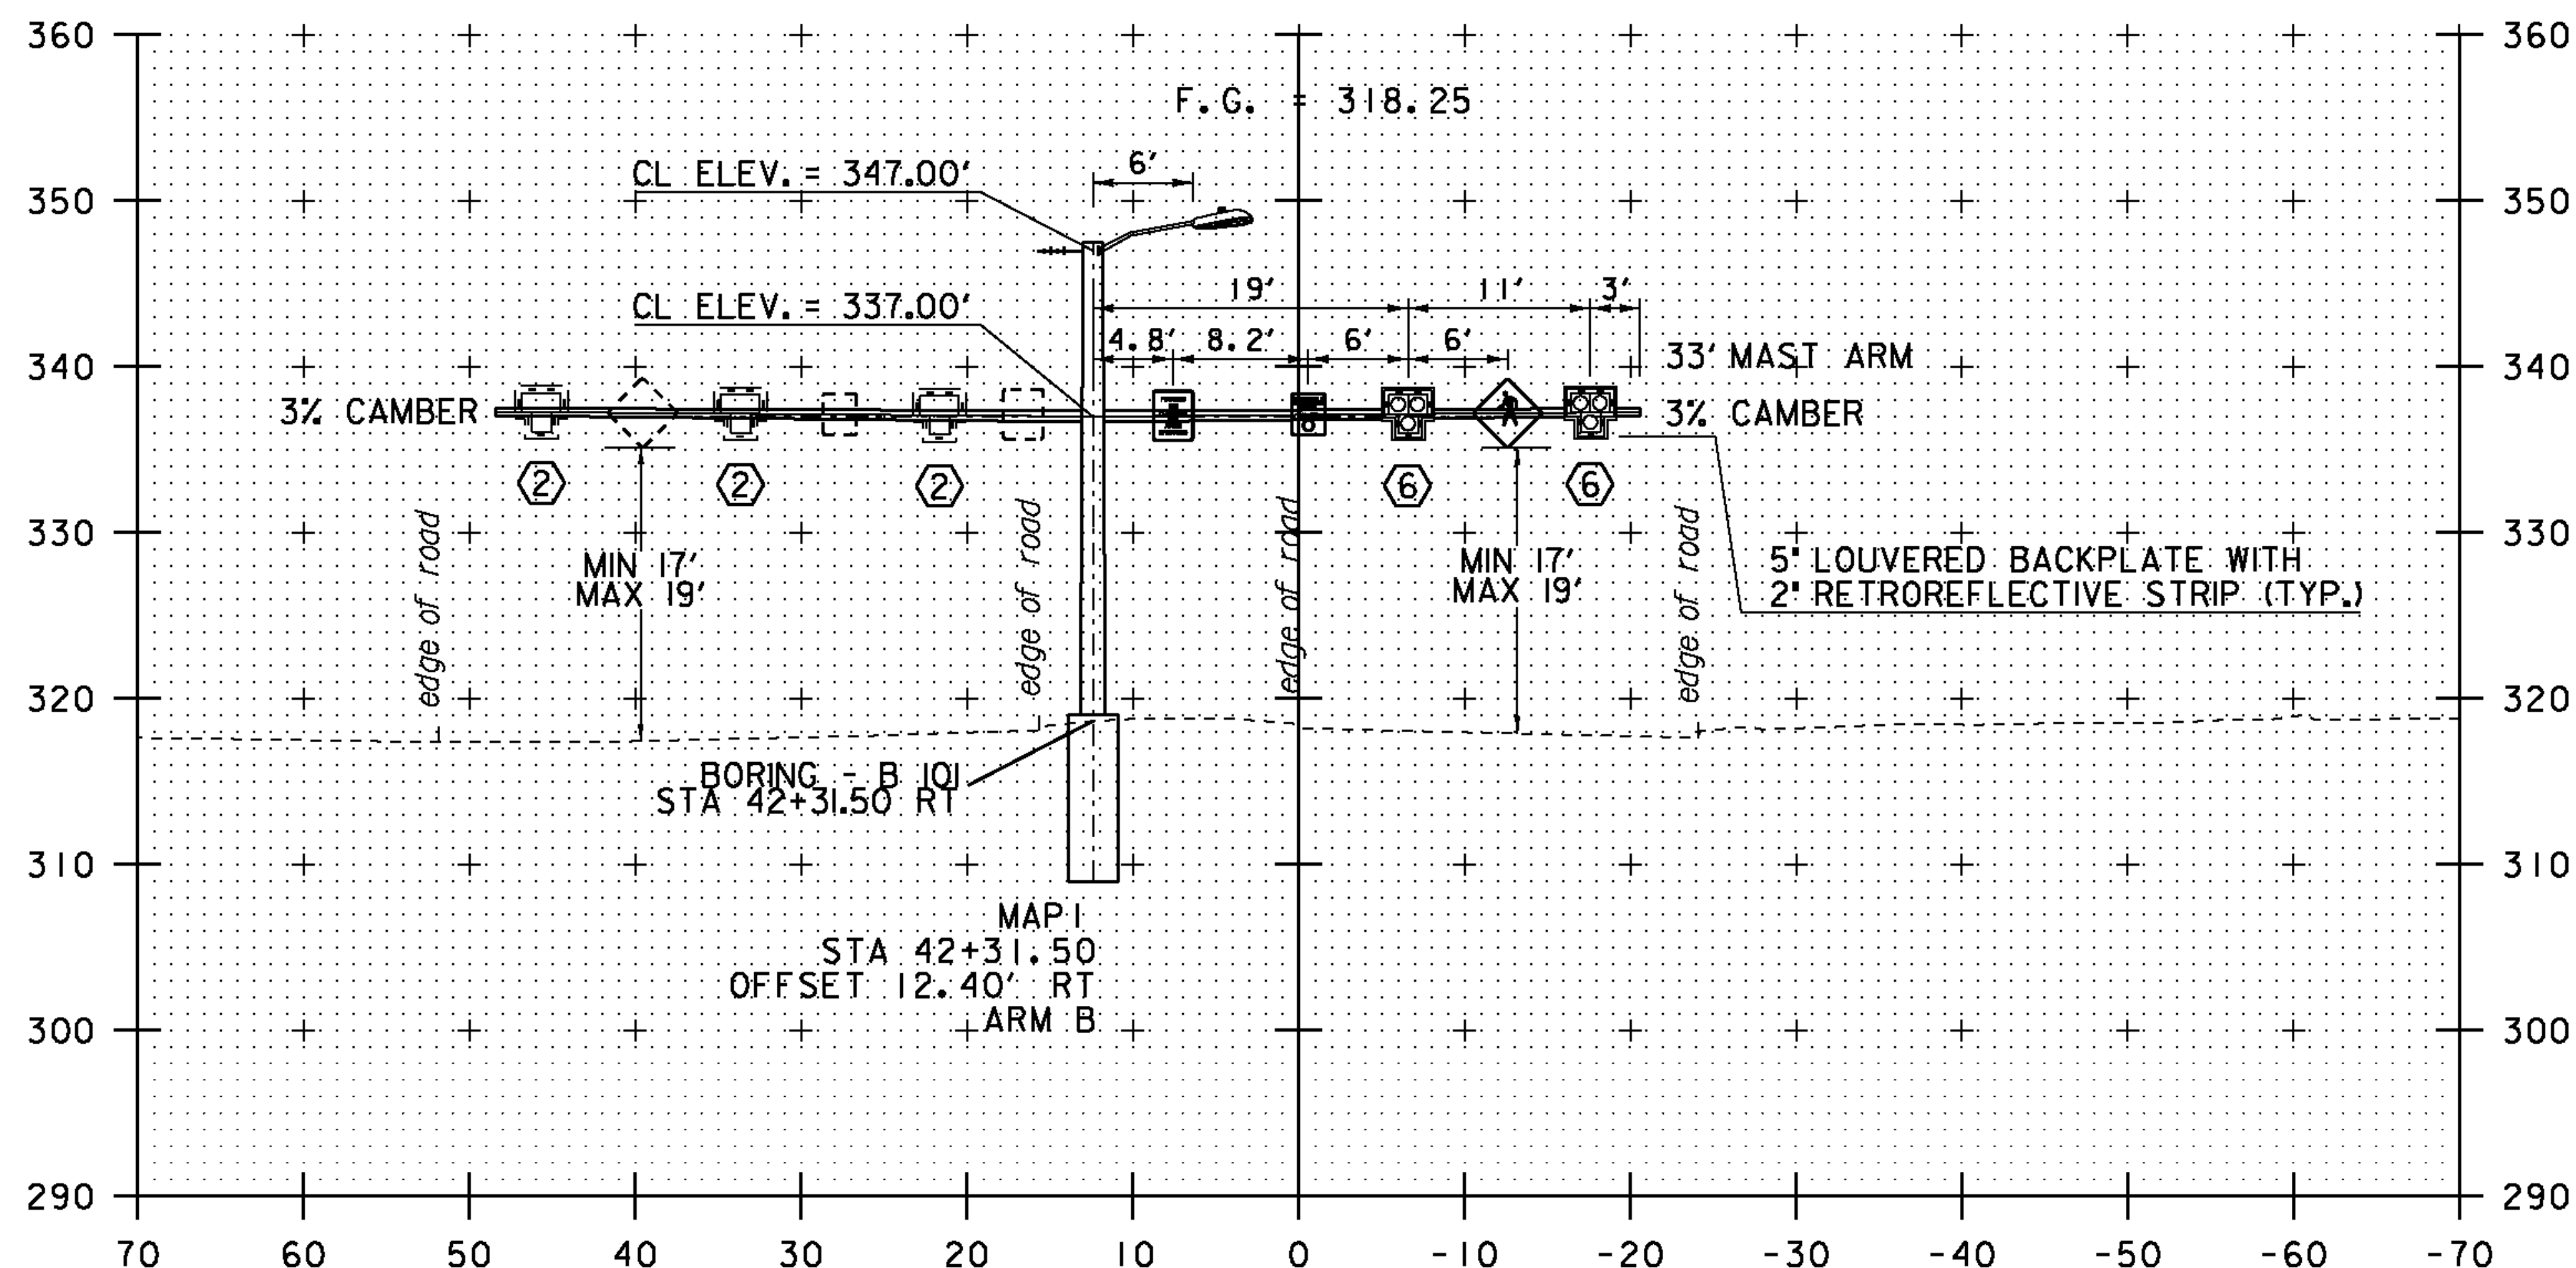

42+31.50 - VT ROUTE 15

NOTES :

1. ALL MAST ARM FOOTINGS SHALL INCLUDE A 4" REVEAL. ELEVATIONS SHOWN IN CROSS-SECTIONS ARE APPROXIMATE FINAL GRADE ELEVATIONS FOR CONTRACTOR BIDDING PURPOSES ONLY. ACTUAL FOOTING ELEVATIONS SHALL BE DETERMINED BY THE CONTRACTOR PRIOR TO SUBMITTING WORKING DRAWINGS.
2. MAST ARM FOOTING SIZES ARE NOT TO SCALE. FOOTING DESIGNS SHALL BE DETERMINED BY THE CONTRACTOR IN ACCORDANCE WITH SOIL CONDITIONS AND ACTUAL MAST ARM LOADINGS TRANSMITTED TO THE TOP OF THE FOOTINGS.
3. PLEASE REFER TO SHEET 17 FOR BORING INFORMATION. FOR ADDITIONAL INFORMATION PLEASE REFER TO THE GEOTECHNICAL REPORT IN THE CONTRACT DOCUMENTS.
4. LOCATIONS OF WIRELESS RADIO INTERCONNECT EQUIPMENT ARE APPROXIMATE. FINAL LOCATIONS FOR WIRELESS RADIO INTERCONNECT EQUIPMENT SHALL BE DETERMINED BY THE CONTRACTOR AND THE ENGINEER IN ACCORDANCE WITH THE MANUFACTURER'S RECOMMENDATIONS.
5. SIGNAL HEADS SHALL BE MOUNTED ON THE VERTICAL CENTER OF THE MAST ARM.

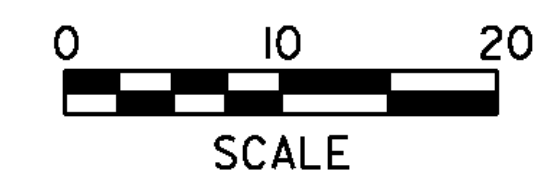

PROJECT NAME: COLCHESTER  
PROJECT NUMBER: TCSP TCSE (9)

FILE NAME: t06b242+s.dgn  
PROJECT LEADER: J. SCHULTZ  
DESIGNED BY: D. LYMAN  
MAST ARM CROSS SECTIONS

PLOT DATE: 23-FEB-2012  
DRAWN BY: D. LYMAN  
CHECKED BY: J. SCHULTZ  
SHEET 16 OF 22