


TEMPORARY 4in YELLOW LINE (PAINT)  
 DURABLE 4in YELLOW LINE (THERMOPLASTIC)  
 STA 149+42 TO 174+00 SOLID LT&RT

TEMPORARY 4in WHITE LINE (PAINT)  
 DURABLE 4in WHITE LINE (THERMOPLASTIC)  
 STA 149+42 TO 174+00 SOLID LT&RT

YIELDING MARKER POST  
 STA 150+23 LT&RT  
 STA 152+27 LT&RT

DITCHING LOCATIONS (REFER TO SHEET 10 FOR DETAILS)  
 STA 149+42 TO 150+23 LT  
 STA 152+27 TO 157+50 LT  
 STA 161+00 TO 170+75 LT

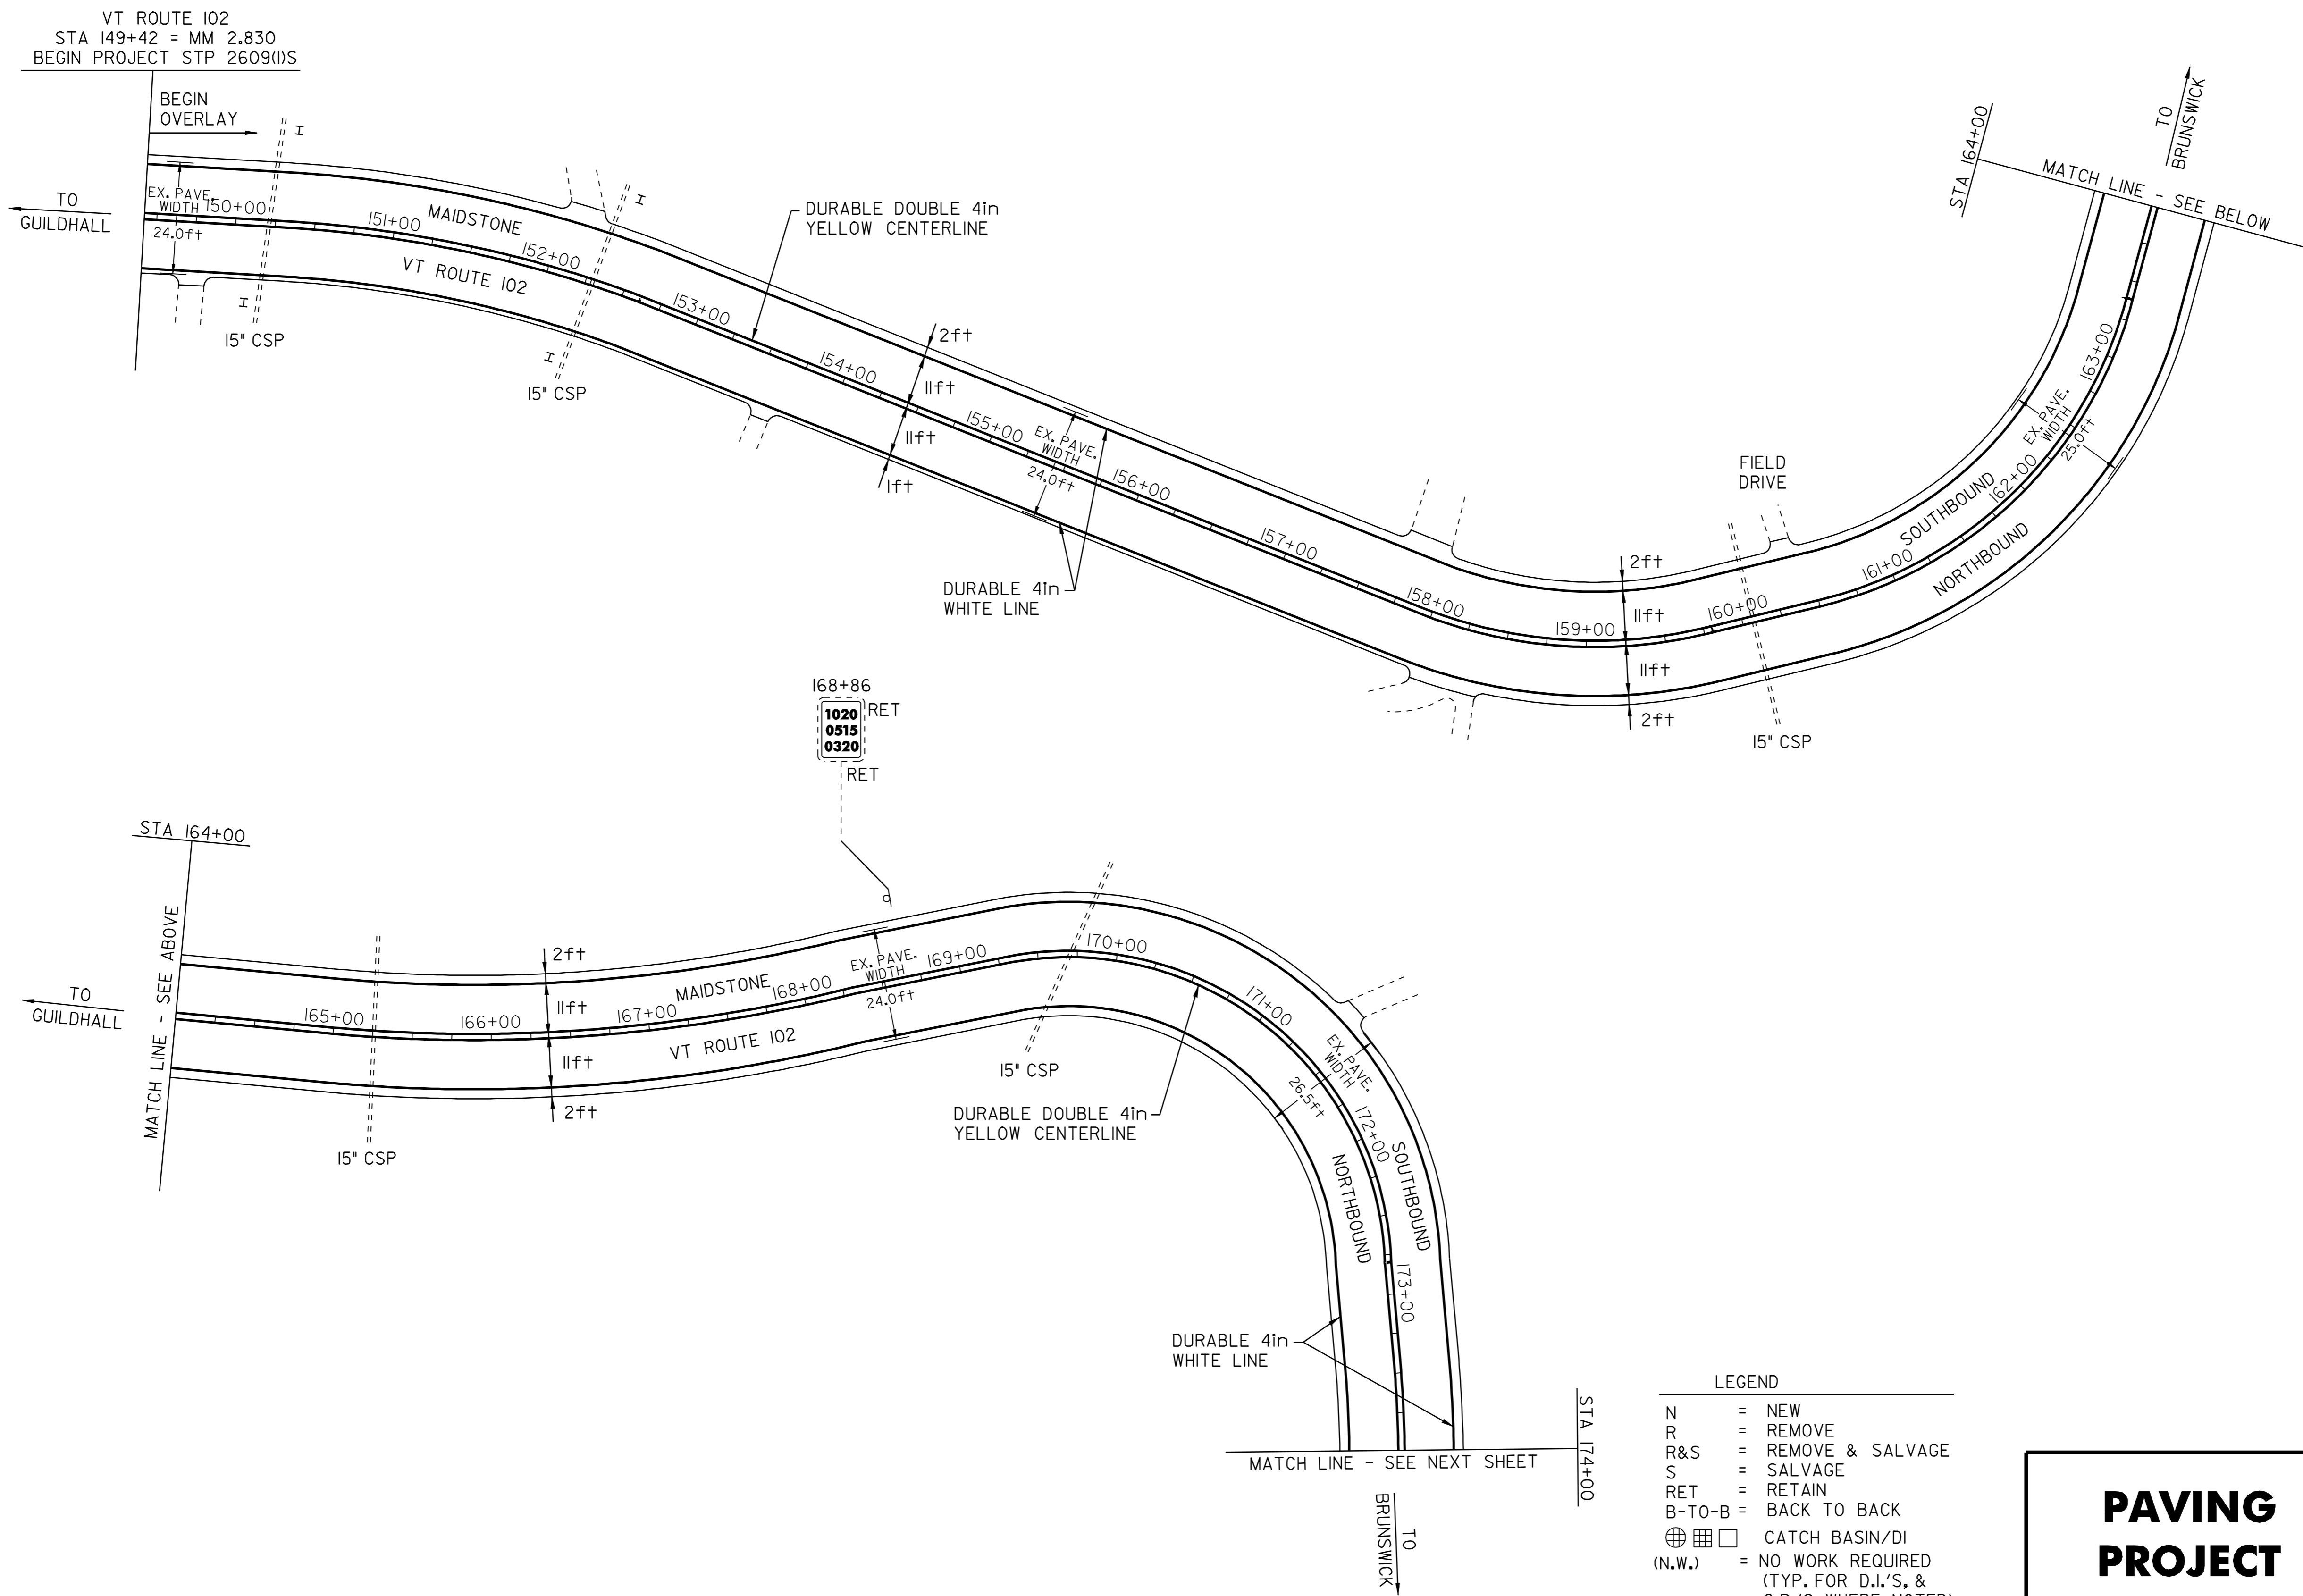

LEGEND

N	= NEW
R	= REMOVE
R&S	= REMOVE & SALVAGE
S	= SALVAGE
RET	= RETAIN
B-TO-B	= BACK TO BACK
⊕	= CATCH BASIN/DI
(N.W.)	= NO WORK REQUIRED (TYP. FOR D.I.'S, & C.B.'S WHERE NOTED)
I	= YIELDING MARKER POST
⊗	= UTILITY POLE
---	= DRIVE

## PAVING PROJECT LAYOUT SHEET #1

DESIGNED BY	BCE/PJM	DATE	10-06
DRAWN BY	C.E.A., INC.	DATE	10-06
DESIGN FILE NO.	06c042.dgn		
PRF FILE	06c042p01.i	DATE PLOTTED	24-AUG-2009
PROJ. NAME	MAIDSTONE - BLOOMFIELD		
PROJ. NO.	STP 2609(1)S		
SHEET	11	OF	40 SHEETS