


TEMPORARY 4in YELLOW LINE (PAINT)
 DURABLE 4in YELLOW LINE (THERMOPLASTIC)
 STA 204+00 TO 235+00 SOLID LT&R

TEMPORARY 4in WHITE LINE (PAINT)
 DURABLE 4in WHITE LINE (THERMOPLASTIC)
 STA 204+00 TO 235+00 SOLID LT&R

YIELDING MARKER POST
 STA 219+69 LT
 STA 227+50 LT

DITCHING LOCATIONS (REFER TO SHEET 10 FOR DETAILS)
 STA 204+00 TO 213+65 LT
 STA 216+30 TO 218+30 LT

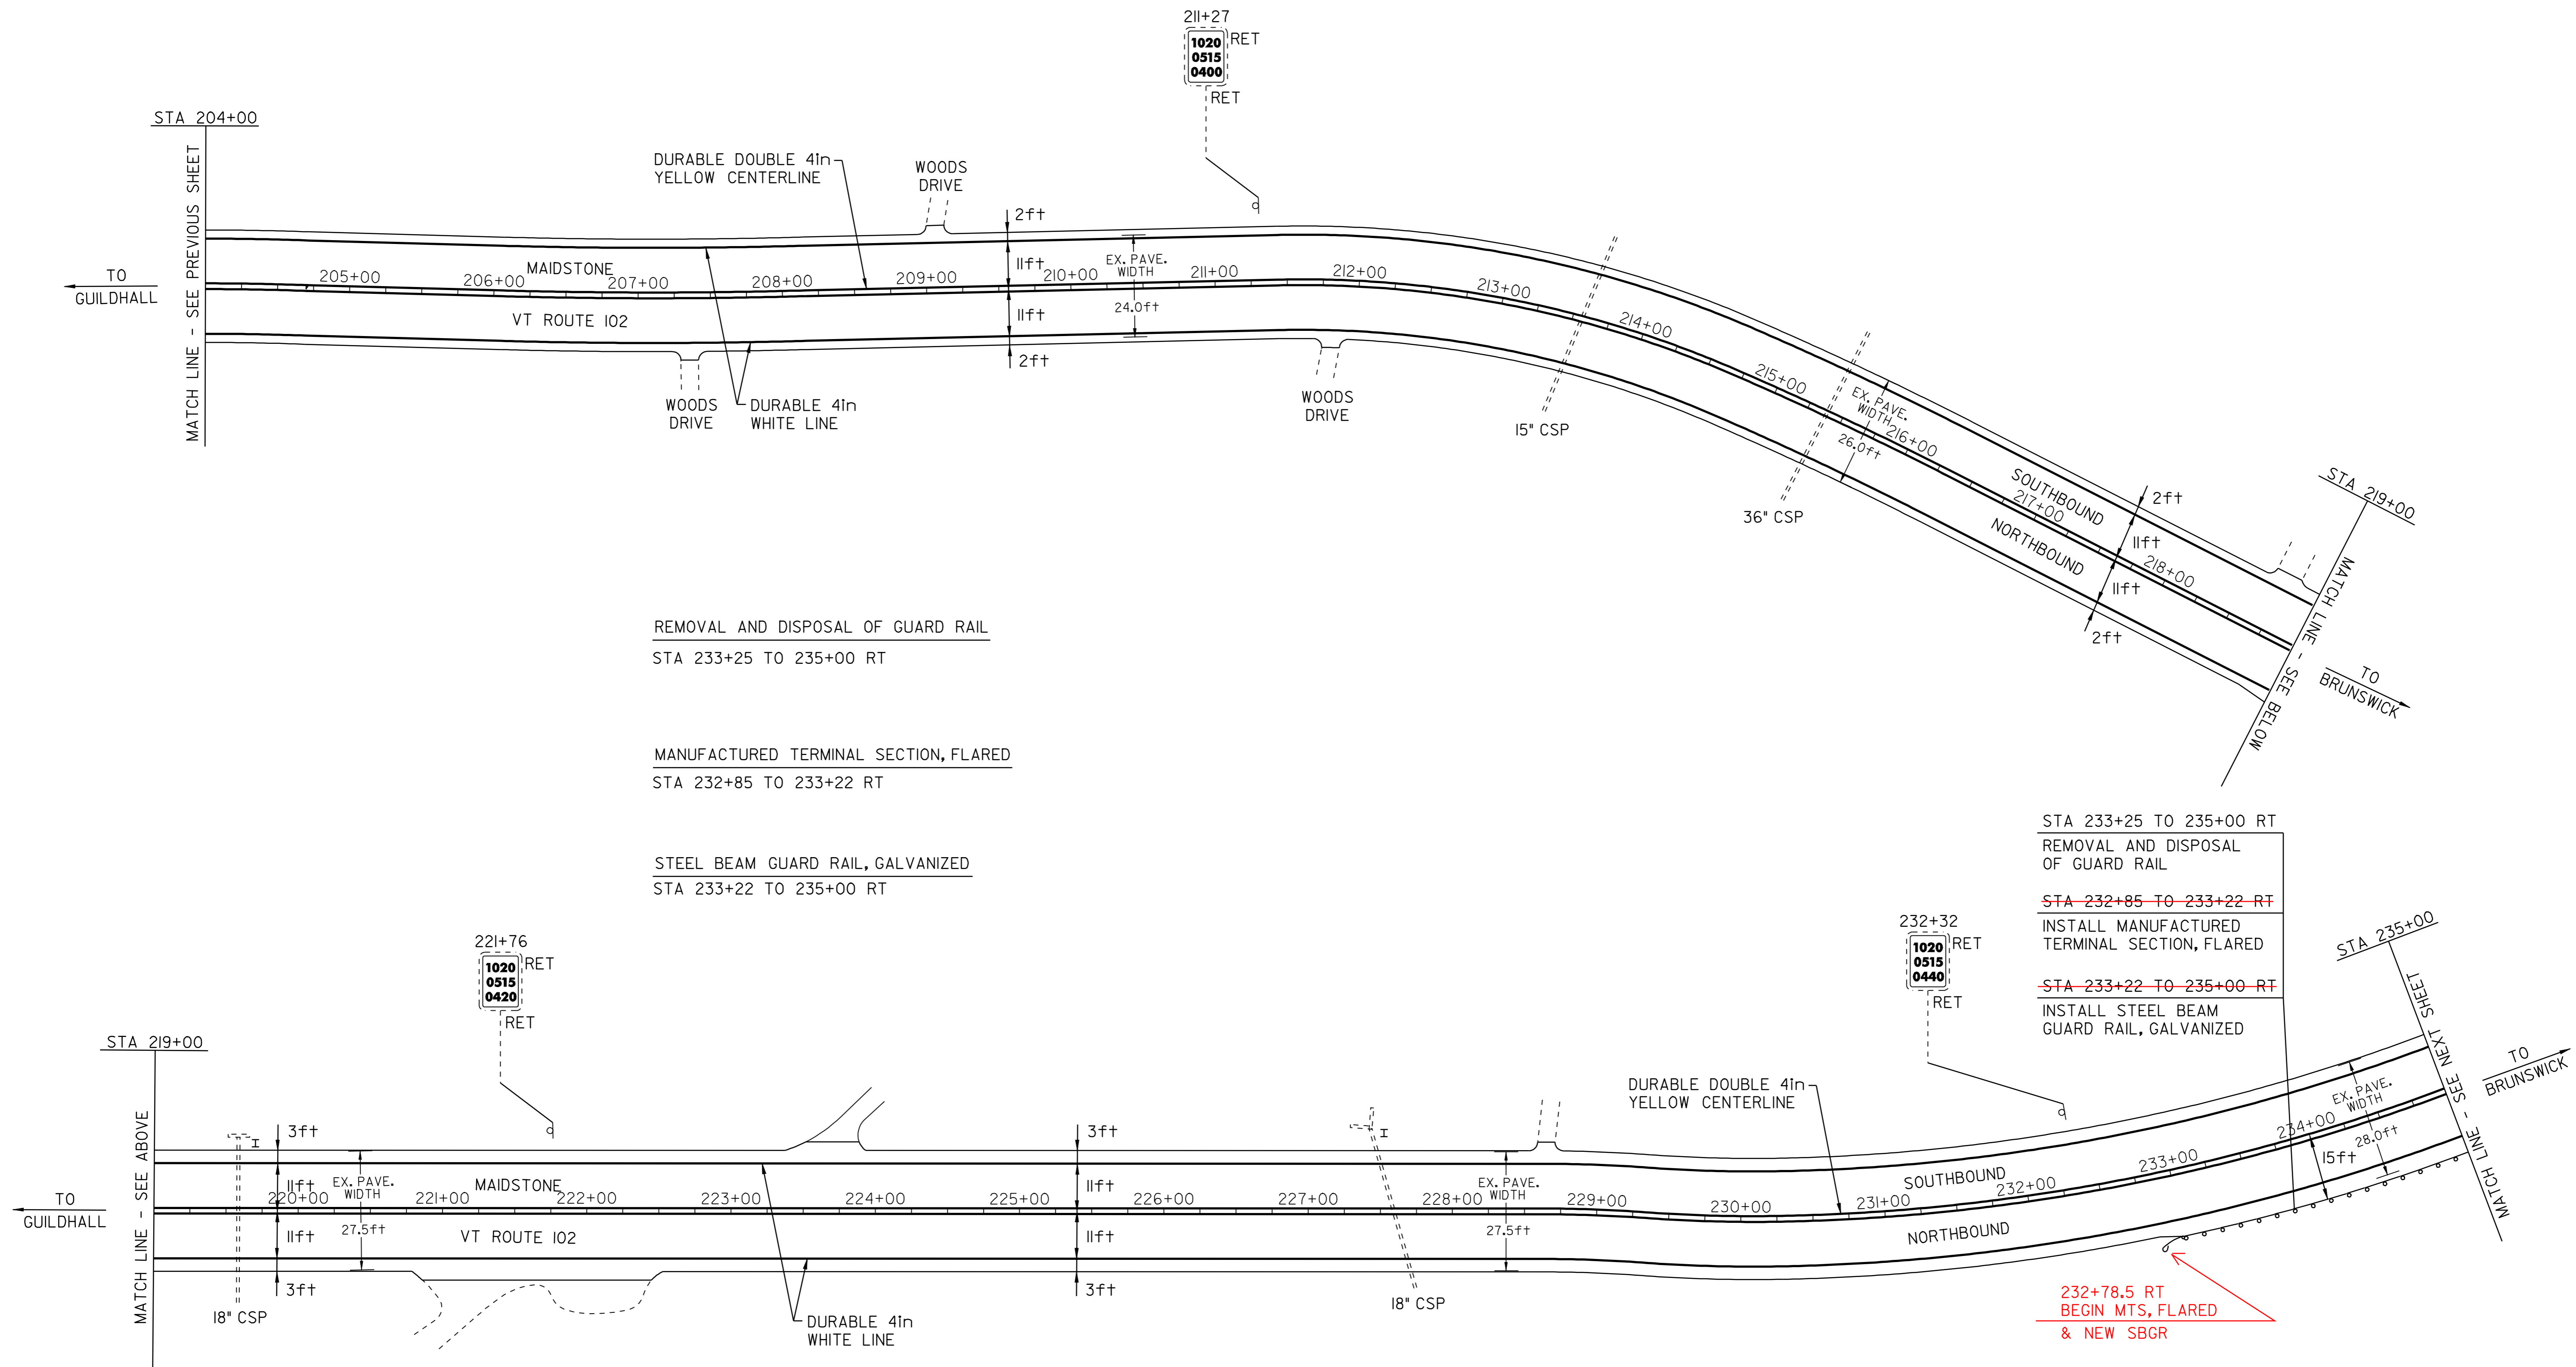

REMOVAL AND DISPOSAL OF GUARD RAIL
 STA 233+25 TO 235+00 RT

MANUFACTURED TERMINAL SECTION, FLARED
 STA 232+85 TO 233+22 RT

STEEL BEAM GUARD RAIL, GALVANIZED
 STA 233+22 TO 235+00 RT

STA 233+25 TO 235+00 RT
 REMOVAL AND DISPOSAL
 OF GUARD RAIL

STA 232+85 TO 233+22 RT
 INSTALL MANUFACTURED
 TERMINAL SECTION, FLARED

STA 233+22 TO 235+00 RT
 INSTALL STEEL BEAM
 GUARD RAIL, GALVANIZED

- LEGEND
- N = NEW
 - R = REMOVE
 - R&S = REMOVE & SALVAGE
 - S = SALVAGE
 - RET = RETAIN
 - B-TO-B = BACK TO BACK
 - ⊕ ⊞ □ CATCH BASIN/DI (N.W.) = NO WORK REQUIRED (TYP. FOR D.I.'S, & C.B.'S WHERE NOTED)
 - I YIELDING MARKER POST
 - ⊙ UTILITY POLE
 - - - DRIVE

PAVING PROJECT LAYOUT SHEET #3

DESIGNED BY	BCE/PJM	DATE	10-06
DRAWN BY	C.E.A., INC.	DATE	10-06
DESIGN FILE NO.	06c042.dgn		
PRF FILE	06c042p03.1	DATE PLOTTED	24-AUG-2009
PROJ. NAME	MAIDSTONE - BLOOMFIELD		
PROJ. NO.	STP 2609(1)S		
SHEET	13	OF	40 SHEETS