

TEMPORARY 4in YELLOW LINE (PAINT)
DURABLE 4in YELLOW LINE (THERMOPLASTIC)

STA 235+00 TO 248+69 SOLID LT&RT
STA 248+69 TO 256+87 SOLID LT & DASHED RT
STA 256+87 TO 262+94 DASHED
STA 262+94 TO 265+00 DASHED LT & SOLID RT

TEMPORARY 4in WHITE LINE (PAINT)
DURABLE 4in WHITE LINE (THERMOPLASTIC)


STA 235+00 TO 265+00 SOLID LT&RT

YIELDING MARKER POST

STA 238+15 LT&RT
STA 258+79 LT
STA 263+07 LT

REHABILITATION OF D.I., C.B., OR M.H.

STA 245+40 RT

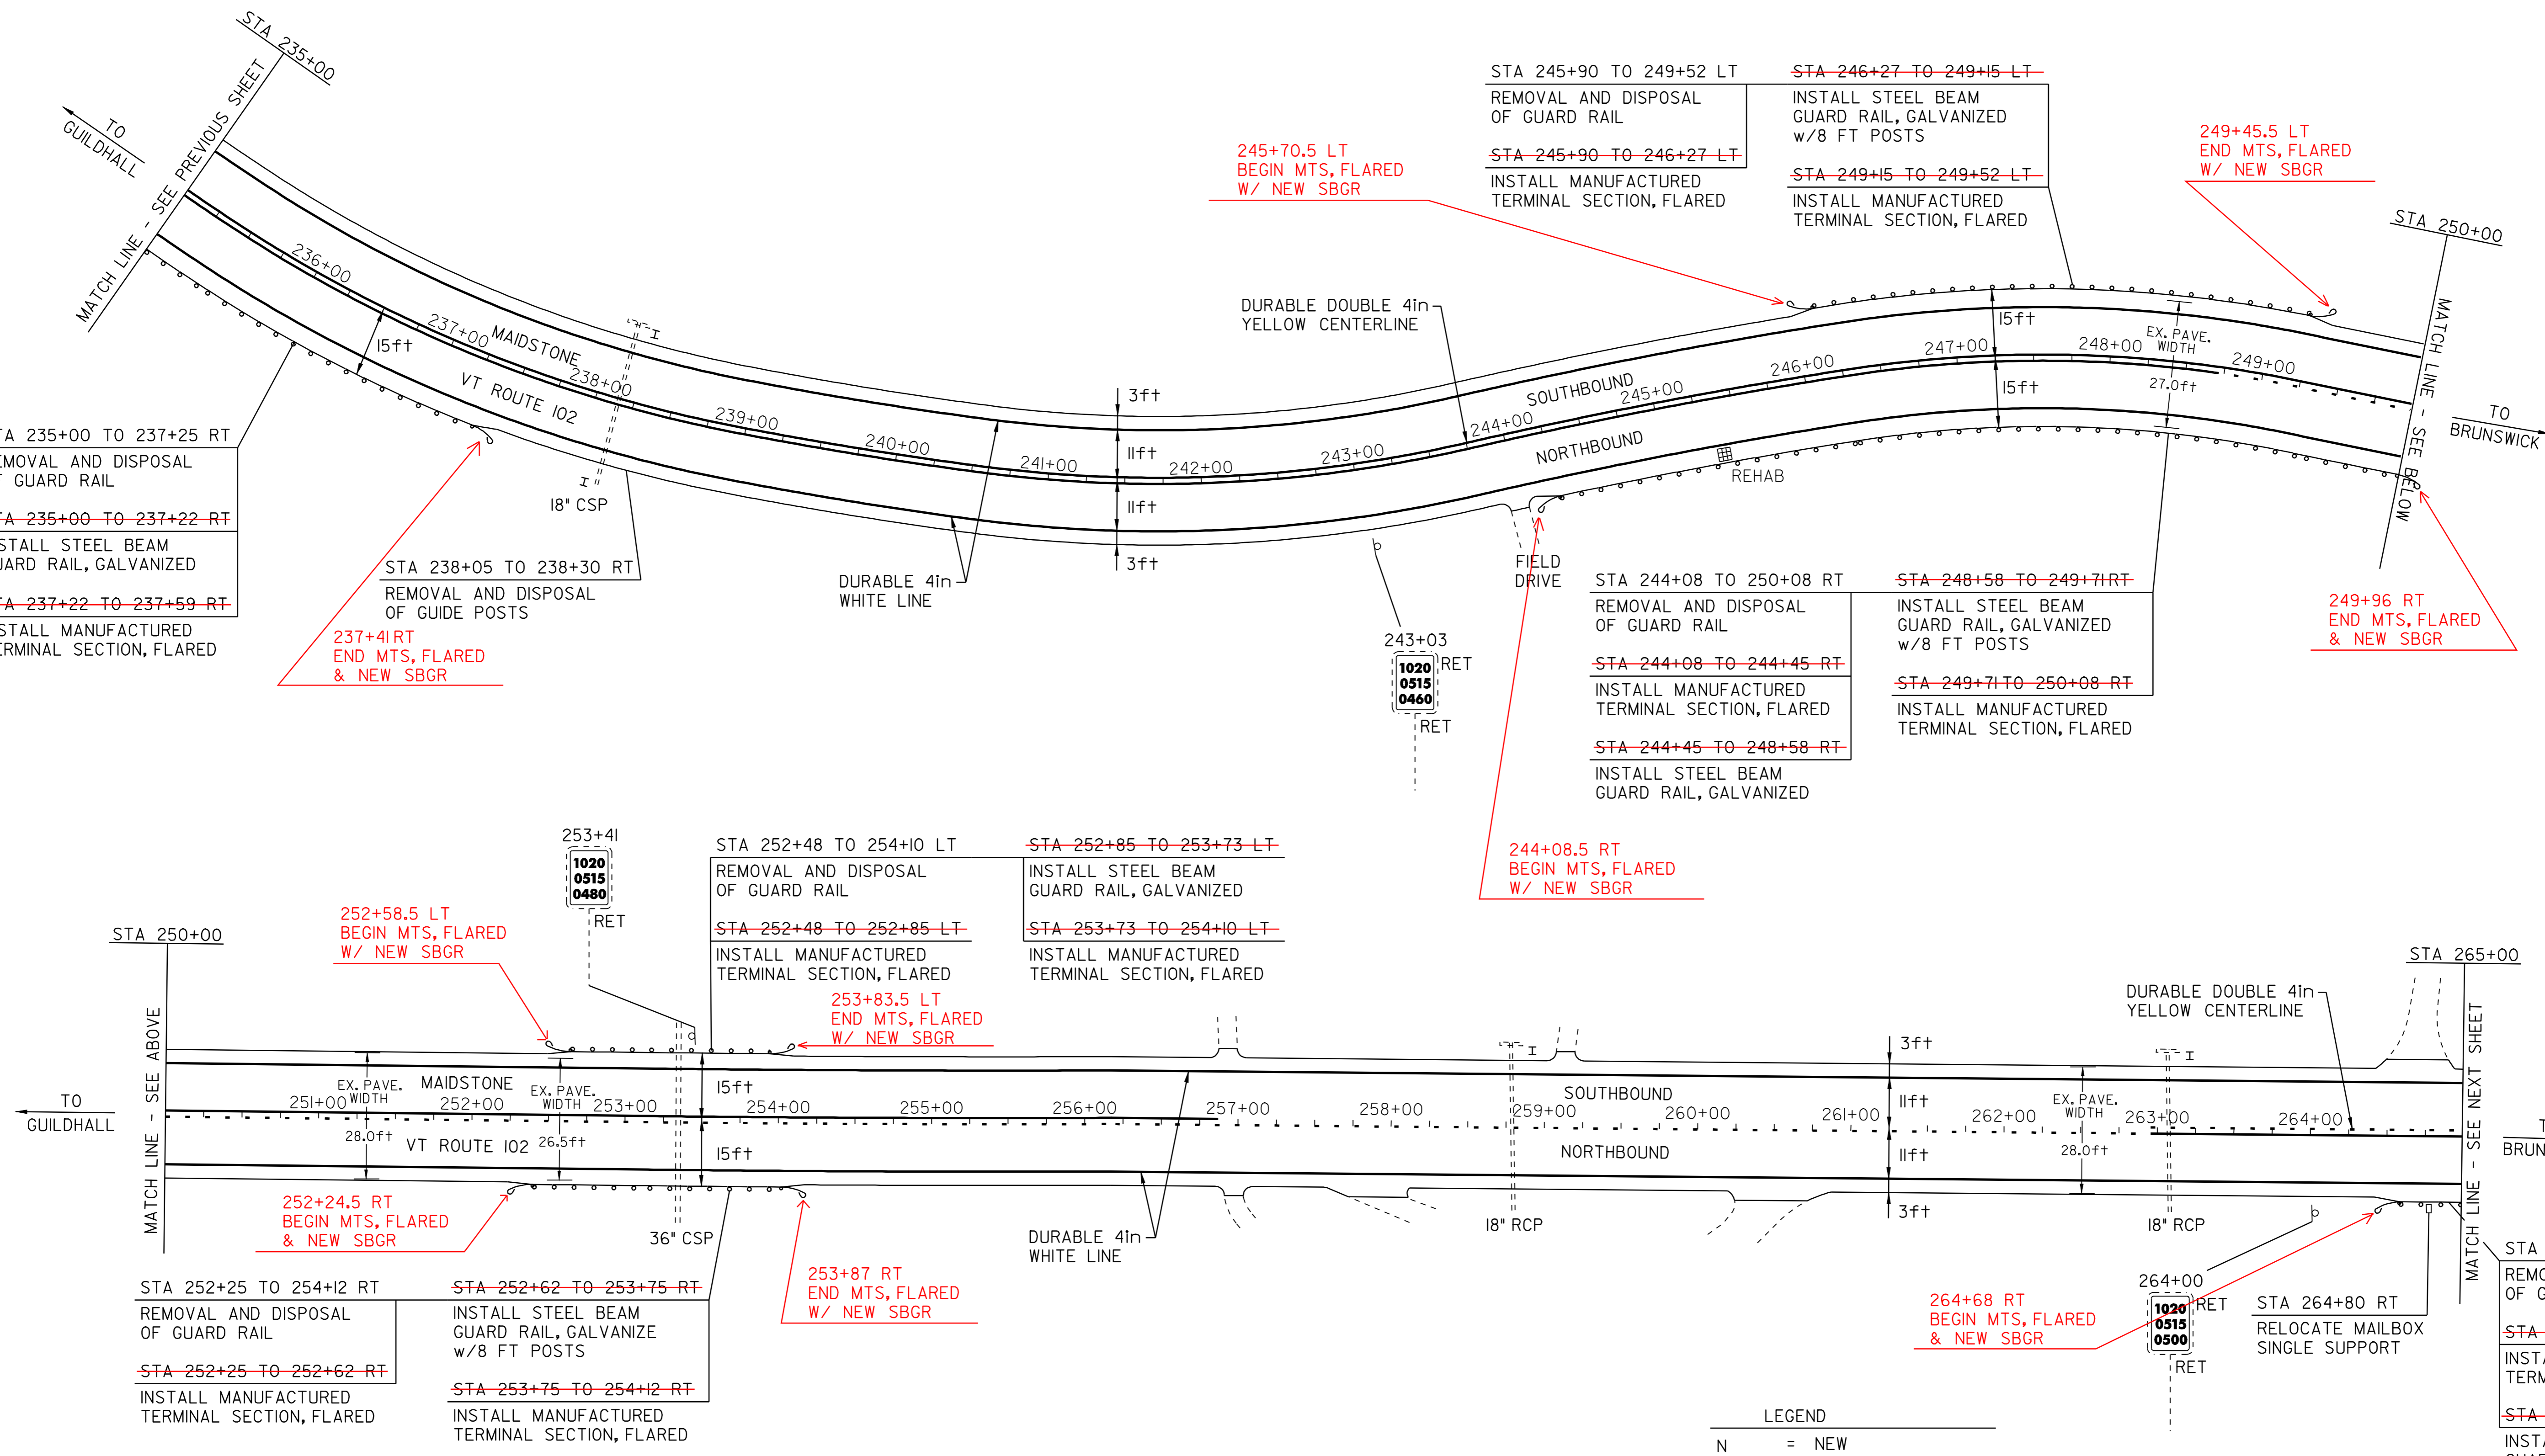

~~MANUFACTURED TERMINAL SECTION, FLARED~~

~~STA 237+22 TO 237+59 RT~~
~~STA 244+08 TO 244+45 RT~~
~~STA 249+71 TO 250+08 RT~~
~~STA 245+90 TO 246+27 LT~~
~~STA 249+15 TO 249+52 LT~~
~~STA 252+25 TO 252+62 RT~~
~~STA 252+48 TO 252+85 LT~~
~~STA 253+73 TO 254+10 LT~~
~~STA 253+75 TO 254+12 RT~~
~~STA 264+43 TO 264+80 RT~~

REMOVAL AND DISPOSAL OF GUARD RAIL

STA 235+00 TO 237+25 RT
STA 244+08 TO 250+08 RT
STA 245+90 TO 249+52 LT
STA 252+25 TO 254+12 RT
STA 252+48 TO 265+00 RT

REMOVAL AND DISPOSAL OF GUIDE POSTS

STA 238+05 TO 238+30 RT - 3

~~STEEL BEAM GUARD RAIL, GALVANIZED~~

~~STA 235+00 TO 237+22 RT~~
~~STA 244+45 TO 248+58 RT~~
~~STA 252+85 TO 253+73 LT~~
~~STA 264+80 TO 265+00 RT~~

~~STEEL BEAM GUARD RAIL, GALVANIZED w/8 FT POSTS~~

~~STA 248+58 TO 249+71 RT~~
~~STA 246+27 TO 249+15 LT~~
~~STA 252+62 TO 253+75 RT~~

RELOCATE MAILBOX, SINGLE SUPPORT

STA 264+80 RT

- LEGEND
- N = NEW
 - R = REMOVE
 - R&S = REMOVE & SALVAGE
 - S = SALVAGE
 - RET = RETAIN
 - B-T-O-B = BACK TO BACK
 - ⊕ ⊞ ⊠ CATCH BASIN/DI
 - (N.W.) = NO WORK REQUIRED (TYP. FOR D.I.'S, & C.B.'S WHERE NOTED)
 - I YIELDING MARKER POST
 - ⊕ UTILITY POLE
 - ⊞ DRIVE

PAVING PROJECT LAYOUT SHEET #4

DESIGNED BY BCE/PJM DATE 10-06

DRAWN BY C.E.A., INC. DATE 10-06

DESIGN FILE NO. 06c042.dgn

PRF FILE 06c042p04.i DATE PLOTTED 24-AUG-2009

PROJ. NAME **MAIDSTONE - BLOOMFIELD**

PROJ. NO. **STP 2609(1)S**

SHEET **14** OF **40** SHEETS