

TEMPORARY 4in YELLOW LINE (PAINT)
 DURABLE 4in YELLOW LINE (THERMOPLASTIC)
 STA 265+00 TO 270+07 DASHED LT & SOLID RT
 STA 270+07 TO 295+00 SOLID LT&RT

TEMPORARY 4in WHITE LINE (PAINT)
 DURABLE 4in WHITE LINE (THERMOPLASTIC)
 STA 265+00 TO 295+00 SOLID LT&RT

YIELDING MARKER POST

STA 267+06 LT
 STA 270+20 LT
 STA 273+55 LT
 STA 278+76 LT
 STA 293+91 LT

REHABILITATION OF D.I., C.B., OR M.H.

STA 291+31 RT

~~TREATED TIMBER CURB~~

~~STA 291+31 TO 292+37 RT~~

REMOVAL AND DISPOSAL OF GUIDE POSTS

STA 271+0 TO 271+40 RT - 3
 STA 279+52 TO 280+45 RT - 7
 STA 290+30 TO 291+30 RT - 4

REMOVAL AND DISPOSAL OF GUARD RAIL

STA 265+00 TO 270+18 RT
 STA 271+55 TO 275+05 RT
 STA 282+40 TO 287+40 RT
 STA 283+07 TO 284+45 LT
 STA 291+30 TO 292+80 RT
 STA 293+25 TO 295+15 RT

~~MANUFACTURED TERMINAL SECTION, FLARED~~

~~STA 269+81 TO 270+18 RT~~
~~STA 271+55 TO 271+92 RT~~
~~STA 275+05 TO 275+42 RT~~
~~STA 281+65 TO 282+02 RT~~
~~STA 282+70 TO 283+07 LT~~
~~STA 284+08 TO 284+45 LT~~
~~STA 287+40 TO 287+77 RT~~
~~STA 290+92 TO 291+30 RT~~
~~STA 293+12 TO 293+50 RT~~
~~STA 294+88 TO 295+25 RT~~

RELOCATE MAILBOX, SINGLE SUPPORT

STA 270+12 RT
 STA 285+45 RT
 STA 290+30 RT

~~STEEL BEAM GUARD RAIL, GALVANIZED~~


~~STA 265+00 TO 267+05 RT~~
~~STA 271+92 TO 272+30 RT~~
~~STA 291+30 TO 292+30 RT~~
~~STA 293+50 TO 294+88 RT~~

~~STEEL BEAM GUARD RAIL, GALVANIZED w/8 FT POSTS~~

~~STA 267+05 TO 269+81 RT~~
~~STA 272+30 TO 275+05 RT~~
~~STA 282+02 TO 287+40 RT~~
~~STA 283+07 TO 284+08 LT~~

MANUFACTURED TERMINAL SECTION, TANGENT

STA 292+30 TO 292+80 RT

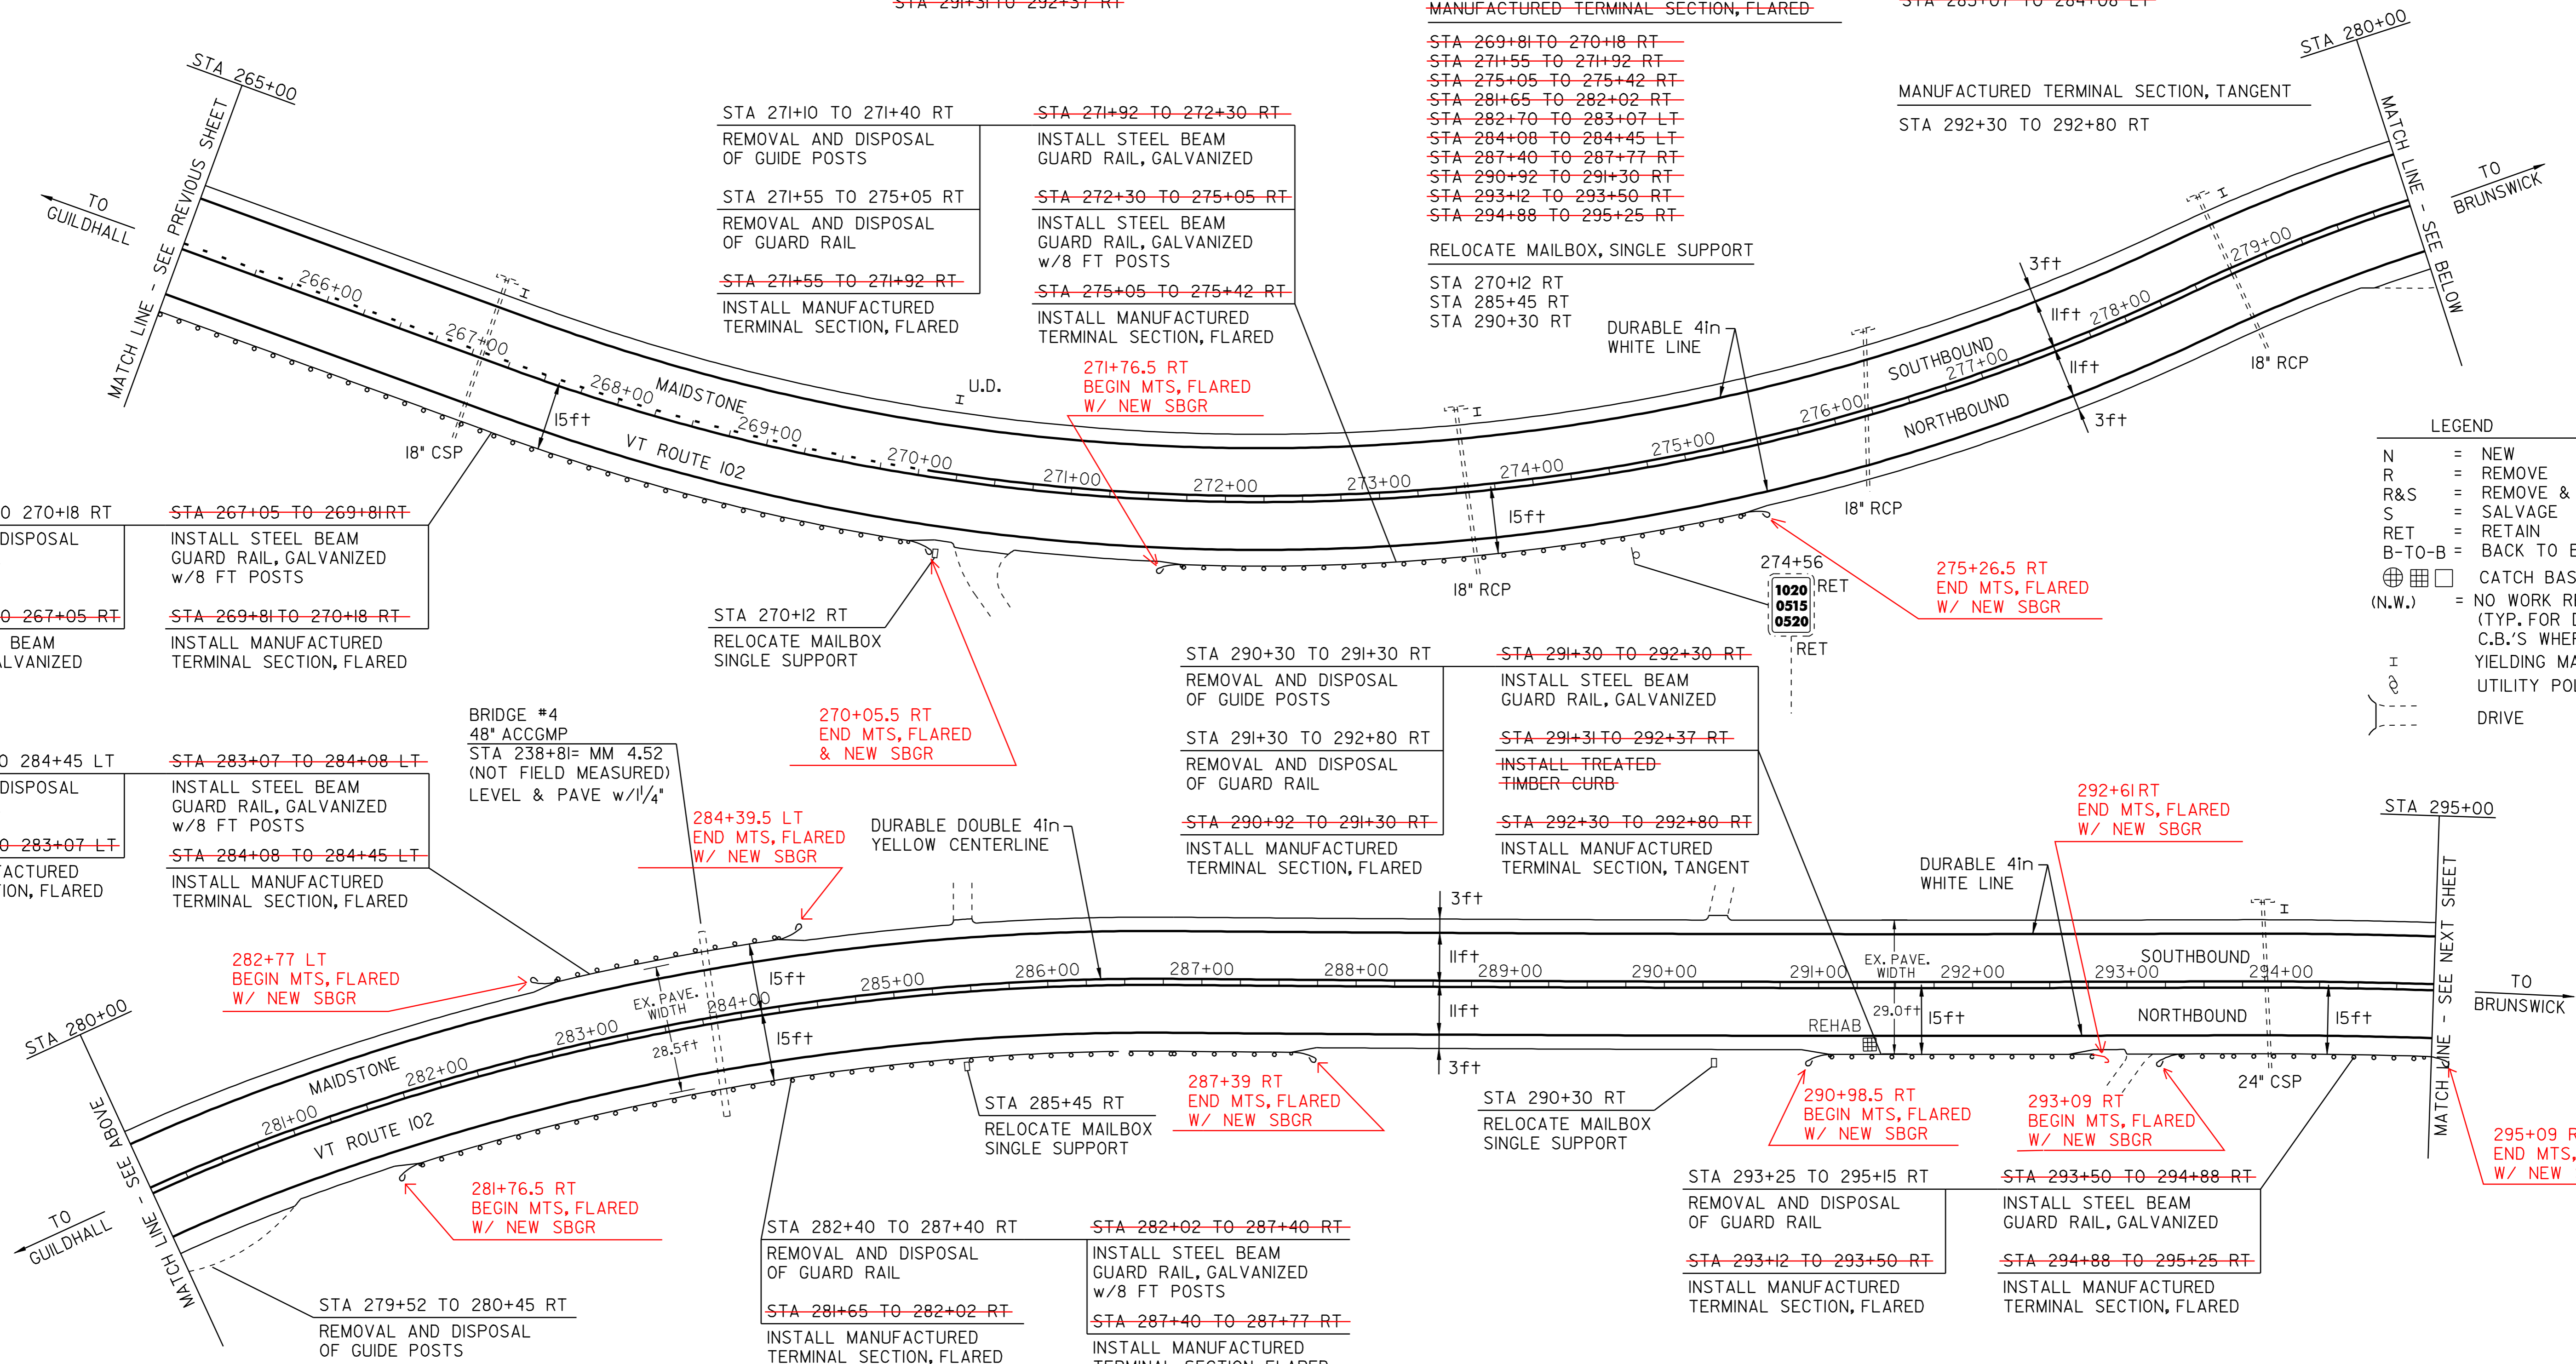

LEGEND

N	=	NEW
R	=	REMOVE
R&S	=	REMOVE & SALVAGE
S	=	SALVAGE
RET	=	RETAIN
B-TO-B	=	BACK TO BACK
⊗	=	CATCH BASIN/DI
(N.W.)	=	NO WORK REQUIRED (TYP. FOR D.I.'S, & C.B.'S WHERE NOTED)
I	=	YIELDING MARKER POST
⊕	=	UTILITY POLE
---	=	DRIVE

PAVING PROJECT LAYOUT SHEET #5

DESIGNED BY	BCE/PJM	DATE	10-06
DRAWN BY	C.E.A., INC.	DATE	10-06
DESIGN FILE NO.	06c042.dgn		
PRF FILE	06c042p05.1	DATE PLOTTED	24-AUG-2009
PROJ. NAME	MAIDSTONE - BLOOMFIELD		
PROJ. NO.	STP 2609(1)S		
SHEET	15	OF	40 SHEETS