


TEMPORARY 4in YELLOW LINE (PAINT)
DURABLE 4in WHITE LINE (THERMOPLASTIC)
STA 295+00 TO 325+00 SOLID LT&R

TEMPORARY 4in WHITE LINE (PAINT)
DURABLE 4in WHITE LINE (THERMOPLASTIC)
STA 295+00 TO 325+00 SOLID LT&R

YIELDING MARKER POST
STA 296+43 RT

DITCHING LOCATIONS (REFER TO SHEET 10 FOR DETAILS)
STA 306+00 TO 316+00 LT

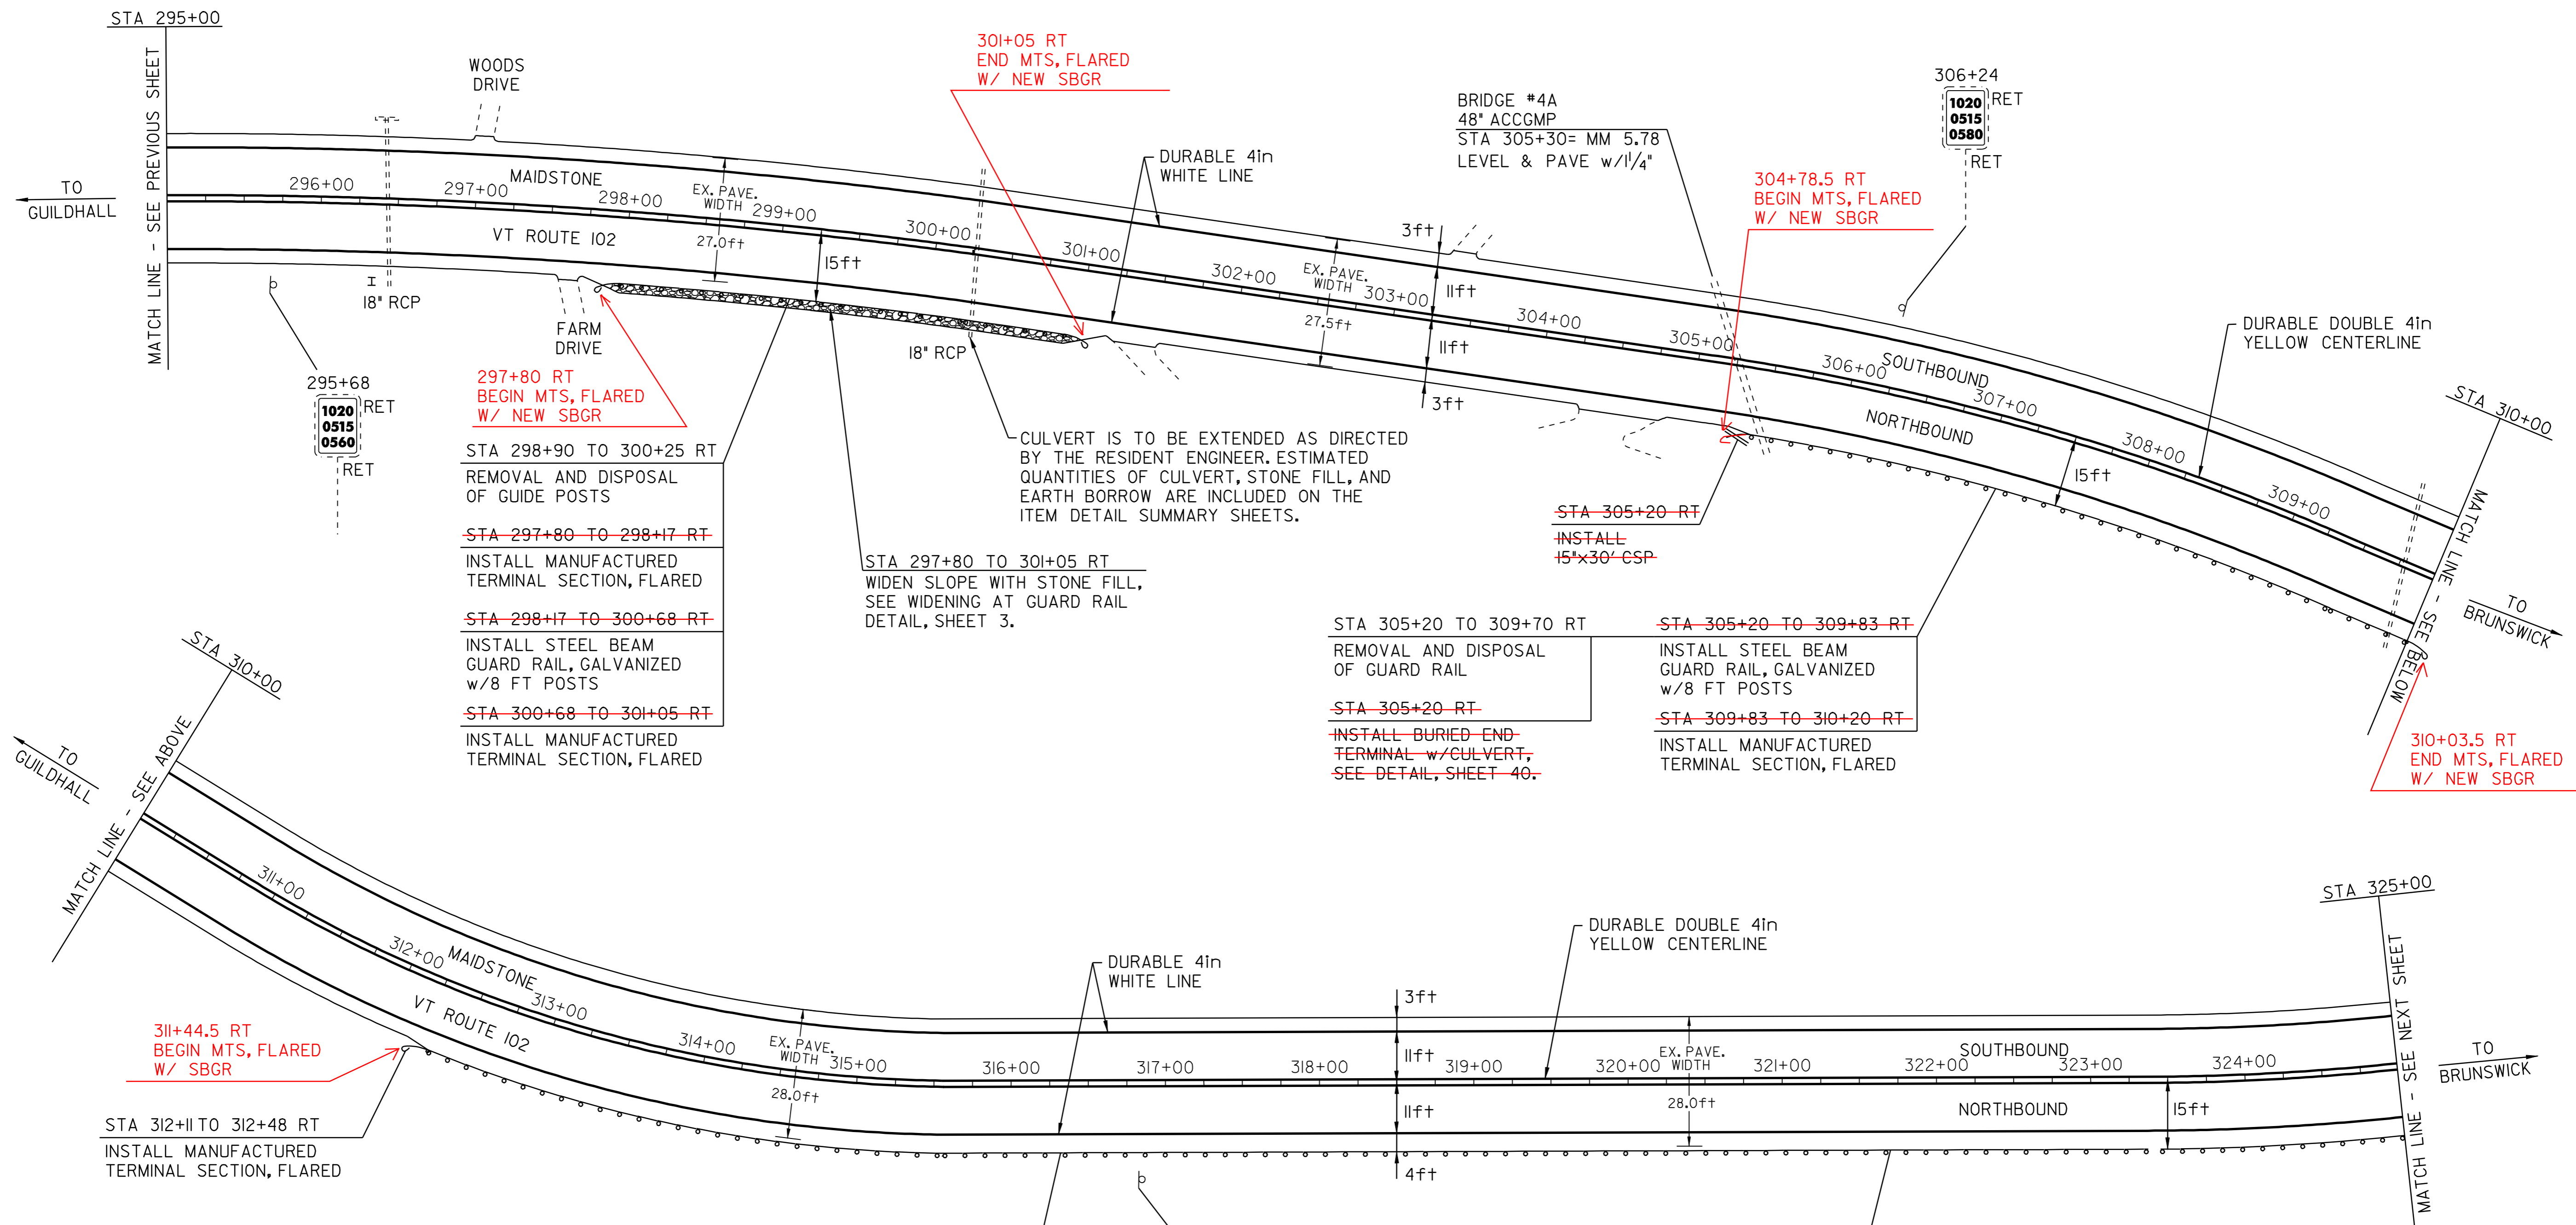

- LEGEND**
- N = NEW
 - R = REMOVE
 - R&S = REMOVE & SALVAGE
 - S = SALVAGE
 - RET = RETAIN
 - B-TO-B = BACK TO BACK
 - ⊕ □ CATCH BASIN/DI
 - (N.W.) = NO WORK REQUIRED (TYP. FOR D.I.'S, & C.B.'S WHERE NOTED)
 - I = YIELDING MARKER POST
 - ⊕ = UTILITY POLE
 - = DRIVE

- REMOVAL AND DISPOSAL OF GUIDE POSTS
- STA 298+90 TO 300+25 RT - 5
- REMOVAL AND DISPOSAL OF GUARD RAIL
- STA 305+20 TO 309+70 RT
- STA 312+61 TO 325+00 RT
- ~~MANUFACTURED TERMINAL SECTION, FLARED~~
- ~~STA 297+80 TO 298+17 RT~~
- ~~STA 300+68 TO 301+05 RT~~
- ~~STA 309+83 TO 310+20 RT~~
- ~~STA 312+11 TO 312+48 RT~~

- ~~STEEL BEAM GUARD RAIL, GALVANIZED w/8 FT POSTS~~
- ~~STA 298+17 TO 300+68 RT~~
- ~~STA 305+20 TO 309+83 RT~~
- ~~STA 312+48 TO 325+00 RT~~
- ~~ANCHOR FOR STEEL BEAM RAIL~~
- ~~STA 305+20 RT - 2~~

PAVING PROJECT LAYOUT SHEET #6

DESIGNED BY	BCE/PJM	DATE	10-06
DRAWN BY	C.E.A., INC.	DATE	10-06
DESIGN FILE NO.	06c042.dgn		
PRF FILE	06c042p06.1	DATE PLOTTED	24-AUG-2009
PROJ. NAME	MAIDSTONE - BLOOMFIELD		
PROJ. NO.	STP 2609(1)S		
SHEET	16	OF	40 SHEETS