


TEMPORARY 4in YELLOW LINE (PAINT)
 DURABLE 4in YELLOW LINE (THERMOPLASTIC)
 STA 325+00 TO 355+00 SOLID LT&RT
 STA 335+70 DOUBLE SOLID RT
 (WITH CENTERLINE BREAKS FOR TOWN HIGHWAYS)


TEMPORARY 4in WHITE LINE (PAINT)
 DURABLE 4in WHITE LINE (THERMOPLASTIC)
 STA 325+00 TO 355+00 SOLID LT&RT

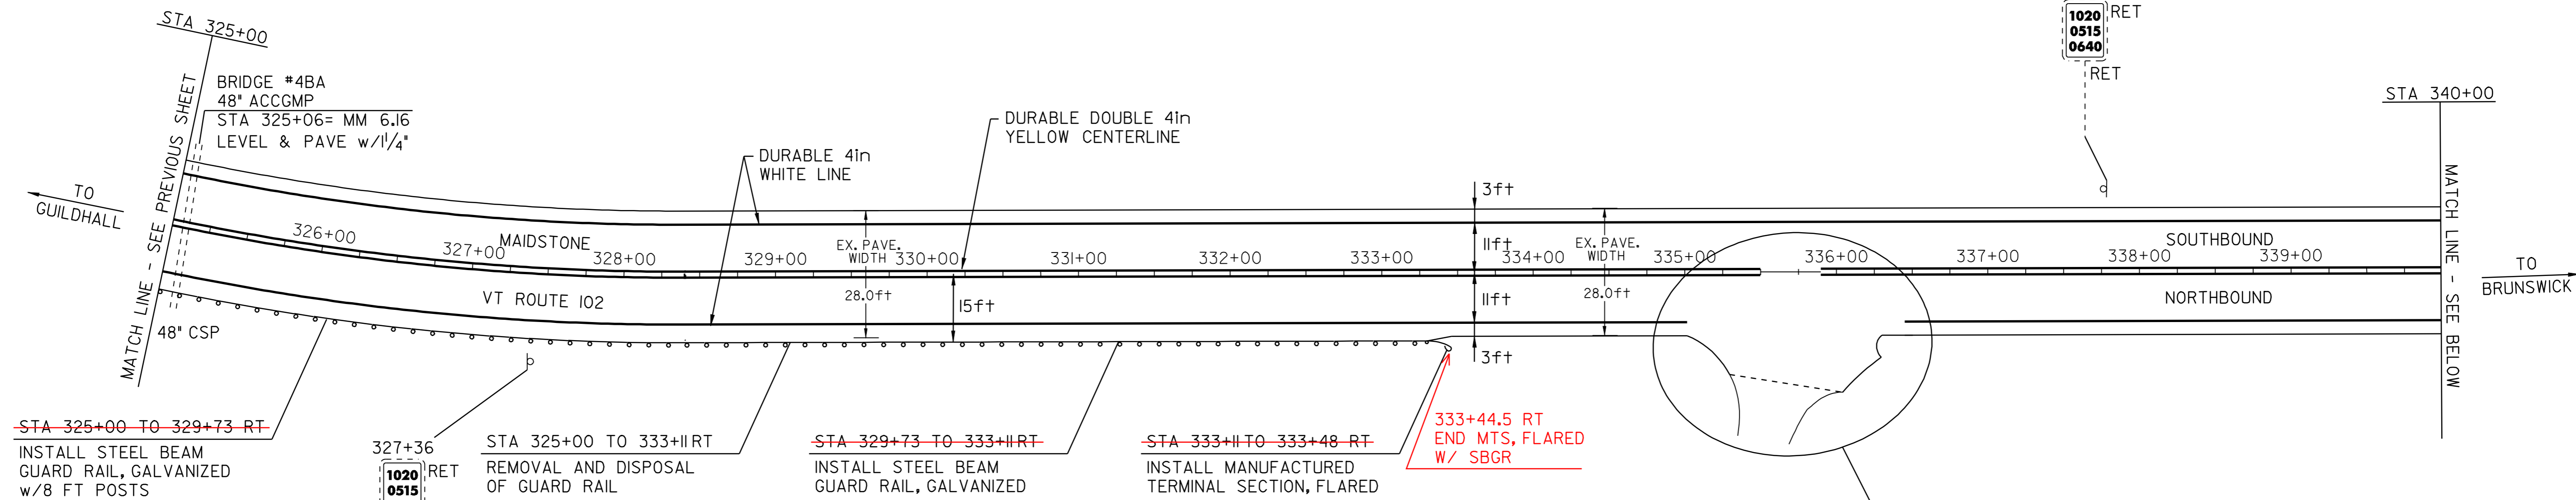

TEMPORARY LETTER OR SYMBOL (PAINT)
 DURABLE LETTER OR SYMBOL (THERMOPLASTIC)
 STA 335+70 RT "STOP"

TEMPORARY 24in STOP BAR (PAINT)
 DURABLE 24in STOP BAR (THERMOPLASTIC)
 STA 335+70 RT MAIDSTONE TOWN HIGHWAY

DITCHING LOCATIONS (REFER TO SHEET 10 FOR DETAILS)
 STA 333+50 TO 344+00 LT
 STA 346+00 TO 355+00 LT

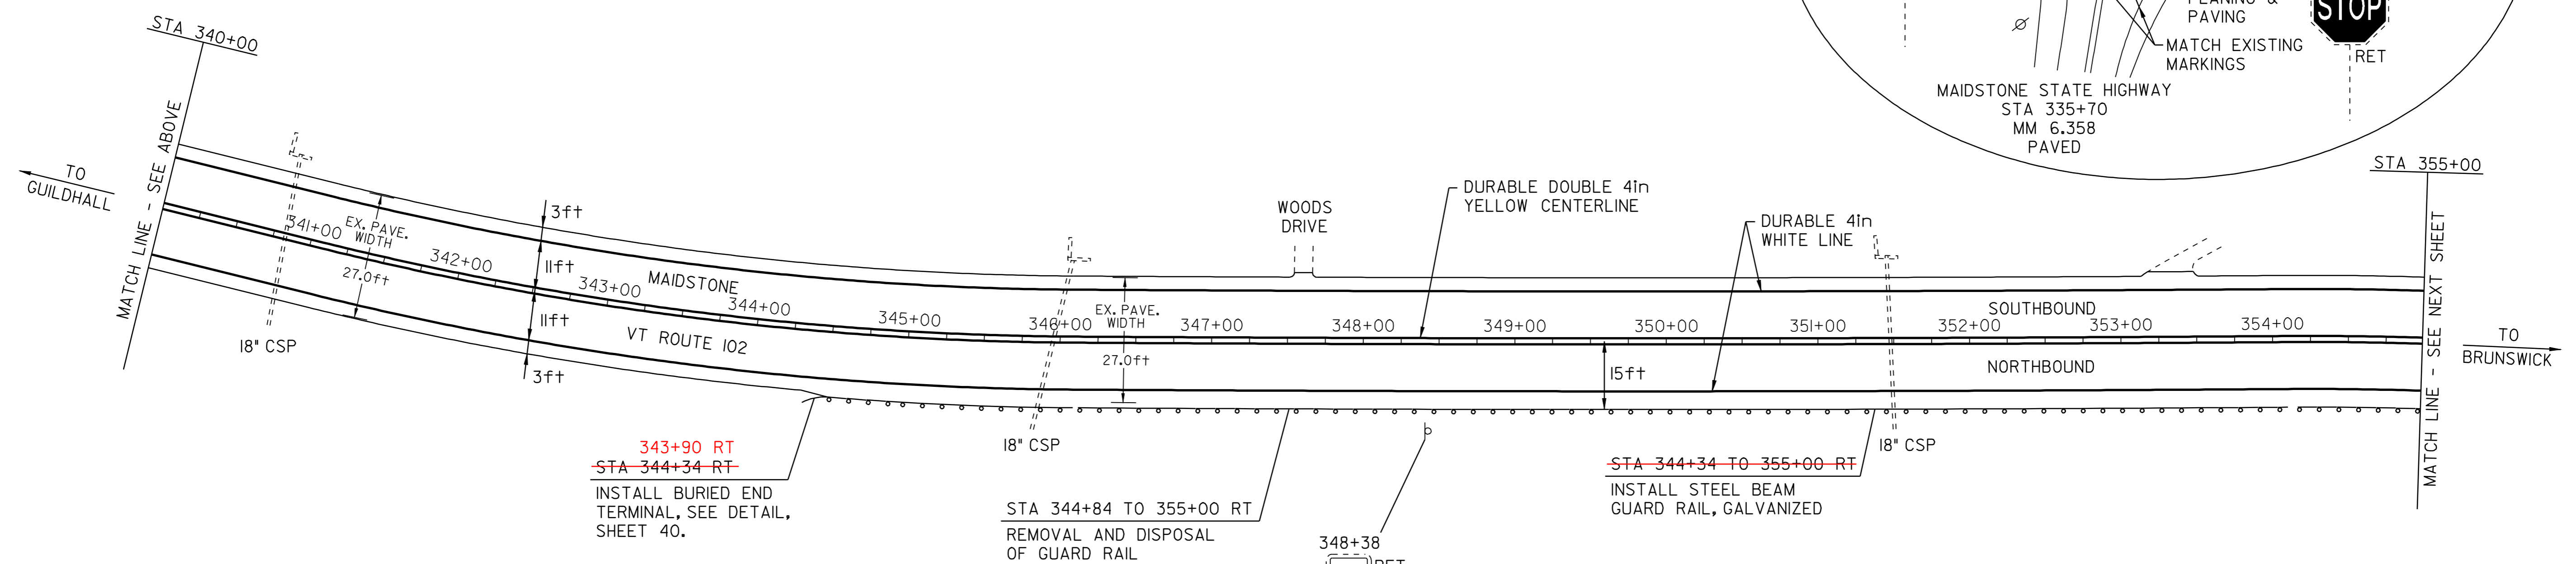

REMOVAL AND DISPOSAL OF GUARD RAIL
 STA 325+00 TO 333+IRT
 STA 344+84 TO 355+00 RT

STEEL BEAM GUARD RAIL, GALVANIZED
 STA 329+73 TO 333+IRT
 STA 344+34 TO 355+00 RT

MANUFACTURED TERMINAL SECTION, FLARED
 STA 333+IRT TO 333+48 RT

STEEL BEAM GUARD RAIL, GALVANIZED w/8 FT POSTS
 STA 325+00 TO 329+73 RT

ANCHOR FOR STEEL BEAM RAIL
 STA 344+34 RT - 2
 343+90 RT

ANCHOR FOR STEEL BEAM RAIL
 STA 344+34 RT - 2
 343+90 RT

LEGEND

N	=	NEW
R	=	REMOVE
R&S	=	REMOVE & SALVAGE
S	=	SALVAGE
RET	=	RETAIN
B-T-O-B	=	BACK TO BACK
⊕	=	CATCH BASIN/DI
(N.W.)	=	NO WORK REQUIRED (TYP. FOR D.I.'S, & C.B.'S WHERE NOTED)
I	=	YIELDING MARKER POST
⊙	=	UTILITY POLE
---	=	DRIVE

PAVING PROJECT LAYOUT SHEET #7

DESIGNED BY	BCE/PJM	DATE	10-06
DRAWN BY	C.E.A., INC.	DATE	10-06
DESIGN FILE NO.	06c042.dgn		
PRF FILE	06c042p07.l	DATE PLOTTED	24-AUG-2009
PROJ. NAME	MAIDSTONE - BLOOMFIELD		
PROJ. NO.	STP 2609(1)S		
SHEET	17	OF	40 SHEETS