



TEMPORARY 4in YELLOW LINE (PAINT)
DURABLE 4in YELLOW LINE (THERMOPLASTIC)
STA 355+00 TO 385+00 SOLID LT&RT

TEMPORARY 4in WHITE LINE (PAINT)
DURABLE 4in WHITE LINE (THERMOPLASTIC)
STA 355+00 TO 385+00 SOLID LT&RT

YIELDING MARKER POST
STA 365+87 RT
STA 366+21LT
STA 375+08 RT

DITCHING LOCATIONS (REFER TO SHEET 10 FOR DETAILS)
STA 355+00 TO 361+00 LT
STA 362+50 TO 368+25 LT
STA 369+00 TO 378+00 LT

LEGEND
N = NEW
R = REMOVE
R&S = REMOVE & SALVAGE
S = SALVAGE
RET = RETAIN
B-TO-B = BACK TO BACK
CATCH BASIN/DI
(N.W.) = NO WORK REQUIRED (TYP. FOR D.I.'S, & C.B.'S WHERE NOTED)
YIELDING MARKER POST
UTILITY POLE
DRIVE

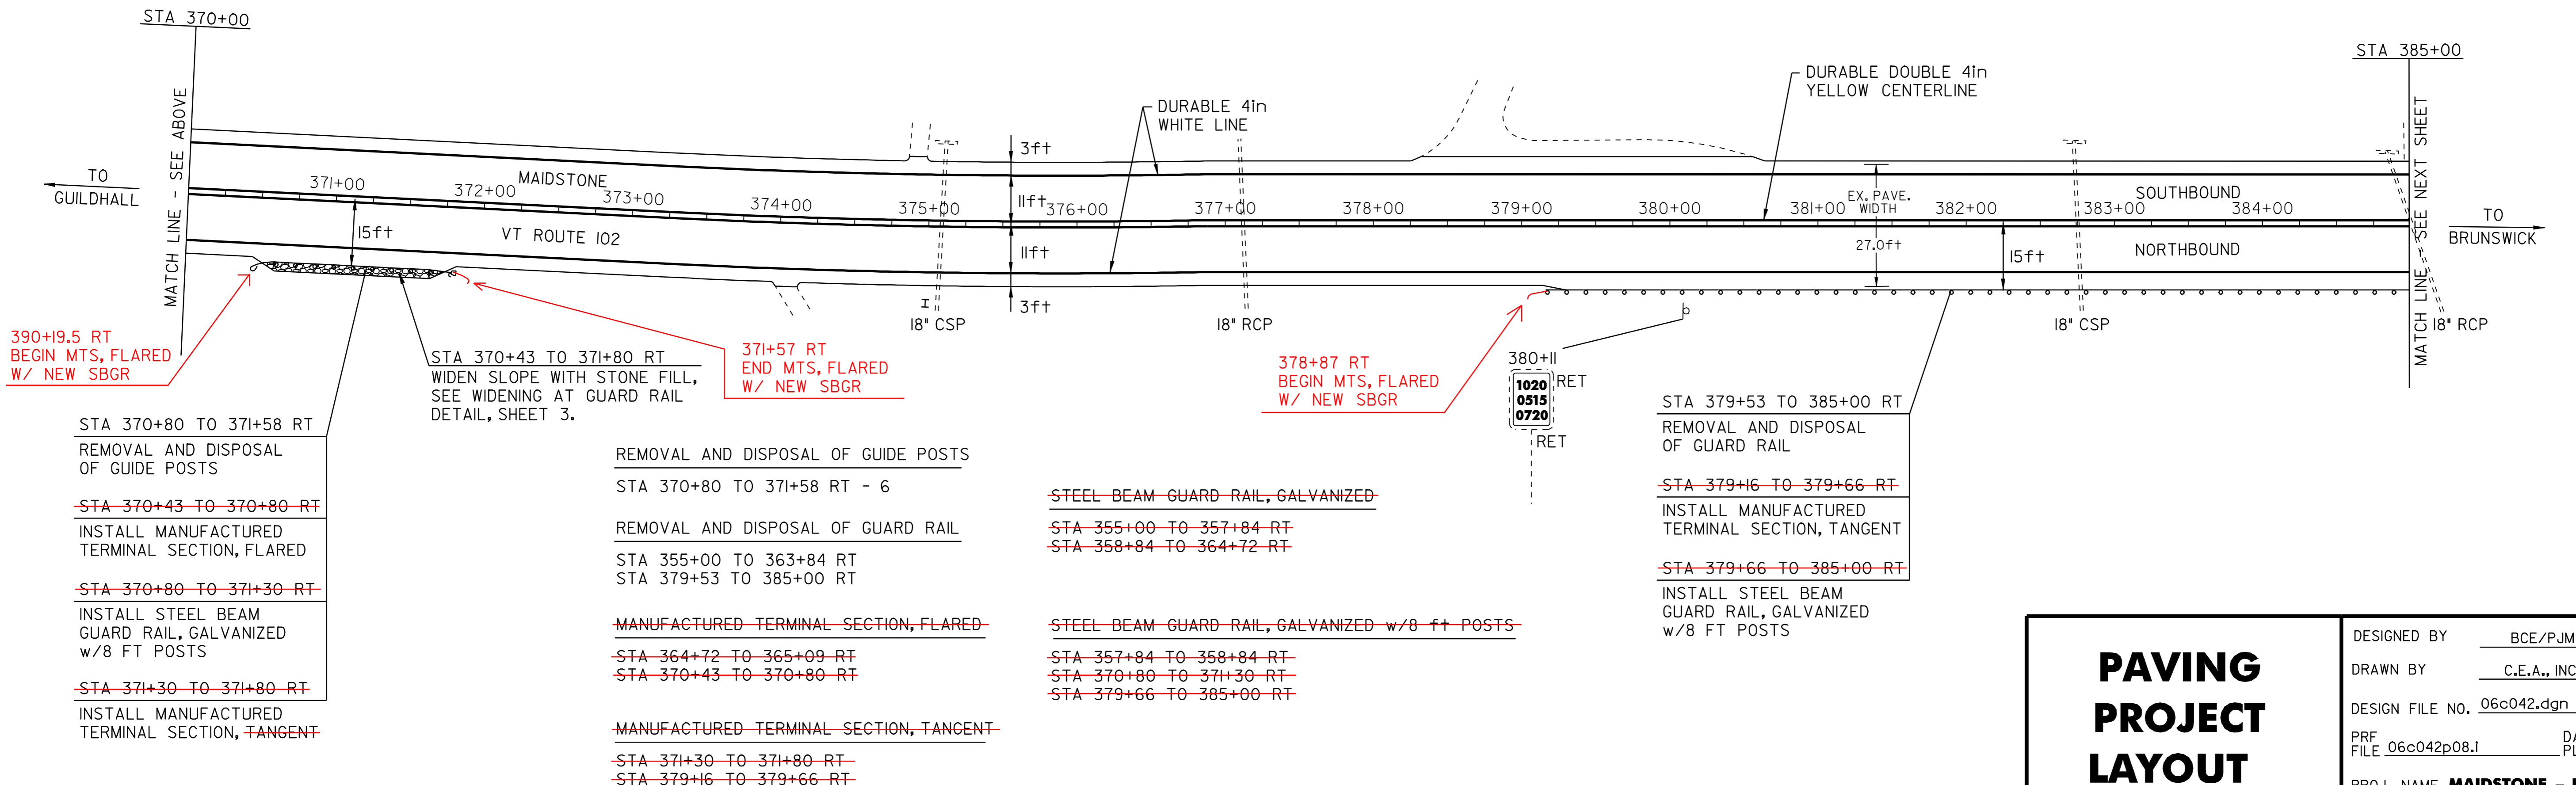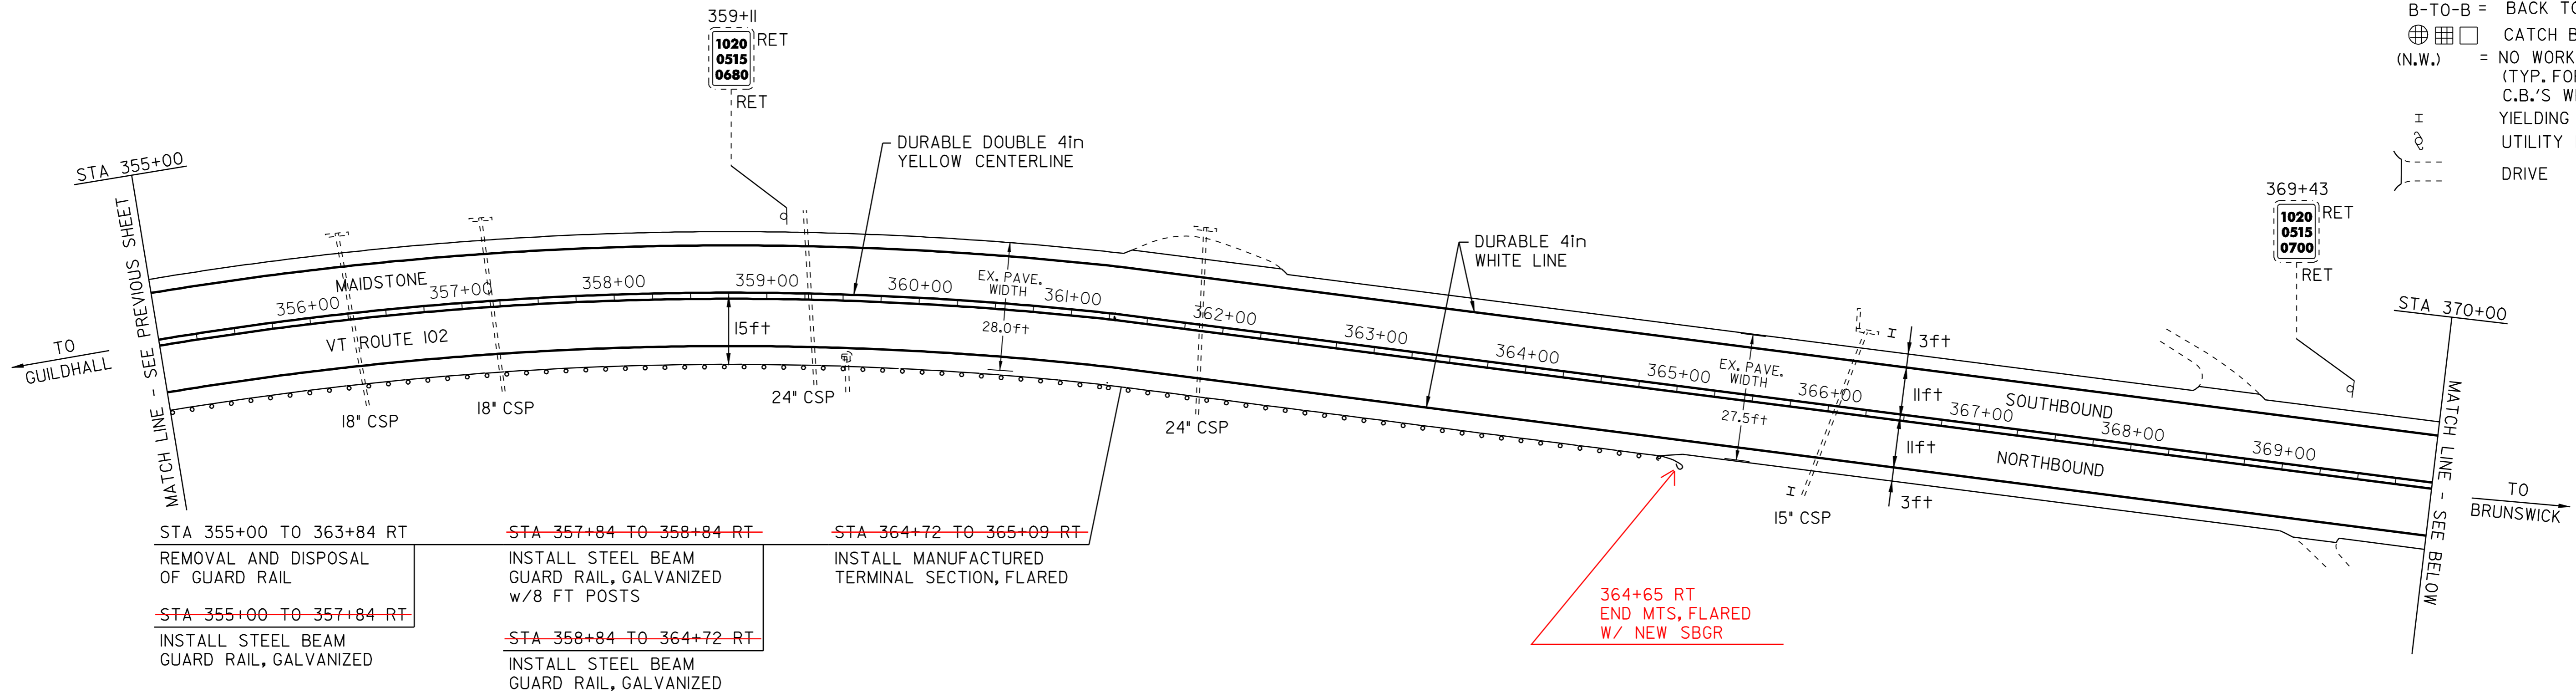

PAVING PROJECT LAYOUT SHEET #8

DESIGNED BY	BCE/PJM	DATE	10-06
DRAWN BY	C.E.A., INC.	DATE	10-06
DESIGN FILE NO.	06c042.dgn		
PRF FILE	06c042p08.i	DATE PLOTTED	24-AUG-2009
PROJ. NAME	MAIDSTONE - BLOOMFIELD		
PROJ. NO.	STP 2609(1)S		
SHEET	18	OF	40 SHEETS