

TEMPORARY 4in YELLOW LINE (PAINT)
DURABLE 4in YELLOW LINE (THERMOPLASTIC)

STA 60+00 TO 68+11 SOLID LT&RT
STA 68+11 TO 74+71 SOLID LT & DASHED RT
STA 74+71 TO 75+77 SOLID LT&RT
STA 75+77 TO 82+10 DASHED LT & SOLID RT
STA 82+10 TO 90+00 SOLID LT&RT

TEMPORARY 4in WHITE LINE (PAINT)
DURABLE 4in WHITE LINE (THERMOPLASTIC)

STA 60+00 TO 90+00 SOLID LT&RT

DITCHING LOCATIONS (REFER TO SHEET 10 FOR DETAILS)

STA 60+00 TO 64+00 LT
STA 70+75 TO 72+80 LT


STA 66+01 TO 69+38 LT
REMOVAL AND DISPOSAL OF GUARD RAIL

~~STA 66+01 TO 66+38 LT~~
INSTALL MANUFACTURED TERMINAL SECTION, FLARED

STA 66+38 TO 69+01 LT
INSTALL STEEL BEAM GUARD RAIL, GALVANIZED

~~STA 69+01 TO 69+38 LT~~
INSTALL MANUFACTURED TERMINAL SECTION, FLARED

YIELDING MARKER POST
STA 70+75 LT
STA 72+79 LT

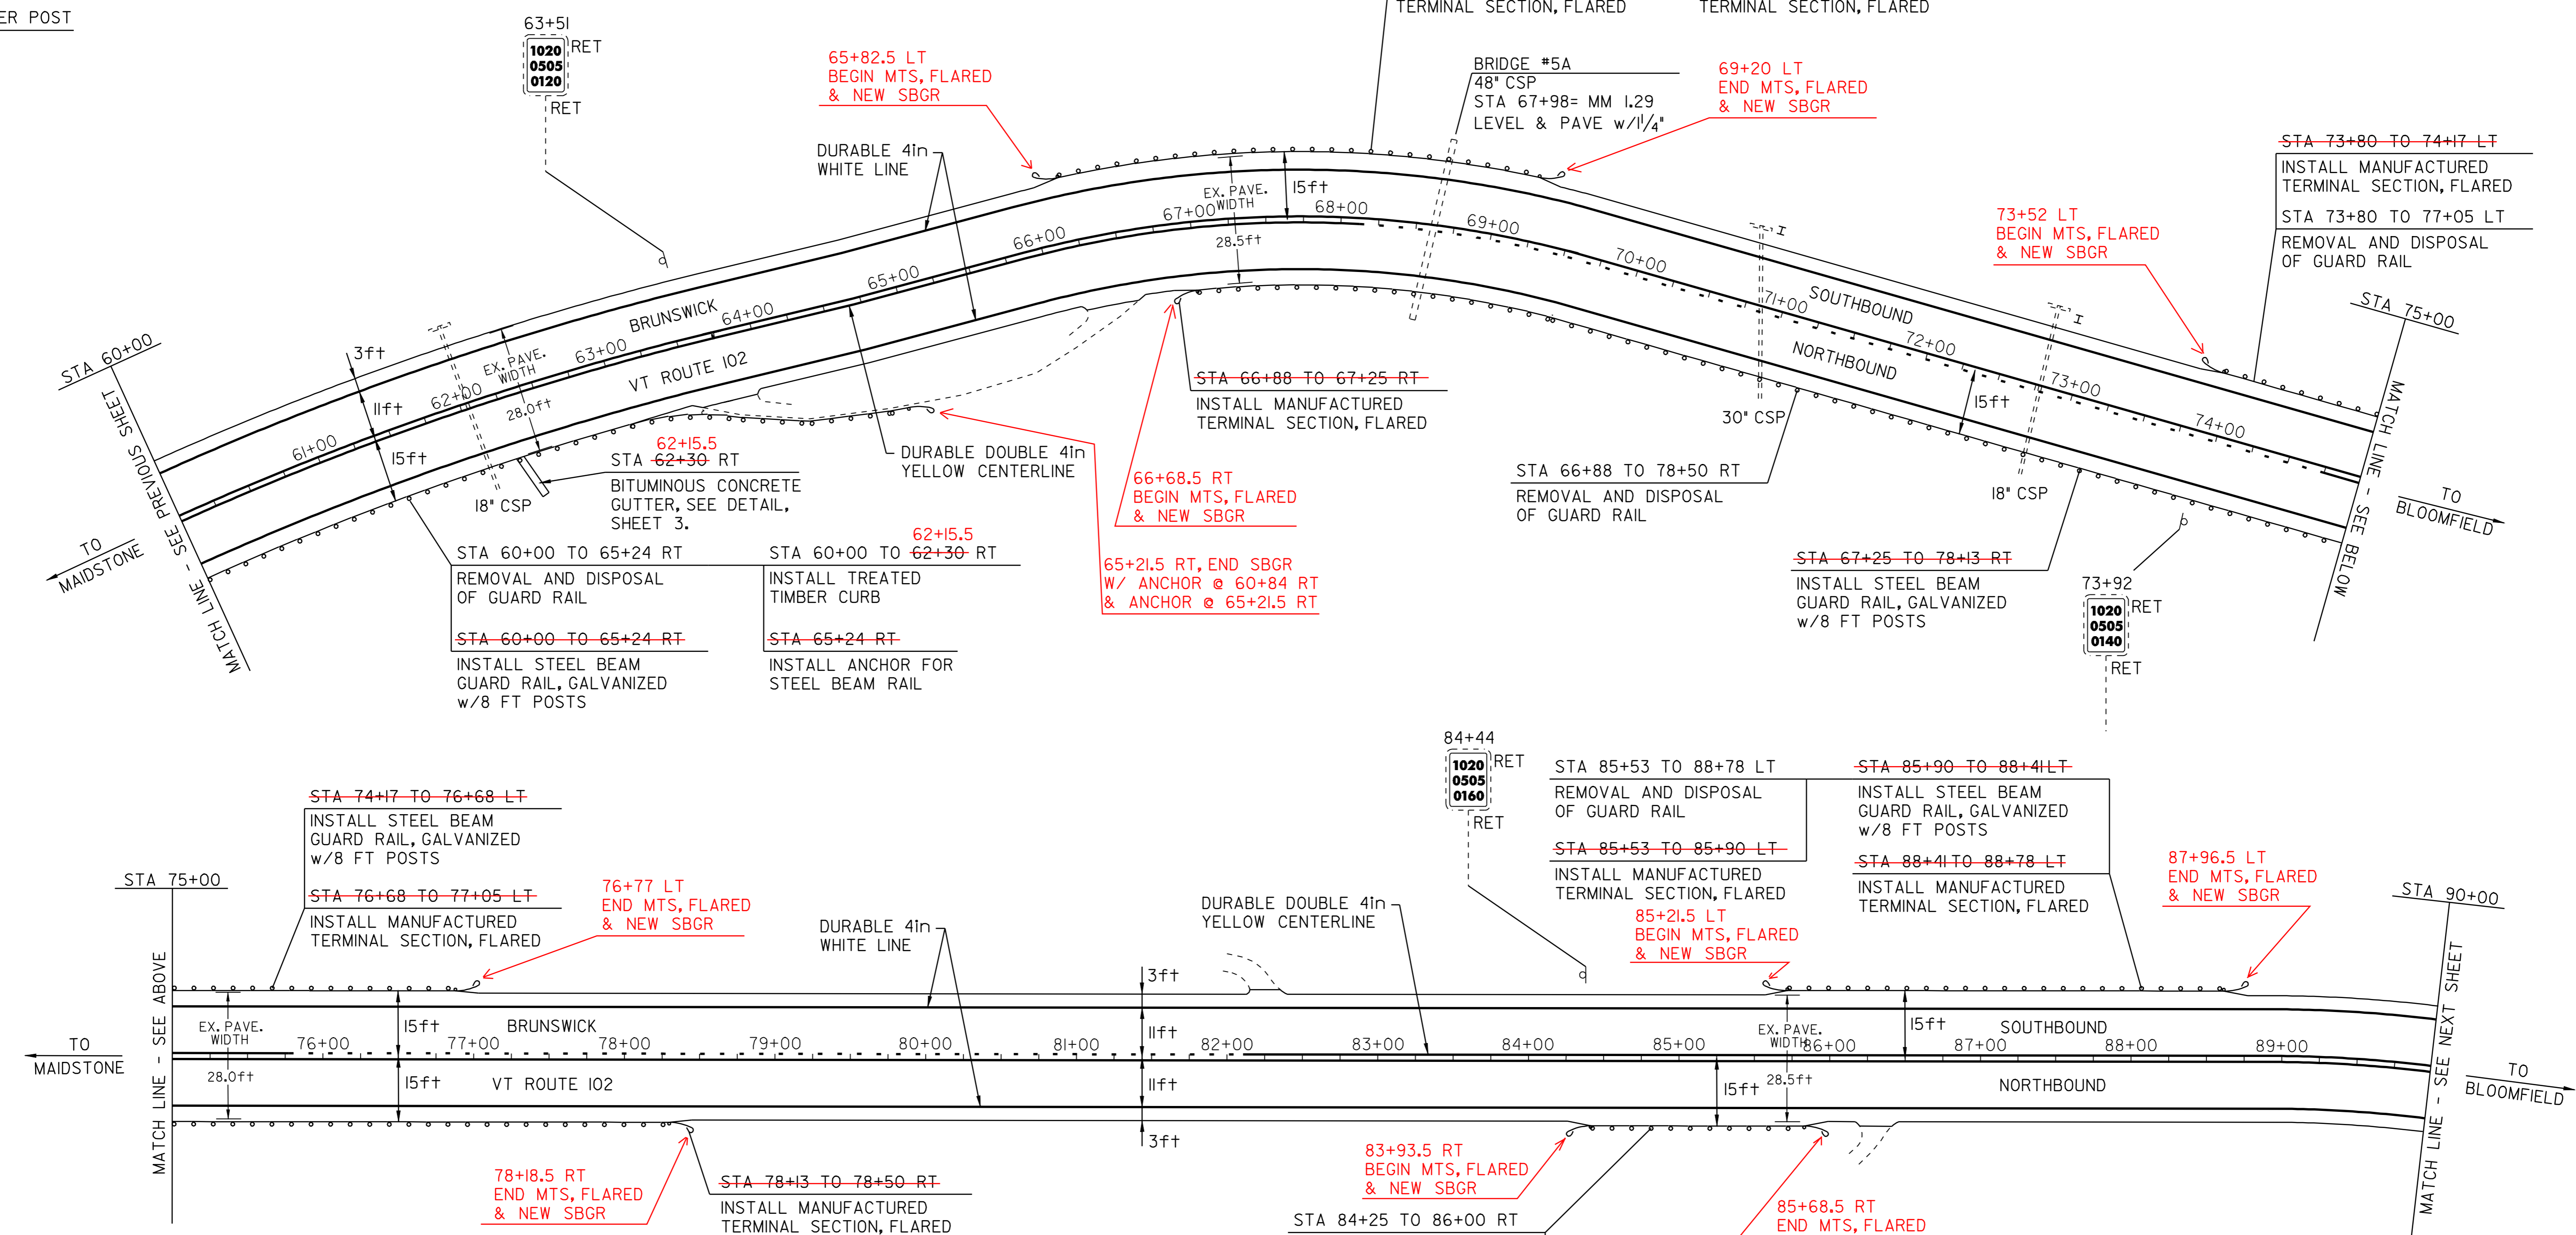

REMOVAL AND DISPOSAL OF GUARD RAIL

STA 60+00 TO 65+24 RT
STA 66+01 TO 69+38 LT
STA 66+88 TO 78+50 RT
STA 73+80 TO 77+05 LT
STA 84+25 TO 86+00 RT
STA 85+53 TO 88+78 LT

STEEL BEAM GUARD RAIL, GALVANIZED w/8 FT POSTS

~~STA 60+00 TO 65+24 RT~~
~~STA 67+25 TO 78+13 RT~~
~~STA 74+71 TO 76+68 LT~~
~~STA 85+90 TO 88+41 LT~~

MANUFACTURED TERMINAL SECTION, FLARED

~~STA 66+01 TO 66+38 LT~~
~~STA 66+88 TO 67+25 RT~~
~~STA 69+01 TO 69+38 LT~~
~~STA 73+80 TO 74+71 LT~~
~~STA 76+68 TO 77+05 LT~~
~~STA 78+13 TO 78+50 RT~~
~~STA 84+25 TO 84+62 RT~~
~~STA 85+53 TO 85+90 LT~~
~~STA 85+63 TO 86+00 RT~~
~~STA 88+41 TO 88+78 LT~~

STEEL BEAM GUARD RAIL, GALVANIZED

~~STA 66+38 TO 69+01 LT~~
~~STA 84+62 TO 85+63 RT~~

ANCHOR FOR STEEL BEAM RAIL

STA 65+24 RT

TREATED TIMBER CURB

STA 60+00 TO 62+30 RT
62+15.5

BITUMINOUS CONCRETE GUTTER (SEE DETAIL, SHEET 3)

STA 62+30 RT (30' LONG)
62+15.5

STA 84+25 TO 86+00 RT
REMOVAL AND DISPOSAL OF GUARD RAIL

~~STA 84+25 TO 84+62 RT~~
INSTALL MANUFACTURED TERMINAL SECTION, FLARED

~~STA 84+62 TO 85+63 RT~~
INSTALL STEEL BEAM GUARD RAIL, GALVANIZED

~~STA 85+63 TO 86+00 RT~~
INSTALL MANUFACTURED TERMINAL SECTION, FLARED

LEGEND

N = NEW
R = REMOVE
R&S = REMOVE & SALVAGE
S = SALVAGE
RET = RETAIN
B-TO-B = BACK TO BACK
⊕ □ = CATCH BASIN/DI (N.W.) = NO WORK REQUIRED (TYP. FOR D.I.'S, & C.B.'S WHERE NOTED)
I = YIELDING MARKER POST
⊕ = UTILITY POLE
--- = DRIVE

PAVING PROJECT LAYOUT SHEET #12

DESIGNED BY	BCE/PJM	DATE	10-06
DRAWN BY	C.E.A., INC.	DATE	10-06
DESIGN FILE NO.	06c042.dgn		
PRF FILE	06c042pl2.i	DATE PLOTTED	24-AUG-2009
PROJ. NAME	MAIDSTONE - BLOOMFIELD		
PROJ. NO.	STP 2609(1)S		
SHEET	22	OF	40 SHEETS