

TEMPORARY 4in YELLOW LINE (PAINT)  
DURABLE 4in YELLOW LINE (THERMOPLASTIC)

STA 90+00 TO 91+34 SOLID LT&RT  
STA 91+34 TO 99+00 SOLID LT & DASHED RT  
STA 99+00 TO 107+18 DASHED LT & SOLID RT  
STA 107+18 TO 120+00 SOLID LT&RT  
STA 116+50 DOUBLE SOLID LT

TEMPORARY 4in WHITE LINE (PAINT)  
DURABLE 4in WHITE LINE (THERMOPLASTIC)

STA 90+00 TO 120+00 SOLID LT&RT

TEMPORARY LETTER OR SYMBOL (PAINT)  
DURABLE LETTER OR SYMBOL (THERMOPLASTIC)


STA 116+50 LT "STOP"  
STA 116+50 LT SFH

REMOVING SIGNS 2  
YIELDING MARKER POST  
STA 96+56 LT  
STA 112+60 LT

DITCHING LOCATIONS (REFER TO SHEET 10 FOR DETAILS)  
STA 103+00 TO 105+00 LT

TEMPORARY 24in STOP BAR (PAINT)  
DURABLE 24in STOP BAR (THERMOPLASTIC)

STA 116+50 LT SFH

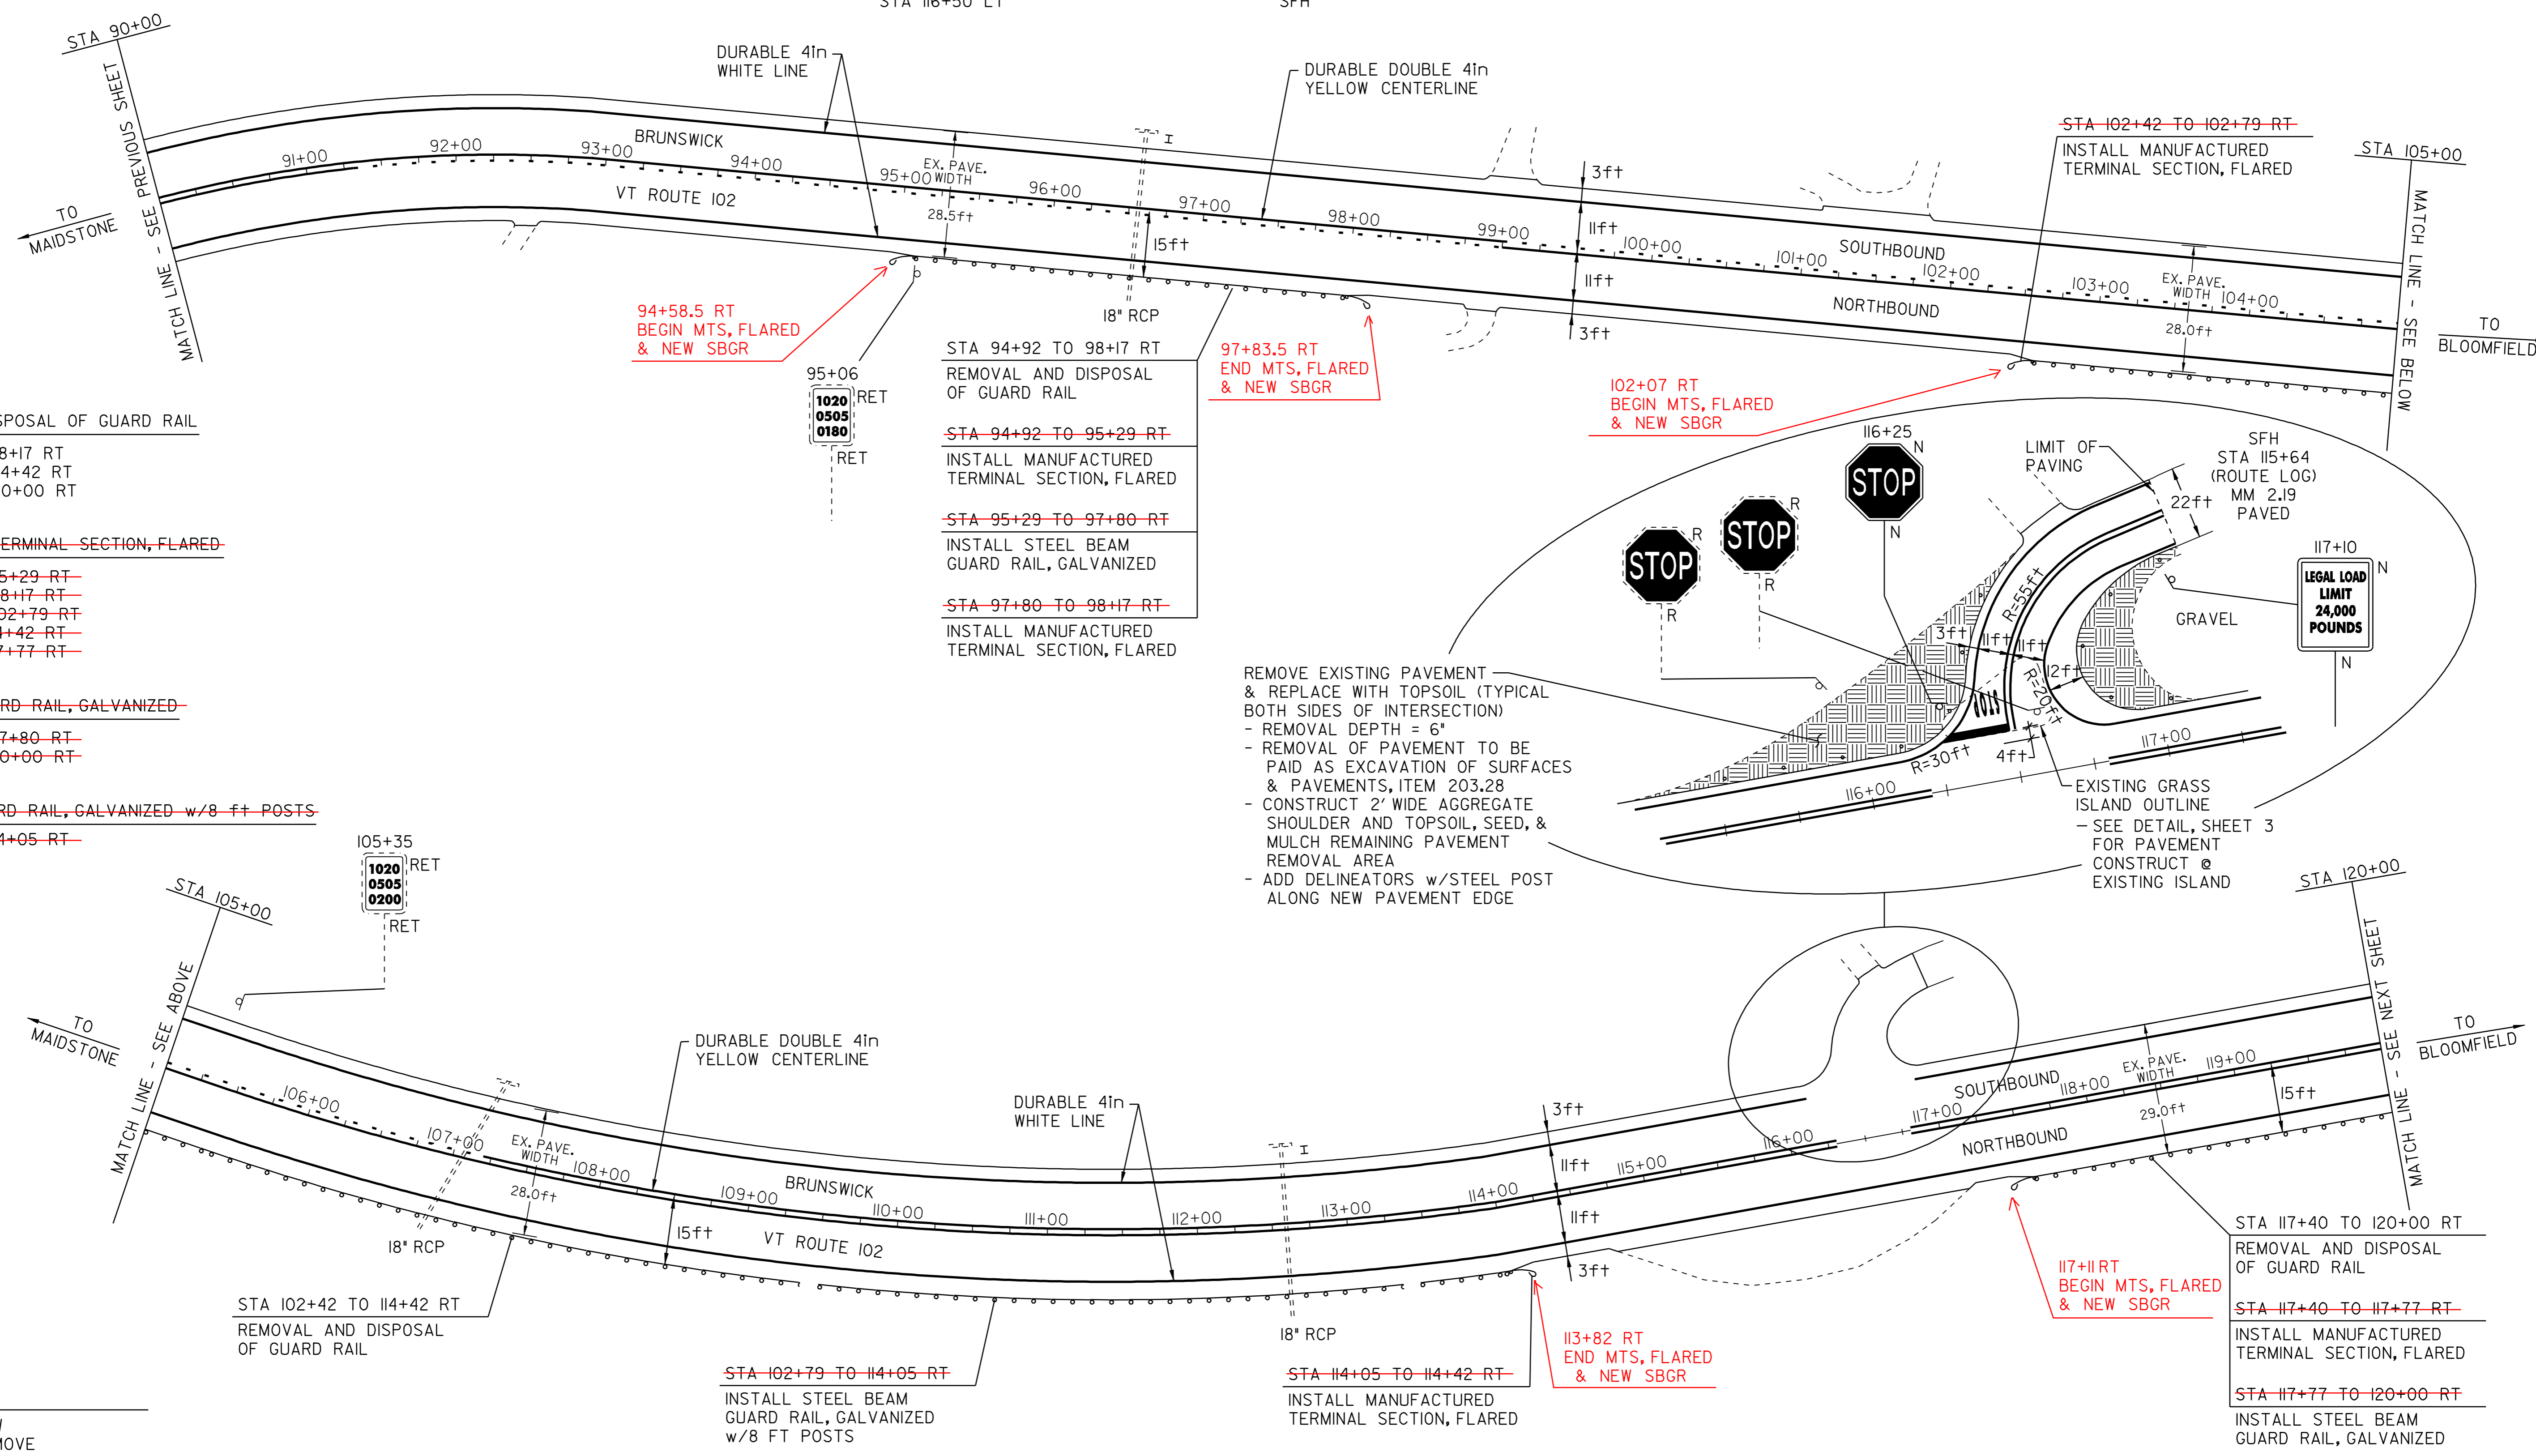

**REMOVAL AND DISPOSAL OF GUARD RAIL**

STA 94+92 TO 98+17 RT  
STA 102+42 TO 114+42 RT  
STA 117+40 TO 120+00 RT

**MANUFACTURED TERMINAL SECTION, FLARED**

~~STA 94+92 TO 95+29 RT~~  
~~STA 97+80 TO 98+17 RT~~  
~~STA 102+42 TO 102+79 RT~~  
~~STA 114+05 TO 114+42 RT~~  
~~STA 117+40 TO 117+77 RT~~

**STEEL BEAM GUARD RAIL, GALVANIZED**

~~STA 95+29 TO 97+80 RT~~  
~~STA 117+77 TO 120+00 RT~~

**STEEL BEAM GUARD RAIL, GALVANIZED w/8 FT POSTS**

~~STA 102+79 TO 114+05 RT~~

18" RCP  
STA 94+92 TO 98+17 RT  
REMOVAL AND DISPOSAL  
OF GUARD RAIL

~~STA 94+92 TO 95+29 RT~~  
INSTALL MANUFACTURED  
TERMINAL SECTION, FLARED

~~STA 95+29 TO 97+80 RT~~  
INSTALL STEEL BEAM  
GUARD RAIL, GALVANIZED

~~STA 97+80 TO 98+17 RT~~  
INSTALL MANUFACTURED  
TERMINAL SECTION, FLARED

REMOVE EXISTING PAVEMENT  
& REPLACE WITH TOPSOIL (TYPICAL  
BOTH SIDES OF INTERSECTION)  
- REMOVAL DEPTH = 6"  
- REMOVAL OF PAVEMENT TO BE  
PAID AS EXCAVATION OF SURFACES  
& PAVEMENTS, ITEM 203.28  
- CONSTRUCT 2' WIDE AGGREGATE  
SHOULDER AND TOPSOIL, SEED, &  
MULCH REMAINING PAVEMENT  
REMOVAL AREA  
- ADD DELINEATORS w/STEEL POST  
ALONG NEW PAVEMENT EDGE

STA 117+40 TO 120+00 RT  
REMOVAL AND DISPOSAL  
OF GUARD RAIL

~~STA 117+40 TO 117+77 RT~~  
INSTALL MANUFACTURED  
TERMINAL SECTION, FLARED

~~STA 117+77 TO 120+00 RT~~  
INSTALL STEEL BEAM  
GUARD RAIL, GALVANIZED

**LEGEND**

N	=	NEW
R	=	REMOVE
R&S	=	REMOVE & SALVAGE
S	=	SALVAGE
RET	=	RETAIN
B-TO-B	=	BACK TO BACK
⊕	=	CATCH BASIN/DI
(N.W.)	=	NO WORK REQUIRED (TYP. FOR D.I.'S, & C.B.'S WHERE NOTED)
I	=	YIELDING MARKER POST
⊙	=	UTILITY POLE
---	=	DRIVE

## PAVING PROJECT LAYOUT SHEET #13

DESIGNED BY	BCE/PJM	DATE	10-06
DRAWN BY	C.E.A., INC.	DATE	10-06
DESIGN FILE NO.	06c042.dgn		
PRF FILE	06c042pl3.l	DATE PLOTTED	24-AUG-2009
PROJ. NAME	MAIDSTONE - BLOOMFIELD		
PROJ. NO.	STP 2609(1)S		
SHEET	23	OF	40 SHEETS