

TEMPORARY 4in YELLOW LINE (PAINT)
 DURABLE 4in YELLOW LINE (THERMOPLASTIC)

STA 150+00 TO 162+62 SOLID LT&RT
 STA 162+62 TO 170+02 SOLID LT & DASHED RT
 STA 170+02 TO 170+54 DASHED
 STA 170+54 TO 177+94 DASHED LT & SOLID RT
 STA 177+94 TO 180+00 SOLID LT&RT



TEMPORARY 4in WHITE LINE (PAINT)
 DURABLE 4in WHITE LINE (THERMOPLASTIC)

STA 150+00 TO 180+00 SOLID LT&RT

DITCHING LOCATIONS (REFER TO SHEET 10 FOR DETAILS)

STA 150+00 TO 152+00 LT
 STA 157+25 TO 158+75 LT

RELOCATE MAILBOX, SINGLE SUPPORT
 STA 156+95 RT

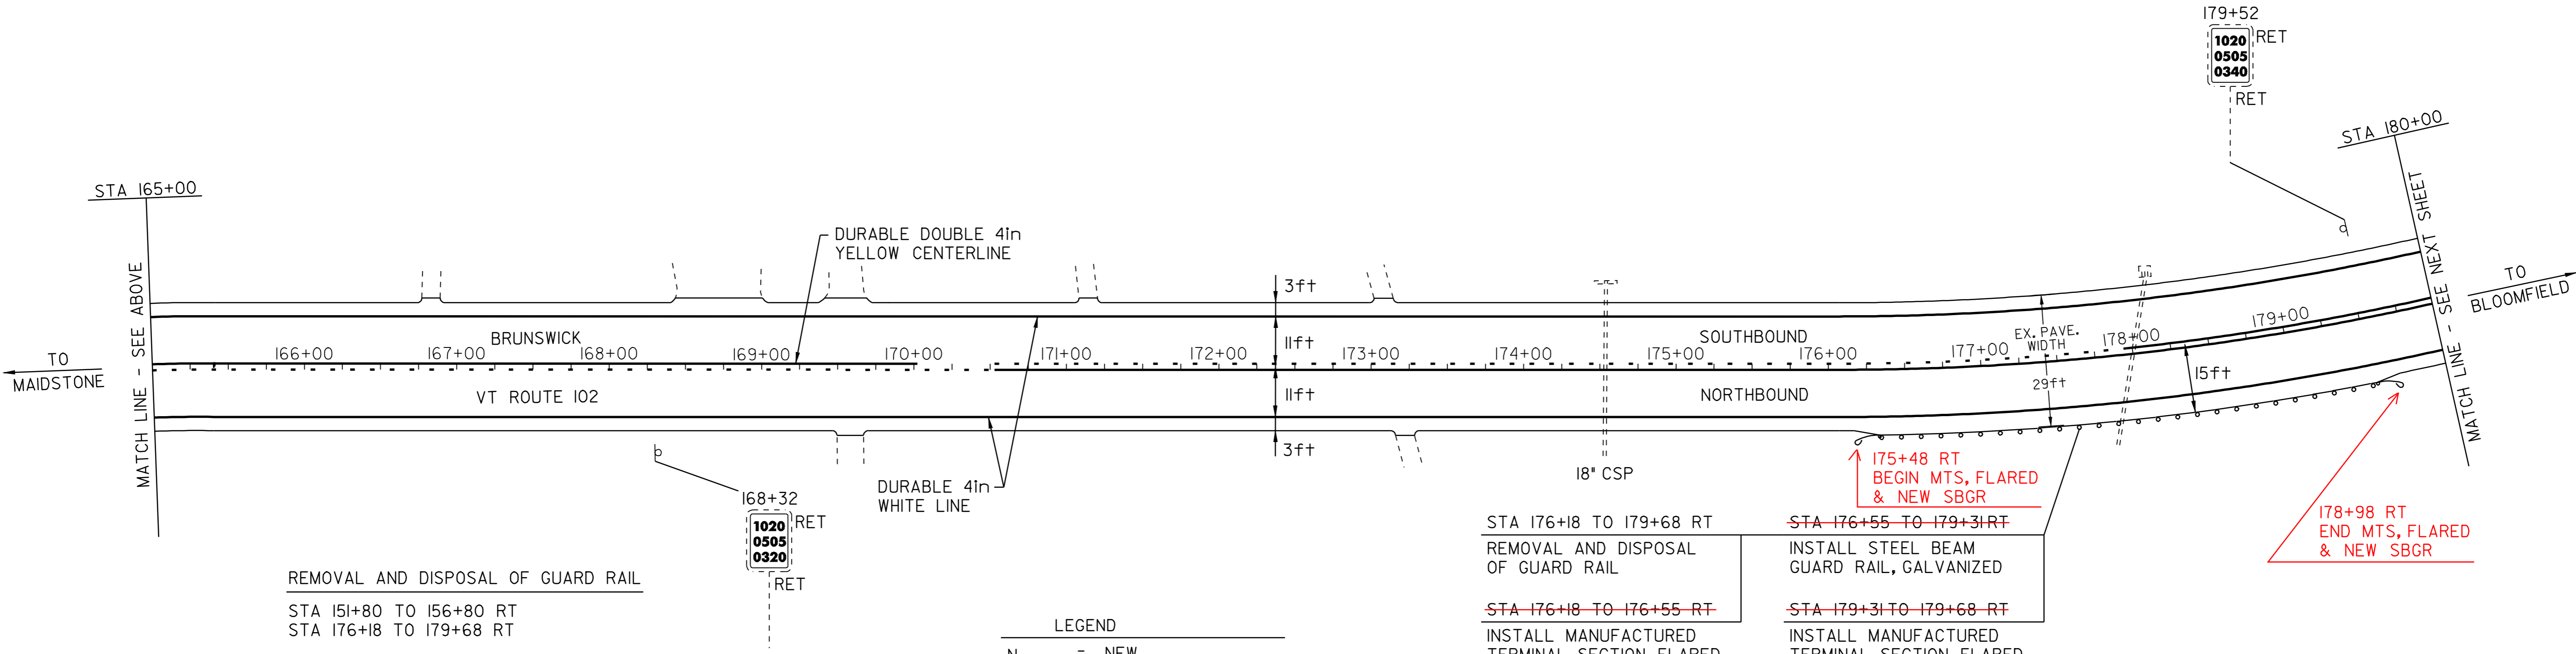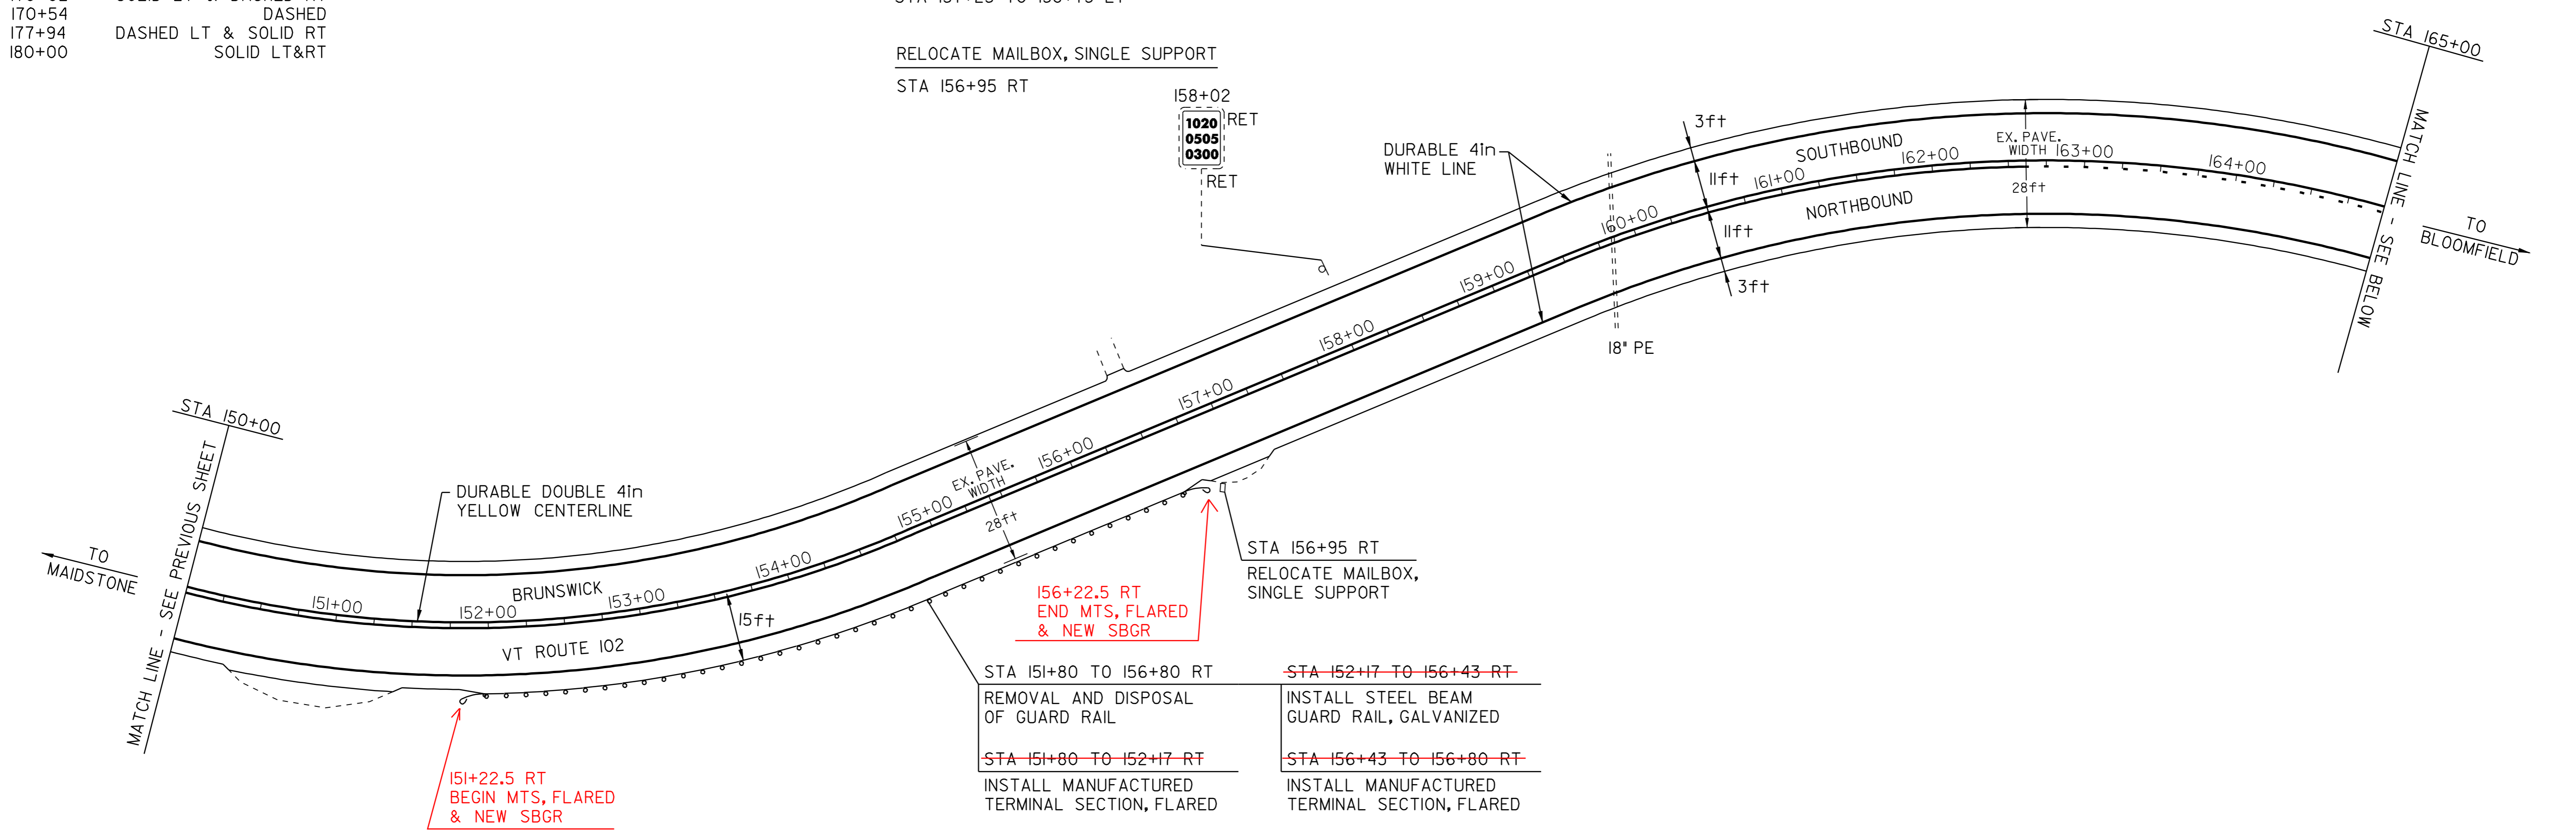

REMOVAL AND DISPOSAL OF GUARD RAIL
 STA 151+80 TO 156+80 RT
 STA 176+18 TO 179+68 RT

~~MANUFACTURED TERMINAL SECTION, FLARED~~
~~STA 151+80 TO 152+17 RT~~
~~STA 156+43 TO 156+80 RT~~
~~STA 176+18 TO 176+55 RT~~
~~STA 179+31 TO 179+68 RT~~

STEEL BEAM GUARD RAIL, GALVANIZED
 STA 152+17 TO 156+43 RT
 STA 176+55 TO 179+31 RT

LEGEND

N	=	NEW
R	=	REMOVE
R&S	=	REMOVE & SALVAGE
S	=	SALVAGE
RET	=	RETAIN
B-TO-B	=	BACK TO BACK
⊕ □	=	CATCH BASIN/DI
(N.W.)	=	NO WORK REQUIRED (TYP. FOR D.I.'S, & C.B.'S WHERE NOTED)
I	=	YIELDING MARKER POST
⊗	=	UTILITY POLE
---	=	DRIVE

STA 176+18 TO 179+68 RT
 REMOVAL AND DISPOSAL OF GUARD RAIL
~~STA 176+18 TO 176+55 RT~~
 INSTALL MANUFACTURED TERMINAL SECTION, FLARED

STA 176+55 TO 179+31 RT
 INSTALL STEEL BEAM GUARD RAIL, GALVANIZED
~~STA 179+31 TO 179+68 RT~~
 INSTALL MANUFACTURED TERMINAL SECTION, FLARED

PAVING PROJECT LAYOUT SHEET #15

DESIGNED BY	BCE/PJM	DATE	10-06
DRAWN BY	C.E.A., INC.	DATE	10-06
DESIGN FILE NO.	06c042.dgn		
PRF FILE	06c042pl5.l	DATE PLOTTED	24-AUG-2009
PROJ. NAME	MAIDSTONE - BLOOMFIELD		
PROJ. NO.	STP 2609(1)S		
SHEET	25	OF	40 SHEETS