


TEMPORARY 4in YELLOW LINE (PAINT)
DURABLE 4in YELLOW LINE (THERMOPLASTIC)
STA 180+00 TO 210+00
SOLID LT&RT

TEMPORARY 4in WHITE LINE (PAINT)
DURABLE 4in WHITE LINE (THERMOPLASTIC)
STA 180+00 TO 210+00
SOLID LT&RT

YIELDING MARKER POST
STA 188+23 RT
STA 192+02 RT

DITCHING LOCATIONS (REFER TO SHEET 10 FOR DETAILS)
STA 191+00 TO 199+00 LT
STA 203+50 TO 205+20 LT

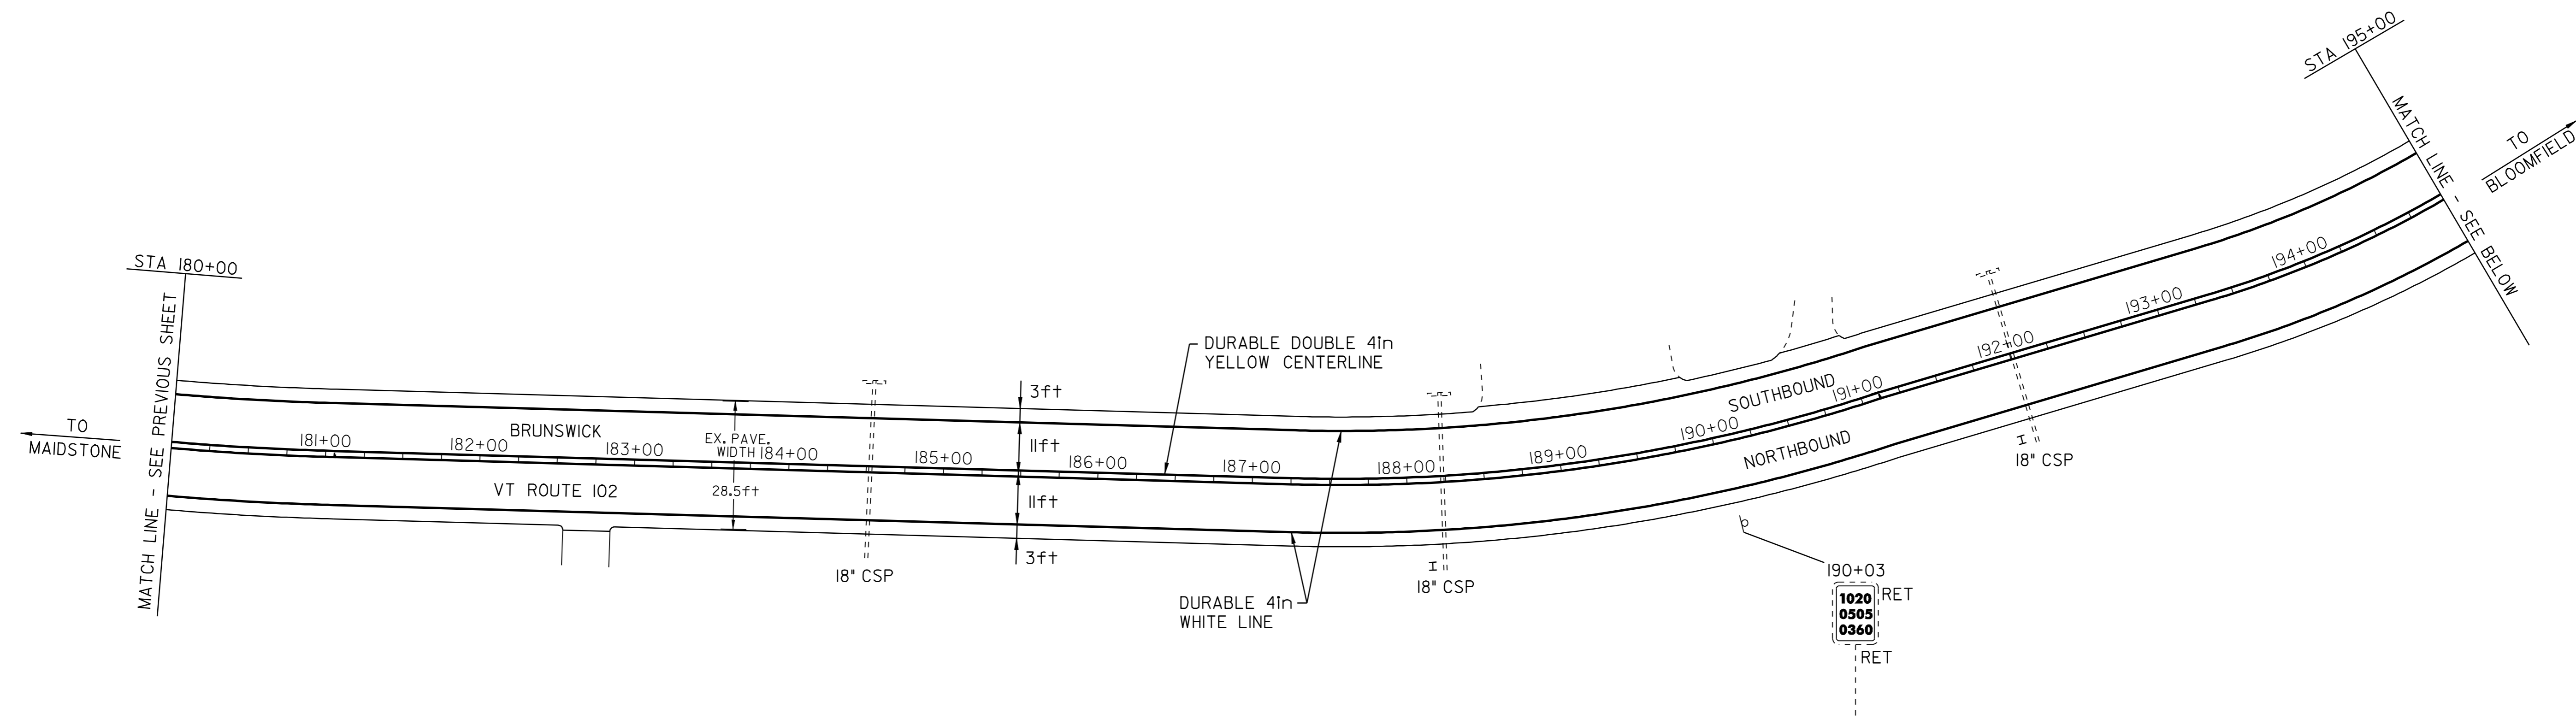

REMOVAL AND DISPOSAL OF GUARD RAIL

STA 195+40 TO 201+40 RT
STA 200+75 TO 203+50 LT

STEEL-BEAM GUARD RAIL, GALVANIZED

~~STA 195+77 TO 199+40 RT~~
~~STA 201+12 TO 203+13 LT~~

MANUFACTURED TERMINAL SECTION, FLARED

~~STA 195+40 TO 195+77 RT~~
~~STA 201+03 TO 201+40 RT~~
~~STA 200+75 TO 201+12 LT~~
~~STA 203+13 TO 203+50 LT~~

STEEL-BEAM GUARD RAIL, GALVANIZED w/8 FT POSTS

~~STA 199+40 TO 201+03 RT~~

STA 200+75 TO 203+50 LT

REMOVAL AND DISPOSAL OF GUARD RAIL

~~STA 200+75 TO 201+12 LT~~

INSTALL MANUFACTURED TERMINAL SECTION, FLARED

STA 201+12 TO 203+13 LT

INSTALL STEEL BEAM GUARD RAIL, GALVANIZED


~~STA 203+13 TO 203+50 LT~~

INSTALL MANUFACTURED TERMINAL SECTION, FLARED

199+97.5 LT
BEGIN MTS, FLARED & NEW SBGR

202+72.5 LT
END MTS, FLARED & NEW SBGR

200+63 RT
END MTS, FLARED & NEW SBGR

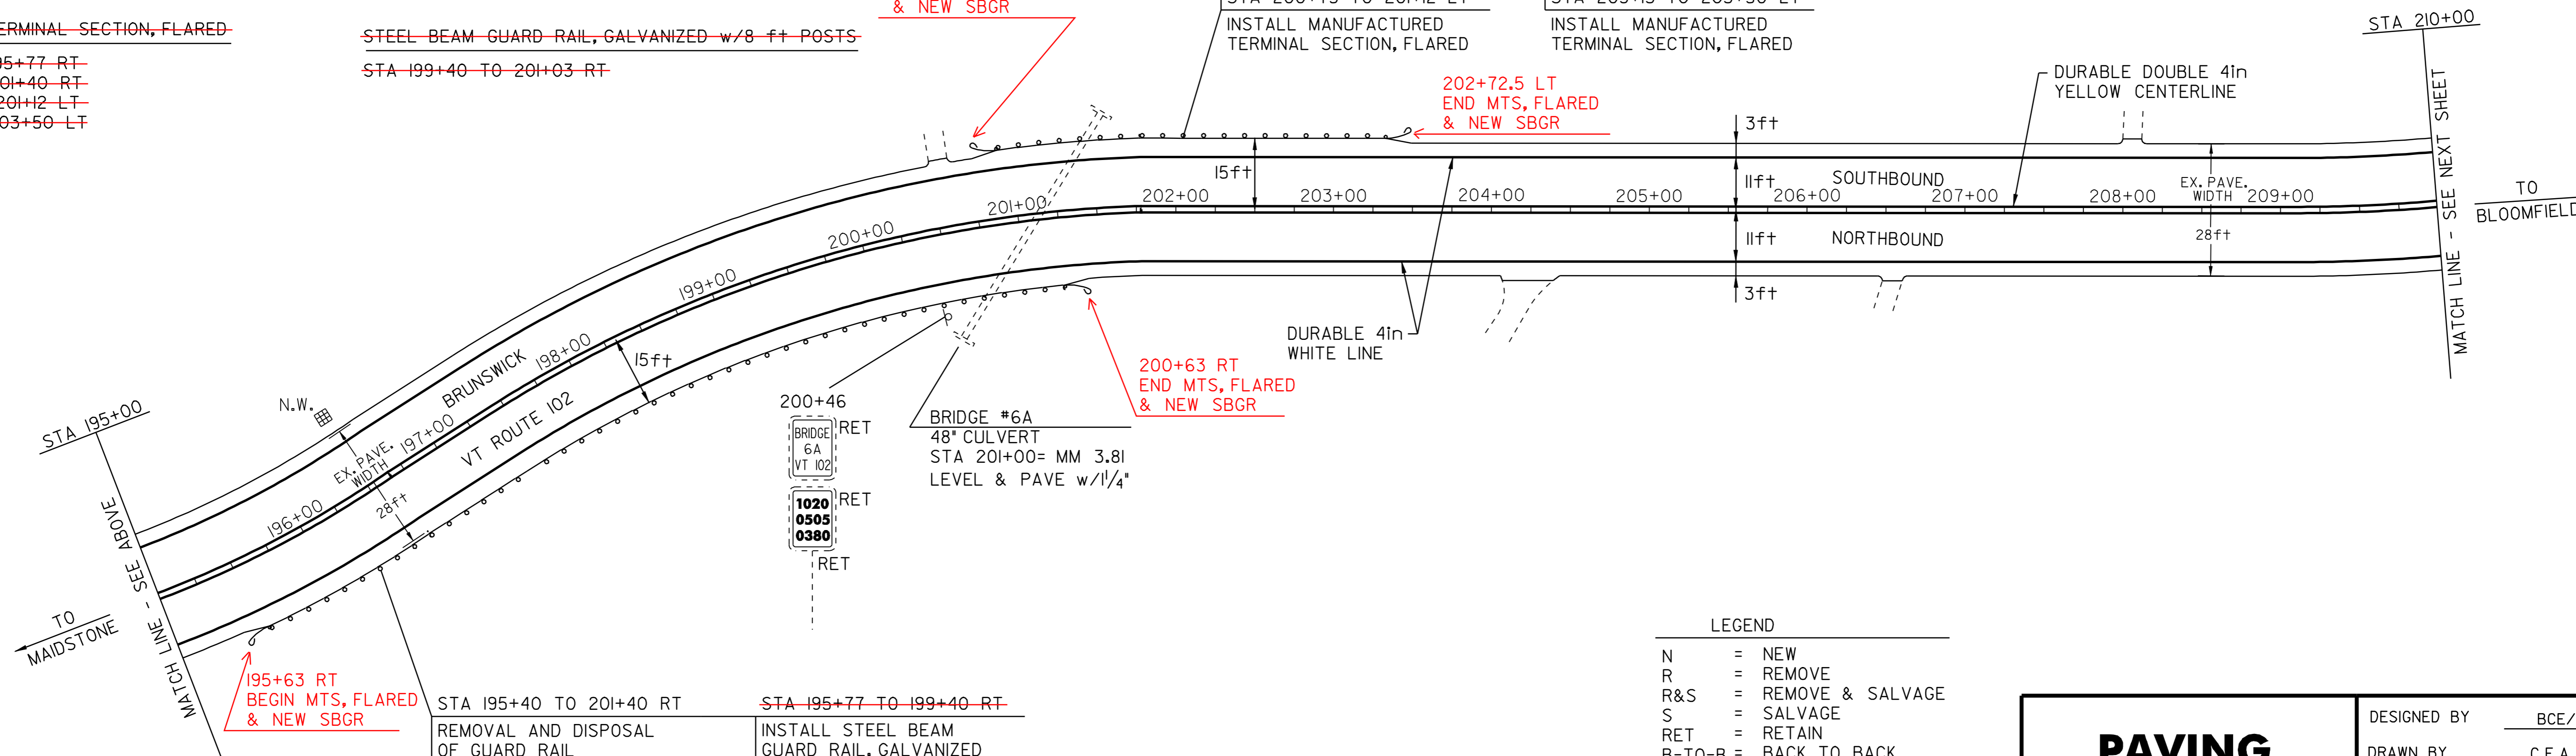

STA 195+40 TO 201+40 RT

REMOVAL AND DISPOSAL OF GUARD RAIL

~~STA 195+40 TO 195+77 RT~~

INSTALL MANUFACTURED TERMINAL SECTION, FLARED

STA 195+77 TO 199+40 RT

INSTALL STEEL BEAM GUARD RAIL, GALVANIZED

~~STA 199+40 TO 201+03 RT~~

INSTALL STEEL BEAM GUARD RAIL, GALVANIZED w/8 FT POSTS

STA 201+03 TO 201+40 RT

INSTALL MANUFACTURED TERMINAL SECTION, FLARED

LEGEND

- N = NEW
- R = REMOVE
- R&S = REMOVE & SALVAGE
- S = SALVAGE
- RET = RETAIN
- B-T-O-B = BACK TO BACK
- ⊕ ⊞ □ CATCH BASIN/DI
- (N.W.) = NO WORK REQUIRED (TYP. FOR D.I.'S, & C.B.'S WHERE NOTED)
- I YIELDING MARKER POST
- ⊕ UTILITY POLE
- DRIVE

PAVING PROJECT LAYOUT SHEET #16

| | | | |
|-----------------|------------------------|--------------|-------------|
| DESIGNED BY | BCE/PJM | DATE | 10-06 |
| DRAWN BY | C.E.A., INC. | DATE | 10-06 |
| DESIGN FILE NO. | 06c042.dgn | | |
| PRF FILE | 06c042pl6.l | DATE PLOTTED | 24-AUG-2009 |
| PROJ. NAME | MAIDSTONE - BLOOMFIELD | | |
| PROJ. NO. | STP 2609(1)S | | |
| SHEET | 26 | OF | 40 SHEETS |