

TEMPORARY 4in YELLOW LINE (PAINT)  
 DURABLE 4in YELLOW LINE (THERMOPLASTIC)  
 STA 210+00 TO 240+00 SOLID LT&RT

TEMPORARY 4in WHITE LINE (PAINT)  
 DURABLE 4in WHITE LINE (THERMOPLASTIC)  
 STA 210+00 TO 240+00 SOLID LT&RT

DITCHING LOCATIONS (REFER TO SHEET 10 FOR DETAILS)  
 STA 210+00 TO 212+25 LT  
 STA 217+50 TO 220+00 LT  
 STA 225+75 TO 231+50 LT  
 STA 232+75 TO 234+40 RT  
 STA 237+00 TO 240+00 LT


~~MANUFACTURED TERMINAL SECTION, FLARED~~  
~~STA 226+25 TO 226+62 RT~~  
~~STA 230+13 TO 230+50 RT~~  
~~STA 234+51 TO 234+88 LT~~  
~~STA 234+75 TO 235+12 RT~~  
~~STA 237+13 TO 237+50 RT~~  
~~STA 238+90 TO 239+27 RT~~

~~STEEL BEAM GUARD RAIL, GALVANIZED~~  
~~STA 226+62 TO 230+13 RT~~  
~~STA 239+27 TO 240+00 RT~~

~~STEEL BEAM GUARD RAIL, GALVANIZED w/8 FT POSTS~~  
~~STA 234+88 TO 236+51LT~~  
~~STA 235+12 TO 237+13 RT~~

~~REMOVAL AND DISPOSAL OF GUARD RAIL~~  
~~STA 226+25 TO 229+50 RT~~  
~~STA 234+51 TO 236+51LT~~  
~~STA 234+75 TO 237+50 RT~~  
~~STA 238+90 TO 240+00 RT~~

~~ANCHOR FOR STEEL BEAM RAIL~~  
~~STA 236+51LT - 2-~~

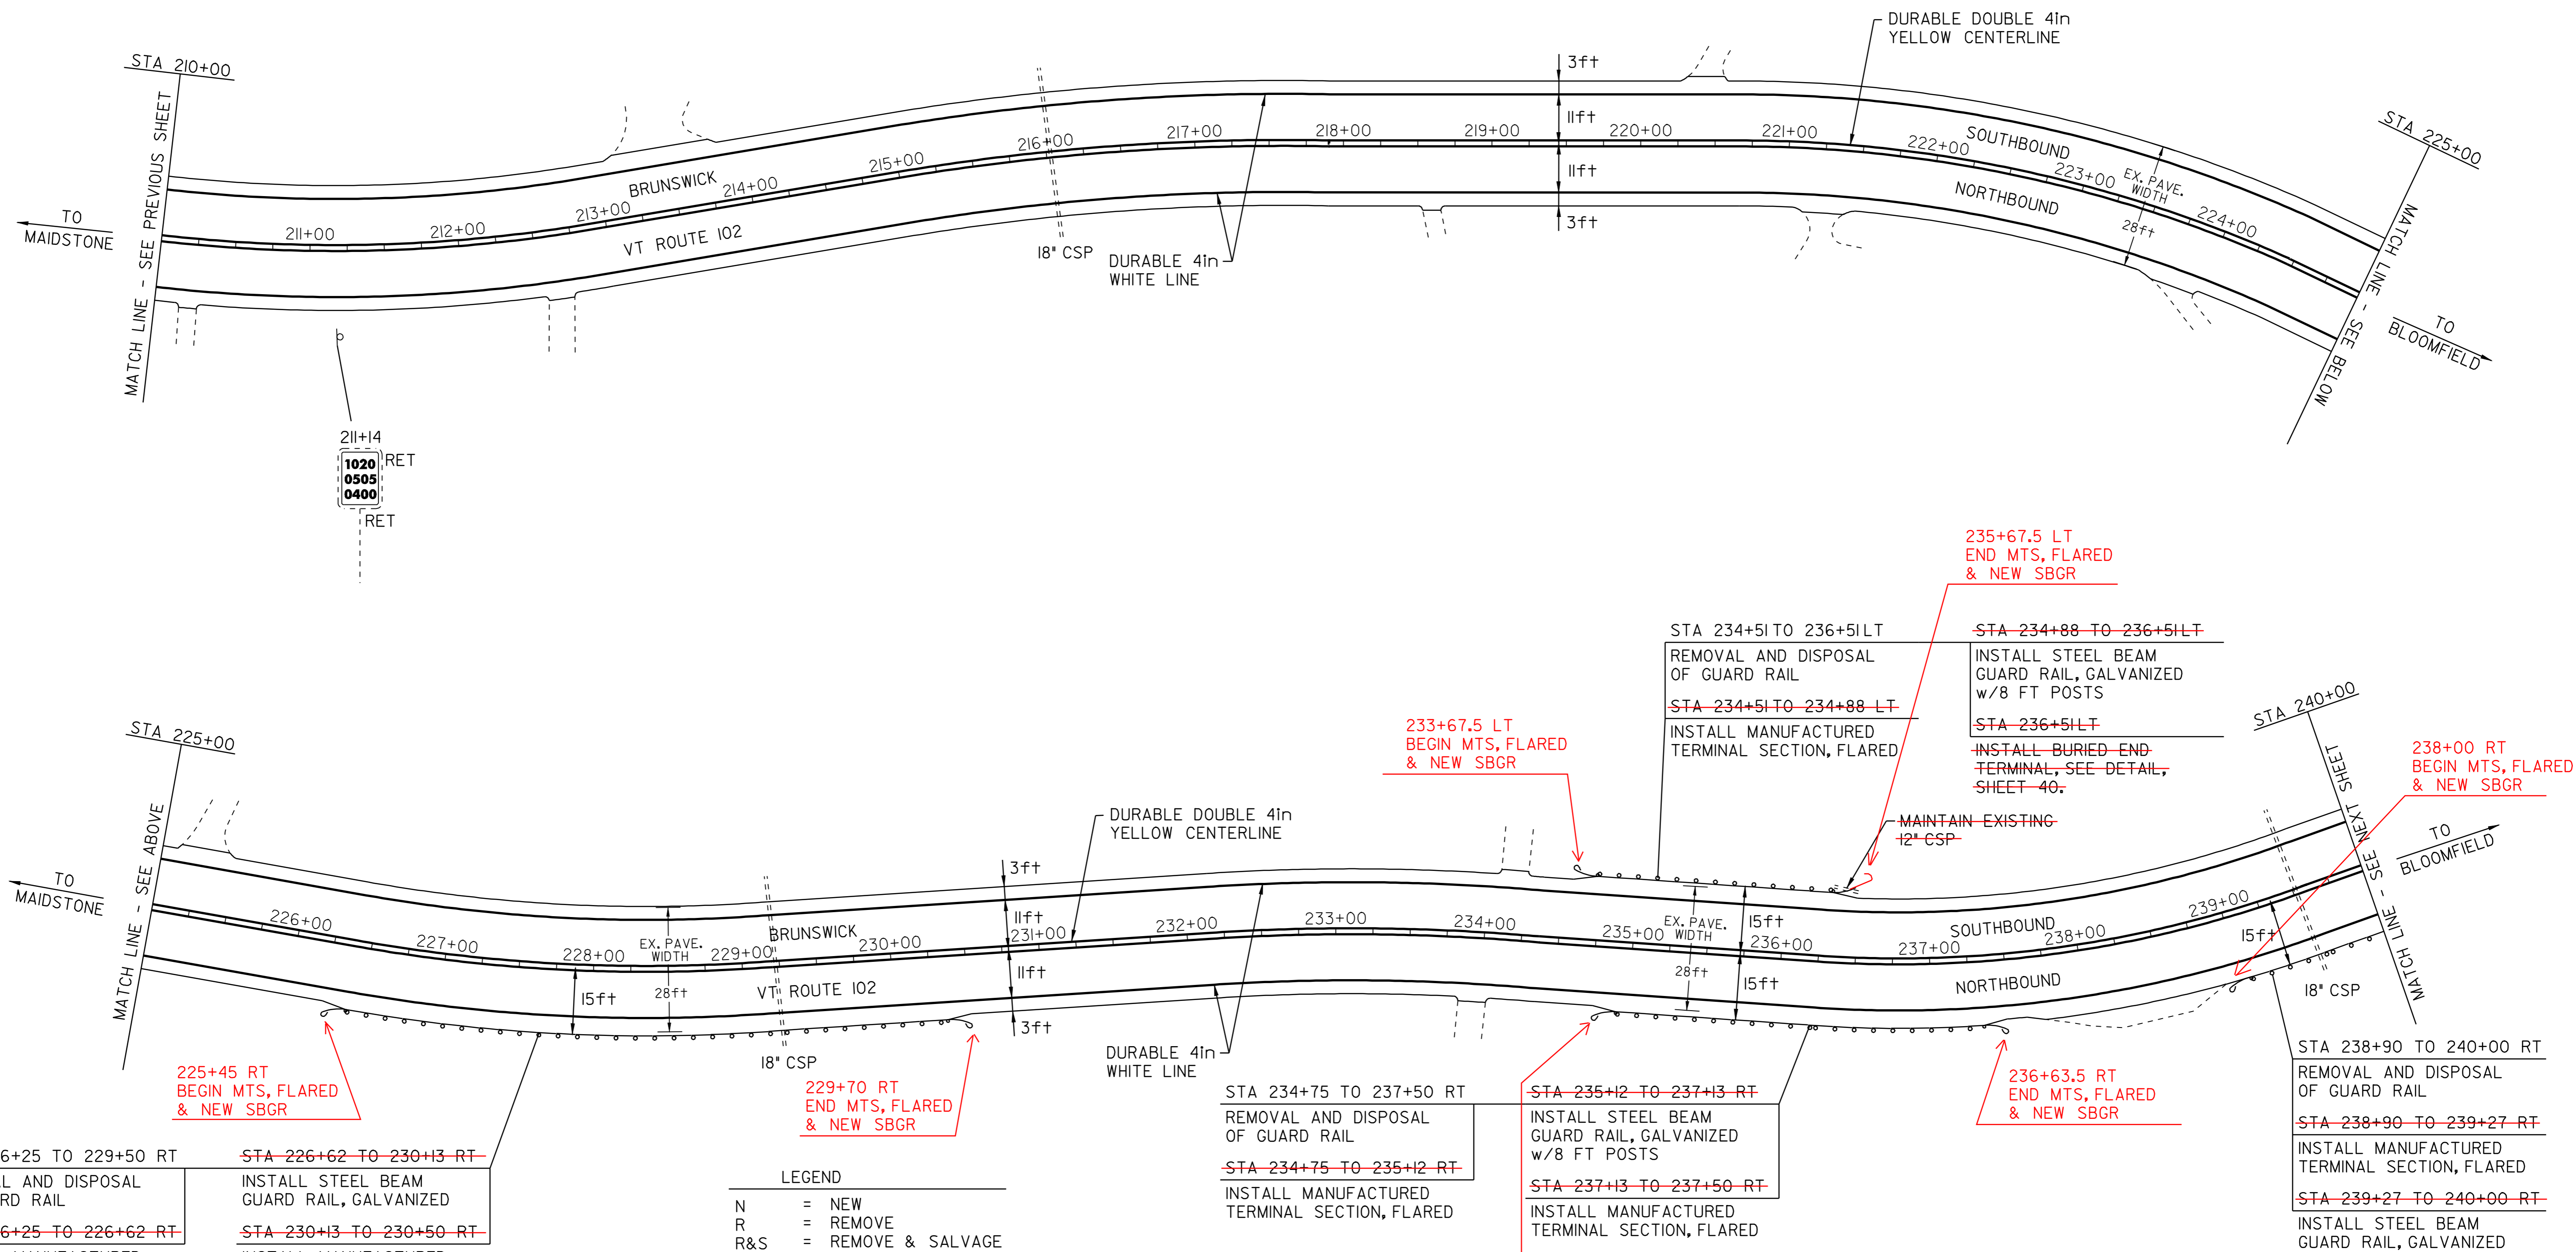

STA 226+25 TO 229+50 RT  
 REMOVAL AND DISPOSAL OF GUARD RAIL  
~~STA 226+25 TO 226+62 RT~~  
 INSTALL MANUFACTURED TERMINAL SECTION, FLARED

~~STA 226+62 TO 230+13 RT~~  
 INSTALL STEEL BEAM GUARD RAIL, GALVANIZED  
~~STA 230+13 TO 230+50 RT~~  
 INSTALL MANUFACTURED TERMINAL SECTION, FLARED

**LEGEND**

N = NEW  
 R = REMOVE  
 R&S = REMOVE & SALVAGE  
 S = SALVAGE  
 RET = RETAIN  
 B-TO-B = BACK TO BACK  
 ⊕ □ = CATCH BASIN/DI (N.W.) = NO WORK REQUIRED (TYP. FOR D.I.'S, & C.B.'S WHERE NOTED)  
 I = YIELDING MARKER POST  
 Ⓢ = UTILITY POLE  
 --- = DRIVE

STA 234+75 TO 237+50 RT  
 REMOVAL AND DISPOSAL OF GUARD RAIL  
~~STA 234+75 TO 235+12 RT~~  
 INSTALL MANUFACTURED TERMINAL SECTION, FLARED

~~STA 235+12 TO 237+13 RT~~  
 INSTALL STEEL BEAM GUARD RAIL, GALVANIZED w/8 FT POSTS  
~~STA 237+13 TO 237+50 RT~~  
 INSTALL MANUFACTURED TERMINAL SECTION, FLARED

233+76 RT  
 BEGIN MTS, FLARED & NEW SBGR

**PAVING PROJECT LAYOUT SHEET #17**

DESIGNED BY	BCE/PJM	DATE	10-06
DRAWN BY	C.E.A., INC.	DATE	10-06
DESIGN FILE NO.	06c042.dgn		
PRF FILE	06c042pl7.l	DATE PLOTTED	24-AUG-2009
PROJ. NAME	MAIDSTONE - BLOOMFIELD		
PROJ. NO.	STP 2609(1)S		
SHEET	27	OF	40 SHEETS