

TEMPORARY 4in YELLOW LINE (PAINT)  
DURABLE 4in YELLOW LINE (THERMOPLASTIC)

STA 300+00 TO 304+66 SOLID LT&RT  
STA 304+66 TO 312+58 SOLID LT & DASHED RT  
STA 312+58 TO 319+44 DASHED  
STA 319+44 TO 327+36 DASHED LT & SOLID RT  
STA 327+36 TO 330+00 SOLID LT&RT

TEMPORARY 4in WHITE LINE (PAINT)  
DURABLE 4in WHITE LINE (THERMOPLASTIC)

STA 300+00 TO 330+00 SOLID LT&RT

STA 300+00 TO 301+00 LT  
REMOVAL AND DISPOSAL  
OF GUARD RAIL

~~STA 300+63 TO 301+00 LT~~  
INSTALL MANUFACTURED  
TERMINAL SECTION, FLARED

~~STA 300+00 TO 300+63 LT~~  
INSTALL STEEL BEAM  
GUARD RAIL, GALVANIZED  
w/8 FT POSTS

STA 305+90 TO 310+65 LT  
REMOVAL AND DISPOSAL  
OF GUARD RAIL

~~STA 305+90 TO 306+27 LT~~  
INSTALL MANUFACTURED  
TERMINAL SECTION, FLARED

~~STA 306+27 TO 310+28 LT~~  
INSTALL STEEL BEAM  
GUARD RAIL, GALVANIZED  
w/8 FT POSTS

~~STA 310+28 TO 310+65 LT~~  
INSTALL MANUFACTURED  
TERMINAL SECTION, FLARED

299+93.5 LT  
END MTS, FLARED  
& NEW SBGR

304+97.5 LT  
BEGIN MTS, FLARED  
& NEW SBGR

309+60 LT  
END MTS, FLARED  
& NEW SBGR

304+97.5 RT  
BEGIN MTS, FLARED  
& NEW SBGR



308+22.5 RT  
END MTS, FLARED  
& NEW SBGR

STA 305+40 TO 309+27 RT  
REMOVAL AND DISPOSAL  
OF GUARD RAIL

~~STA 305+40 TO 305+77 RT~~  
INSTALL MANUFACTURED  
TERMINAL SECTION, FLARED

~~STA 305+77 TO 308+90 RT~~  
INSTALL STEEL BEAM  
GUARD RAIL, GALVANIZED  
w/8 FT POSTS

~~STA 308+90 TO 309+27 RT~~  
INSTALL MANUFACTURED  
TERMINAL SECTION, FLARED

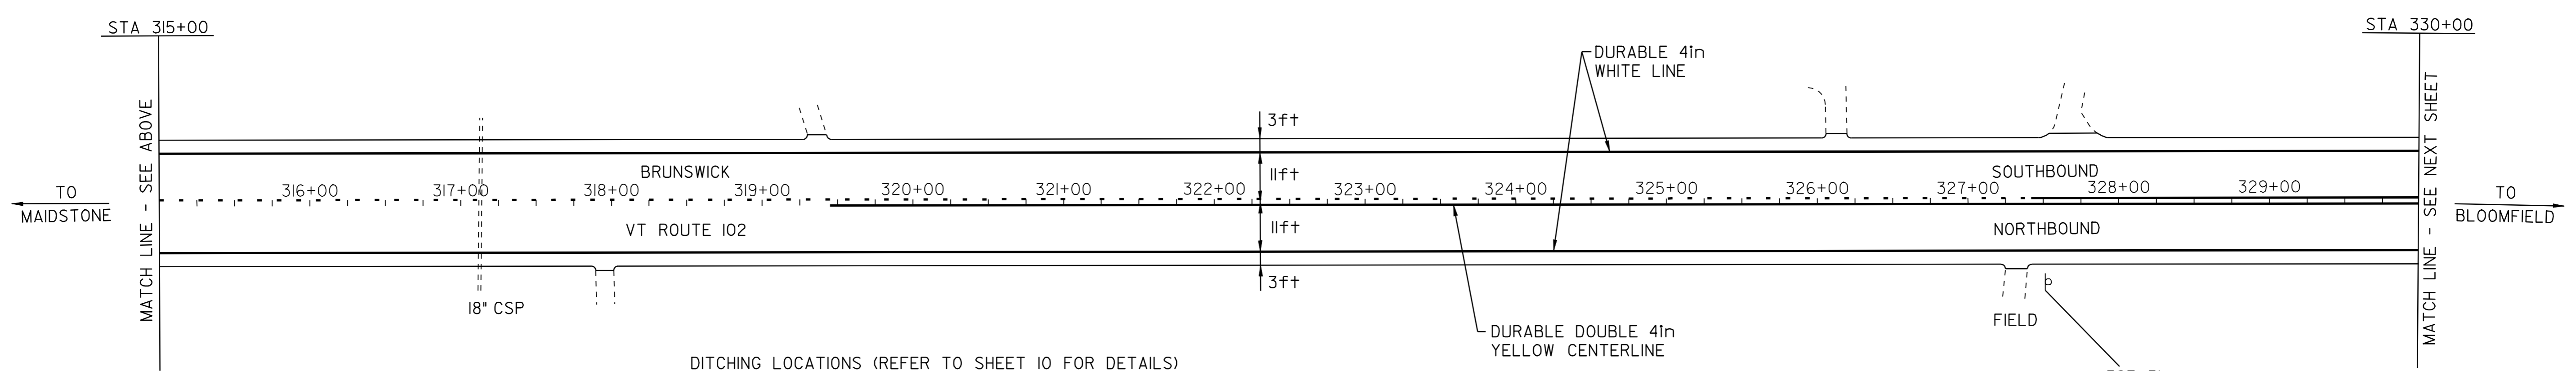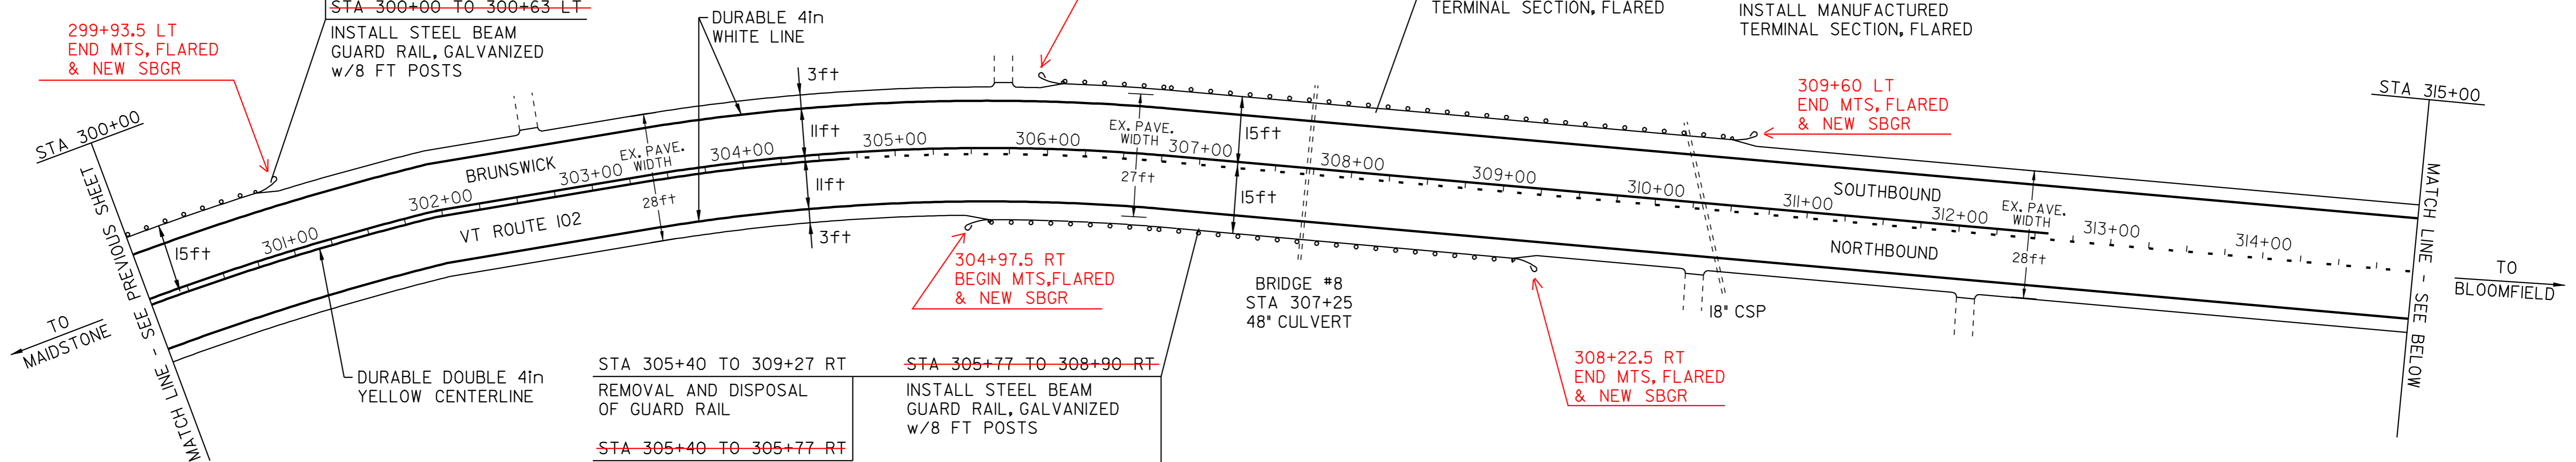

DITCHING LOCATIONS (REFER TO SHEET 10 FOR DETAILS)

STA 328+75 TO 330+00 LT

REMOVAL AND DISPOSAL OF GUARD RAIL

STA 300+00 TO 301+00 LT  
STA 305+40 TO 309+27 RT  
STA 305+90 TO 310+65 LT

~~MANUFACTURED TERMINAL SECTION, FLARED~~

~~STA 300+63 TO 301+00 LT~~  
~~STA 305+40 TO 305+77 RT~~  
~~STA 305+90 TO 306+27 LT~~  
~~STA 308+90 TO 309+27 RT~~  
~~STA 310+28 TO 310+65 LT~~

~~STEEL BEAM GUARD RAIL, GALVANIZED w/8 FT POSTS~~

~~STA 300+00 TO 300+63 LT~~  
~~STA 305+77 TO 308+90 RT~~  
~~STA 306+27 TO 310+28 LT~~

LEGEND

N	=	NEW
R	=	REMOVE
R&S	=	REMOVE & SALVAGE
S	=	SALVAGE
RET	=	RETAIN
B-TO-B	=	BACK TO BACK
⊕	=	CATCH BASIN/DI
(N.W.)	=	NO WORK REQUIRED (TYP. FOR D.I.'S, & C.B.'S WHERE NOTED)
I	=	YIELDING MARKER POST
⊙	=	UTILITY POLE
---	=	DRIVE

## PAVING PROJECT LAYOUT SHEET #20

DESIGNED BY	BCE/PJM	DATE	10-06
DRAWN BY	C.E.A., INC.	DATE	10-06
DESIGN FILE NO.	06c042.dgn		
PRF FILE	06c042p20.1	DATE PLOTTED	24-AUG-2009
PROJ. NAME	MAIDSTONE - BLOOMFIELD		
PROJ. NO.	STP 2609(1)S		
SHEET	30	OF	40 SHEETS