

TEMPORARY 4in YELLOW LINE (PAINT)  
DURABLE 4in YELLOW LINE (THERMOPLASTIC)

STA 330+00 TO 336+07 SOLID LT&RT  
STA 336+07 TO 343+20 SOLID LT & DASHED RT  
STA 343+20 TO 343+99 SOLID LT&RT  
STA 343+99 TO 351+12 DASHED LT & SOLID RT  
STA 351+12 TO 374+11 SOLID LT&RT


TEMPORARY 4in WHITE LINE (PAINT)  
DURABLE 4in WHITE LINE (THERMOPLASTIC)

STA 330+00 TO 374+11 SOLID LT&RT

DITCHING LOCATIONS (REFER TO SHEET 10 FOR DETAILS)

STA 332+00 TO 335+00 LT  
STA 339+60 TO 342+50 RT

RELOCATE MAILBOX, SINGLE SUPPORT  
STA 360+02 RT

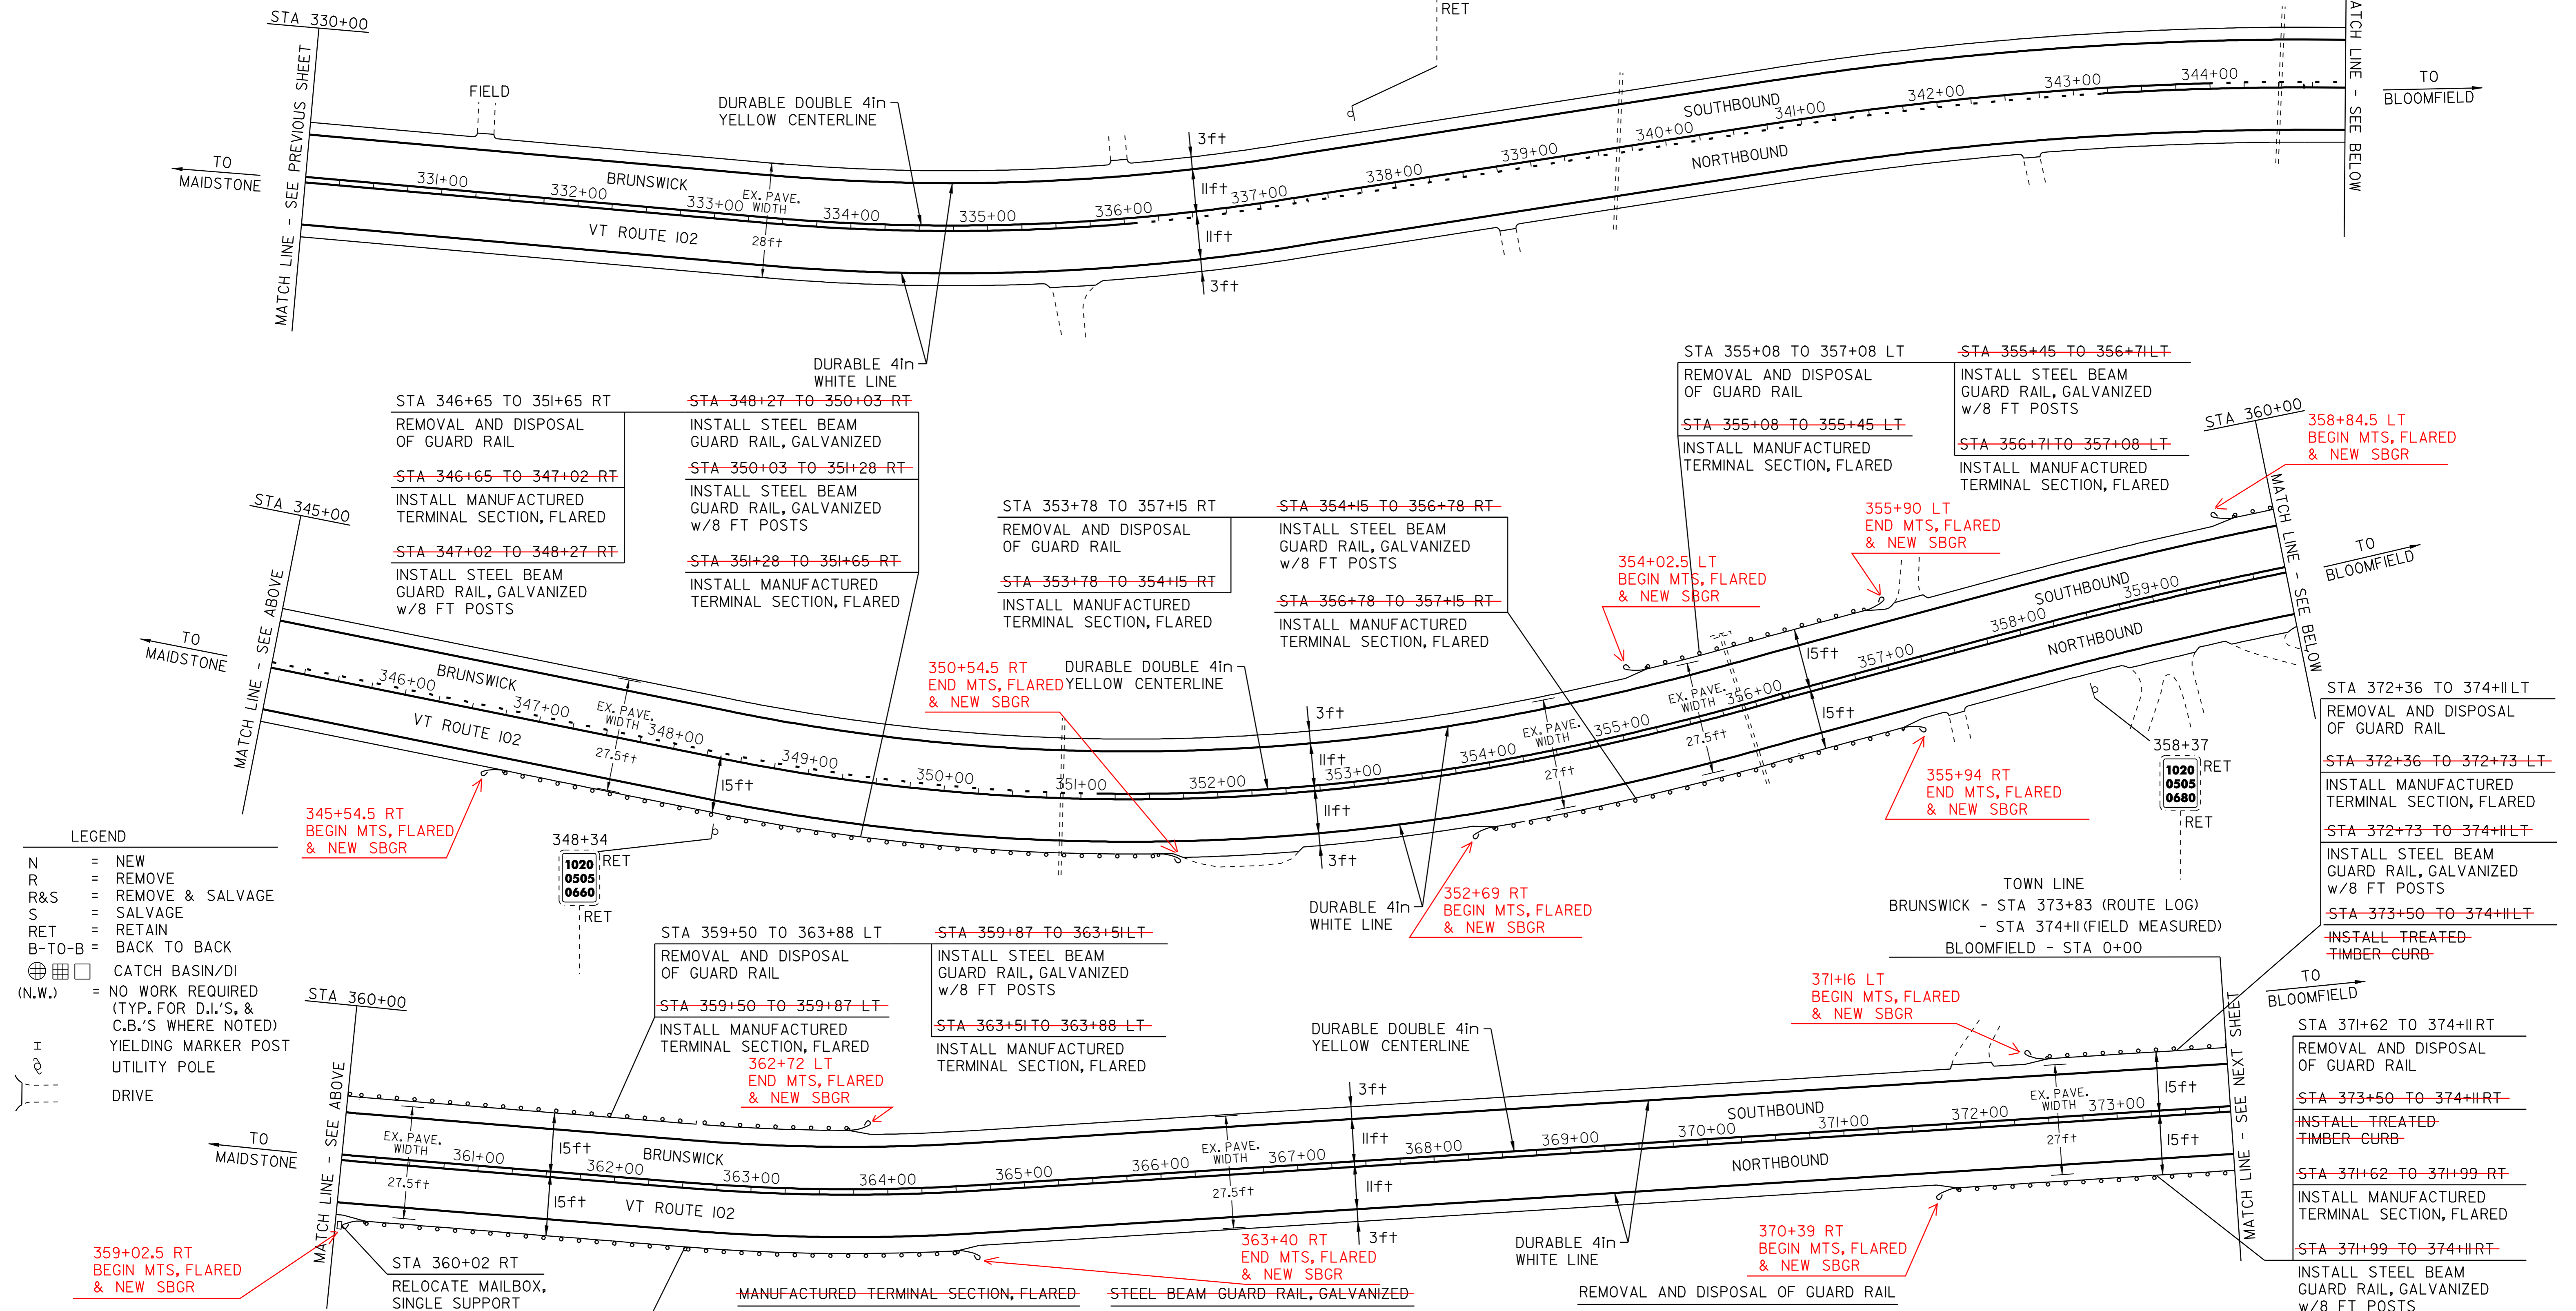

**LEGEND**

N = NEW  
R = REMOVE  
R&S = REMOVE & SALVAGE  
S = SALVAGE  
RET = RETAIN  
B-TO-B = BACK TO BACK  
CATCH BASIN/DI  
(N.W.) = NO WORK REQUIRED (TYP. FOR D.I.'S, & C.B.'S WHERE NOTED)  
I = YIELDING MARKER POST  
UTILITY POLE  
DRIVE

STA 360+05 TO 364+67 RT  
REMOVAL AND DISPOSAL OF GUARD RAIL

STA 360+05 TO 360+42 RT  
INSTALL MANUFACTURED TERMINAL SECTION, FLARED

STA 360+42 TO 364+30 RT  
INSTALL STEEL BEAM GUARD RAIL, GALVANIZED w/8 FT POSTS

STA 364+30 TO 364+67 RT  
INSTALL MANUFACTURED TERMINAL SECTION, FLARED

~~MANUFACTURED TERMINAL SECTION, FLARED~~

~~STA 346+65 TO 347+02 RT~~  
~~STA 351+28 TO 351+65 RT~~  
~~STA 353+78 TO 354+15 RT~~  
~~STA 355+08 TO 355+45 LT~~  
~~STA 356+71 TO 357+08 LT~~  
~~STA 356+78 TO 357+15 RT~~  
~~STA 359+50 TO 359+87 LT~~  
~~STA 360+05 TO 360+42 RT~~  
~~STA 363+51 TO 363+88 LT~~  
~~STA 364+30 TO 364+67 RT~~  
~~STA 371+62 TO 371+99 RT~~  
~~STA 372+36 TO 372+73 LT~~

~~STEEL BEAM GUARD RAIL, GALVANIZED~~  
~~STA 348+27 TO 350+03 RT~~

~~STEEL BEAM GUARD RAIL, GALVANIZED w/8 FT POSTS~~

~~STA 347+02 TO 348+27 RT~~  
~~STA 350+03 TO 351+28 RT~~  
~~STA 354+15 TO 356+78 RT~~  
~~STA 355+45 TO 356+71 LT~~  
~~STA 359+87 TO 363+51 LT~~  
~~STA 360+42 TO 364+30 RT~~  
~~STA 371+99 TO 374+11 RT~~  
~~STA 372+73 TO 374+11 LT~~

REMOVAL AND DISPOSAL OF GUARD RAIL

STA 346+65 TO 351+65 RT  
STA 353+78 TO 357+15 RT  
STA 355+08 TO 357+08 LT  
STA 359+50 TO 363+88 LT  
STA 360+05 TO 364+67 RT  
STA 371+62 TO 374+11 RT  
STA 372+36 TO 374+11 LT

TREATED TIMBER CURB

372+26.5 STA 373+50 TO 374+11 RT  
371+53.5 STA 373+50 TO 374+11 LT

## PAVING PROJECT LAYOUT SHEET #21

DESIGNED BY	BCE/PJM	DATE	10-06
DRAWN BY	C.E.A., INC.	DATE	10-06
DESIGN FILE NO.	06c042.dgn		
PRF FILE	06c042p21.i	DATE PLOTTED	24-AUG-2009
PROJ. NAME	MAIDSTONE - BLOOMFIELD		
PROJ. NO.	STP 2609(1)S		
SHEET	31	OF	40 SHEETS