


TEMPORARY 4in YELLOW LINE (PAINT)
 DURABLE 4in YELLOW LINE (THERMOPLASTIC)
 STA 20+00 TO 26+75
 (WITH CENTERLINE BREAKS FOR TOWN HIGHWAYS)

TEMPORARY 4in WHITE LINE (PAINT)
 DURABLE 4in WHITE LINE (THERMOPLASTIC)
 STA 20+00 TO 26+75
 (WITH EDGELINE BREAKS FOR TOWN HIGHWAYS)

TEMPORARY LETTER OR SYMBOL (PAINT)
 DURABLE LETTER OR SYMBOL (THERMOPLASTIC)
 STA 22+84 LT "STOP AHEAD"
 STA 22+84 RT "STOP AHEAD"

REMOVING SIGNS
 4

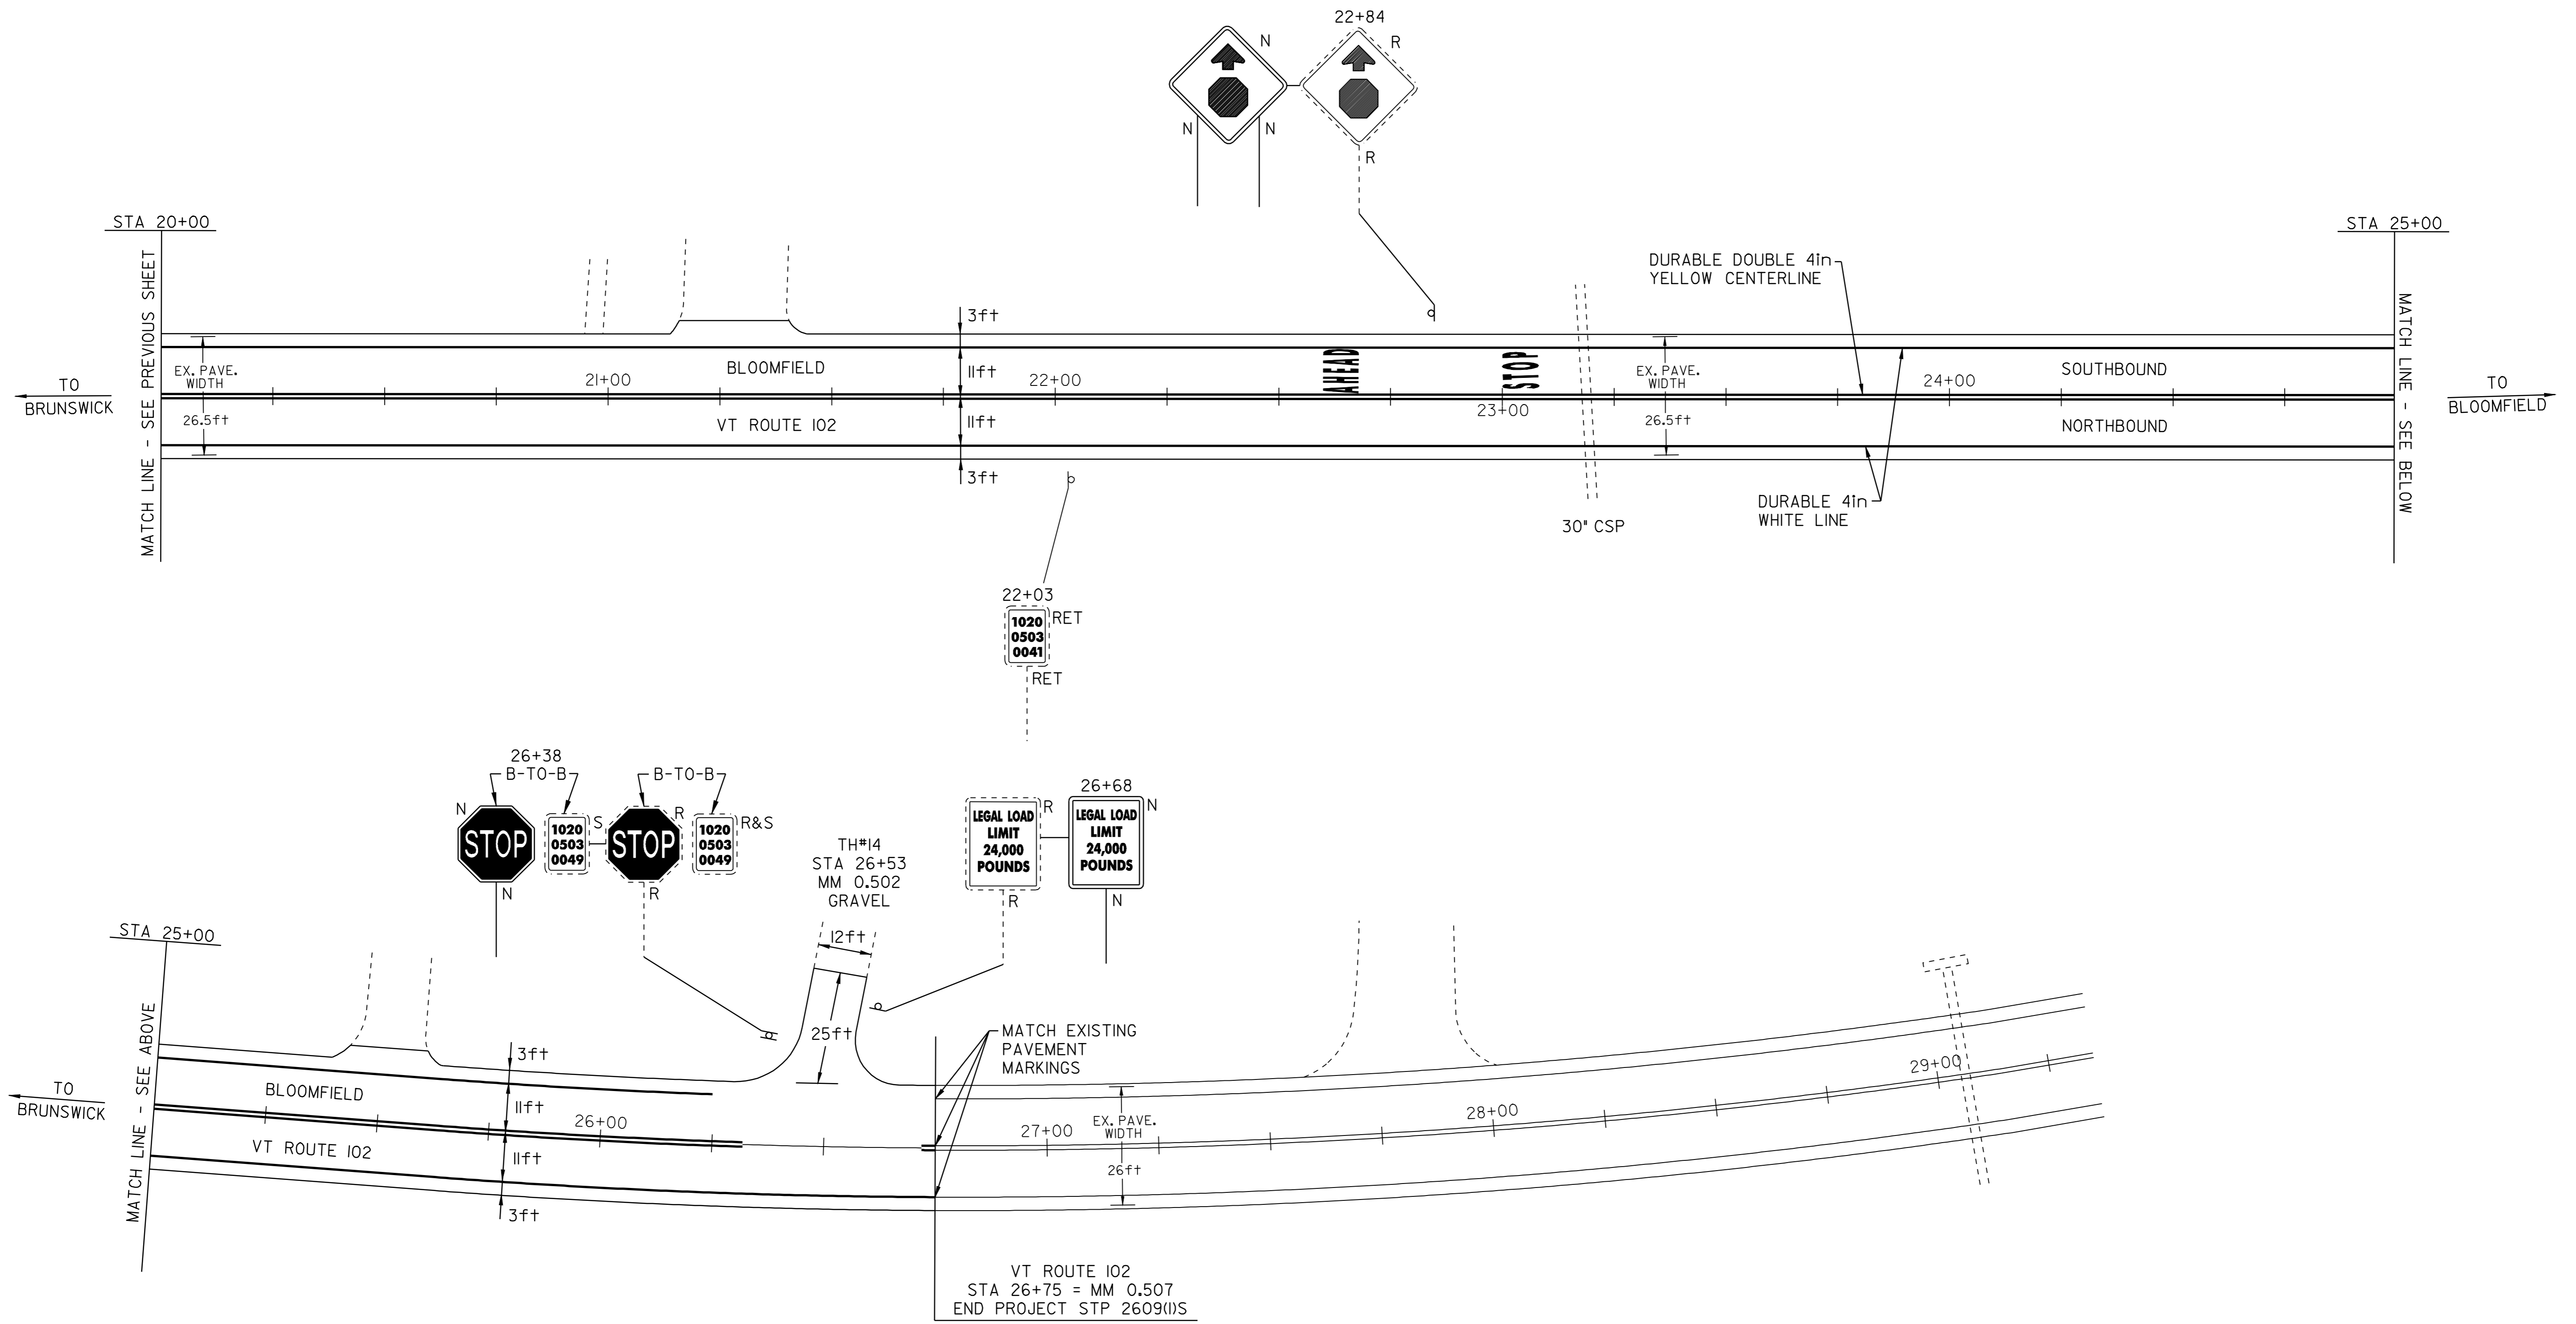

<h1>PAVING PROJECT LAYOUT SHEET #24</h1>	DESIGNED BY	BCE/PJM	DATE	10-06
	DRAWN BY	C.E.A., INC.	DATE	10-06
	DESIGN FILE NO.	06c042.dgn		
	PRF FILE	06c042p24.i	DATE PLOTTED	24-AUG-2009
	PROJ. NAME	MAIDSTONE - BLOOMFIELD		
PROJ. NO.	STP 2609(1)S			
SHEET	34	OF	40	SHEETS