


INDEX OF SHEETS

1	TITLE SHEET
2-3	PROJECT TYPICAL SHEETS
4	ASPHALTIC PLUG-TYPE JOINT DETAIL SHEET
5-6	QUANTITY SHEETS
7-9	ITEM DETAIL SUMMARY SHEETS
10	DITCH CLEANING DETAIL SHEET
11-34	PAVING PROJECT LAYOUT SHEETS
35-37	TRAFFIC SIGN SUMMARY SHEETS
38-39	BRIDGE DETAIL SHEETS
40	CONSTRUCTION APPROACH SIGNING, CONSERVATION SEED MIX, and BURIED END TERMINAL SHEET

VAOT STANDARDS

D-3	TREATED GUTTERS	06-01-94
D-8	REINFORCED CONCRETE DROP INLET WITH PRECAST COVER	01-03-00
	REINFORCED CONCRETE DROP INLET WITH GRATE (BOTTOM SECTION)	
D-15	PRECAST REINFORCED CONCRETE CATCH BASIN W/CAST IRON GRATE	06-01-94
	PRECAST REINFORCED CONCRETE MANHOLE W/CAST IRON COVER	
	CAST IRON GRATE WITH FRAME, TYPE D	
	CAST IRON GRATE WITH FRAME, TYPE E	
E-100	CONSTRUCTION APPROACH SIGNS	01-02-04
E-100A	SIDE ROAD CONSTRUCTION APPROACH SIGNS	01-02-04
E-101	CONSTRUCTION SIGN DETAILS	05-30-03
E-102	CONSTRUCTION SIGN DETAILS	06-30-03
E-102A	CONSTRUCTION SIGN DETAILS	05-01-04
E-103	MAINLINE TRAFFIC CONTROL DIVIDED HIGHWAY ONE LANE CLOSED	03-01-04
E-106	TRAFFIC CONTROL MISCELLANEOUS DETAILS	03-01-04
E-107	DELINEATION, BARRICADES AND DETOURS FOR CONSTRUCTION AREAS	06-30-03
E-107A	BREAKAWAY BARRICADE DETAILS	08-08-95
E-110	MAJOR MAINTENANCE OPERATION LANE CLOSURE	08-08-95
E-111	MINOR MAINTENANCE OPERATIONS	03-11-97
E-119	UTILITY WORK ZONE	03-01-04
E-120	STANDARD SIGN PLACEMENT EXPRESSWAY AND FREEWAY	08-08-95
E-121	STANDARD SIGN PLACEMENT CONVENTIONAL ROAD	08-08-95
E-134	BRIDGE NUMBER PLAQUE	08-08-95
E-141	REGULATORY SIGN DETAILS	09-20-95
E-143	REGULATORY SIGN DETAILS	06-15-04
E-150	WARNING SIGN DETAILS	05-01-04
E-154	WARNING SIGN DETAILS	05-01-04
E-160	FLANGED CHANNEL STEEL SIGN POST	05-20-99
E-164	SQUARE STEEL SIGN POST	05-20-99
E-172	VEHICLE DETECTOR LOOP DETAILS	08-09-95
E-191	PAVEMENT MARKING DETAILS	02-01-99
E-193	PAVEMENT MARKING DETAILS	08-18-95
G-1	STEEL BEAM GUARDRAIL WITH STEEL POSTS	01-03-00
	STEEL BEAM GUARDRAIL WITH WOOD POSTS	
G-1D	STEEL BEAM GUARDRAIL APPROACH END TERMINAL	01-03-00
	STEEL BEAM GUARDRAIL TRAILING END TERMINAL	
	ANCHOR FOR STEEL BEAM GUARDRAIL	
	STEEL BEAM MEDIAN BARRIER	
G-4	PLANK RAIL	06-01-94
	GUIDE POSTS	
	WOOD MARKER POSTS	
	STEEL MARKER POSTS	
G-19	GENERIC PLANS FOR GUARDRAIL END TERMINALS	11-15-02
J-3	MAILBOX SUPPORT DETAIL (SINGLE AND MULTIPLE SUPPORT)	08-07-95

STATE OF VERMONT AGENCY OF TRANSPORTATION

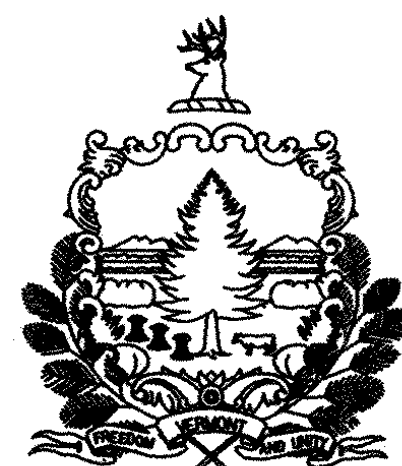



PROPOSED IMPROVEMENTS TOWNS OF MAIDSTONE, BRUNSWICK, AND BLOOMFIELD

COUNTY OF ESSEX VT ROUTE 102

BEGINNING AT STATION 149+42 (MM 2.830) OF VT ROUTE 102 IN THE TOWN OF MAIDSTONE AND EXTENDING NORTHERLY ALONG VT ROUTE 102 THROUGH THE TOWNS OF MAIDSTONE, BRUNSWICK, AND INTO THE TOWN OF BLOOMFIELD FOR A DISTANCE OF APPROXIMATELY 66,423 FEET (12.580 MILES) TO THE END OF THE PROJECT AT STATION 26+75 (M.M. 0.507) IN THE TOWN OF BLOOMFIELD.

STATION TO STATION DATA	LENGTH	
	(FEET)	(MILES)
TOWN OF MAIDSTONE STA 149+42 TO STA 413+07 (MM 2.830 TO MM 7.823)	26,365	4.993
TOWN OF BRUNSWICK STA 0+00 TO STA 373+83 (MM 0.000 TO MM 7.080)	37,383	7.080
TOWN OF BLOOMFIELD STA 0+00 TO STA 26+75 (MM 0.000 TO MM 0.507)	2,675	0.507
PROJECT TOTALS	66,423	12.580

WORK TO BE PERFORMED UNDER THIS PROJECT INCLUDES RESURFACING OF THE EXISTING HIGHWAY WITH COLD PLANING & OVERLAY SECTIONS (LEVELING AND WEARING COURSE), NEW PAVEMENT MARKINGS, GUARD RAIL INSTALLATION, DRAINAGE IMPROVEMENTS AND INCIDENTAL ITEMS.

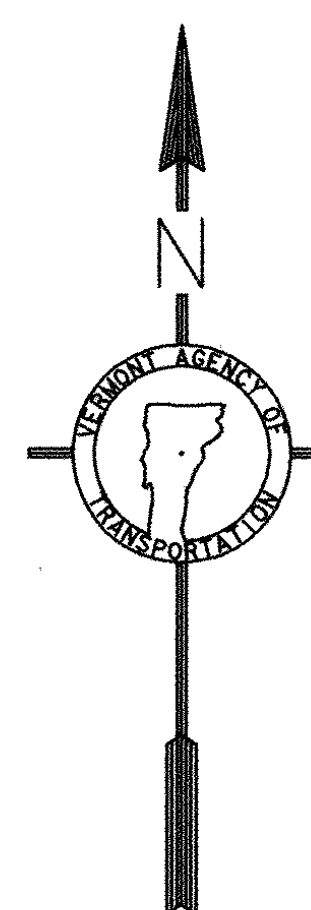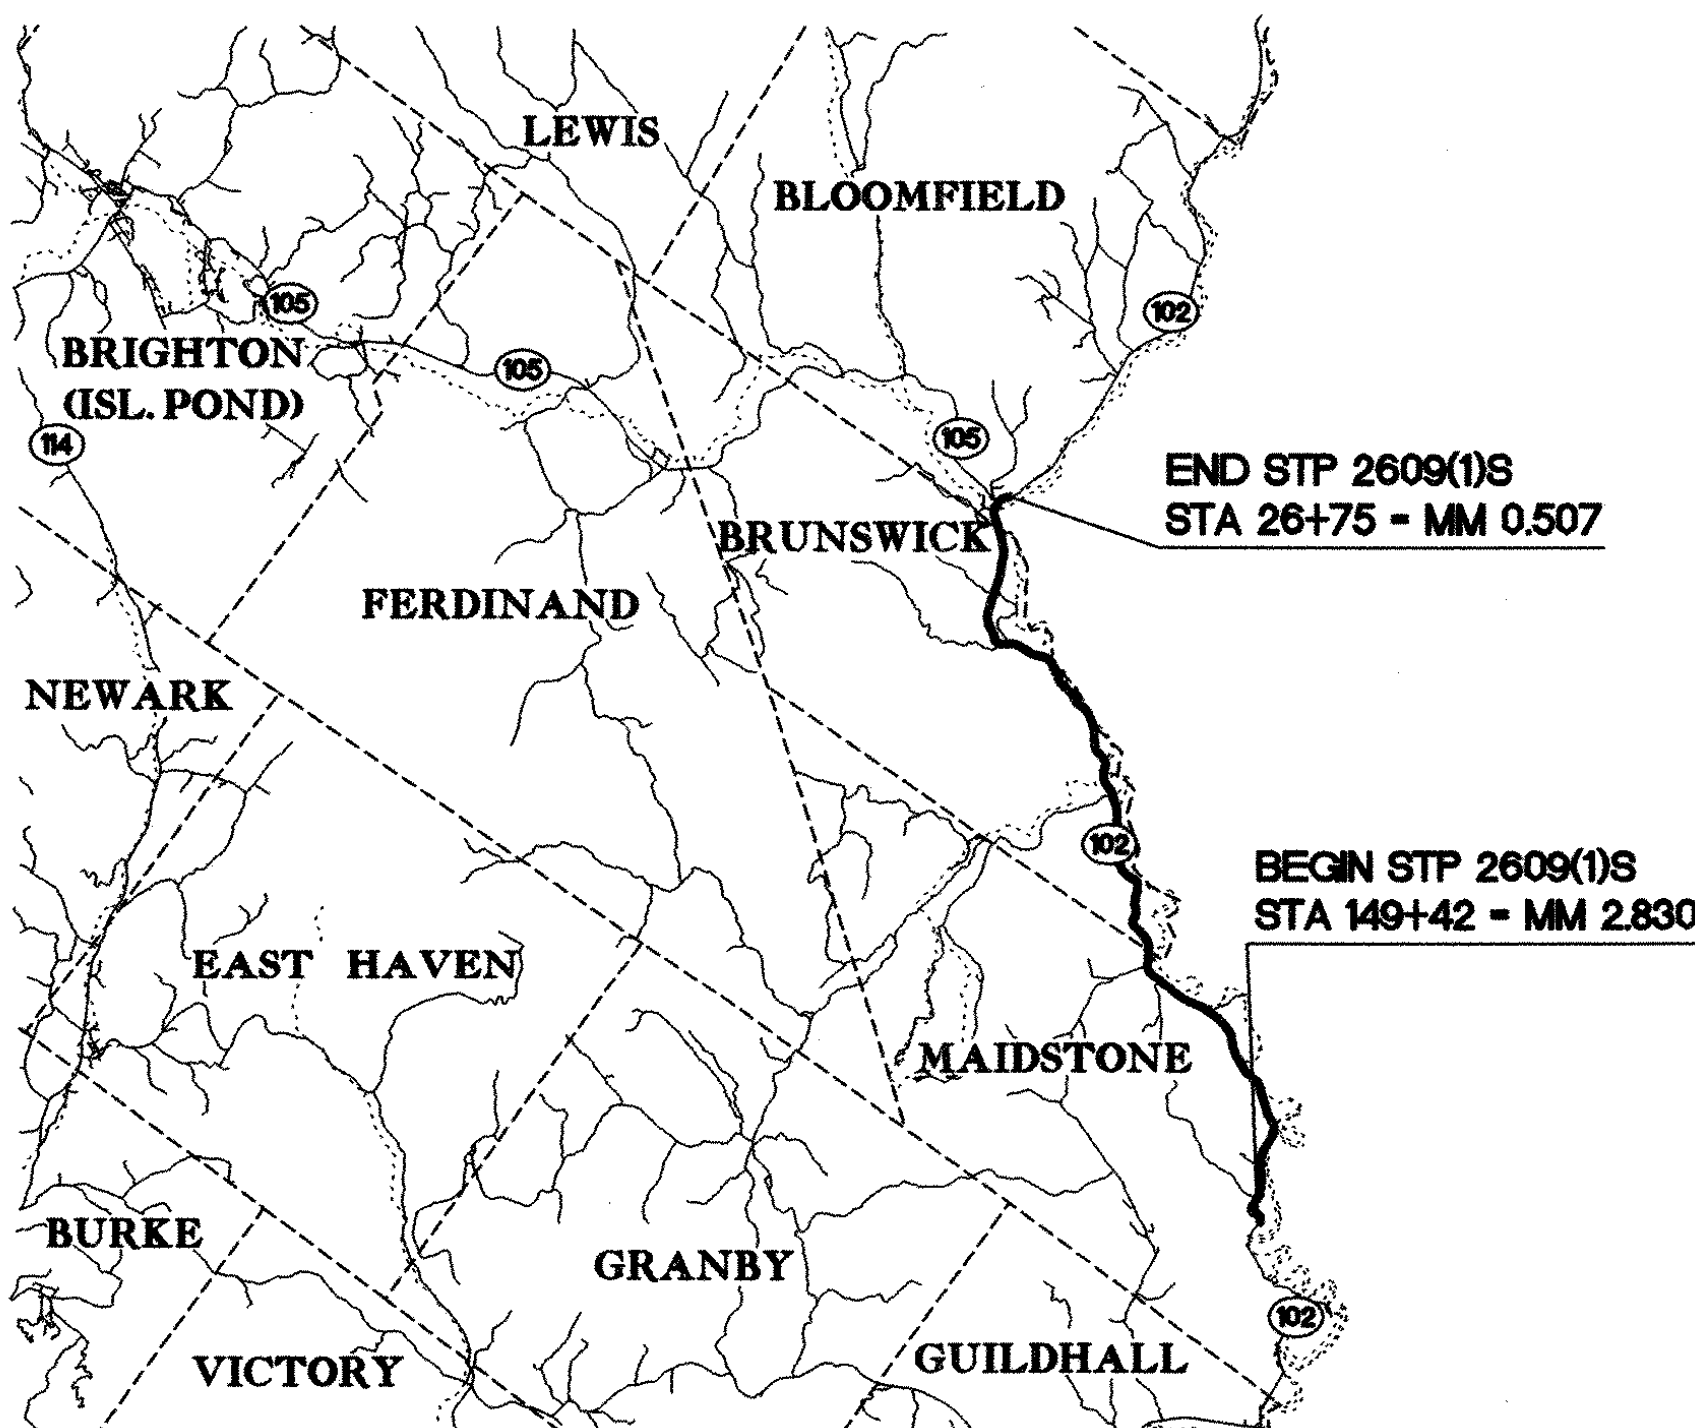


RIGHT-OF-WAY LIMITS, IF APPLICABLE, ARE PROVIDED SOLELY FOR THE CONVENIENCE OF THE STATE AND ITS CONTRACTOR DURING THE COURSE OF THIS PAVING PROJECT. ANY REFERENCES TO OFFSETS ON THESE PLANS ARE APPROXIMATE AND SHOULD NOT BE RELIED UPON FOR ANY OTHER PURPOSES.

UNLESS OTHERWISE NOTED, ALL DRAWINGS AND DETAILS ON THESE PLANS ARE DRAWN "NOT TO SCALE".

THESE PLANS ARE SUBJECT TO SUCH ENGINEERING CHANGES AS MAY BE REQUIRED BY THE FEDERAL HIGHWAY ADMINISTRATION OR THE DIRECTOR OF PROGRAM DEVELOPMENT.

CONSTRUCTION IS TO BE CARRIED ON IN ACCORDANCE WITH THESE PLANS AND THE STANDARD SPECIFICATIONS FOR CONSTRUCTION DATED 2006, AS APPROVED BY THE FEDERAL HIGHWAY ADMINISTRATION ON JUNE 15, 2006 FOR USE ON THIS PROJECT, INCLUDING ALL SUBSEQUENT REVISIONS AND SUCH REVISED SPECIFICATIONS AND SPECIAL PROVISIONS AS ARE INCORPORATED IN THESE PLANS.

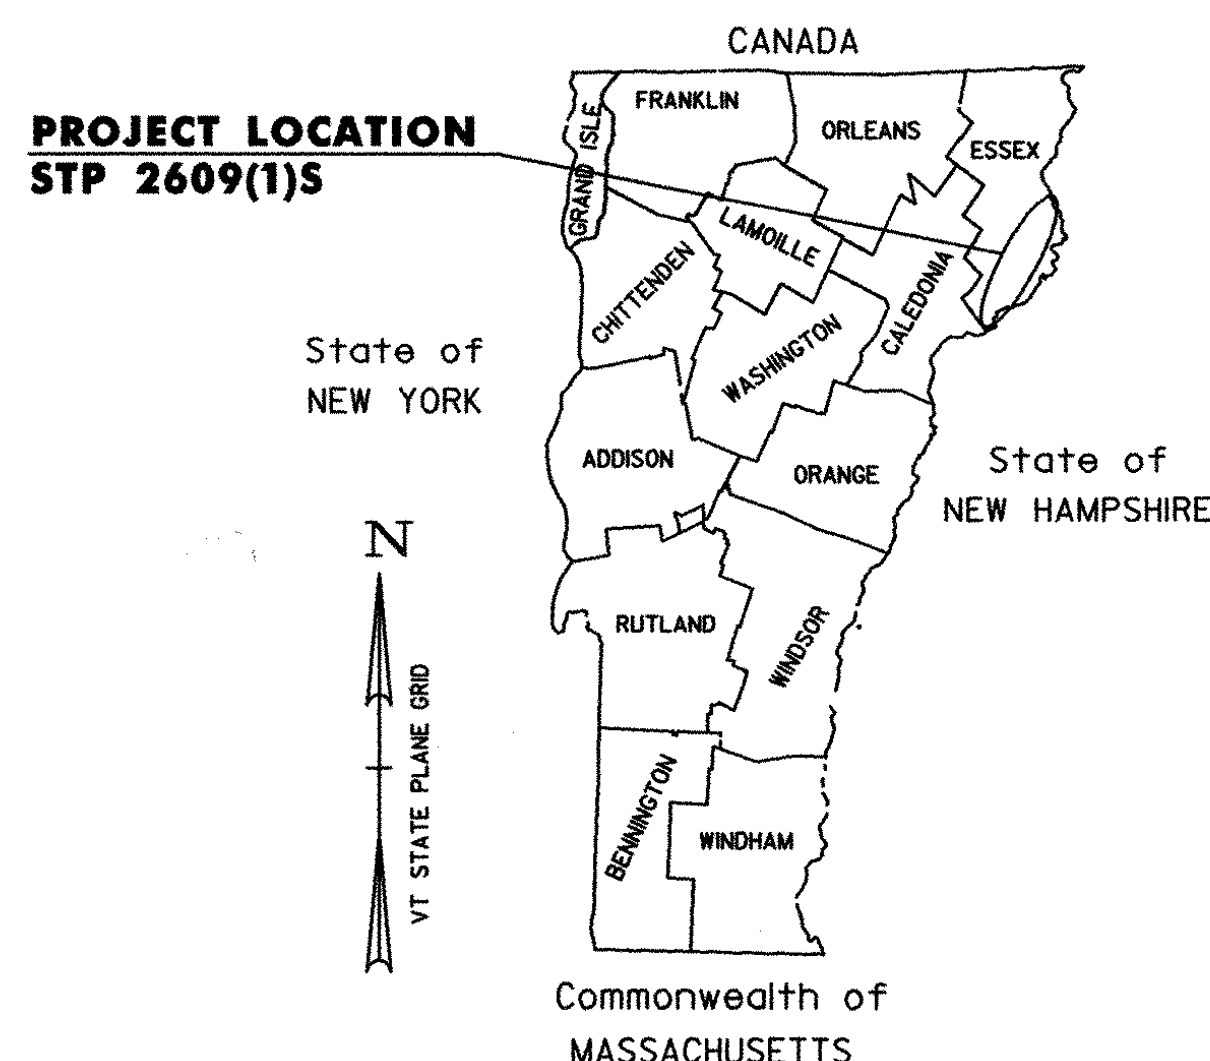

TRAFFIC DATA

SECTION	ADT			DHV			ESAL'S (2007-2017)	ESAL'S (2007-2027)
	2007	2017	2027	2007	2017	2027		
SECTION 1	540	600	670	70	80	90	127,000	297,000
SECTION 2	560	620	690	75	80	90	131,000	307,000

RECORD PLANS

CONTRACTOR: PIKE INDUSTRIES, INC. - BERLIN, VT

RESIDENT ENGINEER: DOUG BUMPS

CONSTRUCTION BEGAN: APRIL 28, 2008

CONSTRUCTION COMPLETE: OCTOBER 20, 2008

RECORD PLANS BY: D. BUMPS & C. PIERCE

I HEREBY CERTIFY THAT ALL THE CONSTRUCTION REQUIRED BY THIS SET OF DRAWINGS HAS BEEN ACCOMPLISHED AS INDICATED HEREIN.

BY: *Douglas Bumps* RESIDENT ENGINEER

DATE: 7/1/09

NOTE: Any further information concerning final quantities, amounts or other details relative to this project may be found at Central Files in the electronic archives.

CONVENTIONAL SIGNS

COUNTY LINE	---
TOWN LINE	- - - -
LIMITS OF ACCESS	o-o-o-o
POINT OF ACCESS	X
FENCE LINE	x-x-x-x
STONE WALL	o-o-o-o
TRAVELED WAY	o-o-o-o
RAILROAD	o-o-o-o
SURVEY LINE	+
CULVERT	o
POWER POLE	o
TELEPHONE POLE	o
TREES	o
CONTROL OF ACCESS	///
PROPERTY LINE	---
R.O.W. TAKING LINE	SR
SLOPE RIGHTS	o
TOP OF CUT	o
TOE OF SLOPE	o

DATUM

VERTICAL: N/A

HORIZONTAL: N/A


BY: *[Signature]*

CIVIL ENGINEERING ASSOCIATES, INC.
P.O. BOX 488 SHELburnE, VT 05482
802-985-2323 FAX: 802-985-2271 web: www.ceo-vt.com


DIRECTOR OF PROGRAM DEVELOPMENT	
APPROVED: <i>[Signature]</i>	DATE: 9-6-07
PROJECT MANAGER: TED DOMEY	
PROJECT NAME: MAIDSTONE - BLOOMFIELD	
PROJECT NUMBER: STP 2609(1)S	
SHEET 1 OF 40 SHEETS	

NOTES


- THE PAVEMENT WEARING COURSE SHALL BE TYPE IV.
- THE LEVELING COURSE SHALL BE TYPE IV UNLESS OTHERWISE SHOWN IN THE PLANS OR DIRECTED BY THE RESIDENT ENGINEER. LEVELING HAS BEEN INCLUDED TO RESHAPE THE ROADWAY PRIOR TO PAVING THE TOP COURSE ALONG THE OVERLAY AND COLD PLANE TYPICAL SECTIONS. AN ESTIMATED THICKNESS OF 1 in OF ITEM 406.27 HAS BEEN INCLUDED TO COVER THIS PROVISION. AN INCREASED LEVELING DEPTH HAS BEEN INCLUDED BECAUSE OF THE EXTREME RUTTING IN THE EXISTING PAVEMENT.
- ALL ASPHALT CEMENT USED IN THE BITUMINOUS CONCRETE PAVEMENT SHALL BE PG 58-34.
- EMULSIFIED ASPHALT SHALL BE APPLIED ON EXISTING PAVEMENT SURFACES, BETWEEN ALL COURSES OF PAVEMENT AND ON COLD PLANED SURFACES AT THE RATE OF 0.025 GAL/SY OR AS DIRECTED BY THE RESIDENT ENGINEER.
- BITUMINOUS CONCRETE PAVEMENT TOLERANCE = +/- 1/4 in (TOTAL THICKNESS EXCLUDING LEVELING).
- EXISTING SHOULDER MATERIAL DEEMED UNSUITABLE BY THE RESIDENT ENGINEER WILL BE EXCAVATED TO A DEPTH OF 3 in +/- OR AS DIRECTED BY THE RESIDENT ENGINEER. EXCAVATED MATERIAL WILL BE SPREAD ON THE ADJACENT SLOPES OR REMOVED FROM THE PROJECT, AS DIRECTED BY THE RESIDENT ENGINEER. THIS WORK WILL BE PAID FOR USING THE APPROPRIATE RENTAL ITEMS SUCH AS ALL PURPOSE EXCAVATOR RENTAL, TYPE I, POWER GRADER RENTAL, LOADER RENTAL, TYPE I, TRUCK RENTAL, AND POWER BROOM RENTAL, TYPE I. THE METHOD OF REMOVAL AND THE USE OF RENTAL ITEMS SHALL BE APPROVED BY THE RESIDENT ENGINEER PRIOR TO ANY WORK BEING DONE. MATERIAL REMOVED SHALL BE REPLACED WITH SUBBASE OF CRUSHED GRAVEL, FINE GRADED.
- THREE FEET OF BACKING IS REQUIRED BEHIND THE FACE OF GUARD RAIL WITH 6 ft POSTS. IF THIS CANNOT BE OBTAINED THEN 8 ft POSTS SHALL BE USED. ALL GUARDRAIL SHALL BE STEEL BEAM WITH STEEL POSTS AND WOOD BLOCKOUTS (OR APPROVED ALTERNATIVE MATERIAL). NEW GUARDRAIL SHALL BE INSTALLED IN COMPLIANCE WITH STANDARD G-1.
- COLD PLANING TO BE COMPLETED ACCORDING TO THE TYPICAL OR AS NOTED OTHERWISE ON THE PLANS. A FULL DEPTH BUTT JOINT SHALL BE CONSTRUCTED AT THE PROJECT BEGIN/END AND AT ALL SIDE ROAD APPROACHES AS DENOTED ON THE PROJECT PLANS OR AS OTHERWISE DIRECTED BY THE RESIDENT ENGINEER.
- ITEMS 604.40 & 604.412 ARE ESTIMATED QUANTITIES AND SHALL BE PERFORMED AT LOCATIONS INDICATED ON THE LAYOUT SHEETS AND AS DIRECTED BY THE RESIDENT ENGINEER. ALL D.I.'S SHALL BE RAISED OR REHABILITATED SUCH THAT THE NEW GRATE ELEVATION IS LEVEL WITH THE SURROUNDING TERRAIN.
- ALL EDGES OF PAVEMENT AND TREATED TIMBER CURB SHALL BE BACKED UP FULL HEIGHT WITH ITEM 402.12, AGGREGATE SHOULDERS, AS DIRECTED BY THE RESIDENT ENGINEER.
- ALL DRIVES SHALL RECEIVE A PAVED APRON AS DIRECTED BY THE RESIDENT ENGINEER. ALL REQUIRED EXCAVATION IN DRIVE AREAS SHALL BE PERFORMED AS DIRECTED BY THE RESIDENT ENGINEER AND WILL BE PAID FOR UNDER THE APPLICABLE RENTAL ITEM(S). IF REQUIRED, A NEW DRIVEWAY SUBBASE SHALL BE CONSTRUCTED AND WILL BE PAID FOR UNDER ITEM 301.28, SUBBASE OF CRUSHED GRAVEL, FINE GRADED. A NEW BITUMINOUS SURFACE SHALL BE CONSTRUCTED AS DIRECTED BY THE RESIDENT ENGINEER AND WILL BE PAID FOR UNDER ITEM 406.27. ESTIMATED QUANTITIES OF THE ABOVE ITEMS HAVE BEEN INCLUDED TO PAY FOR THIS WORK.
- AN ESTIMATED QUANTITY OF EARTH BORROW HAS BEEN INCLUDED FOR THE PROVISION OF CONSTRUCTING GUARD RAIL END SECTIONS WHICH SHALL BE CAPPED WITH AN ESTIMATED 3" DEPTH OF AGGREGATE SHOULDER MATERIAL UNLESS OTHERWISE DIRECTED BY THE RESIDENT ENGINEER. THE QUANTITIES INCLUDED REFLECT 25 CUBIC YARDS OF EARTH BORROW AND 5 TONS OF AGGREGATE SHOULDERS FOR EACH GUARD RAIL TERMINAL.
- ITEM 616.47, BITUMINOUS CONCRETE GUTTERS AND TRAFFIC ISLANDS WILL BE PAID ONLY WHERE SPECIFIED IN THE PLANS. ALL OTHER BITUMINOUS CONCRETE PAVEMENT WORK, WHICH COULD INVOLVE SOME HAND-WORK (SUCH AS DRIVE AND SIDE ROAD APPROACHES AND AROUND DRAINAGE/UTILITY STRUCTURES), SHALL BE PAID FOR AT THE CONTRACT UNIT PRICE FOR ITEM 406.27, MEDIUM DUTY BITUMINOUS CONCRETE PAVEMENT (PG 58-34).
- COMPACTION, GRADING, AND CLEAN UP OF ITEM 301.28, SUBBASE OF CRUSHED GRAVEL, FINE GRADED, ITEM 402.12, AGGREGATE SHOULDERS, AND ITEM 651.35, TOPSOIL, IS TO BE INCLUDED IN THE CONTRACT PRICE OF EACH ITEM.

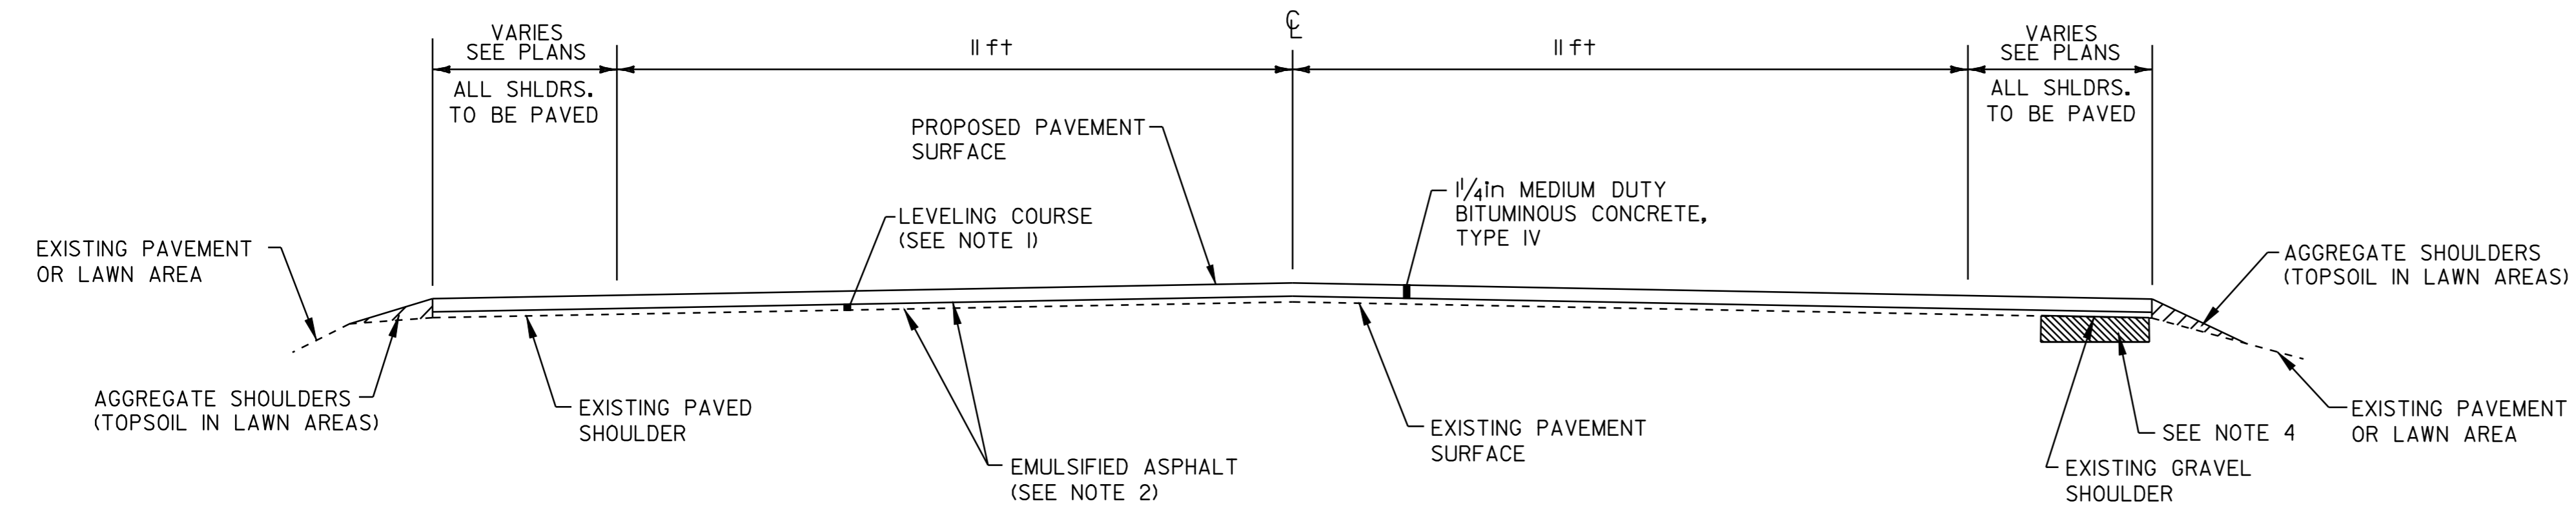

OVERLAY TYPICAL SECTION
MAIDSTONE
STA 149+42 TO 413+07
BLOOMFIELD
STA 0+00 TO 8+00

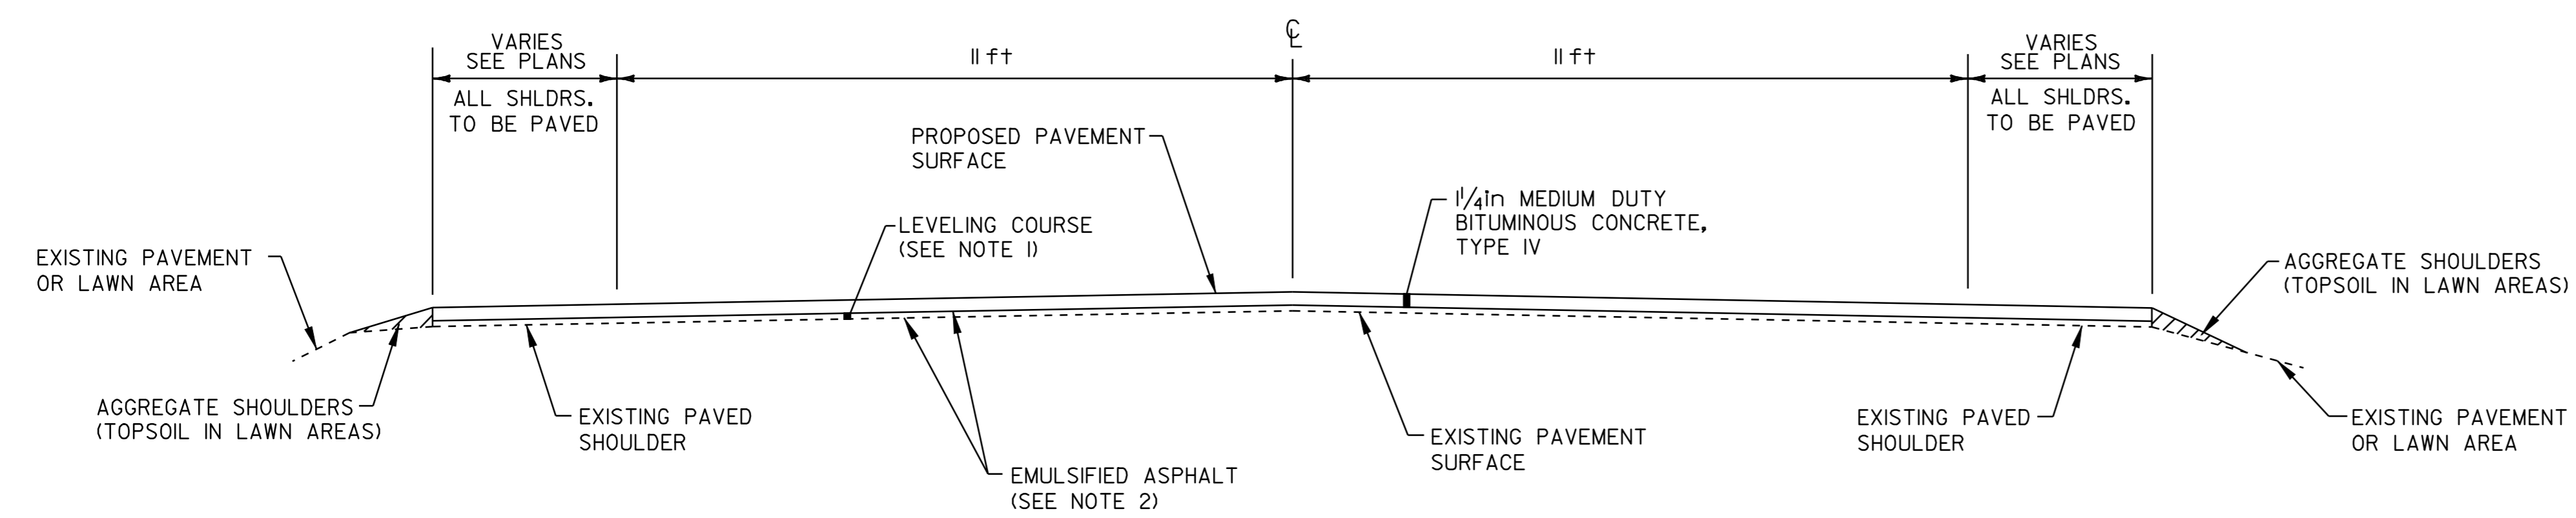

OVERLAY TYPICAL SECTION
BRUNSWICK
STA 0+00 TO 373+83

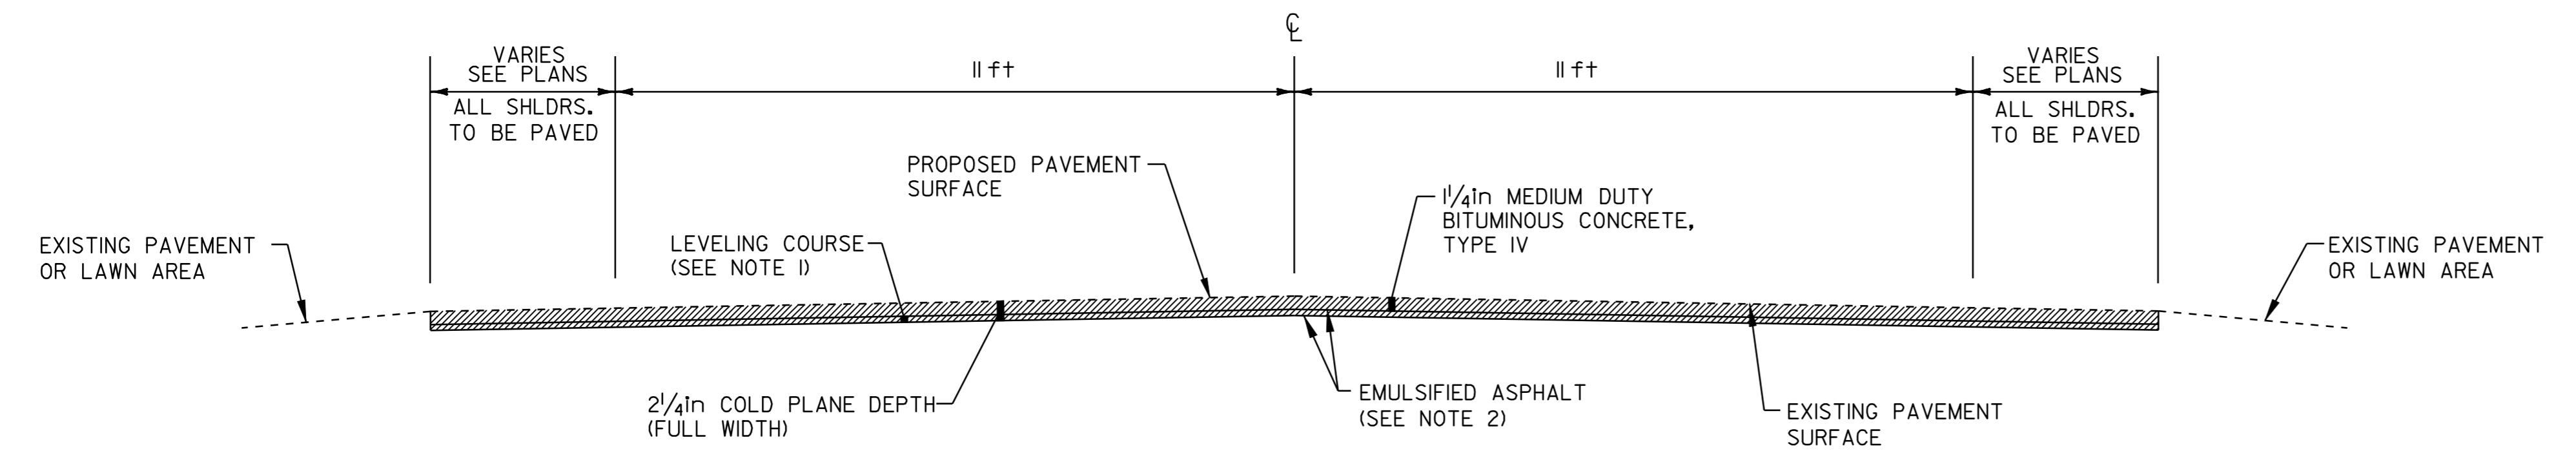


COLD PLANED TYPICAL SECTION
BLOOMFIELD
STA 8+00 TO 26+75

PROJECT PAVING LIMITS

TOWN & ROUTE	BEGIN STATION	END STATION	LANE TYPICAL	WEARING DEPTH	LEVELING Tons	NOTES
MAIDSTONE- VT ROUTE 102	149+42	413+07	VARIES-IIft-IIft-VARIES	1/4in	4,700	LEVEL & PAVE W/1/4in TYPE IV
BRUNSWICK - VT ROUTE 102	0+00	373+83	VARIES-IIft-IIft-VARIES	1/4in	6,790	LEVEL & PAVE W/1/4in TYPE IV
BLOOMFIELD - VT ROUTE 102	0+00	8+00	VARIES-IIft-IIft-VARIES	1/4in	130	LEVEL & PAVE W/1/4in TYPE IV
	8+00	26+75	VARIES-IIft-IIft-VARIES	1/4in	370	COLD PLANE 2/4in, LEVEL, & PAVE W/1/4in TYPE IV


PROJECT TYPICAL SHEET #1

DESIGNED BY	BCE/PJM	DATE	10-06
DRAWN BY	C.E.A., INC.	DATE	10-06
DESIGN FILE NO.	06c042.dgn		
PRF FILE	06c042+typ1	DATE PLOTTED	24-AUG-2009
PROJ. NAME	MAIDSTONE - BLOOMFIELD		
PROJ. NO.	STP 2609(1)S		
SHEET	2	OF	40 SHEETS

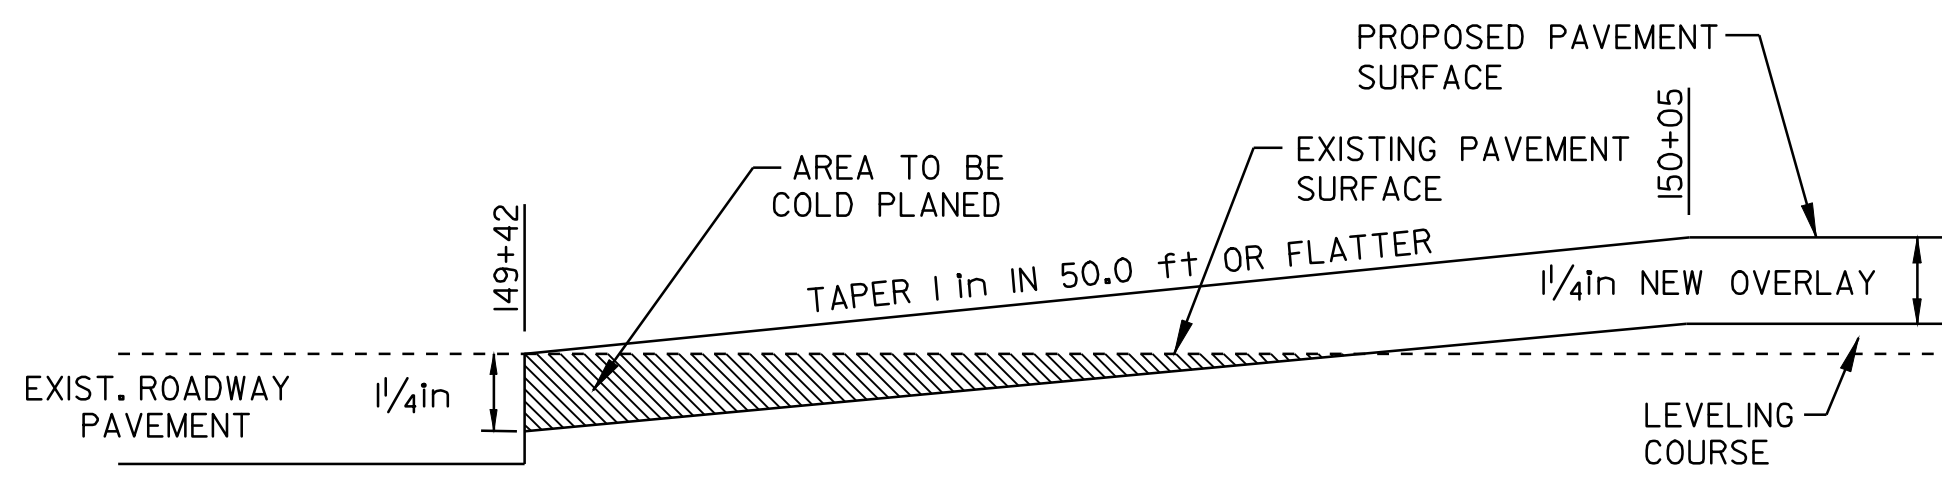


- APPROACH AREA DETAIL -

MAIDSTONE
STA 149+42 TO 150+05 (BEGIN PROJECT)

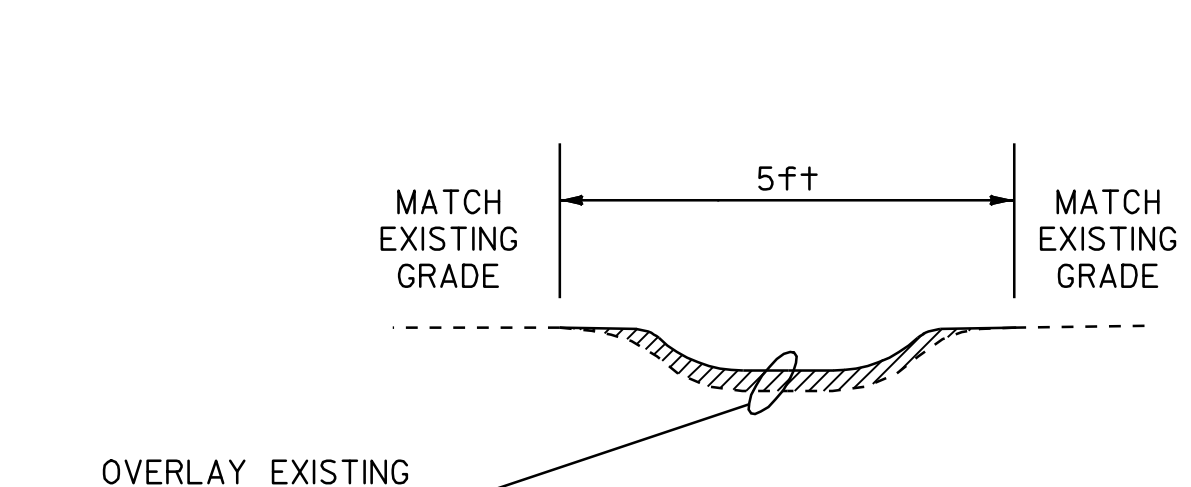


BITUMINOUS CONCRETE GUTTER DETAIL (PERPENDICULAR TO ROADWAY)
BRUNSWICK

STA 62+30 RT (30' LONG)

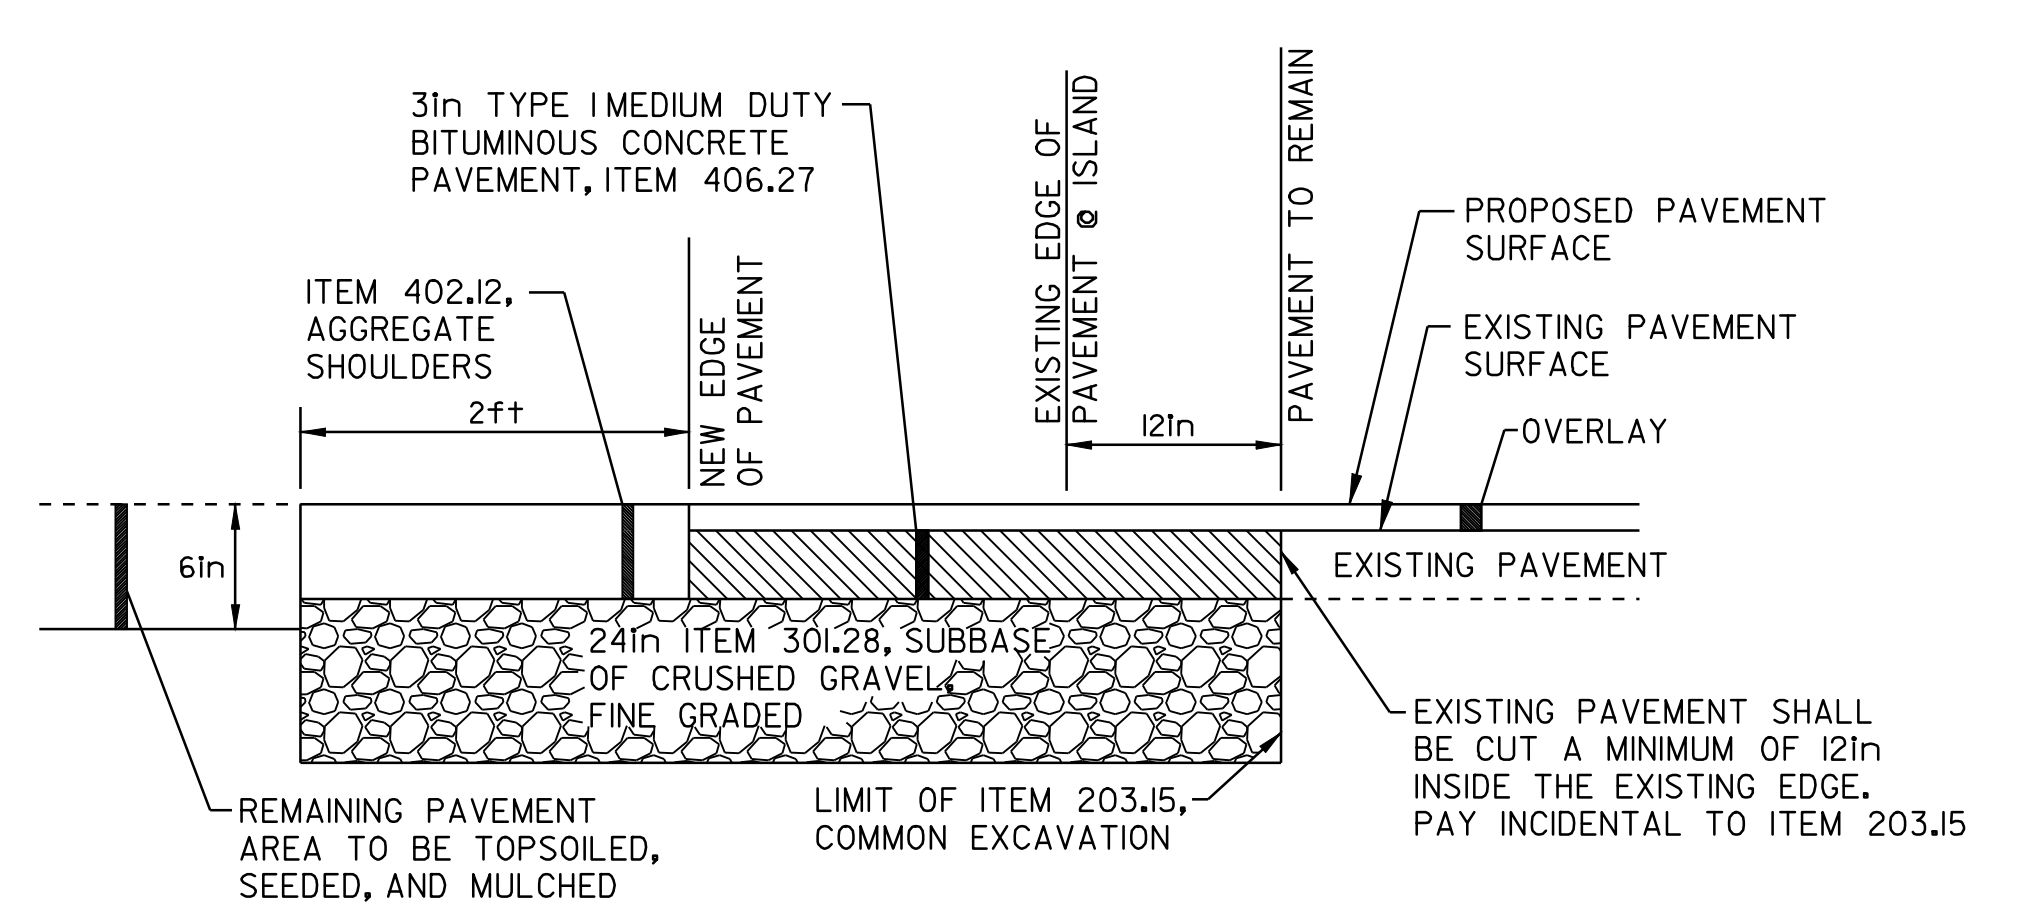


ROAD SECTION AT ISLAND/PAVEMENT TO BE REMOVED

BRUNSWICK
INTERSECTION SFH/VT ROUTE 102
STA 115+64

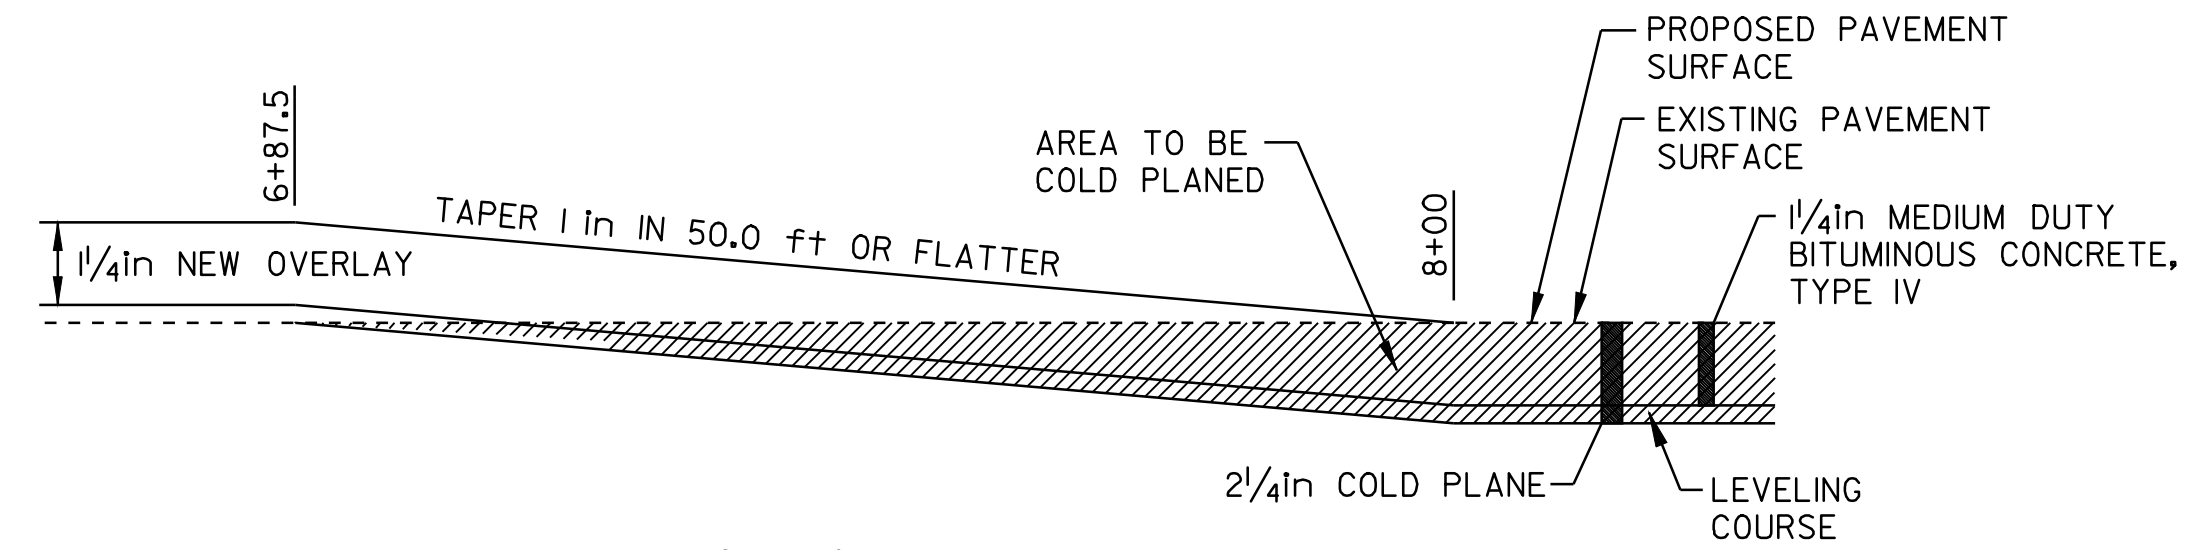


- TRANSITION AREA DETAIL -

BLOOMFIELD
STA 6+87.5 TO 8+00 (END OVERLAY/BEGIN COLD PLANE)

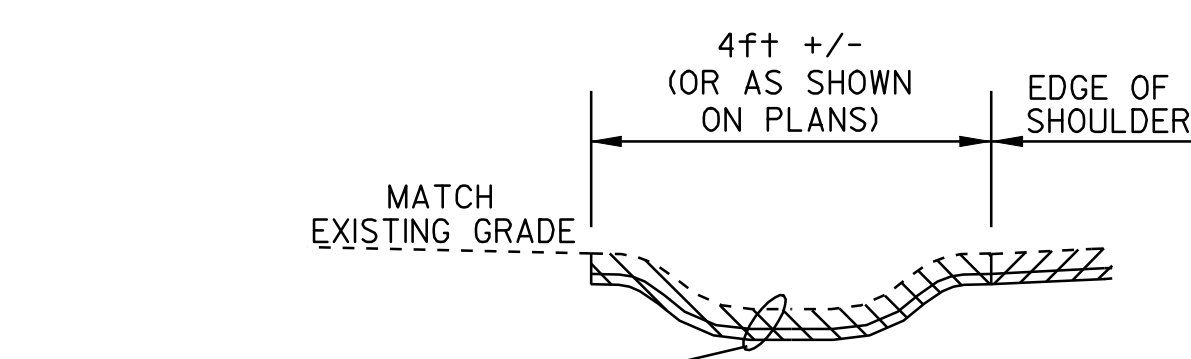


BITUMINOUS CONCRETE GUTTER DETAIL
BLOOMFIELD

STA 15+95 TO 16+63 RT
 STA 15+98 TO 16+80 LT

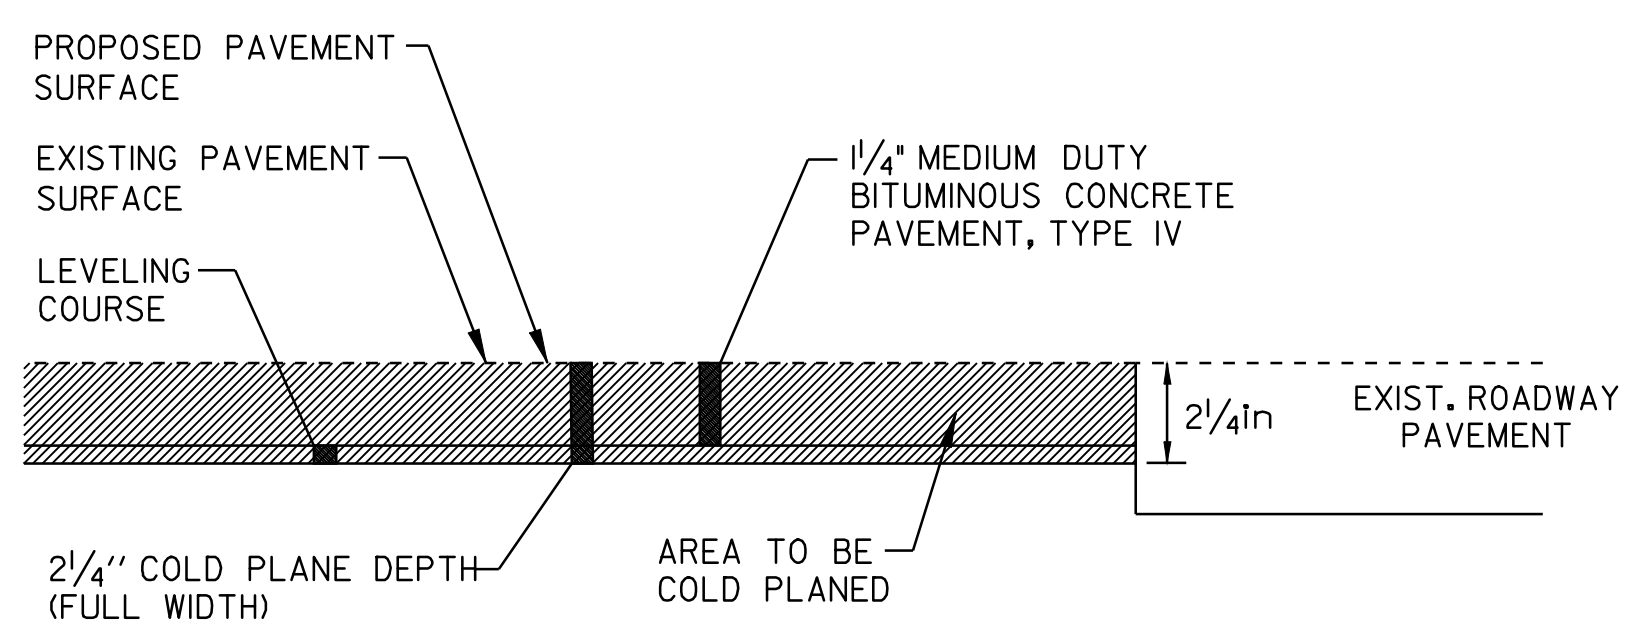


- APPROACH AREA DETAIL -

BLOOMFIELD
STA 26+75 (END PROJECT)

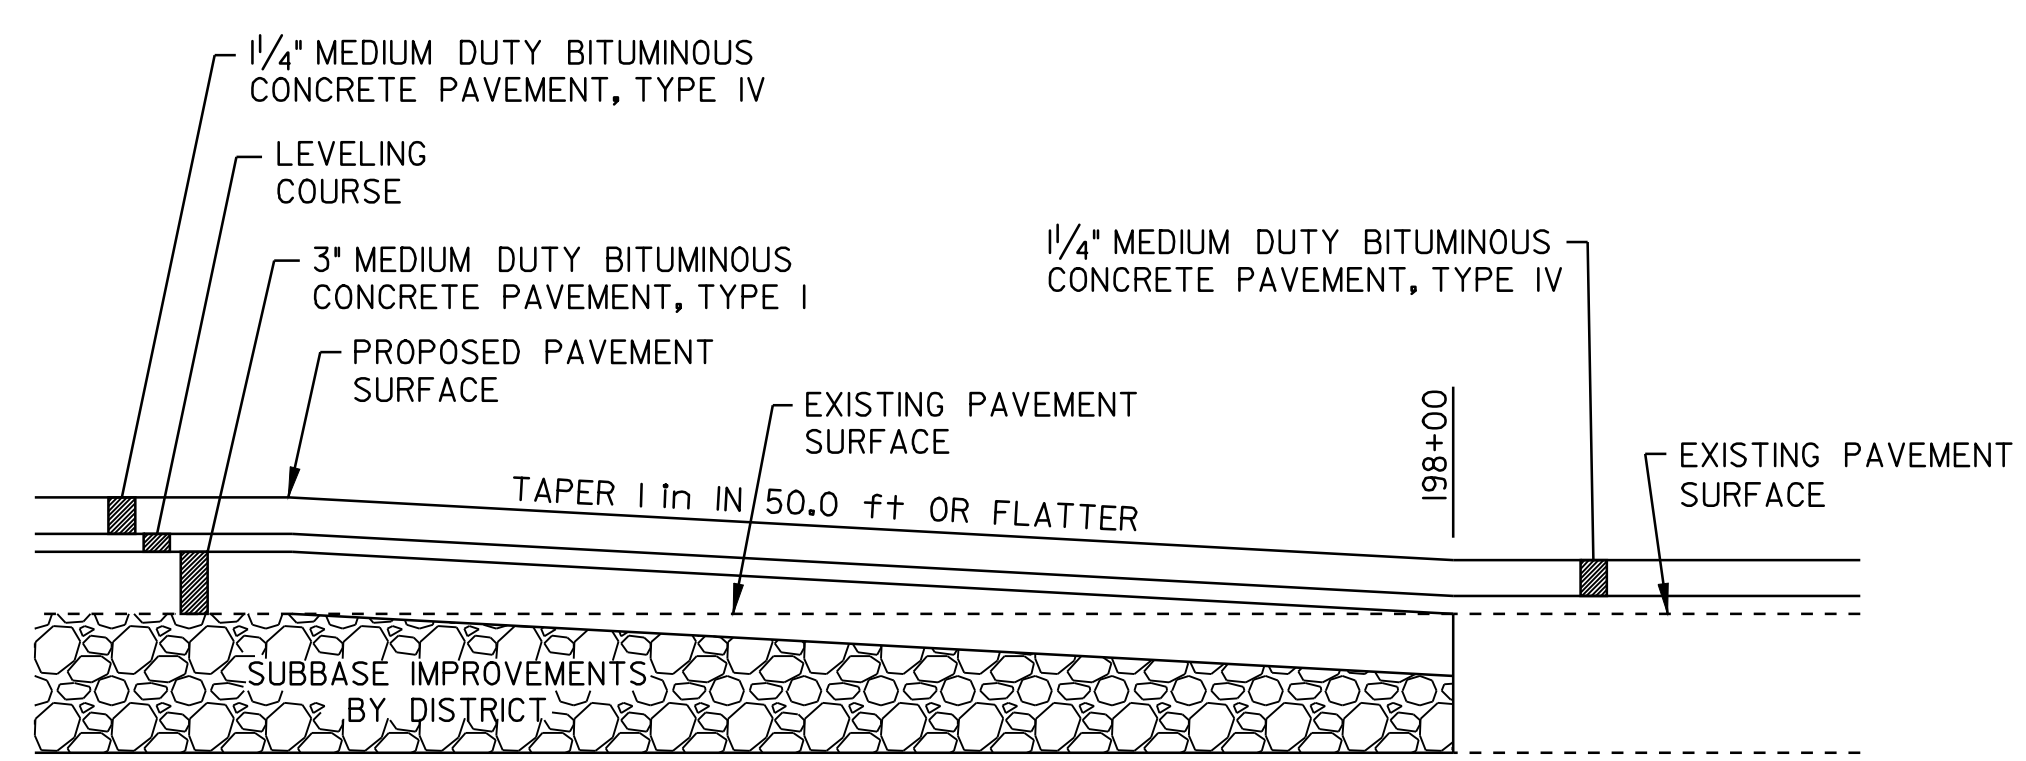


-SUBBASE IMPROVEMENTS DETAIL-

MAIDSTONE
STA 191+50 TO 198+00

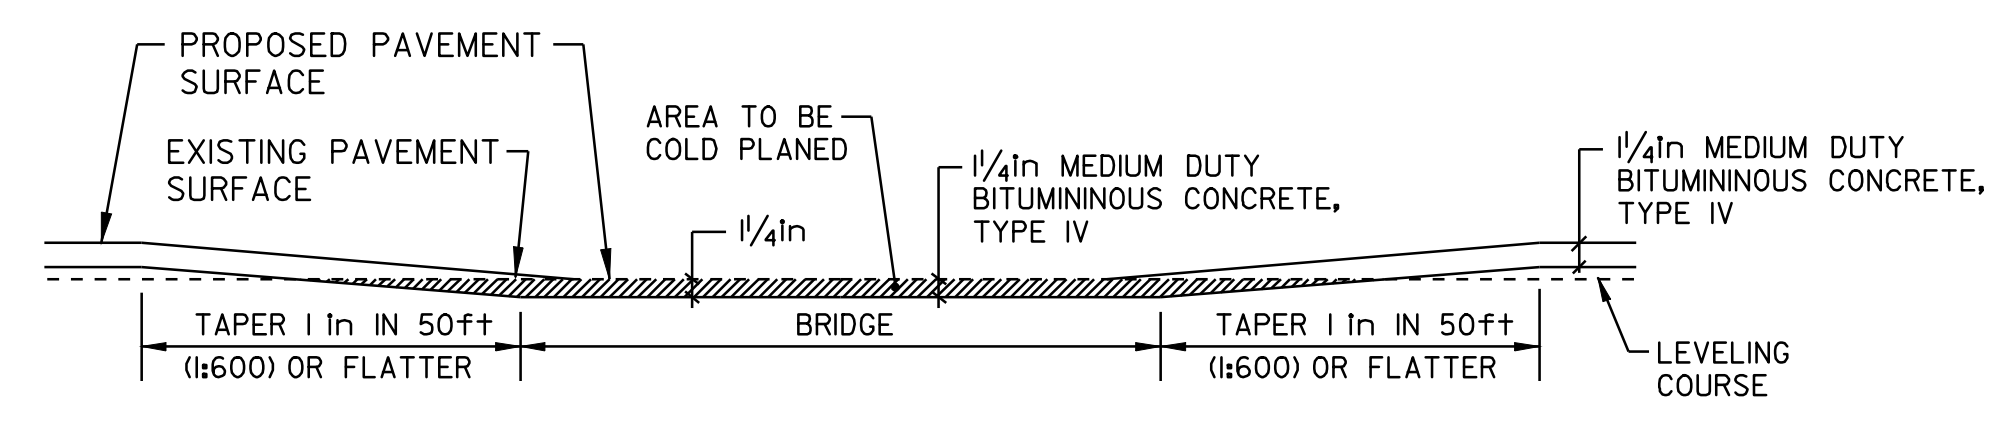


- COLD PLANING DETAIL @ BRIDGE -

BRUNSWICK
BRIDGE #6 - STA 137+15

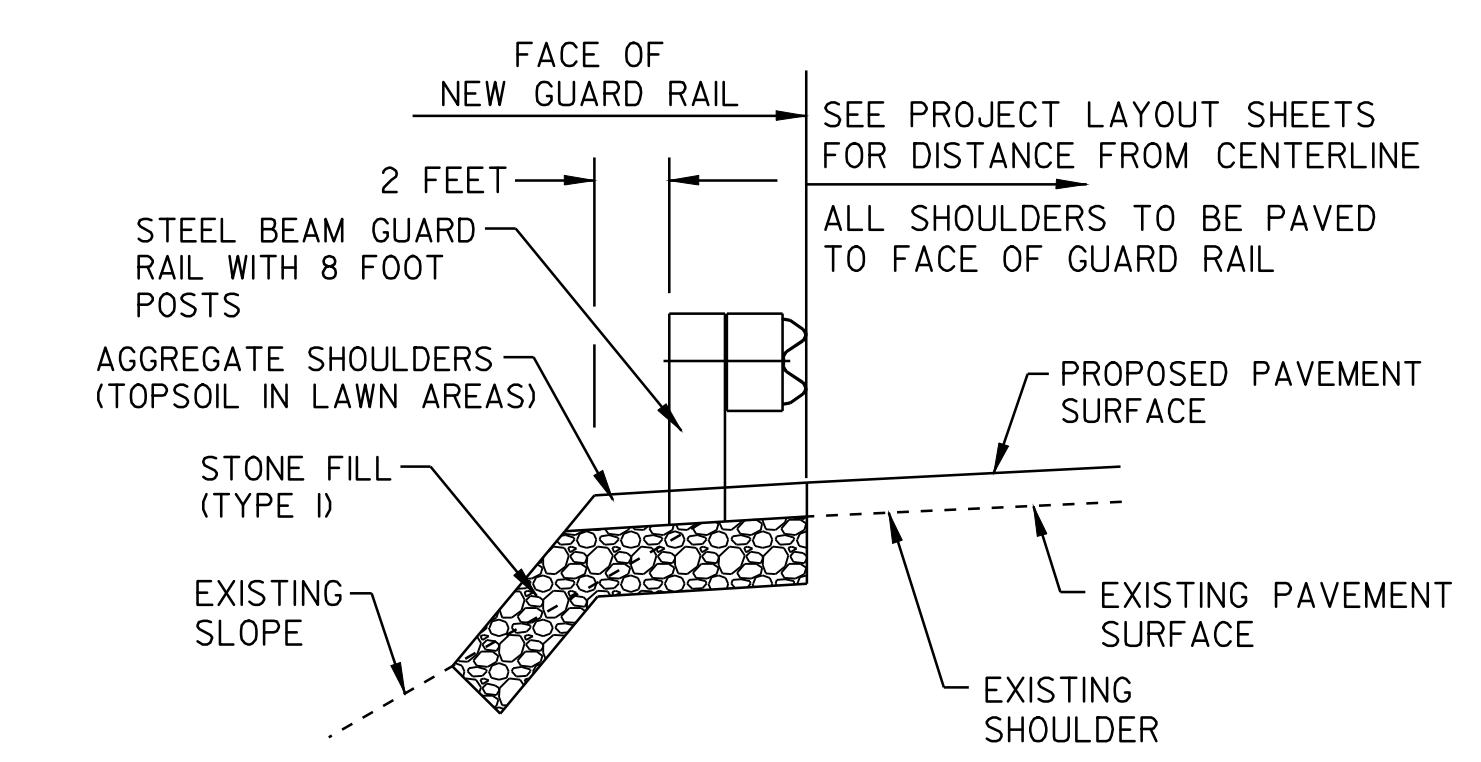

- WIDENING AT GUARD RAIL DETAIL -


MAIDSTONE
STA 297+80 TO 301+05 RT
STA 370+43 TO 371+80 RT
STA 408+30 TO 410+50 RT

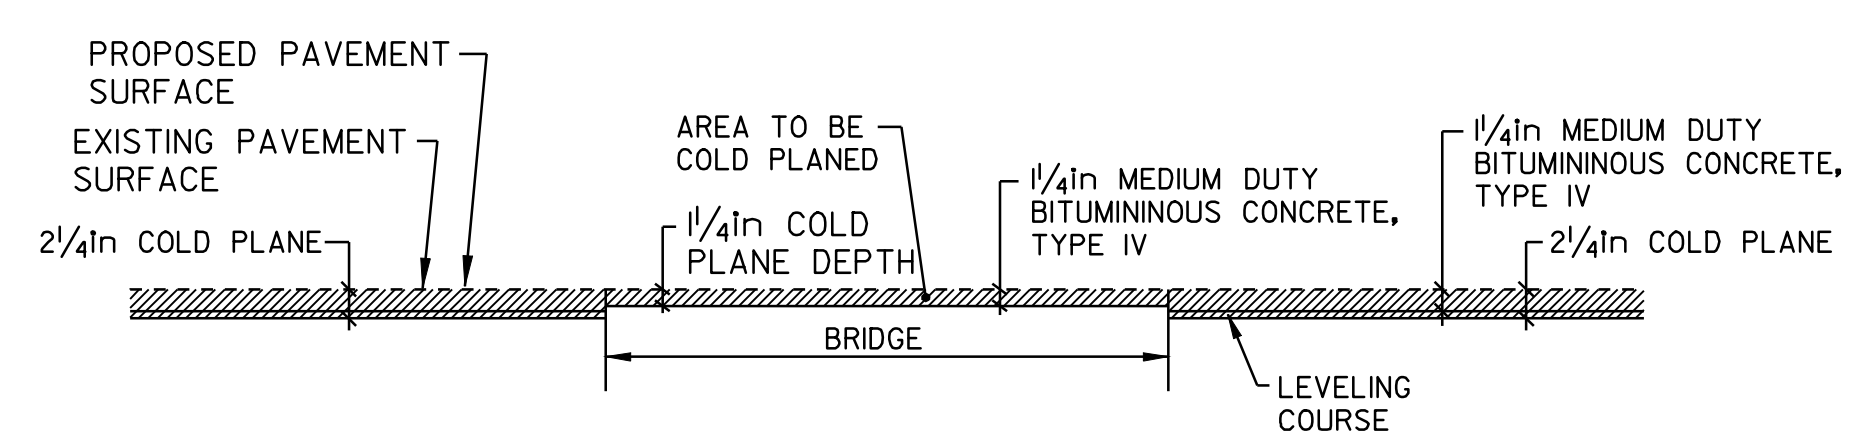

- COLD PLANING DETAIL @ BRIDGE -

BLOOMFIELD
BRIDGE #9 - STA 9+45


- NOTES:
- UNLESS OTHERWISE DIRECTED BY THE RESIDENT ENGINEER THIS TREATMENT WILL ONLY BE USED AT THE LOCATIONS INDICATED ABOVE. EVERY ATTEMPT SHALL BE MADE TO INSTALL THE FACE OF GUARD RAIL AT 15 FEET FROM CENTERLINE WITHOUT WIDENING WITH STONE FILL.
 - PAYMENT FOR ALL EXCAVATION TO PLACE THE STONE FILL, AS SHOWN IN THIS DETAIL, SHALL BE MADE UNDER THE APPROPRIATE EQUIPMENT RENTAL ITEMS. THE EXCAVATED MATERIAL SHALL BE SPREAD ON THE ADJACENT SLOPE OR HAULED AWAY AS DIRECTED BY THE RESIDENT ENGINEER.
 - PAYMENT FOR THE STONE FILL, TYPE I, SHALL BE MADE UNDER PAY ITEM 613.10. QUANTITIES OF THIS STONE FILL HAVE BEEN ESTIMATED FOR USE ON THIS PROJECT.

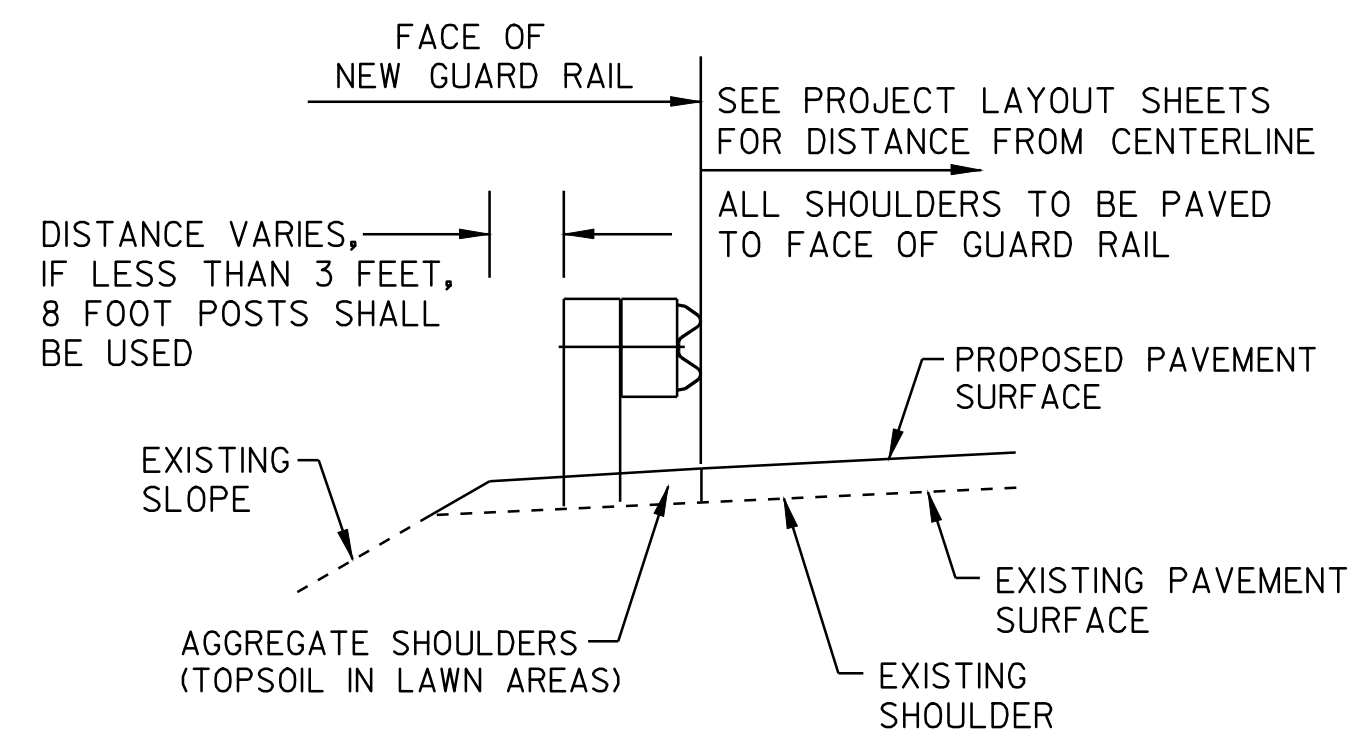

- TYPICAL SECTION AT GUARD RAIL -

THIS TREATMENT SHALL BE USED IN ALL GUARD RAIL LOCATIONS EXCEPT AS NOTED IN THE WIDENING AT GUARD RAIL DETAIL.

PROJECT TYPICAL SHEET #2	DESIGNED BY	BCE/PJM	DATE	8-06
	DRAWN BY	C.E.A., INC.	DATE	8-06
	DESIGN FILE NO.	06c042.dgn		
	PRF FILE	06c042+yp2.i	DATE PLOTTED	24-AUG-2009
	PROJ. NAME	MAIDSTONE - BLOOMFIELD		
PROJ. NO.	STP 2609(1)S			
SHEET	3	OF	40	SHEETS

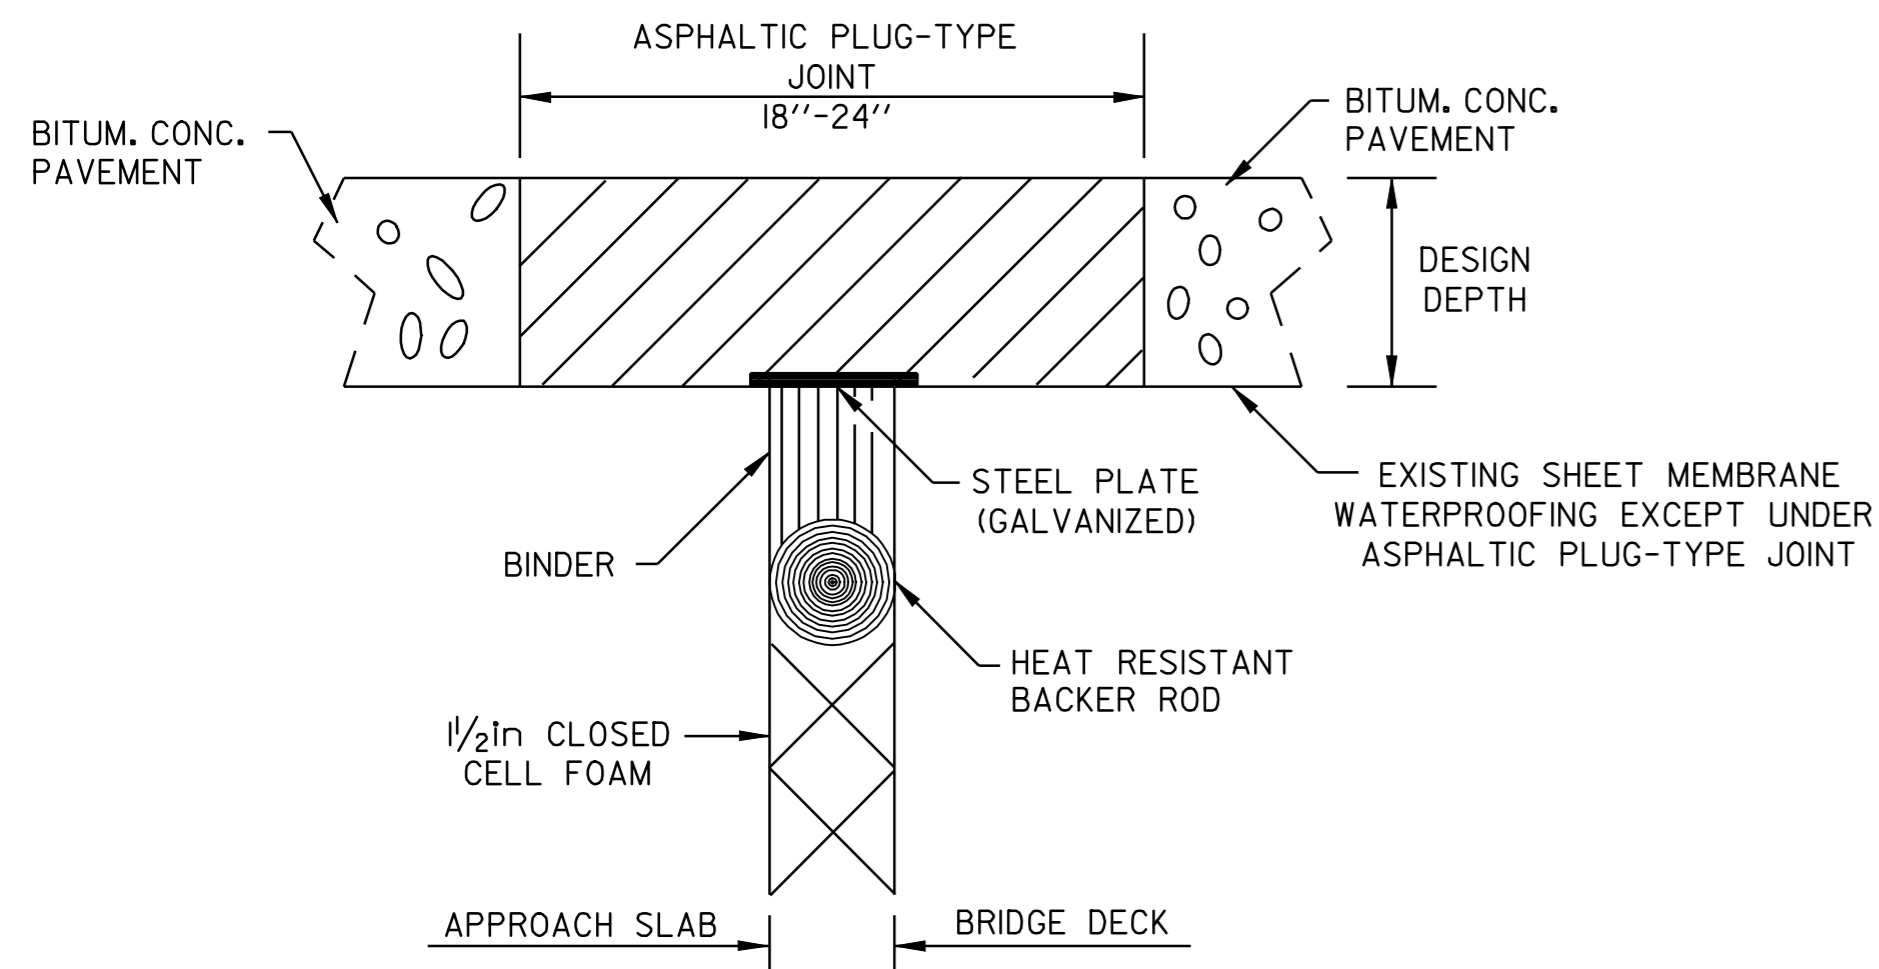

**- ASPHALTIC PLUG TYPE JOINT DETAIL -
LOCATION**

BRUNSWICK	BLOOMFIELD
BRIDGE #6 (20ft) - STA 136+65	BRIDGE #9 (20ft) - STA 8+65
BRIDGE #6 (20ft) - STA 137+00	BRIDGE #9 (20ft) - STA 10+00
BRIDGE #6 (20ft) - STA 137+35	
BRIDGE #6 (20ft) - STA 137+71	


**- ASPHALTIC PLUG BRIDGE JOINT -
GENERAL NOTES**

INSTALLATION:

1. THE JOINT SHALL BE LOCATED CENTRALLY OVER THE DECK EXPANSION GAP OR FIXED JOINT MARKED OUT TO THE MANUFACTURERS RECOMMENDED WIDTH.
2. THE JOINT SHALL BE EXCAVATED AS SHOWN ON THE PLANS BY USE OF SAWS AND PNEUMATIC HAMMER OR A HAMMER AND CHISEL.
3. THE JOINT SHALL BE BLAST CLEANED OF DEBRIS AND ASPHALT. THE JOINT AREA SHALL BE THOROUGHLY DRIED USING HOT COMPRESSED AIR PRIOR TO APPLYING BINDER MATERIAL.
4. SPALLED AND DEFECTIVE CONCRETE SHALL BE REPAIRED WITH AN APPROVED MATERIAL AS AGREED UPON BY THE RESIDENT ENGINEER.
5. PROPERLY SIZED HEAT RESISTANT BACKER ROD SHALL BE PLACED IN THE MOVEMENT GAP ALLOWING FOR 1 INCH +/- OF BINDER ABOVE THE ROD.
6. THE BINDER MATERIAL SHALL BE HEATED AND PLACED AS RECOMMENDED BY THE MANUFACTURER.
7. PLACE 1/4 INCH THICK BY 8 INCH WIDE SECTIONS OF STEEL PLATE OVER THE CENTER OF THE MOVEMENT GAP. SECURE PLATES FROM MOVING BY INSERTING LOCATING PINS THROUGH THE PRESTAMPED HOLES INTO THE BACKER ROD AND COVER WITH HOT BINDER.
 - a. THE STEEL PLATES MAY BE OMITTED WHERE THE APPROACH SLAB IS COVERED WITH A STONE BASE OR BITUMINOUS PAVEMENT, AND VERTICAL MOVEMENT OF THE PLATES MIGHT OCCUR.
8. THE BINDER MATERIAL AND AGGREGATE SHALL BE HEATED AND MIXED AS RECOMMENDED BY THE MANUFACTURER.
9. THE INSTALLATION OF MATERIAL, COMPACTION AND TOPCOATING SHALL BE AS RECOMMENDED BY THE MANUFACTURER.
10. IMMEDIATELY AFTER TOPCOATING, AN ANTI-SKID MATERIAL SHALL BE CAST OVER THE JOINT TO REDUCE THE RISK OF TRACKING.
- II. JOINT SHALL BE PROTECTED FROM TRAFFIC UNTIL THE MATERIAL HAS COOLED TO 125 DEGREES F +/-.

WEATHER LIMITATIONS:


- I. BINDER MATERIAL SHALL BE APPLIED ONLY WHEN THE FOLLOWING CONDITIONS PREVAIL:
 - a. THE AMBIENT AIR TEMPERATURE IS AT LEAST 50 DEGREES F AND RISING.
 - b. THE ROAD SURFACE IS SUFFICIENTLY DRY.
 - c. WEATHER CONDITIONS OR OTHER CONDITIONS ARE FAVORABLE AND ARE EXPECTED TO REMAIN SO FOR THE PERFORMANCE OF THE SATISFACTORY WORK.

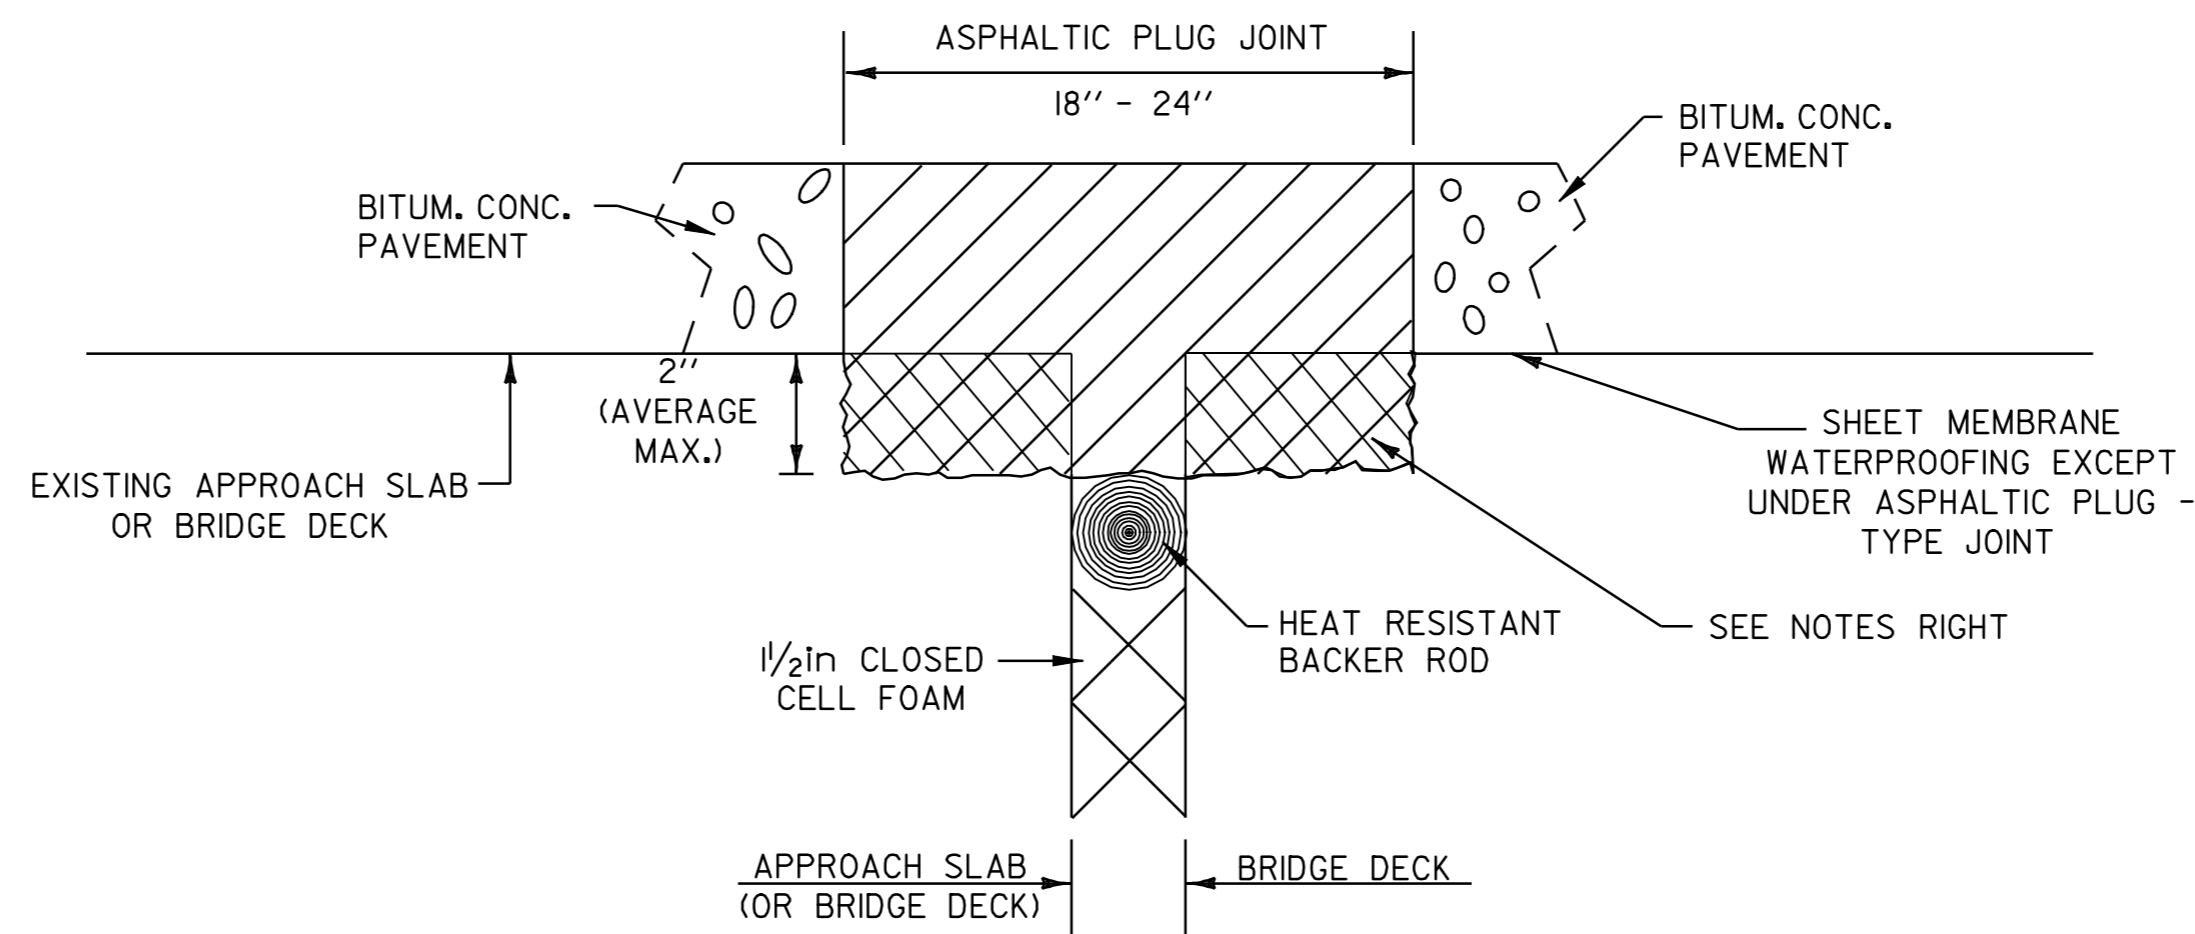

**ASPHALTIC PLUG-TYPE
JOINT DETAIL
REMOVAL OF UP TO
2" DETERIORATED CONCRETE**

NOTES:

1. UPON ENCOUNTERING UP TO 2" AVERAGE OF DETERIORATED CONCRETE, THE CONTRACTOR SHALL REMOVE THE DETERIORATED MATERIAL AND REPLACE IT WITH THE ASPHALTIC PLUG JOINT MATERIAL AS DIRECTED BY THE RESIDENT ENGINEER.
2. REMOVAL OF THE DETERIORATED CONCRETE WILL NOT BE PAID SEPARATELY BUT WILL BE CONSIDERED INCIDENTAL TO THE UNIT BID PRICE FOR THE ITEM 516.10. THE ADDITIONAL PLUG JOINT MATERIAL BELOW THE DESIGN DEPTH TO REPLACE THE DETERIORATED CONCRETE WILL BE CONSIDERED INCIDENTAL TO THE UNIT BID PRICE FOR THE ITEM 516.10.
3. THE STEEL PLATE IN THE ASPHALTIC PLUG JOINT MAY BE OMITTED ONLY IF THE REPAIRED SURFACE IS SO IRREGULAR IT WILL CAUSE VERTICAL MOVEMENT AND IT IS DIRECTED BY THE RESIDENT ENGINEER.

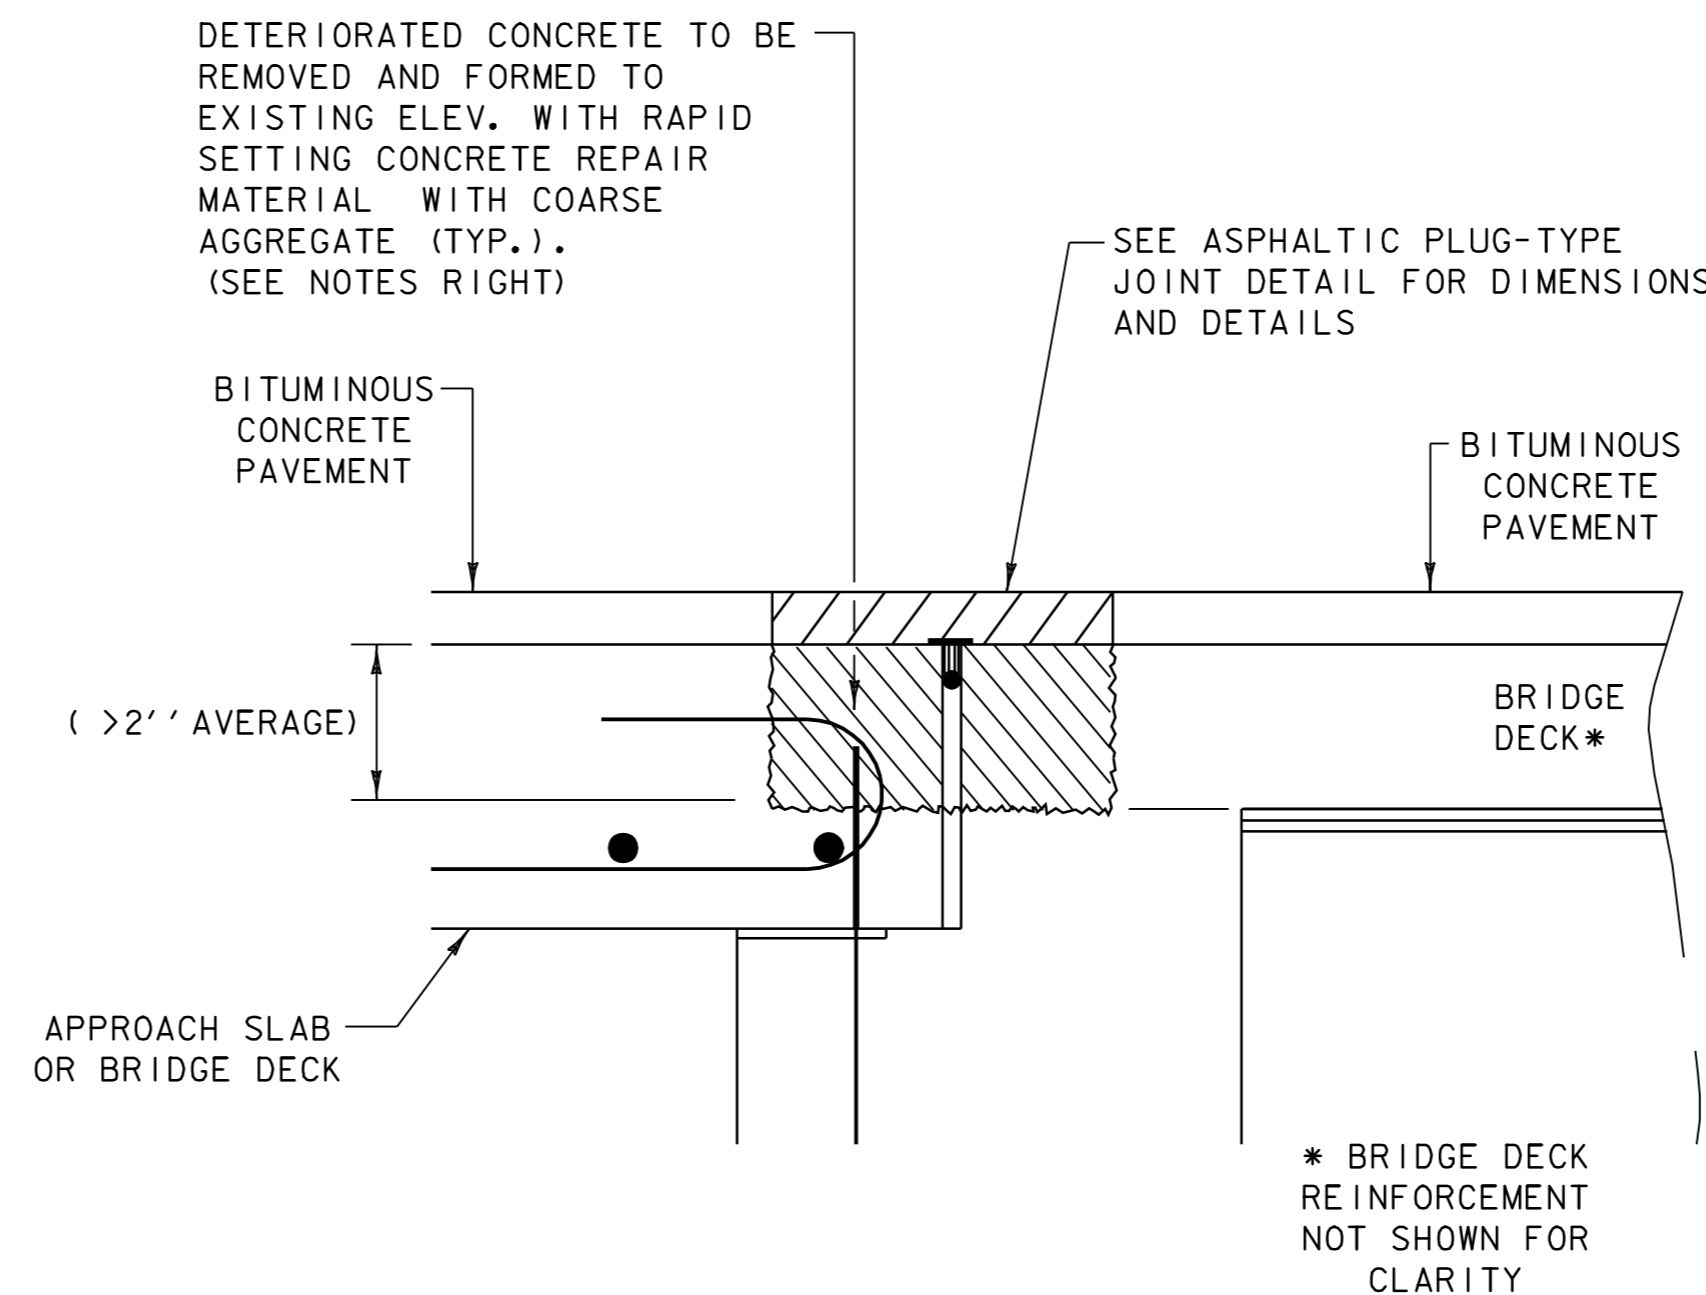

**ASPHALTIC PLUG-TYPE
JOINT DETAIL
REMOVAL OF >2"
DETERIORATED CONCRETE**

NOTES:

1. UPON ENCOUNTERING GREATER THAN 2" AVERAGE OF DETERIORATED CONCRETE, THE CONTRACTOR SHALL REMOVE THE DETERIORATED MATERIAL AND REPLACE IT WITH RAPID SETTING CONCRETE REPAIR MATERIAL WITH COARSE AGGREGATE.
2. REMOVAL OF THE DETERIORATED CONCRETE WILL BE INCLUDED IN THE UNIT BID PRICE FOR ITEM 580.20 "RAPID SETTING CONCRETE REPAIR MATERIAL WITH COARSE AGGREGATE".
3. THE STEEL PLATE IN THE ASPHALTIC PLUG JOINT MAY BE OMITTED ONLY IF THE REPAIRED SURFACE IS SO IRREGULAR IT WILL CAUSE VERTICAL MOVEMENT AND IT IS DIRECTED BY THE RESIDENT ENGINEER.

<h2>ASPHALTIC PLUG-TYPE JOINT DETAIL SHEET</h2>	DESIGNED BY	BCE/PJM	DATE	8-06
	DRAWN BY	C.E.A., INC.	DATE	8-06
	DESIGN FILE NO.	06c042.dgn		
	PRF FILE	06c042+typ3.1	DATE PLOTTED	24-AUG-2009
	PROJ. NAME	MAIDSTONE - BLOOMFIELD		
PROJ. NO.	STP 2609(1)S			
SHEET	4	OF	40	SHEETS

ITEM DETAIL SUMMARY SHEET 1

LOCATION			MISCELLANEOUS ITEMS										DRAINAGE ITEMS							GUARD RAIL ITEMS										REMARKS						
STA	STA	POS.	203.15	203.28	203.30	204.21	301.28	402.12		616.47	617.10	617.12		604.40	604.412	NEW PIPE			613.10	616.35	619.17	621.20	621.205	621.21	621.50	621.51		621.60	621.80		621.81	676.10				
			COM. EXCAV.	EXCAV. OF SURF. AND PAVE.	EARTH BORROW	TRENCH EXCAV. OF ROCK	SUBBASE OF CRUSHED GRAVEL, FINE	AGG. SHOULD.		B. CONC. GUTTER & TRAF. ISLAND	RELOCATE SINGLE SUPPORT	RELOCATE MULTIPLE SUPPORT		CHANGE ELEV.	REHAB. D.I. CLASS 1	DIA.	CSP (0.064)	RCP	CPEP	STONE FILL, TYPE I	TREATED TIMBER CURB	YIELD. MARKER POSTS	STEEL BEAM G.R.	STEEL BEAM G.R. 8" POSTS	HEAVY DUTY S.B. G.R.	MANUF. TERMINAL SECTION, FLARED	MANUF. TERMINAL SECTION, TANGENT		ANCHOR FOR S.B. RAIL		REMOVE & DISP. OF GUARD RAIL	REMOVE & DISP. OF GUIDE POSTS	DELIN. w/STEEL POSTS			
			CY	CY	CY	CY	TON	TON		TON	EA	EA		EA	EA	in	LF	LF	LF	CY	LF	EA	LF	LF	LF	EA	EA		EA	LF	EA	EA				
MAIDSTONE																																				
149+42	413+07	LT&RT			500		1,000	1,500											100		19															
			ESTIMATED QUANTITIES TO BE USED AS DIRECTED BY THE RESIDENT ENGINEER.																																	
232+85	237+59	RT			50			10														400							400		2					
			REPLACE CABLE RAIL WITH STEEL BEAM GUARD RAIL.																																	
238+05	238+30	RT																												3						
			REMOVE GUIDE POSTS.																																	
244+08	250+08	RT			50			10														412.5	112.5						600		2					
			REPLACE EXISTING STEEL BEAM GUARD RAIL.																																	
245+40		RT													1																					
			REHAB D. I.																																	
245+90	249+52	LT			50			10																287.5					362.5		2					
			REPLACE EXISTING STEEL BEAM GUARD RAIL.																																	
252+25	254+12	RT			50			10															112.5						187.5		2					
			REPLACE EXISTING STEEL BEAM GUARD RAIL.																																	
252+48	254+10	LT			50			10															87.5						162.5		2					
			REPLACE EXISTING STEEL BEAM GUARD RAIL.																																	
264+43	270+18	RT			50			10															225	275					550		2					
			REPLACE CABLE RAIL WITH STEEL BEAM GUARD RAIL.																																	
271+55	275+42	RT			50			10															37.5	275					350	3	2					
			REPLACE CABLE RAIL/GUIDE POSTS WITH STEEL BEAM GUARD RAIL.																																	
279+52	280+45	RT																												7						
			REMOVE GUIDE POSTS.																																	
281+65	287+77	RT			50			10																	537.5				500		2					
			REPLACE CABLE RAIL WITH STEEL BEAM GUARD RAIL.																																	
282+70	284+45	LT			50			10																100					135		2					
			REPLACE CABLE RAIL WITH STEEL BEAM GUARD RAIL.																																	
290+30		RT																																		
			RELOCATE SINGLE SUPPORT MAILBOX.																																	
290+92	292+80	RT			50			10												106		100				1	1		150	4	2					
			REPLACE CABLE RAIL/GUIDE POSTS WITH STEEL BEAM GUARD RAIL.																																	
291+31		RT													1																					
			REHAB D. I.																																	
293+12	295+25	RT			50			10																					190		2					
			REPLACE CABLE RAIL WITH STEEL BEAM GUARD RAIL.																																	
297+80	301+05	RT			50			10											75					250					5	2						
			REPLACE GUIDE POSTS WITH STEEL BEAM GUARD RAIL, TYPE I STONE FOR WIDENING AT SHOULDER.																																	
305+20	310+20	RT			50			10							15	30							462.5			1		2	450		2					
			REPLACE CABLE RAIL WITH STEEL BEAM GUARD RAIL. INSTALL BURIED END TERMINAL W/CULVERT @ 305+20.																																	
312+11	333+48	RT			50			10															337.5	1,725					2,050		2					
			REPLACE CABLE RAIL WITH STEEL BEAM GUARD RAIL.																																	
344+34	365+09	RT			50			10												25		1,937.5	100			1		2	1,900		2					
			REPLACE CABLE RAIL WITH STEEL BEAM GUARD RAIL, TYPE I STONE FOR EROSION @ STA 358+10 AND 358+65. BURIED END TERMINAL @ STA 344+34 RT.																																	
370+43	371+80	RT			50			10												30				50			1	1		6	2					
			REPLACE GUIDE POSTS WITH STEEL BEAM GUARD RAIL, TYPE I STONE FOR WIDENING AT SHOULDER.																																	
379+16	385+53	RT			50			10																	550			1	1		600	2				
			REPLACE CABLE RAIL WITH STEEL BEAM GUARD RAIL.																																	
386+70	387+27	RT																												3						
			REMOVE GUIDE POSTS.																																	
389+00	400+37	RT	10		50		10	10								15	40			25				1,100				2	1000		2					
			REPLACE CABLE RAIL WITH S.B.G.R., STONE FOR EROSION @ STA 398+85, B.E.T. W/CULVERT @ STA 400+37. REMOVE DI AND PIPE @ STA 397+46																																	
389+35	395+25	LT			50			10																600			1	1	535	4	2					
			REPLACE CABLE RAIL/G.P. WITH STEEL BEAM GUARD RAIL. INSTALL G1-D AND ANCHOR @ HALL RD.																																	
395+50	399+12	LT			50			10																62.5	300			1	400		2					
			REPLACE CABLE RAIL WITH STEEL BEAM GUARD RAIL. INSTALL G1-D AND ANCHOR @ HALL RD.																																	
408+30	0+74	RT			50			10																				1	415	7	2					
			REPLACE CABLE RAIL/GUIDE POSTS WITH STEEL BEAM GUARD RAIL, TYPE I STONE FOR WIDENING AT SHOULDER.																																	
BRUNSWICK																																				
0+00	373+83	LT&RT			500		100	2,100												100		8														
			ESTIMATED QUANTITIES TO BE USED AS DIRECTED BY THE RESIDENT ENGINEER.																																	
14+40	17+90	RT			50			10																					350		2					
			REPLACE EXISTING STEEL BEAM GUARD RAIL.																																	
20+35	21+35	RT			50			10																					100		2					
			REPLACE EXISTING STEEL BEAM GUARD RAIL.																																	

SHEET SUB-TOTALS	10		2,150		1,110	3,830			4	1			2	15	70			405	106	27	3,737.5	7,612.5		38	3		8	11,387.5	42	46
-------------------------	----	--	-------	--	-------	-------	--	--	---	---	--	--	---	----	----	--	--	-----	-----	----	---------	---------	--	----	---	--	---	----------	----	----

ITEM DETAIL SUMMARY SHEET #1

DESIGNED BY BCE/PJM DATE 12-06
 DRAWN BY C.E.A., INC. DATE 12-06
 DESIGN FILE NO. 06c042.dgn
 PRF FILE 06c0421d1 DATE PLOTTED 24-AUG-2009 0
 PROJ. NAME: **MAIDSTONE - BLOOMFIELD**
 PROJ. NO.: **STP 2609(1)S**
 SHEET **7** OF **40** SHEETS

ITEM DETAIL SUMMARY SHEET 2

LOCATION			MISCELLANEOUS ITEMS										DRAINAGE ITEMS								GUARD RAIL ITEMS										REMARKS		
STA	STA	POS.	203.15 COM. EXCAV.	203.28 EXCAV. OF SURF. AND PAVE.	203.30 EARTH BORROW	204.21 TRENCH EXCAV. OF ROCK	301.28 SUBBASE OF CRUSHED GRAVEL, FINE	402.12 AGG. SHOULD.		616.47 B. CONC. GUTTER & TRAF. ISLAND	617.10 RELOCATE MAILBOX SINGLE SUPPORT	617.12 RELOCATE MAILBOX MULTIPLE SUPPORT		604.40 CHANGE ELEV.	604.412 REHAB. D.I. CLASS 1	DIA.	NEW PIPE			613.10 STONE FILL, TYPE I	616.35 TREATED TIMBER CURB	619.17 YIELD. MARKER POSTS	621.20 STEEL BEAM G.R.	621.205 STEEL BEAM G.R. 8ft POSTS	621.21 HEAVY DUTY S.B. G.R.	621.50 MANUF. TERMINAL SECTION, FLARED	621.51 MANUF. TERMINAL SECTION, TANGENT		621.60 ANCHOR FOR S.B. RAIL	621.80 REMOVE & DISP. OF GUARD RAIL		621.81 REMOVE & DISP. OF GUIDE POSTS	676.10 DELIN. w/STEEL POSTS
BRUNSWICK	CONT' D		CY	CY	CY	CY	TON	TON		TON	EA	EA		EA	EA	in	LF	LF	LF	CY	LF	EA				EA	EA		EA	LF	EA	EA	
20+43	21+43	LT			50			10															25						100		2	REPLACE EXISTING STEEL BEAM GUARD RAIL.	
22+42	23+30	RT			50			10																12.5					87.5		2	REPLACE EXISTING STEEL BEAM GUARD RAIL.	
22+60	23+34	LT																										75				REMOVE EXISTING STEEL BEAM GUARD RAIL, EXTEND CULVERT.	
24+42	25+67	RT			50			10															50						125		2	REPLACE EXISTING STEEL BEAM GUARD RAIL.	
24+53	25+77	LT			50			10															87.5				2		112.5		2	REPLACE EXISTING STEEL BEAM GUARD RAIL. INSTALL BURIED END TERMINAL @ STA 25+77. MAINTAIN EXISTING 12' CSP CULVERT.	
26+31	29+06	RT			50			10			1													200					275		2	REPLACE EXISTING STEEL BEAM GUARD RAIL.	
29+43	36+43	RT			50			10															475	150					700		2	REPLACE EXISTING STEEL BEAM GUARD RAIL.	
35+18	36+68	LT			50			10															75						150		2	REPLACE EXISTING STEEL BEAM GUARD RAIL.	
47+46	65+24	RT			50			10		2										5	470		375	1,387.5			1		1,800		2	REPLACE EXISTING STEEL BEAM GUARD RAIL. REPLACE TREATED TIMBER CURB FROM STA 57+60 TO 62+30. OVERLAY EX. BIT. GUT. @ STA 62+30, STONE FILL @ OUTLET.	
66+01	69+38	LT			50			10															262.5						337.5		2	REPLACE EXISTING STEEL BEAM GUARD RAIL.	
66+88	78+50	RT			50			10																1,087.5					1,162.5		2	REPLACE EXISTING STEEL BEAM GUARD RAIL.	
73+80	77+05	LT			50			10																250					325		2	REPLACE EXISTING STEEL BEAM GUARD RAIL.	
84+25	86+00	RT			50			10															100						175		2	REPLACE EXISTING STEEL BEAM GUARD RAIL.	
85+53	88+78	LT			50			10																250					325		2	REPLACE EXISTING STEEL BEAM GUARD RAIL.	
94+92	98+17	RT			50			10															250						325		2	REPLACE EXISTING STEEL BEAM GUARD RAIL.	
102+42	114+42	RT			50			10																1,125					1,200		2	REPLACE EXISTING STEEL BEAM GUARD RAIL.	
115+64		LT	50	30			50	15																							12	CONSTRUCT 'T' INTERSECTION AT SFH, STA 115+64 LT.	
117+40	122+40	RT			50			10													5		425						500		2	REPLACE EXISTING STEEL BEAM GUARD RAIL. STONE FILL FOR EROSION @ STA 119+25.	
126+03	128+78	RT			50			10															200						275		2	REPLACE EXISTING STEEL BEAM GUARD RAIL.	
126+94	128+94	LT			50			10															125						200		2	REPLACE EXISTING STEEL BEAM GUARD RAIL.	
128+96	130+71	RT			50			10			1												100						175		2	REPLACE EXISTING STEEL BEAM GUARD RAIL.	
134+79	136+66	RT			25			5																125	41.3	1			187.5		1	ATTACH TO NEW BRIDGE RAIL @ STA 136+66, COORD. WITH SHEET 39.	
135+83	136+58	LT			25			5															12.5		32.5	1			75		1	ATTACH TO NEW BRIDGE RAIL @ STA 136+58, COORD. WITH SHEET 39.	
137+70	138+08	LT			25			5															12.5		32.5		1		37.5		1	ATTACH TO NEW BRIDGE RAIL @ STA 137+70, COORD. WITH SHEET 39.	
137+84	138+46	RT			25			5			1														32.5	1			50		1	ATTACH TO NEW BRIDGE RAIL @ STA 137+84, COORD. WITH SHEET 39.	
151+80	156+80	RT			50			10															425						500		2	REPLACE EXISTING STEEL BEAM GUARD RAIL.	
156+95		RT									1																						RELOCATE MAILBOX, SINGLE SUPPORT.
176+18	179+68	RT			50			10															275						350		2	REPLACE EXISTING STEEL BEAM GUARD RAIL.	
195+40	201+40	RT			50			10															362.5	162.5					600		2	REPLACE EXISTING STEEL BEAM GUARD RAIL.	
200+75	203+50	LT			50			10															200						275		2	REPLACE EXISTING STEEL BEAM GUARD RAIL.	
226+25	230+50	RT			50			10															350						325		2	REPLACE EXISTING STEEL BEAM GUARD RAIL.	
234+51	236+51	LT			50			10																162.5		1	2	200		2	REPLACE EXISTING STEEL BEAM GUARD RAIL. INSTALL BURIED END TERMINAL @ STA 236+51, MAINTAIN EXISTING 12' CSP CULVERT.		
234+75	237+50	RT			50			10																200					275		2	REPLACE EXISTING STEEL BEAM GUARD RAIL.	
238+90	242+40	RT			50			10															162.5	112.5					350		2	REPLACE EXISTING STEEL BEAM GUARD RAIL.	
250+90	254+15	RT			50			10															150	100					325		2	REPLACE EXISTING STEEL BEAM GUARD RAIL.	
250+95	252+70	LT			50			10															100						175		2	REPLACE EXISTING STEEL BEAM GUARD RAIL.	
SHEET SUB-TOTALS			50	30	1,550		50	325		2	4										10	470		4,600	5,325	138.8	58		6	12,150		74	

ITEM DETAIL SUMMARY SHEET #2

DESIGNED BY BCE/PJM DATE 12-06
 DRAWN BY C.E.A., INC. DATE 12-06
 DESIGN FILE NO. 06c042.dgn
 PRF FILE 06c0421d2.1 DATE PLOTTED 24-AUG-2009 0
 PROJ. NAME: **MAIDSTONE - BLOOMFIELD**
 PROJ. NO.: **STP 2609(1)S**
 SHEET **8** OF **40** SHEETS

ITEM DETAIL SUMMARY SHEET 3

LOCATION			MISCELLANEOUS ITEMS										DRAINAGE ITEMS								GUARD RAIL ITEMS										REMARKS	
STA	STA	POS.	203.15 COM. EXCAV.	203.28 EXCAV. OF SURF. AND PAVE.	203.30 EARTH BORROW	204.21 TRENCH EXCAV. OF ROCK	301.28 SUBBASE OF CRUSHED GRAVEL, FINE	402.12 AGG. SHOULD.	616.47 B. CONC. GUTTER & TRAF. ISLAND	617.10 RELOCATE MAILBOX SINGLE SUPPORT	617.12 RELOCATE MAILBOX MULTIPLE SUPPORT	604.40 CHANGE ELEV.	604.412 REHAB. D.I. CLASS 1	DIA.	CSP (0.064)	RCP	CPEP	613.10 STONE FILL, TYPE I	616.35 TREATED TIMBER CURB	619.17 YIELD. MARKER POSTS	621.20 STEEL BEAM G.R.	621.205 STEEL BEAM G.R. 8" POSTS	621.21 HEAVY DUTY S.B. G.R.	621.50 MANUF. TERMINAL SECTION, FLARED	621.51 MANUF. TERMINAL SECTION, TANGENT	621.60 ANCHOR FOR S.B. RAIL	621.80 REMOVE & DISP. OF GUARD RAIL	621.81 REMOVE & DISP. OF GUIDE POSTS	676.10 DELIN. w/STEEL POSTS			
BRUNSWICK CONT'D 257+27	262+27	RT	CY	CY	CY	CY	TON	TON				EA	EA	in	LF	LF	LF	CY	LF	EA	LF	LF	LF	EA	EA		EA	LF	EA	EA	REPLACE EXISTING STEEL BEAM GUARD RAIL.	
266+70	270+95	RT			50			10													350			2				425		2	REPLACE EXISTING STEEL BEAM GUARD RAIL.	
273+45	276+95	RT			50			10													275			2				350		2	REPLACE EXISTING STEEL BEAM GUARD RAIL.	
276+10	280+35	LT			50			10													350			2				425		2	REPLACE EXISTING STEEL BEAM GUARD RAIL.	
296+32	299+70	RT			50			10														262.5		2				337.5		2	REPLACE EXISTING STEEL BEAM GUARD RAIL.	
296+50	301+00	LT			50			10														375		2				450		2	REPLACE EXISTING STEEL BEAM GUARD RAIL.	
305+40	309+27	RT			50			10														312.5		2				387.5		2	REPLACE EXISTING STEEL BEAM GUARD RAIL.	
305+90	310+65	LT			50			10														400		2				475		2	REPLACE EXISTING STEEL BEAM GUARD RAIL.	
346+65	351+65	RT			50			10														175	250	2				500		2	REPLACE EXISTING STEEL BEAM GUARD RAIL.	
353+78	357+15	RT			50			10														262.5		2				337.5		2	REPLACE EXISTING STEEL BEAM GUARD RAIL.	
355+08	357+08	LT			50			10														125		2				200		2	REPLACE EXISTING STEEL BEAM GUARD RAIL.	
359+50	363+88	LT			50			10														362.5		2				437.5		2	REPLACE EXISTING STEEL BEAM GUARD RAIL.	
360+02		RT								1																					RELOCATE MAILBOX, SINGLE SUPPORT.	
360+05	364+67	RT			50			10														387.5		2				462.5		2	REPLACE EXISTING STEEL BEAM GUARD RAIL.	
BRUNS. 371+62	BL00M. 4+37	RT			50			10											475				612.5		2			687.5		2	REPLACE EXISTING STEEL BEAM GUARD RAIL.	
BRUNS. 372+36	BL00M. 3+14	LT			50			10											355				437.5		2			512.5		2	REPLACE EXISTING STEEL BEAM GUARD RAIL.	
BLOOMFIELD 0+00	26+75	LT&RT					50	150																							ESTIMATED QUANTITIES TO BE USED AS DIRECTED BY THE RESIDENT ENGINEER.	
7+78	8+65	RT			25			5													25		32.5	1			87.5		1	ATTACHED TO EXISTING BRIDGE RAIL @ STA 8+65, COORD. WITH SHEET 38.		
8+50	8+65	LT			25			5															45			1	37.5		1	ATTACHED TO EXISTING BRIDGE RAIL @ STA 8+65, COORD. WITH SHEET 38.		
10+00	10+75	RT			25			5													12.5		32.5	1			75		1	ATTACHED TO EXISTING BRIDGE RAIL @ STA 10+00, COORD. WITH SHEET 38.		
10+00	11+37	LT			25			5													75		32.5	1			137.5		1	ATTACHED TO EXISTING BRIDGE RAIL @ STA 10+00, COORD. WITH SHEET 38.		
15+43		LT											1																		REHAB D. I.	
15+48		RT											1																		REHAB D. I.	
15+95		RT											1																		REHAB D. I.	
15+98		LT											1																		REHAB D. I.	
15+95	16+63	RT	2						4																						REPLACE EXISTING BITUMINOUS CONCRETE GUTTER.	
15+98	16+80	LT	2						4																						REPLACE EXISTING BITUMINOUS CONCRETE GUTTER.	
17+06		RT										1																			ADJUST ELEVATION OF D. I.	
18+30		RT										1																			ADJUST ELEVATION OF D. I.	
PROJECT LIMITS						50								15	100																ESTIMATED QUANTITIES TO BE USED AS DIRECTED BY THE RESIDENT ENGINEER.	
														18	100	100																
														24	50	50																
														36	50																	
														42	12																	
SHEET SUB-TOTALS			4	--	850	50	50	320	8	1	--	2	4	* SEE BELOW *			--	830	--	1,487.5	3,987.5	142.5	33	--		1	6,825	--	34			
ID#1 SUB-TOTALS			10	--	2,150	--	1,110	3,830	--	4	1	--	2				405	106	27	3,737.5	7,612.5	--	38	3	8	11,387.5	42	46				
ID#2 SUB-TOTALS			50	30	1,550	--	50	325	2	4	--	--	--				10	470	--	4,600	5,325	138.8	58	--	6	12,150	--	74				
PROJECT SUB-TOTALS			64	30	4,550	50	1,210	4,475	10	9	1	2	6				415	1,406	27	9,825	16,925	281.3	129	3	15	30,362.5	42	154				
ROUNDING			1	--	--	--	--	--	--	--	--	--	--				5	14	--	75	175	18.7	--	--	--	137.5	--	--				
PROJECT TOTALS			65	30	4,550	50	1,210	4,475	10	9	1	2	6				420	1,420	27	9,900	17,100	300	129	3	15	30,500	42	154				

ITEM DETAIL SUMMARY SHEET #3

DESIGNED BY BCE/PJM DATE 12-06

DRAWN BY C.E.A., INC. DATE 12-06

DESIGN FILE NO. 06c042.dgn

PRF FILE 06c0421d3.1 DATE PLOTTED 24-AUG-2009 0


PROJ. NAME: **MAIDSTONE - BLOOMFIELD**

PROJ. NO.: **STP 2609(1)S**

SHEET **9** OF **40** SHEETS

LOCATION				FEET OF DITCHING				MISC. ITEMS			REMARKS
SITE	STATION	STATION	POS.	PERCENT GRADE				653.20	613.10	649.31	
				0-1	1-2.5	2.5-10	>10	TEMP. EROS. MATT.	STONE FILL TYP. I	GEOT. UNDER STONE FILL	
VT ROUTE 102, MAIDSTONE DISTRICT #7								SY	CY	SY	
1	149+42	150+23	LT		81			36			
2	152+27	157+50	LT		523			232			
3	161+00	170+75	LT	325	375	275		167	41	183	
4	175+75	187+00	LT	375	125	625		56	92	417	
5	193+50	196+50	RT			300			44	200	
6	204+00	213+65	LT	665	300			133			
7	216+30	218+30	LT		200			89			
8	306+00	316+00	LT			1,000			148	667	
9	333+50	344+00	LT	750	300			133			
10	346+00	361+00	LT	400	700	400		311	59	267	
11	362+50	368+25	LT	75	150	350		67	52	233	
12	369+00	378+00	LT		200	700		89	104	467	
VT ROUTE 102, BRUNSWICK DISTRICT #9											
13	0+30	3+25	LT		295			131			
14	38+50	48+75	LT	1,025							
15	56+50	64+00	LT	750							
16	70+75	72+80	LT	205							
17	103+00	105+00	LT			200			30	133	
18	150+00	152+00	LT	200							
19	157+25	158+75	LT	150							
20	191+00	199+00	LT		200	600		89	89	400	
21	203+50	205+20	LT			170			25	113	
22	210+00	212+25	LT	225							
23	217+50	220+00	LT		250				111		
24	225+75	231+50	LT		575				256		
25	232+75	234+40	RT	165							
26	237+00	250+75	LT	1,075	300				133		
27	256+50	259+00	LT			250			37	167	
28	265+00	273+40	LT	840							
29	328+75	330+00	LT		125				56		
30	332+00	335+00	LT	300							
31	339+60	342+50	RT			290			43	193	
PROJECT SUBTOTALS				7,525	4,699	5,160		2,089	764	3,440	
ROUNDING				225	101	140		11	16	160	
PROJECT TOTALS				7,750	4,800	5,300		2,100	780	3,600	

LOCATION				FEET OF DITCHING				MISC. ITEMS			REMARKS
SITE	STATION	STATION	POS.	PERCENT GRADE				653.20	613.10	649.31	
				0-1	1-2.5	2.5-10	>10	TEMP. EROS. MATT.	STONE FILL TYP. I	GEOT. UNDER STONE FILL	

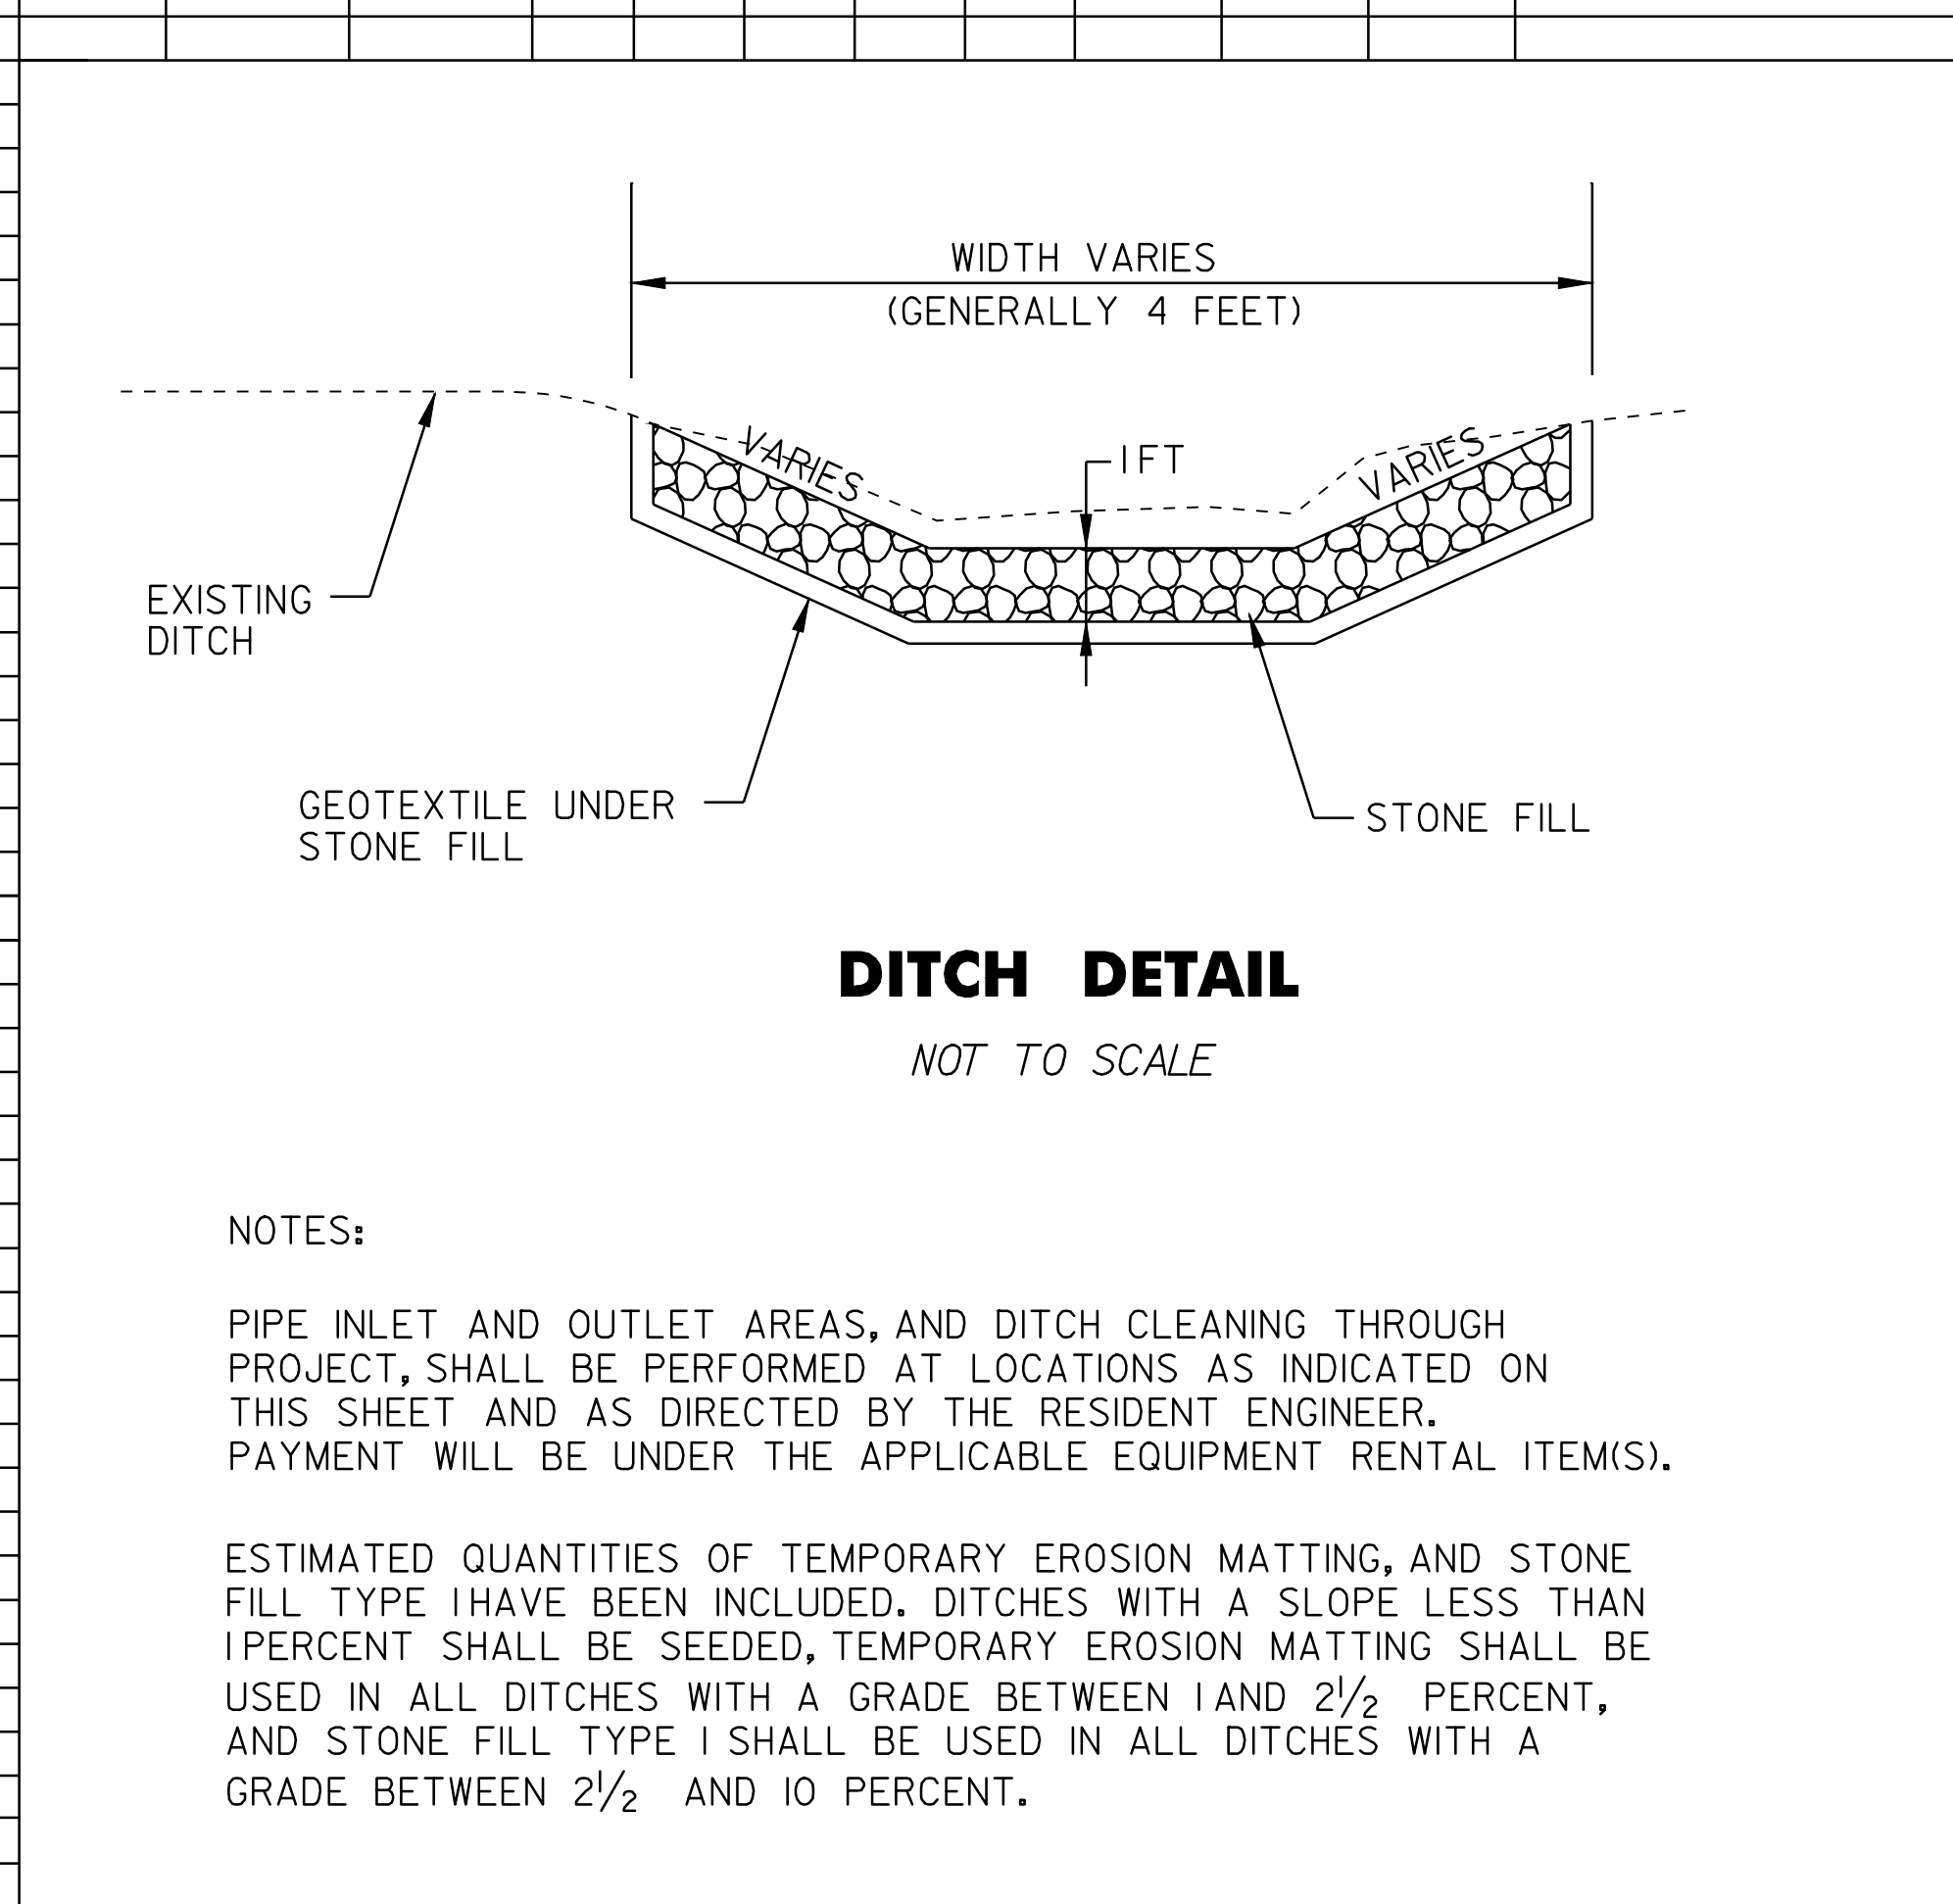


DITCH CLEANING DETAIL SHEET	PROJECT : MAIDSTONE - BLOOMFIELD	PROJECT NO. : STP 2609(1)S
	DESIGN FILE NAME: 06c042.dgn	
	IPARM FILE NAME: 06c042d1t-1	PLOT DATE: 24-AUG-2009
	SURVEYED BY: BCE/PJM	SURVEY DATE: 9-06
	SQUAD LEADER: BCE	DRAWN BY: C.E.A., INC.
		SHEET: 10 OF 40

TEMPORARY 4in YELLOW LINE (PAINT)
 DURABLE 4in YELLOW LINE (THERMOPLASTIC)
 STA 149+42 TO 174+00 SOLID LT&RT

TEMPORARY 4in WHITE LINE (PAINT)
 DURABLE 4in WHITE LINE (THERMOPLASTIC)
 STA 149+42 TO 174+00 SOLID LT&RT

YIELDING MARKER POST
 STA 150+23 LT&RT
 STA 152+27 LT&RT

DITCHING LOCATIONS (REFER TO SHEET 10 FOR DETAILS)
 STA 149+42 TO 150+23 LT
 STA 152+27 TO 157+50 LT
 STA 161+00 TO 170+75 LT

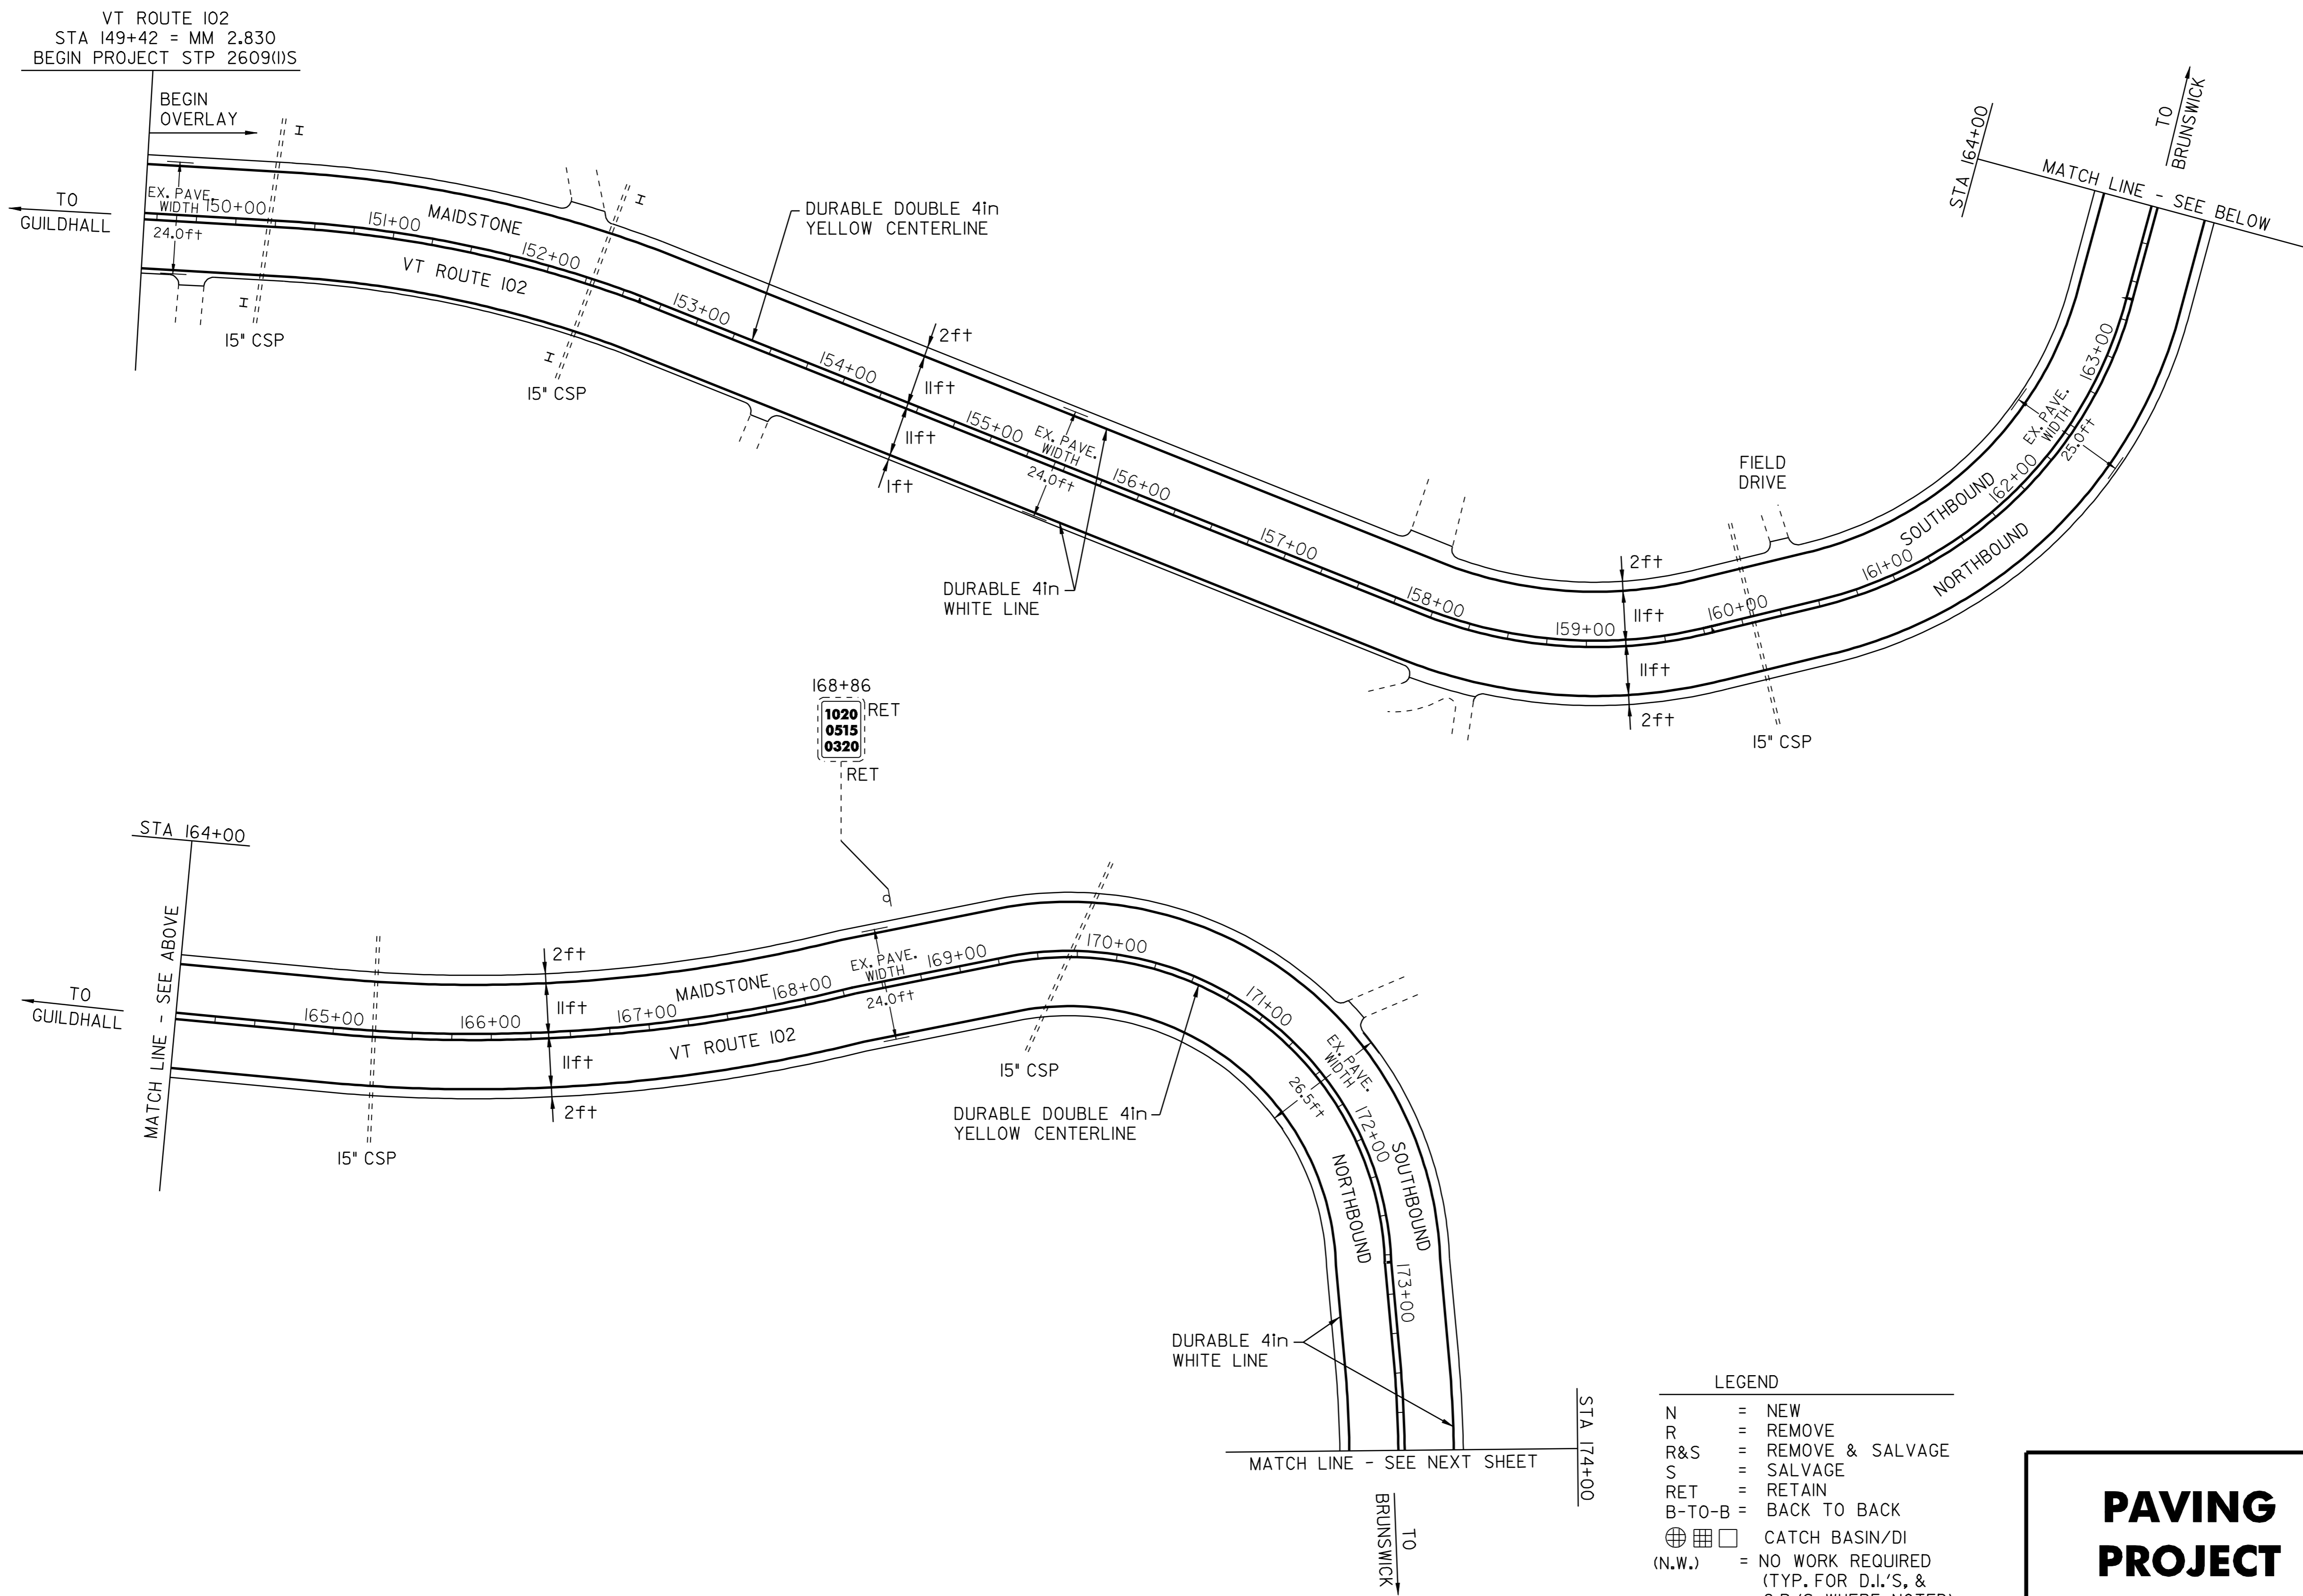

LEGEND

N	= NEW
R	= REMOVE
R&S	= REMOVE & SALVAGE
S	= SALVAGE
RET	= RETAIN
B-TO-B	= BACK TO BACK
⊕	= CATCH BASIN/DI
(N.W.)	= NO WORK REQUIRED (TYP. FOR D.I.'S, & C.B.'S WHERE NOTED)
I	= YIELDING MARKER POST
⊗	= UTILITY POLE
---	= DRIVE



PAVING PROJECT LAYOUT SHEET #1

DESIGNED BY	BCE/PJM	DATE	10-06
DRAWN BY	C.E.A., INC.	DATE	10-06
DESIGN FILE NO.	06c042.dgn		
PRF FILE	06c042p01.i	DATE PLOTTED	24-AUG-2009
PROJ. NAME	MAIDSTONE - BLOOMFIELD		
PROJ. NO.	STP 2609(1)S		
SHEET	11	OF	40 SHEETS

TEMPORARY 4in YELLOW LINE (PAINT)
 DURABLE 4in YELLOW LINE (THERMOPLASTIC)
 STA 174+00 TO 204+00 SOLID LT&RT

TEMPORARY 4in WHITE LINE (PAINT)
 DURABLE 4in WHITE LINE (THERMOPLASTIC)
 STA 174+00 TO 204+00 SOLID LT&RT

DITCHING LOCATIONS (REFER TO SHEET 10 FOR DETAILS)
 STA 175+75 TO 187+00 LT
 STA 193+50 TO 196+50 RT

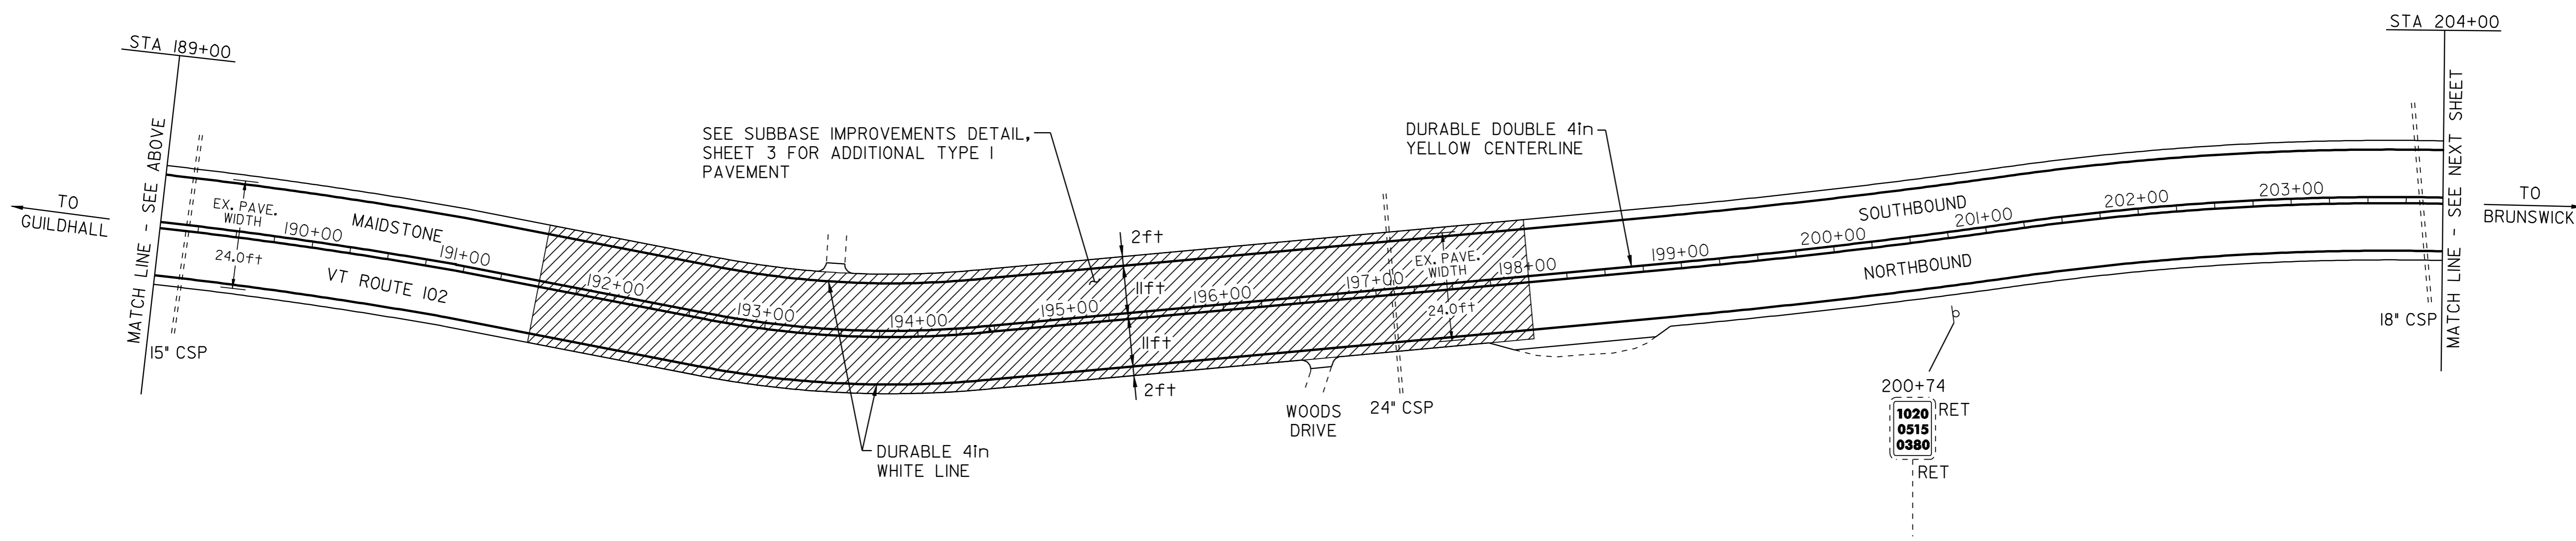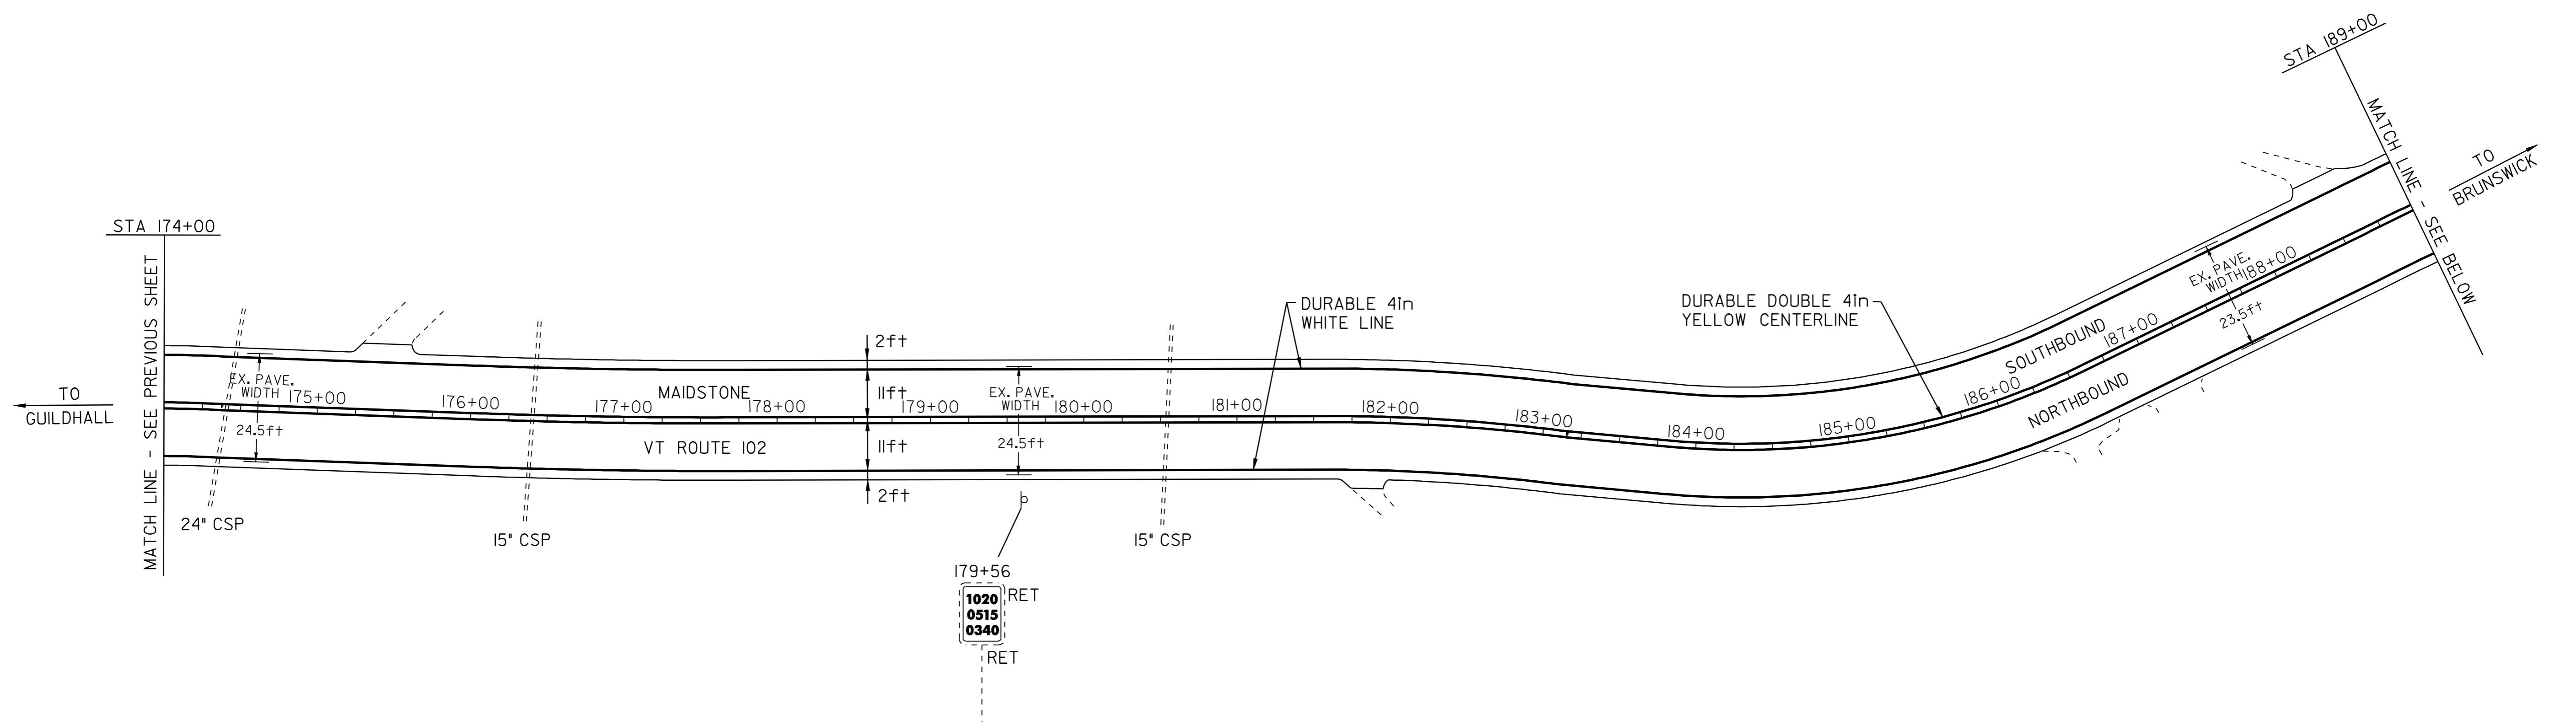

LEGEND

N	=	NEW
R	=	REMOVE
R&S	=	REMOVE & SALVAGE
S	=	SALVAGE
RET	=	RETAIN
B-TO-B	=	BACK TO BACK
⊕ □	=	CATCH BASIN/DI
(N.W.)	=	NO WORK REQUIRED (TYP. FOR D.I.'S, & C.B.'S WHERE NOTED)
I	=	YIELDING MARKER POST
⊕	=	UTILITY POLE
---	=	DRIVE

PAVING PROJECT LAYOUT SHEET #2


DESIGNED BY	BCE/PJM	DATE	10-06
DRAWN BY	C.E.A., INC.	DATE	10-06
DESIGN FILE NO.	06c042.dgn		
PRF FILE	06c042p02.i	DATE PLOTTED	24-AUG-2009
PROJ. NAME	MAIDSTONE - BLOOMFIELD		
PROJ. NO.	STP 2609(1)S		
SHEET	12	OF	40 SHEETS

TEMPORARY 4in YELLOW LINE (PAINT)
 DURABLE 4in YELLOW LINE (THERMOPLASTIC)
 STA 204+00 TO 235+00 SOLID LT&R

TEMPORARY 4in WHITE LINE (PAINT)
 DURABLE 4in WHITE LINE (THERMOPLASTIC)
 STA 204+00 TO 235+00 SOLID LT&R

YIELDING MARKER POST
 STA 219+69 LT
 STA 227+50 LT

DITCHING LOCATIONS (REFER TO SHEET 10 FOR DETAILS)
 STA 204+00 TO 213+65 LT
 STA 216+30 TO 218+30 LT

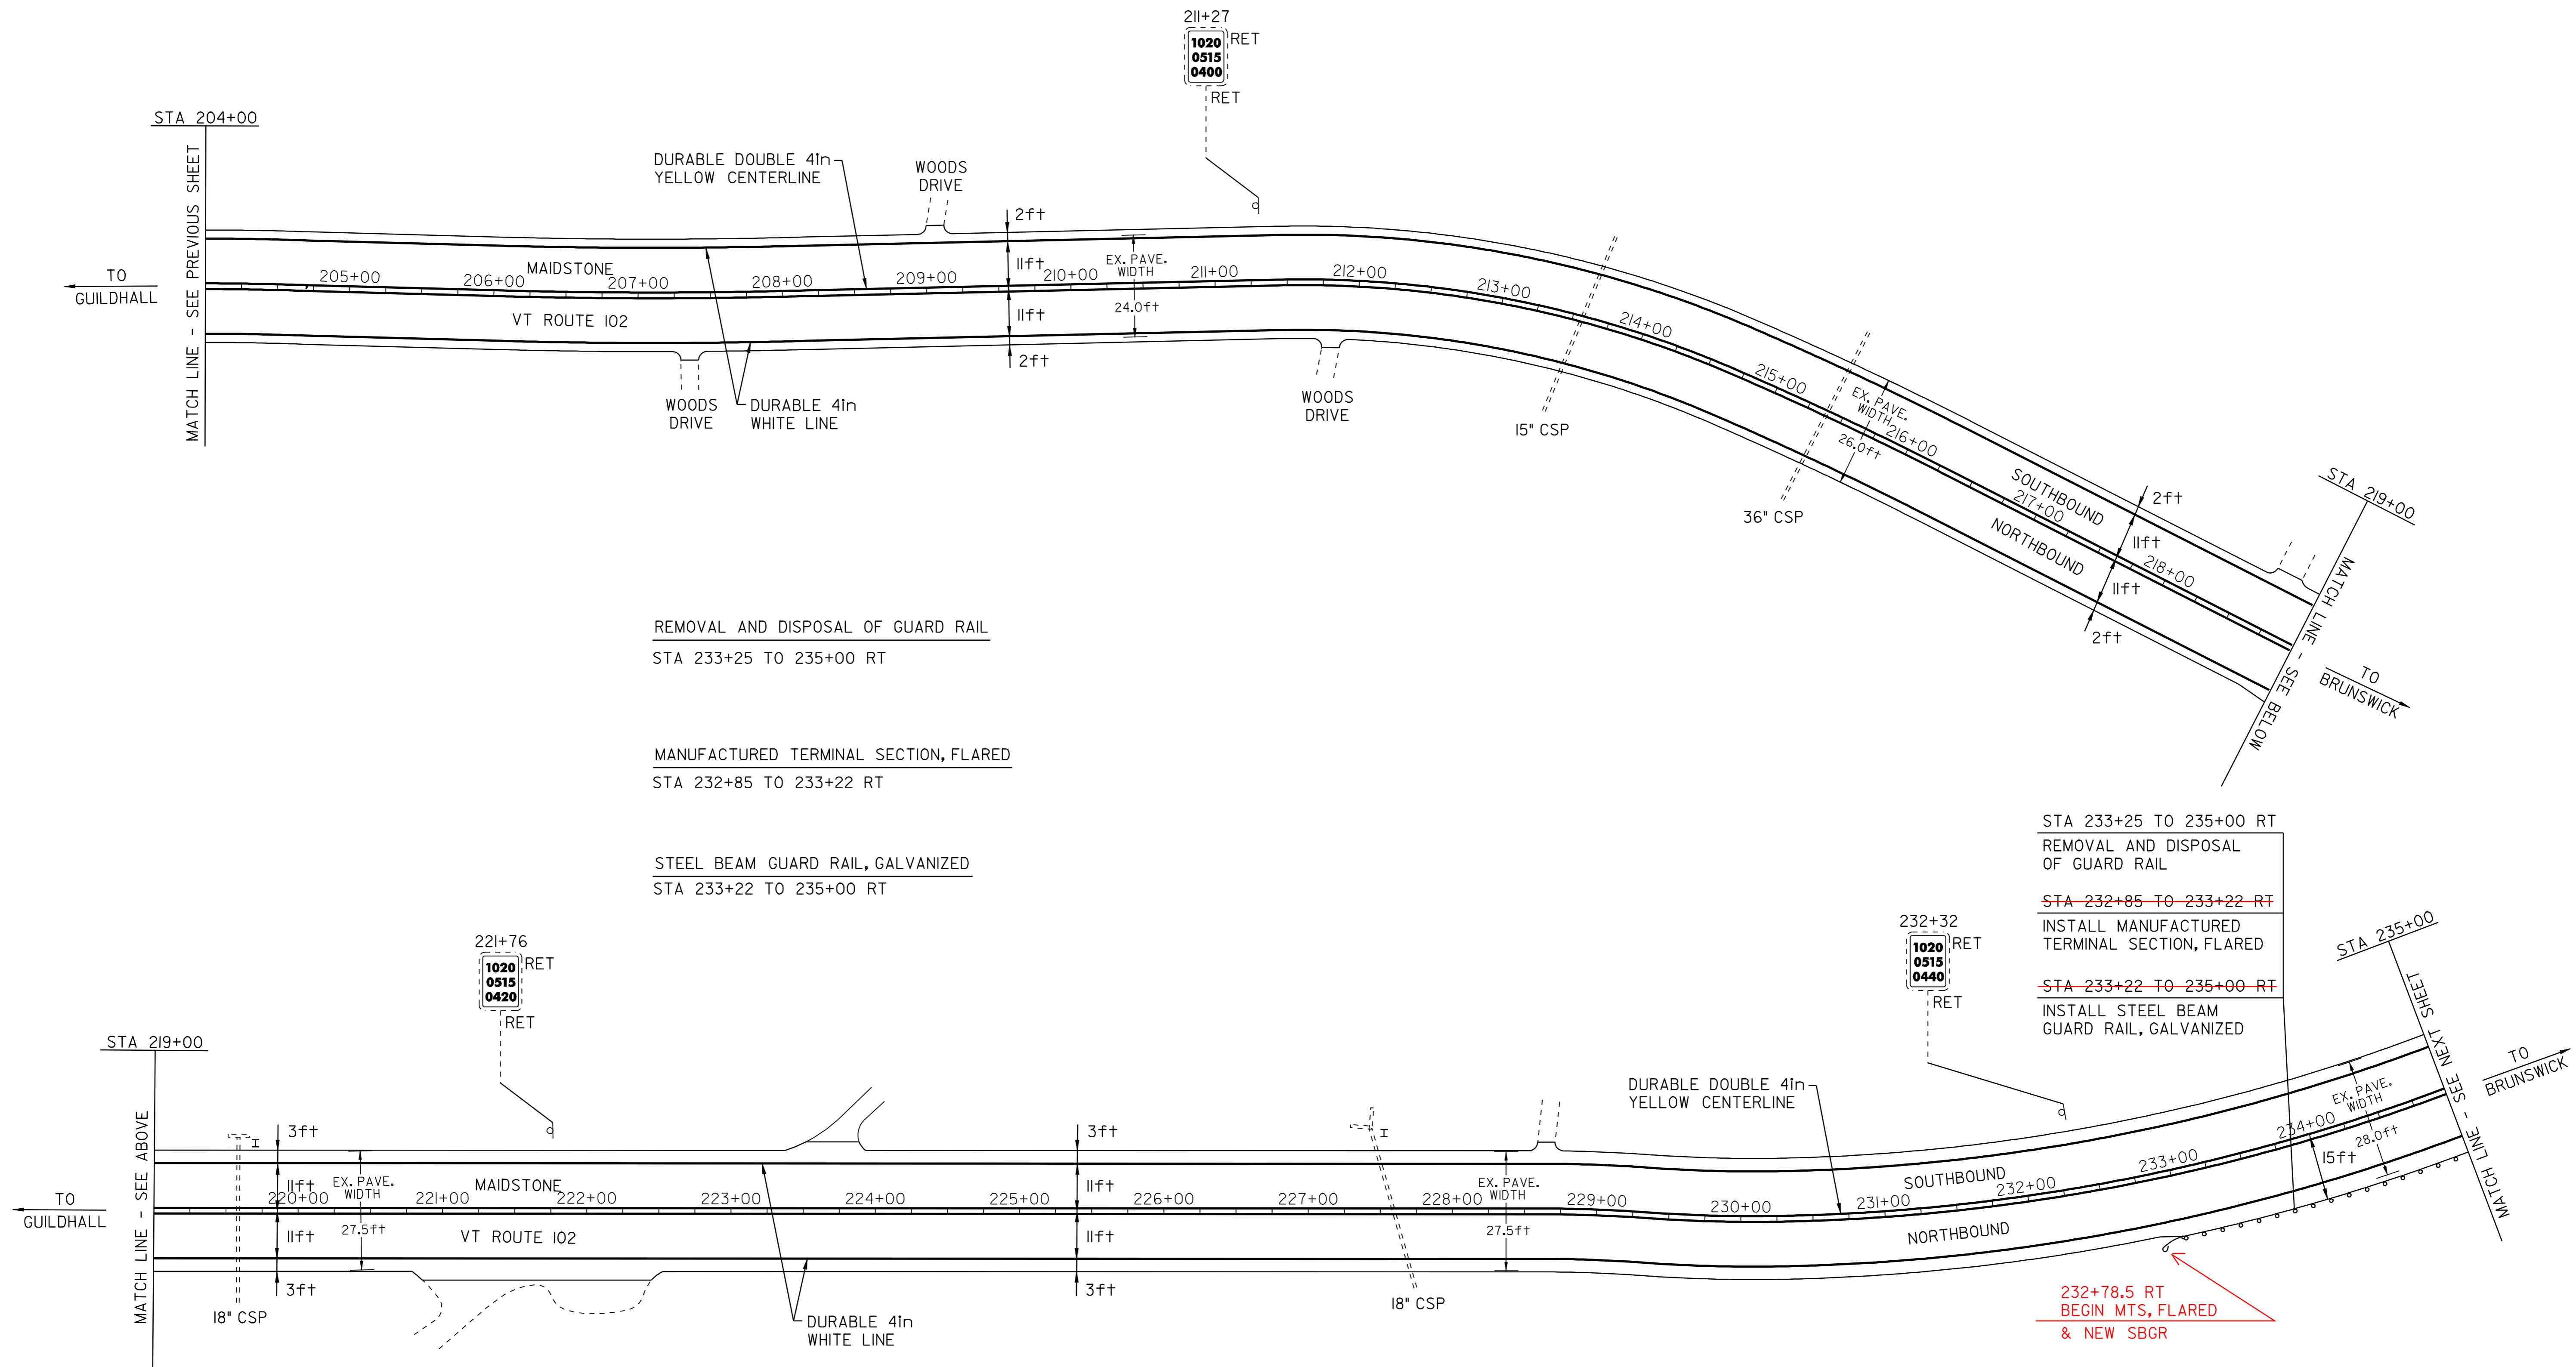

REMOVAL AND DISPOSAL OF GUARD RAIL
 STA 233+25 TO 235+00 RT

MANUFACTURED TERMINAL SECTION, FLARED
 STA 232+85 TO 233+22 RT

STEEL BEAM GUARD RAIL, GALVANIZED
 STA 233+22 TO 235+00 RT

STA 233+25 TO 235+00 RT
 REMOVAL AND DISPOSAL OF GUARD RAIL

STA 232+85 TO 233+22 RT
 INSTALL MANUFACTURED TERMINAL SECTION, FLARED

STA 233+22 TO 235+00 RT
 INSTALL STEEL BEAM GUARD RAIL, GALVANIZED

- LEGEND
- N = NEW
 - R = REMOVE
 - R&S = REMOVE & SALVAGE
 - S = SALVAGE
 - RET = RETAIN
 - B-TO-B = BACK TO BACK
 - ⊕ ⊞ □ CATCH BASIN/DI (N.W.) = NO WORK REQUIRED (TYP. FOR D.I.'S, & C.B.'S WHERE NOTED)
 - I YIELDING MARKER POST
 - ⊕ UTILITY POLE
 - DRIVE

PAVING PROJECT LAYOUT SHEET #3

DESIGNED BY	BCE/PJM	DATE	10-06
DRAWN BY	C.E.A., INC.	DATE	10-06
DESIGN FILE NO.	06c042.dgn		
PRF FILE	06c042p03.1	DATE PLOTTED	24-AUG-2009
PROJ. NAME	MAIDSTONE - BLOOMFIELD		
PROJ. NO.	STP 2609(1)S		
SHEET	13	OF	40 SHEETS

TEMPORARY 4in YELLOW LINE (PAINT)
DURABLE 4in YELLOW LINE (THERMOPLASTIC)

STA 235+00 TO 248+69 SOLID LT&RT
STA 248+69 TO 256+87 SOLID LT & DASHED RT
STA 256+87 TO 262+94 DASHED
STA 262+94 TO 265+00 DASHED LT & SOLID RT

TEMPORARY 4in WHITE LINE (PAINT)
DURABLE 4in WHITE LINE (THERMOPLASTIC)


STA 235+00 TO 265+00 SOLID LT&RT

YIELDING MARKER POST

STA 238+15 LT&RT
STA 258+79 LT
STA 263+07 LT

REHABILITATION OF D.I., C.B., OR M.H.

STA 245+40 RT

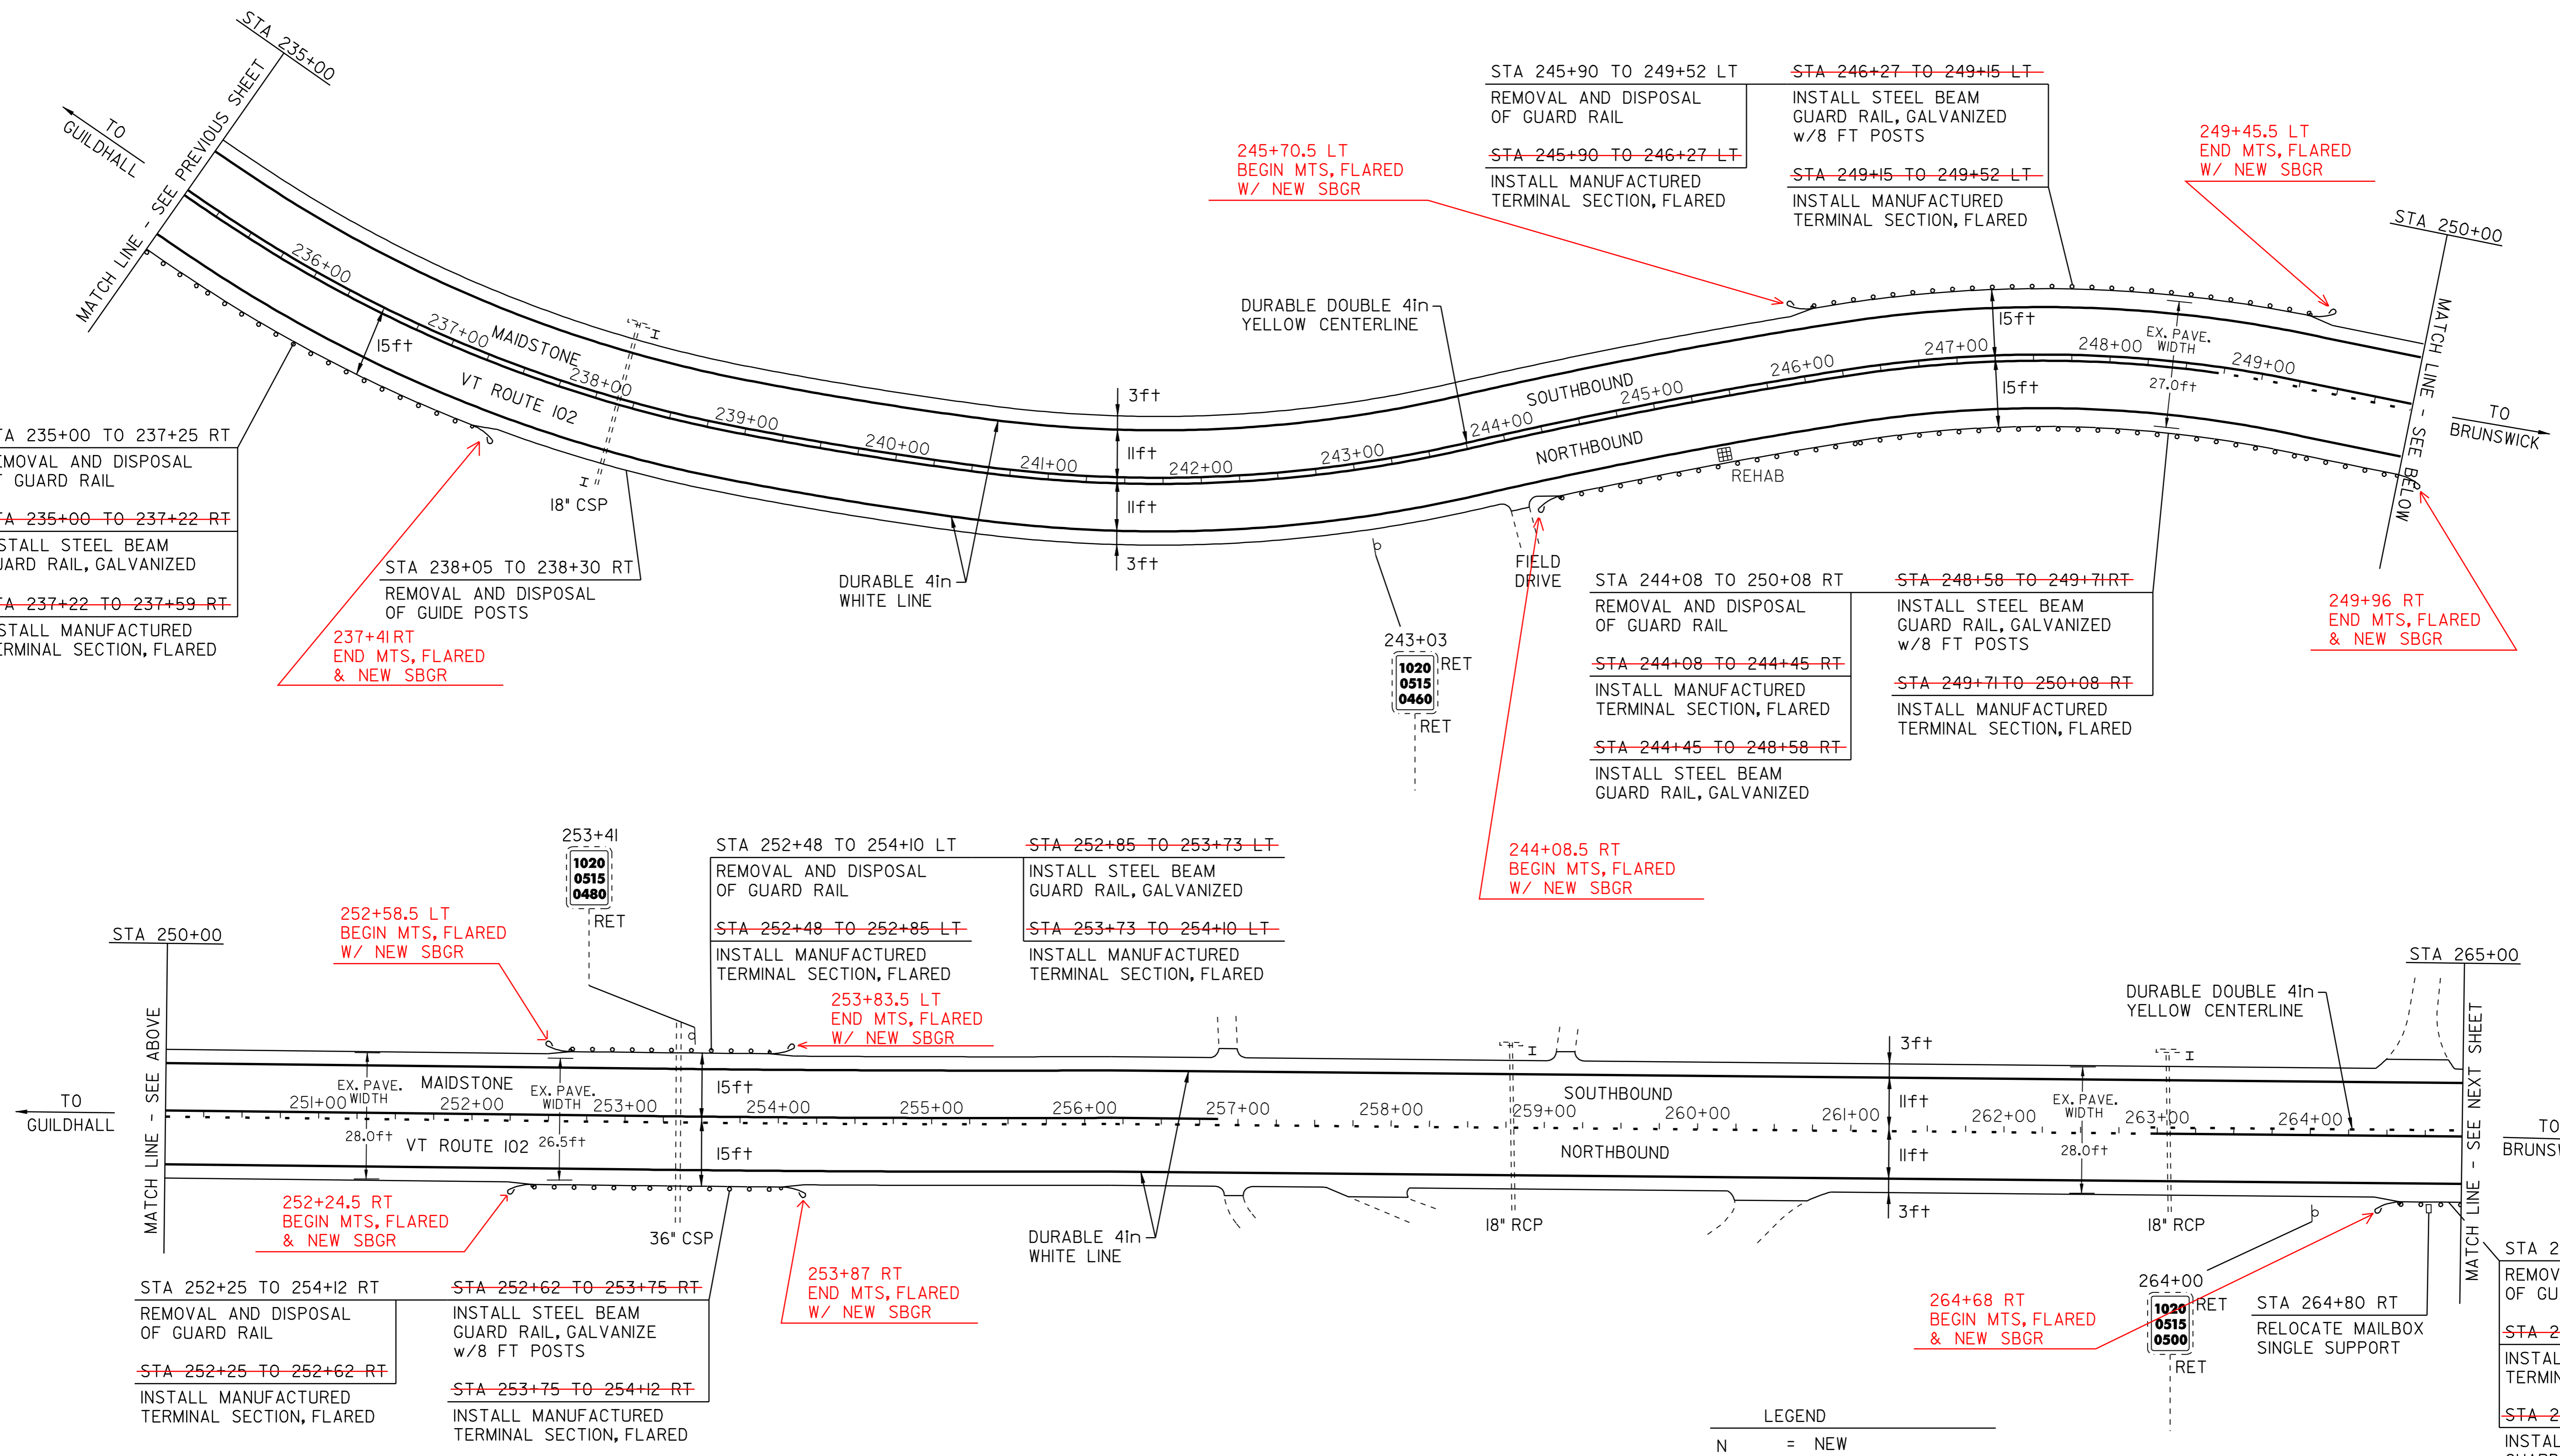

~~MANUFACTURED TERMINAL SECTION, FLARED~~

~~STA 237+22 TO 237+59 RT~~
~~STA 244+08 TO 244+45 RT~~
~~STA 249+71 TO 250+08 RT~~
~~STA 245+90 TO 246+27 LT~~
~~STA 249+15 TO 249+52 LT~~
~~STA 252+25 TO 252+62 RT~~
~~STA 252+48 TO 252+85 LT~~
~~STA 253+73 TO 254+10 LT~~
~~STA 253+75 TO 254+12 RT~~
~~STA 264+43 TO 264+80 RT~~

REMOVAL AND DISPOSAL OF GUARD RAIL

STA 235+00 TO 237+25 RT
STA 244+08 TO 250+08 RT
STA 245+90 TO 249+52 LT
STA 252+25 TO 254+12 RT
STA 252+48 TO 265+00 RT

REMOVAL AND DISPOSAL OF GUIDE POSTS

STA 238+05 TO 238+30 RT - 3

~~STEEL BEAM GUARD RAIL, GALVANIZED~~

~~STA 235+00 TO 237+22 RT~~
~~STA 244+45 TO 248+58 RT~~
~~STA 252+85 TO 253+73 LT~~
~~STA 264+80 TO 265+00 RT~~

~~STEEL BEAM GUARD RAIL, GALVANIZED w/8 FT POSTS~~

~~STA 248+58 TO 249+71 RT~~
~~STA 246+27 TO 249+15 LT~~
~~STA 252+62 TO 253+75 RT~~

RELOCATE MAILBOX, SINGLE SUPPORT

STA 264+80 RT

- LEGEND
- N = NEW
 - R = REMOVE
 - R&S = REMOVE & SALVAGE
 - S = SALVAGE
 - RET = RETAIN
 - B-T-O-B = BACK TO BACK
 - ⊕ ⊞ ⊠ CATCH BASIN/DI
 - (N.W.) = NO WORK REQUIRED (TYP. FOR D.I.'S, & C.B.'S WHERE NOTED)
 - I YIELDING MARKER POST
 - ⊕ UTILITY POLE
 - DRIVE

PAVING PROJECT LAYOUT SHEET #4

DESIGNED BY BCE/PJM DATE 10-06

DRAWN BY C.E.A., INC. DATE 10-06

DESIGN FILE NO. 06c042.dgn

PRF FILE 06c042p04.i DATE PLOTTED 24-AUG-2009

PROJ. NAME **MAIDSTONE - BLOOMFIELD**

PROJ. NO. **STP 2609(1)S**

SHEET **14** OF **40** SHEETS

TEMPORARY 4in YELLOW LINE (PAINT)
 DURABLE 4in YELLOW LINE (THERMOPLASTIC)
 STA 265+00 TO 270+07 DASHED LT & SOLID RT
 STA 270+07 TO 295+00 SOLID LT&RT

TEMPORARY 4in WHITE LINE (PAINT)
 DURABLE 4in WHITE LINE (THERMOPLASTIC)
 STA 265+00 TO 295+00 SOLID LT&RT

YIELDING MARKER POST

STA 267+06 LT
 STA 270+20 LT
 STA 273+55 LT
 STA 278+76 LT
 STA 293+91 LT

REHABILITATION OF D.I., C.B., OR M.H.

STA 291+31 RT

~~TREATED TIMBER CURB~~

~~STA 291+31 TO 292+37 RT~~

REMOVAL AND DISPOSAL OF GUIDE POSTS

STA 271+10 TO 271+40 RT - 3
 STA 279+52 TO 280+45 RT - 7
 STA 290+30 TO 291+30 RT - 4

REMOVAL AND DISPOSAL OF GUARD RAIL

STA 265+00 TO 270+18 RT
 STA 271+55 TO 275+05 RT
 STA 282+40 TO 287+40 RT
 STA 283+07 TO 284+45 LT
 STA 291+30 TO 292+80 RT
 STA 293+25 TO 295+15 RT

~~MANUFACTURED TERMINAL SECTION, FLARED~~

~~STA 269+81 TO 270+18 RT~~
~~STA 271+55 TO 271+92 RT~~
~~STA 275+05 TO 275+42 RT~~
~~STA 281+65 TO 282+02 RT~~
~~STA 282+70 TO 283+07 LT~~
~~STA 284+08 TO 284+45 LT~~
~~STA 287+40 TO 287+77 RT~~
~~STA 290+92 TO 291+30 RT~~
~~STA 293+12 TO 293+50 RT~~
~~STA 294+88 TO 295+25 RT~~

RELOCATE MAILBOX, SINGLE SUPPORT

STA 270+12 RT
 STA 285+45 RT
 STA 290+30 RT

~~STEEL BEAM GUARD RAIL, GALVANIZED~~


~~STA 265+00 TO 267+05 RT~~
~~STA 271+92 TO 272+30 RT~~
~~STA 291+30 TO 292+30 RT~~
~~STA 293+50 TO 294+88 RT~~

~~STEEL BEAM GUARD RAIL, GALVANIZED w/8 FT POSTS~~

~~STA 267+05 TO 269+81 RT~~
~~STA 272+30 TO 275+05 RT~~
~~STA 282+02 TO 287+40 RT~~
~~STA 283+07 TO 284+08 LT~~

MANUFACTURED TERMINAL SECTION, TANGENT

STA 292+30 TO 292+80 RT

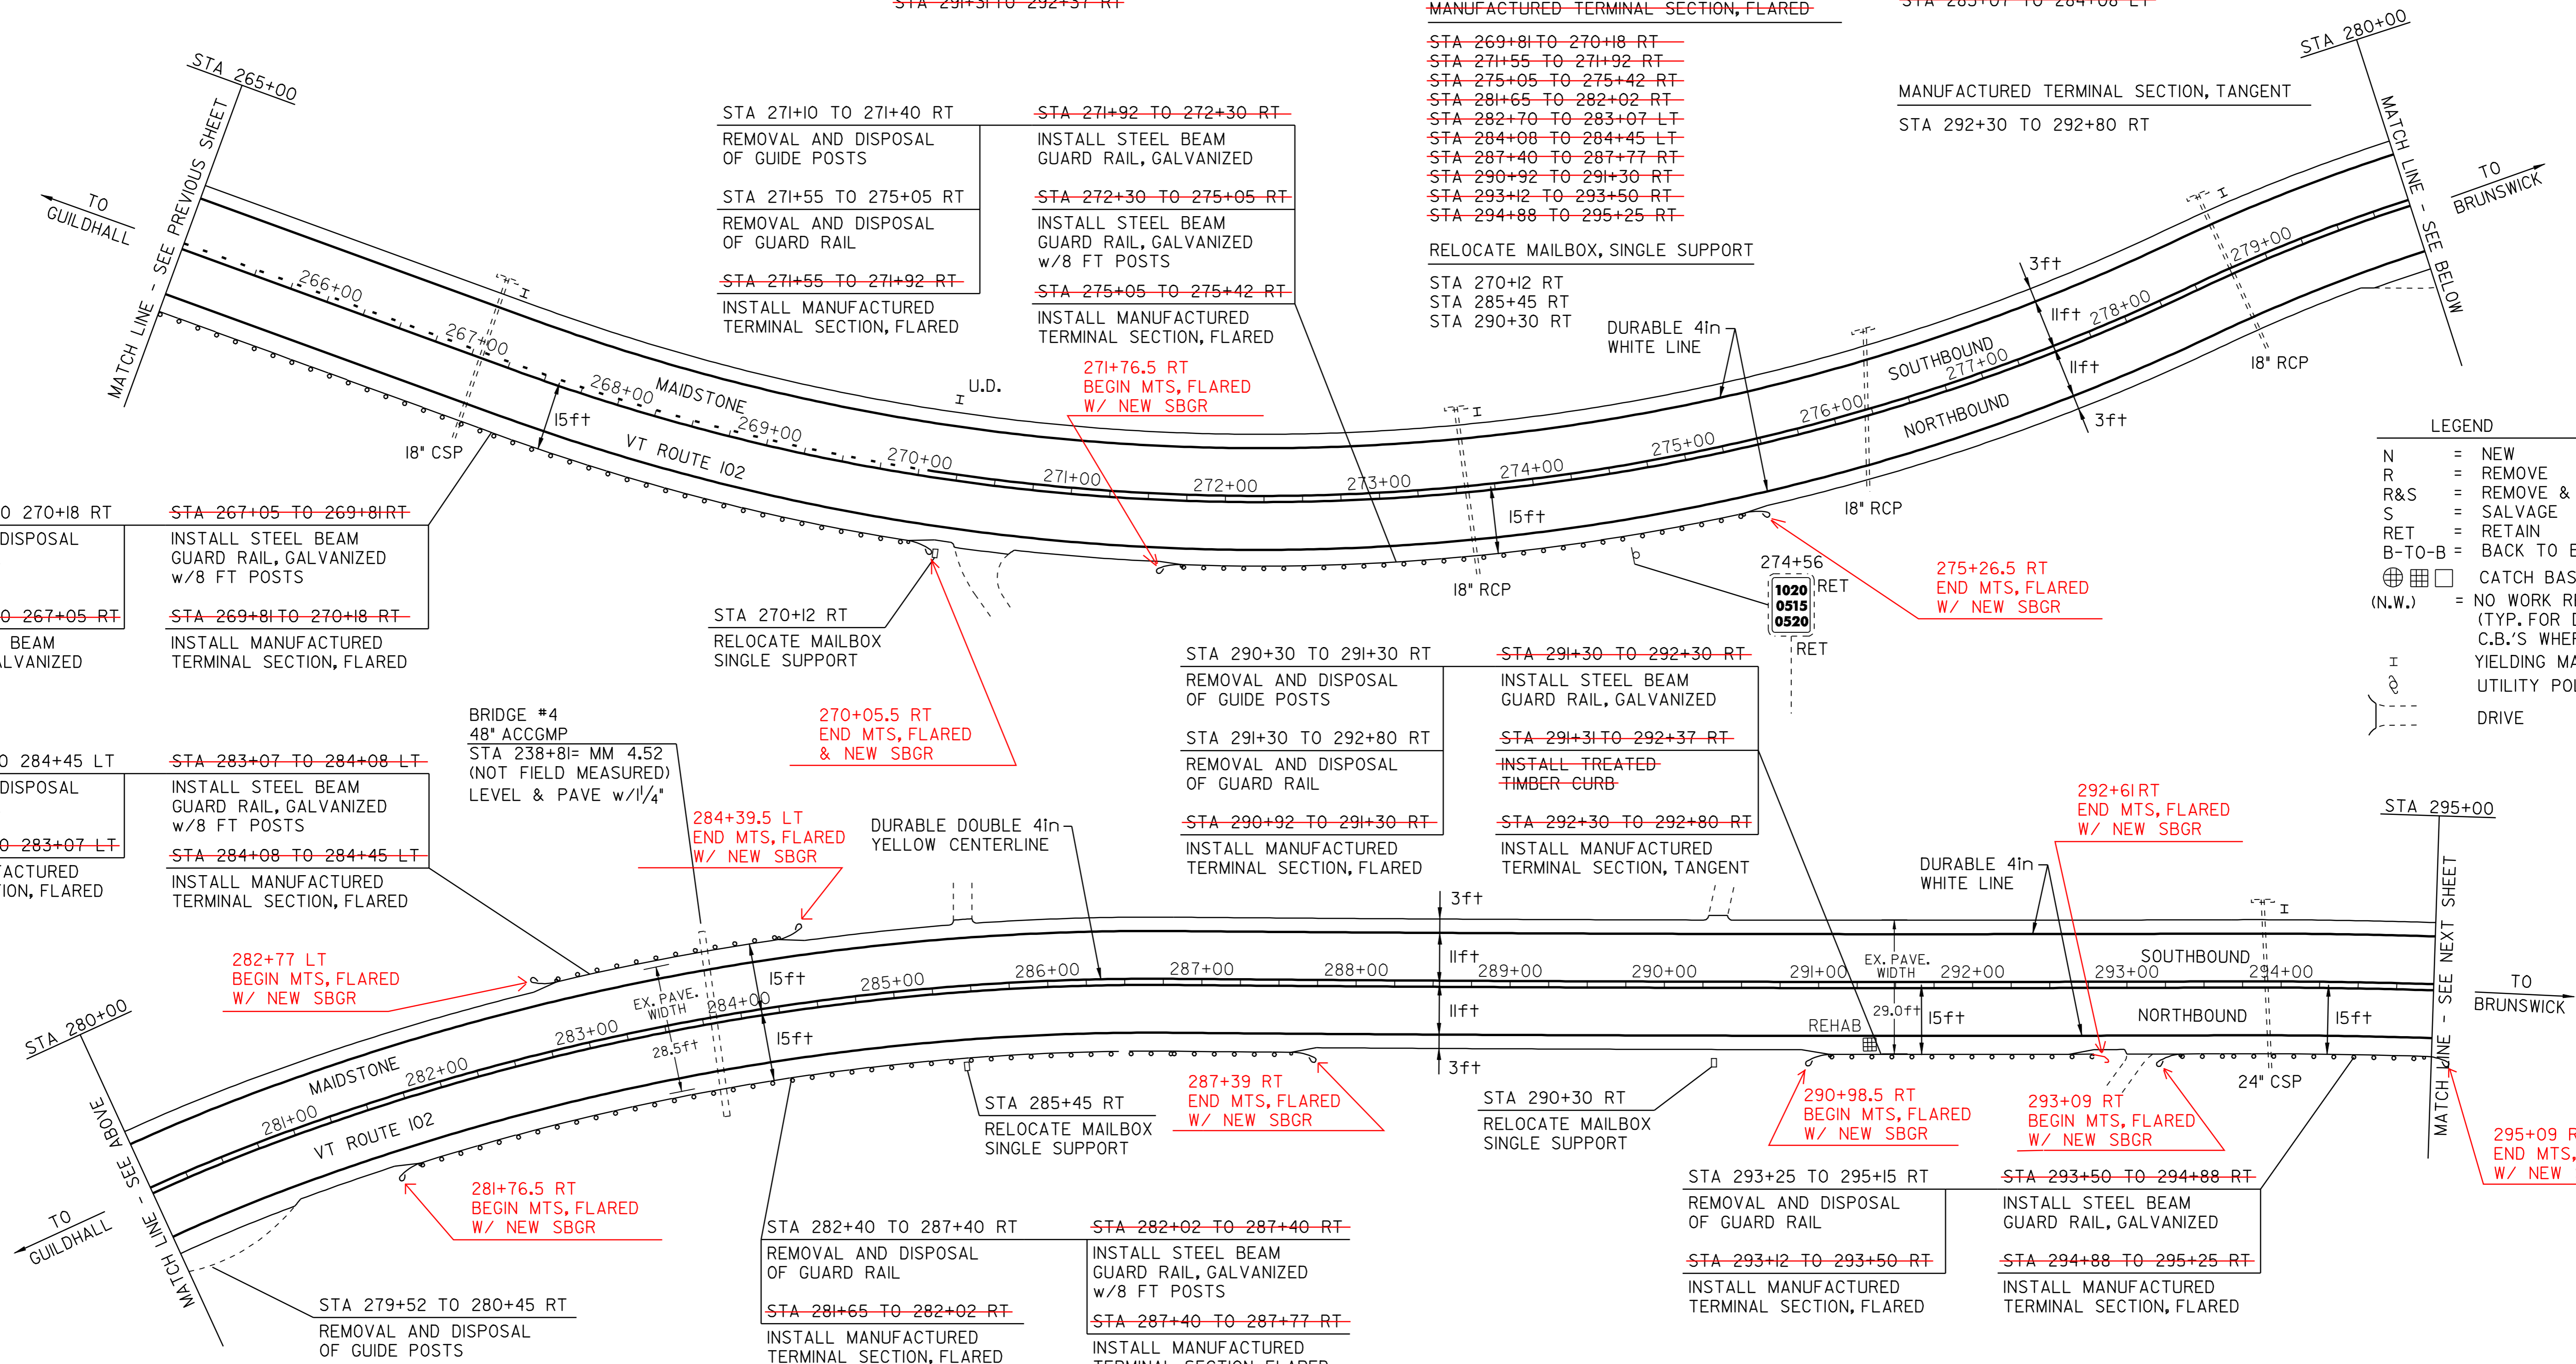

LEGEND

N	=	NEW
R	=	REMOVE
R&S	=	REMOVE & SALVAGE
S	=	SALVAGE
RET	=	RETAIN
B-TO-B	=	BACK TO BACK
⊗	=	CATCH BASIN/DI
(N.W.)	=	NO WORK REQUIRED (TYP. FOR D.I.'S, & C.B.'S WHERE NOTED)
I	=	YIELDING MARKER POST
⊕	=	UTILITY POLE
---	=	DRIVE

PAVING PROJECT LAYOUT SHEET #5


DESIGNED BY	BCE/PJM	DATE	10-06
DRAWN BY	C.E.A., INC.	DATE	10-06
DESIGN FILE NO.	06c042.dgn		
PRF FILE	06c042p05.1	DATE PLOTTED	24-AUG-2009
PROJ. NAME	MAIDSTONE - BLOOMFIELD		
PROJ. NO.	STP 2609(1)S		
SHEET	15	OF	40 SHEETS

TEMPORARY 4in YELLOW LINE (PAINT)
DURABLE 4in WHITE LINE (THERMOPLASTIC)
STA 295+00 TO 325+00 SOLID LT&R

TEMPORARY 4in WHITE LINE (PAINT)
DURABLE 4in WHITE LINE (THERMOPLASTIC)
STA 295+00 TO 325+00 SOLID LT&R

YIELDING MARKER POST
STA 296+43 RT

DITCHING LOCATIONS (REFER TO SHEET 10 FOR DETAILS)
STA 306+00 TO 316+00 LT

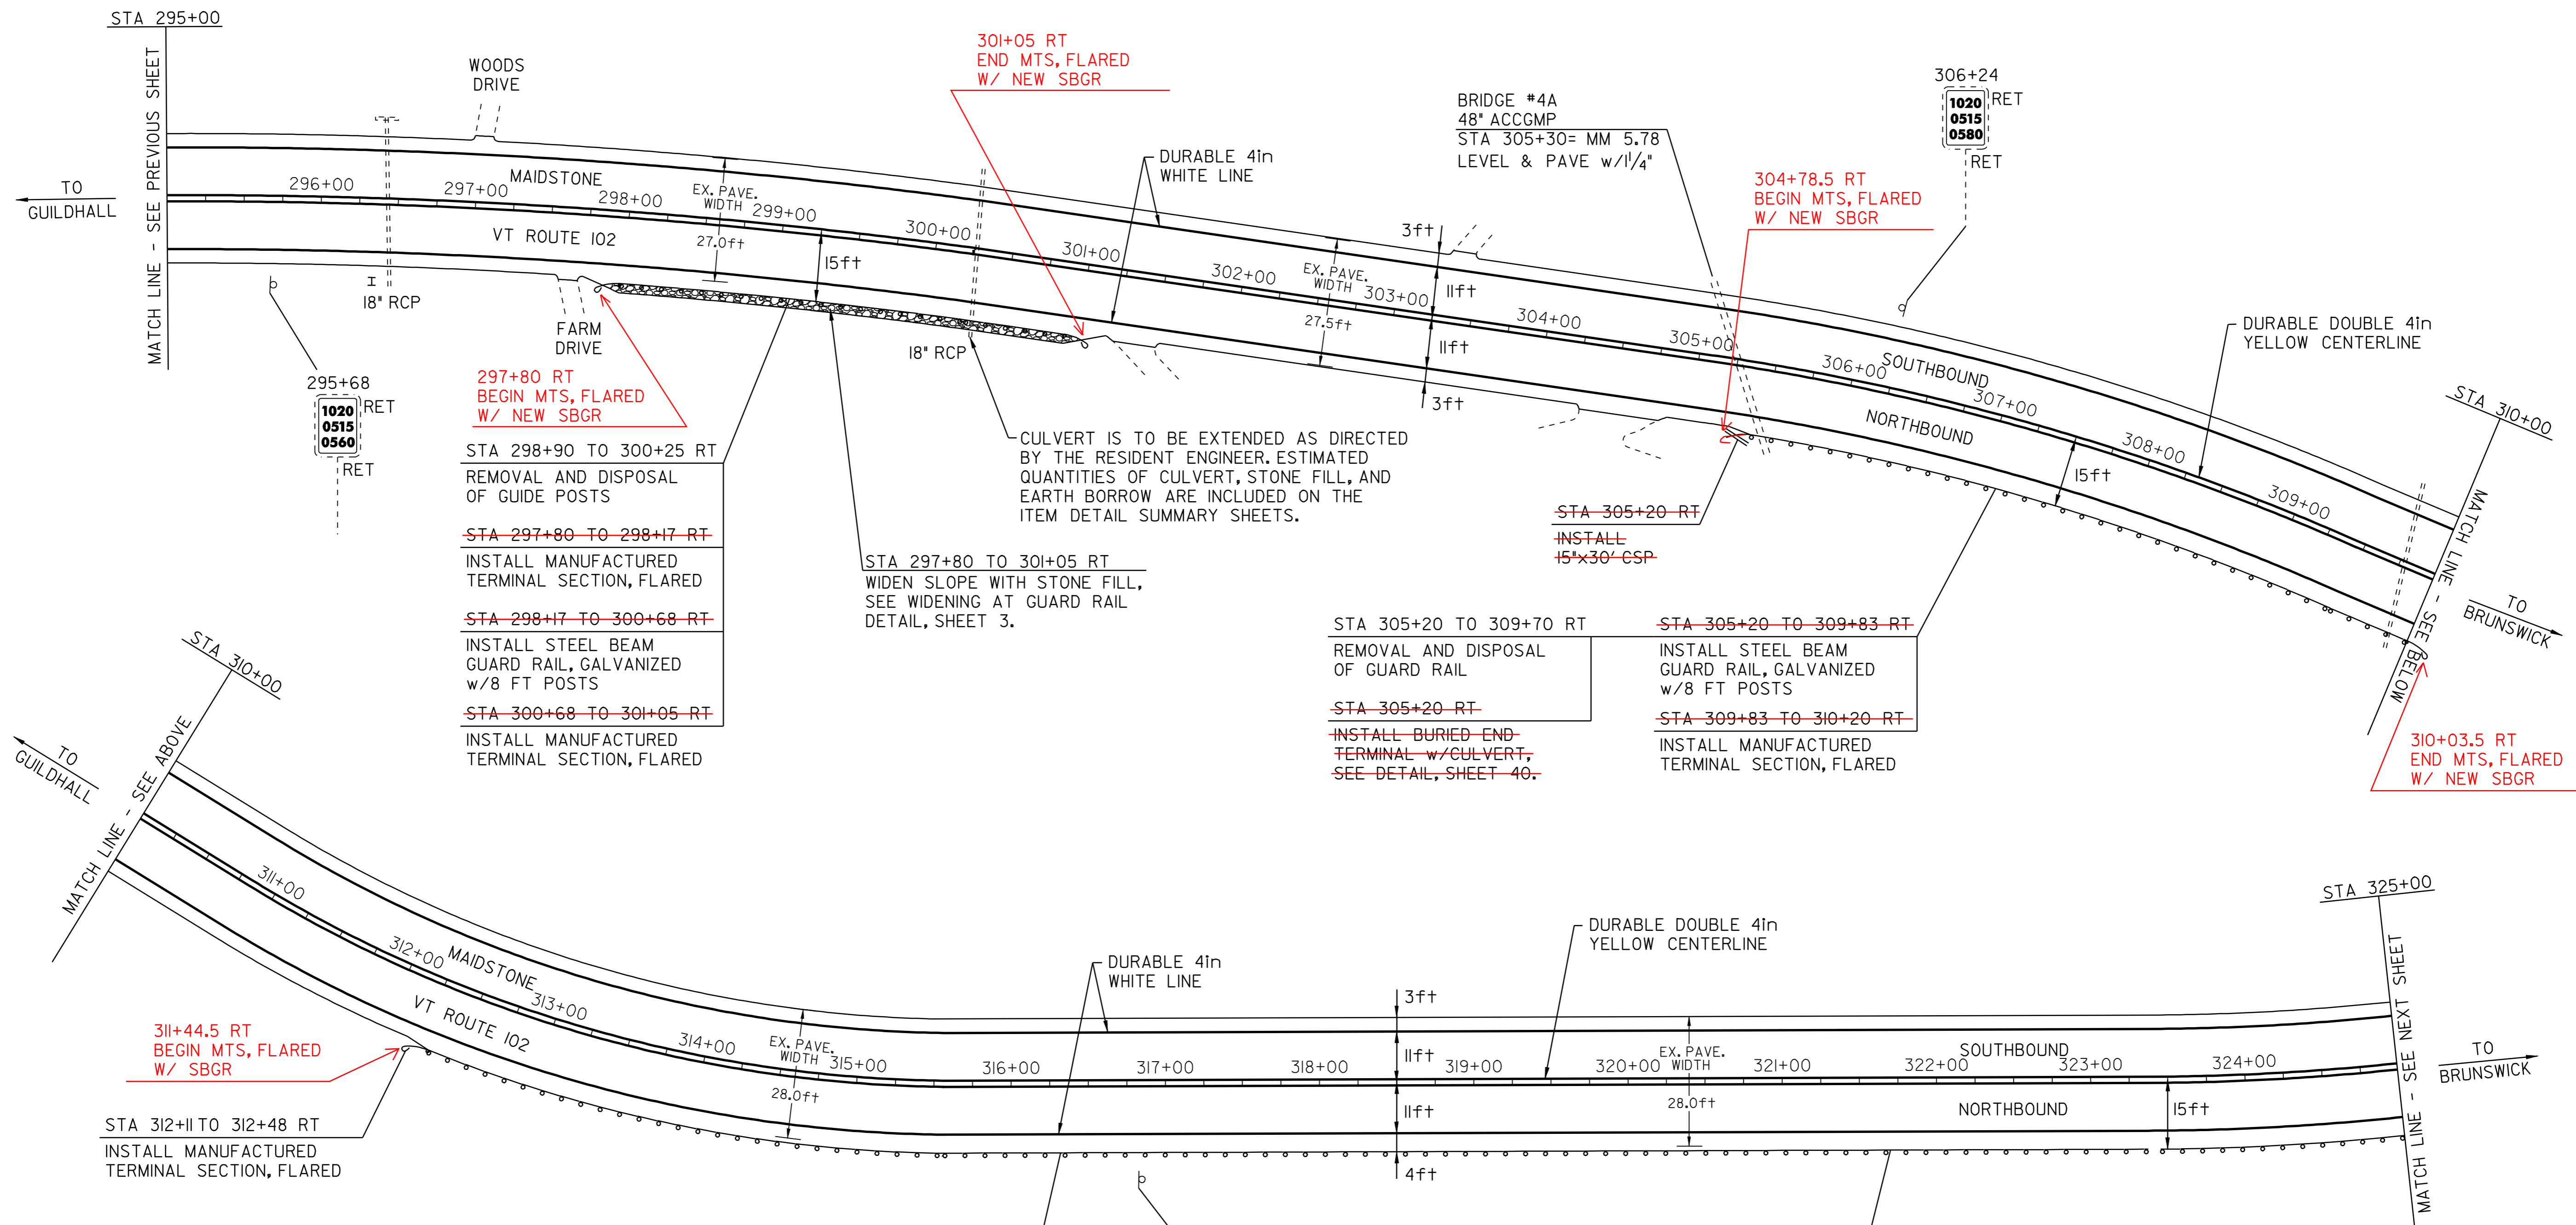

297+80 RT
BEGIN MTS, FLARED
W/ NEW SBGR

298+90 TO 300+25 RT
REMOVAL AND DISPOSAL
OF GUIDE POSTS

297+80 TO 298+17 RT
INSTALL MANUFACTURED
TERMINAL SECTION, FLARED

298+17 TO 300+68 RT
INSTALL STEEL BEAM
GUARD RAIL, GALVANIZED
w/8 FT POSTS

300+68 TO 301+05 RT
INSTALL MANUFACTURED
TERMINAL SECTION, FLARED

301+05 RT
END MTS, FLARED
W/ NEW SBGR

305+20 TO 309+70 RT
REMOVAL AND DISPOSAL
OF GUARD RAIL

305+20 RT
INSTALL BURIED END
TERMINAL w/ CULVERT,
SEE-DETAIL, SHEET 40.

309+83 TO 310+20 RT
INSTALL STEEL BEAM
GUARD RAIL, GALVANIZED
w/8 FT POSTS

310+20 RT
INSTALL MANUFACTURED
TERMINAL SECTION, FLARED

304+78.5 RT
BEGIN MTS, FLARED
W/ NEW SBGR

312+48 TO 325+00 RT
INSTALL STEEL BEAM
GUARD RAIL, GALVANIZED
w/8 FT POSTS

311+44.5 RT
BEGIN MTS, FLARED
W/ SBGR

312+11 TO 312+48 RT
INSTALL MANUFACTURED
TERMINAL SECTION, FLARED

312+61 TO 325+00 RT
REMOVAL AND DISPOSAL
OF GUARD RAIL

316+80
RET

312+48 TO 325+00 RT
INSTALL STEEL BEAM
GUARD RAIL, GALVANIZED
w/8 FT POSTS

- LEGEND**
- N = NEW
 - R = REMOVE
 - R&S = REMOVE & SALVAGE
 - S = SALVAGE
 - RET = RETAIN
 - B-TO-B = BACK TO BACK
 - ⊕ □ = CATCH BASIN/DI
 - (N.W.) = NO WORK REQUIRED (TYP. FOR D.I.'S, & C.B.'S WHERE NOTED)
 - I = YIELDING MARKER POST
 - ⊕ = UTILITY POLE
 - = DRIVE

- REMOVAL AND DISPOSAL OF GUIDE POSTS
- STA 298+90 TO 300+25 RT - 5
- REMOVAL AND DISPOSAL OF GUARD RAIL
- STA 305+20 TO 309+70 RT
- STA 312+61 TO 325+00 RT
- MANUFACTURED TERMINAL SECTION, FLARED
- STA 297+80 TO 298+17 RT
- STA 300+68 TO 301+05 RT
- STA 309+83 TO 310+20 RT
- STA 312+11 TO 312+48 RT


- STEEL BEAM GUARD RAIL, GALVANIZED w/8 FT POSTS
- STA 298+17 TO 300+68 RT
- STA 305+20 TO 309+83 RT
- STA 312+48 TO 325+00 RT
- ANCHOR FOR STEEL BEAM RAIL
- STA 305+20 RT - 2

PAVING PROJECT LAYOUT SHEET #6

DESIGNED BY	BCE/PJM	DATE	10-06
DRAWN BY	C.E.A., INC.	DATE	10-06
DESIGN FILE NO.	06c042.dgn		
PRF FILE	06c042p06.1	DATE PLOTTED	24-AUG-2009
PROJ. NAME	MAIDSTONE - BLOOMFIELD		
PROJ. NO.	STP 2609(1)S		
SHEET	16	OF	40 SHEETS

TEMPORARY 4in YELLOW LINE (PAINT)
 DURABLE 4in YELLOW LINE (THERMOPLASTIC)
 STA 325+00 TO 355+00 SOLID LT&RT
 STA 335+70 DOUBLE SOLID RT
 (WITH CENTERLINE BREAKS FOR TOWN HIGHWAYS)



TEMPORARY 4in WHITE LINE (PAINT)
 DURABLE 4in WHITE LINE (THERMOPLASTIC)
 STA 325+00 TO 355+00 SOLID LT&RT

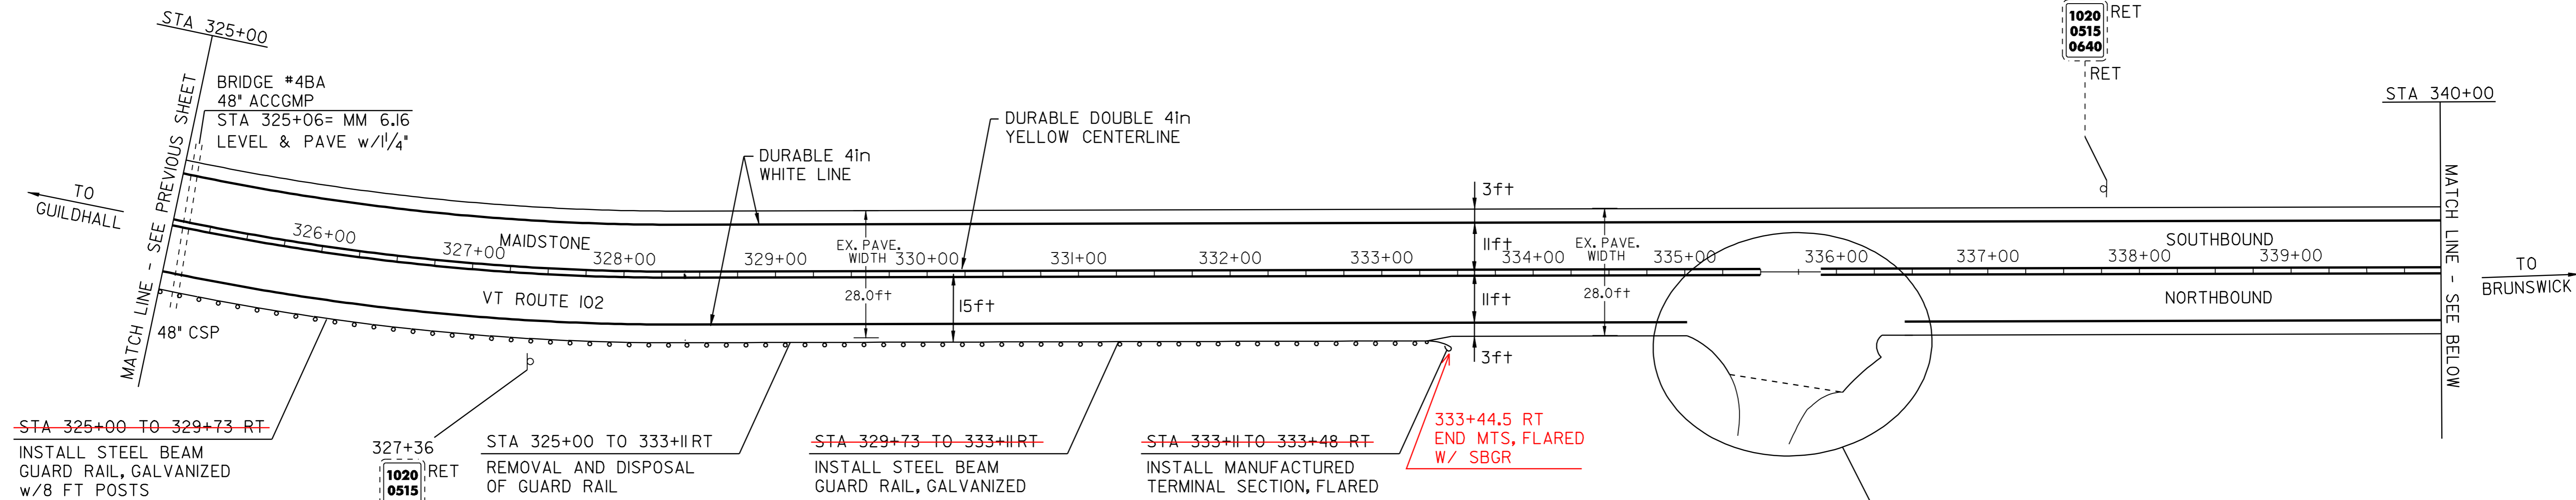

TEMPORARY LETTER OR SYMBOL (PAINT)
 DURABLE LETTER OR SYMBOL (THERMOPLASTIC)
 STA 335+70 RT "STOP"

TEMPORARY 24in STOP BAR (PAINT)
 DURABLE 24in STOP BAR (THERMOPLASTIC)
 STA 335+70 RT MAIDSTONE TOWN HIGHWAY

DITCHING LOCATIONS (REFER TO SHEET 10 FOR DETAILS)
 STA 333+50 TO 344+00 LT
 STA 346+00 TO 355+00 LT

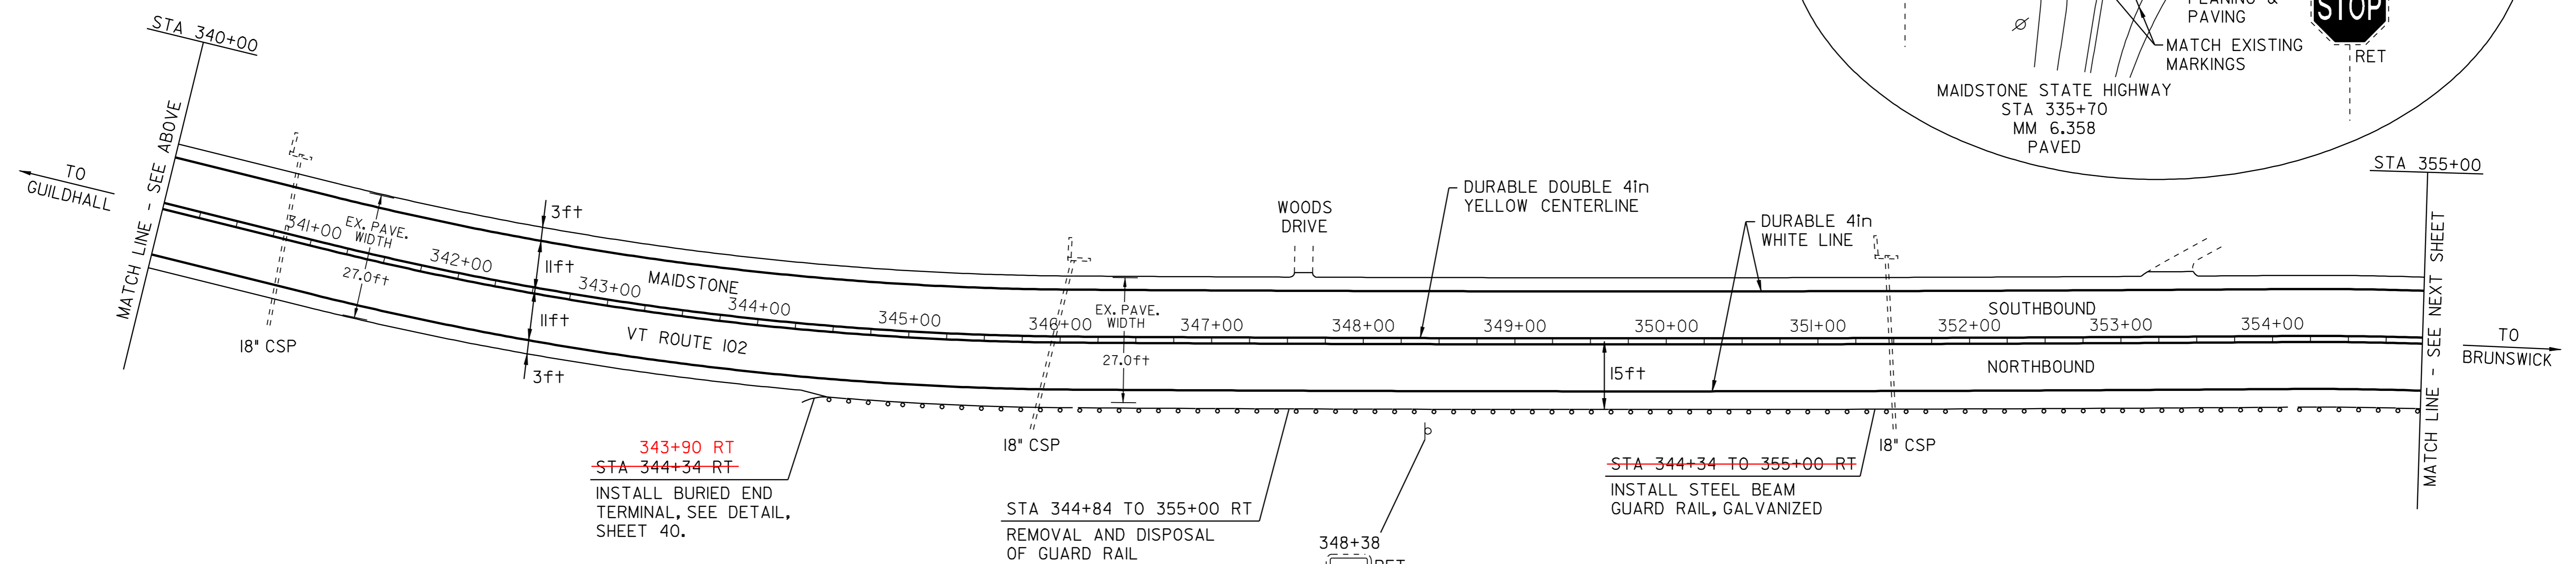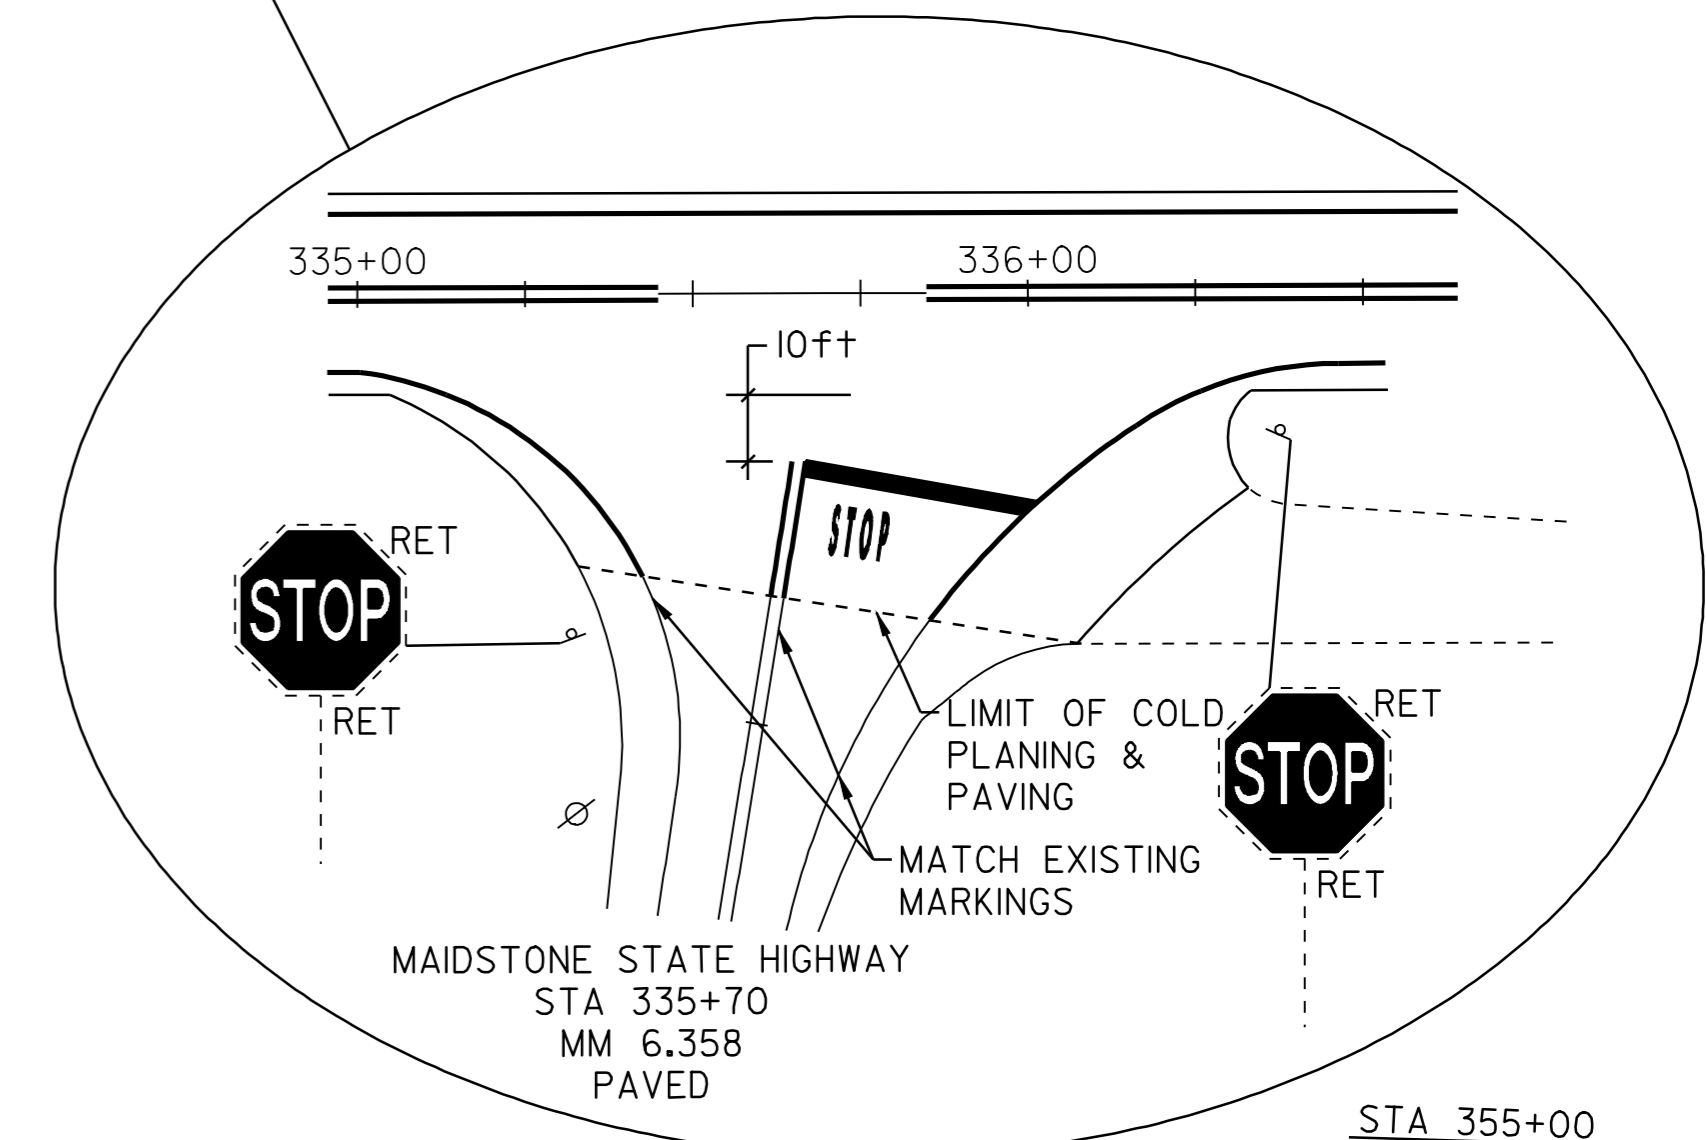

REMOVAL AND DISPOSAL OF GUARD RAIL
 STA 325+00 TO 333+11 RT
 STA 344+84 TO 355+00 RT

STEEL BEAM GUARD RAIL, GALVANIZED
 STA 329+73 TO 333+11 RT
 STA 344+34 TO 355+00 RT

MANUFACTURED TERMINAL SECTION, FLARED
 STA 333+11 TO 333+48 RT

STEEL BEAM GUARD RAIL, GALVANIZED w/8 FT POSTS
 STA 325+00 TO 329+73 RT

ANCHOR FOR STEEL BEAM RAIL
 STA 344+34 RT - 2
 343+90 RT

LEGEND

N	=	NEW
R	=	REMOVE
R&S	=	REMOVE & SALVAGE
S	=	SALVAGE
RET	=	RETAIN
B-T-O-B	=	BACK TO BACK
⊕	=	CATCH BASIN/DI
(N.W.)	=	NO WORK REQUIRED (TYP. FOR D.I.'S, & C.B.'S WHERE NOTED)
I	=	YIELDING MARKER POST
⊙	=	UTILITY POLE
---	=	DRIVE

PAVING PROJECT LAYOUT SHEET #7

DESIGNED BY	BCE/PJM	DATE	10-06
DRAWN BY	C.E.A., INC.	DATE	10-06
DESIGN FILE NO.	06c042.dgn		
PRF FILE	06c042p07.l	DATE PLOTTED	24-AUG-2009
PROJ. NAME	MAIDSTONE - BLOOMFIELD		
PROJ. NO.	STP 2609(1)S		
SHEET	17	OF	40 SHEETS


TEMPORARY 4in YELLOW LINE (PAINT)
DURABLE 4in YELLOW LINE (THERMOPLASTIC)
STA 355+00 TO 385+00 SOLID LT&RT

TEMPORARY 4in WHITE LINE (PAINT)
DURABLE 4in WHITE LINE (THERMOPLASTIC)
STA 355+00 TO 385+00 SOLID LT&RT

YIELDING MARKER POST
STA 365+87 RT
STA 366+21LT
STA 375+08 RT

DITCHING LOCATIONS (REFER TO SHEET 10 FOR DETAILS)
STA 355+00 TO 361+00 LT
STA 362+50 TO 368+25 LT
STA 369+00 TO 378+00 LT

LEGEND
N = NEW
R = REMOVE
R&S = REMOVE & SALVAGE
S = SALVAGE
RET = RETAIN
B-TO-B = BACK TO BACK
CATCH BASIN/DI
(N.W.) = NO WORK REQUIRED (TYP. FOR D.I.'S, & C.B.'S WHERE NOTED)
YIELDING MARKER POST
UTILITY POLE
DRIVE

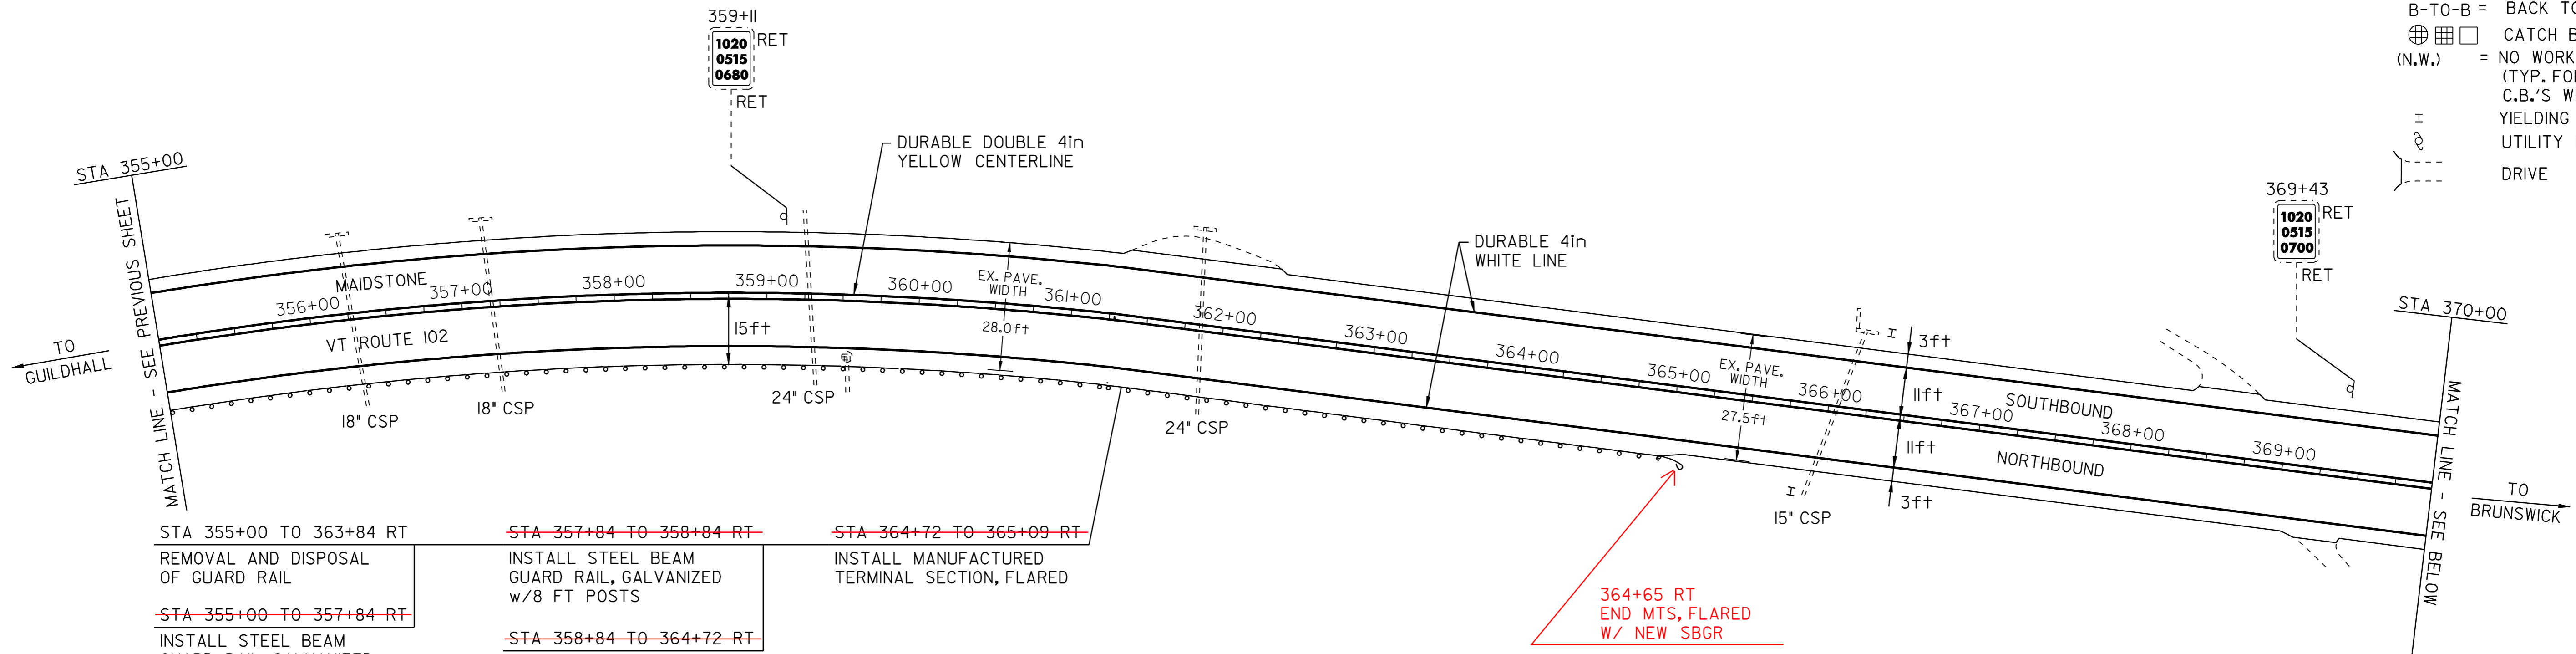


STA 355+00 TO 363+84 RT
REMOVAL AND DISPOSAL OF GUARD RAIL
~~STA 355+00 TO 357+84 RT~~
INSTALL STEEL BEAM GUARD RAIL, GALVANIZED

~~STA 357+84 TO 358+84 RT~~
INSTALL STEEL BEAM GUARD RAIL, GALVANIZED w/8 FT POSTS

~~STA 358+84 TO 364+72 RT~~
INSTALL STEEL BEAM GUARD RAIL, GALVANIZED

~~STA 364+72 TO 365+09 RT~~
INSTALL MANUFACTURED TERMINAL SECTION, FLARED

364+65 RT
END MTS, FLARED
W/ NEW SBGR

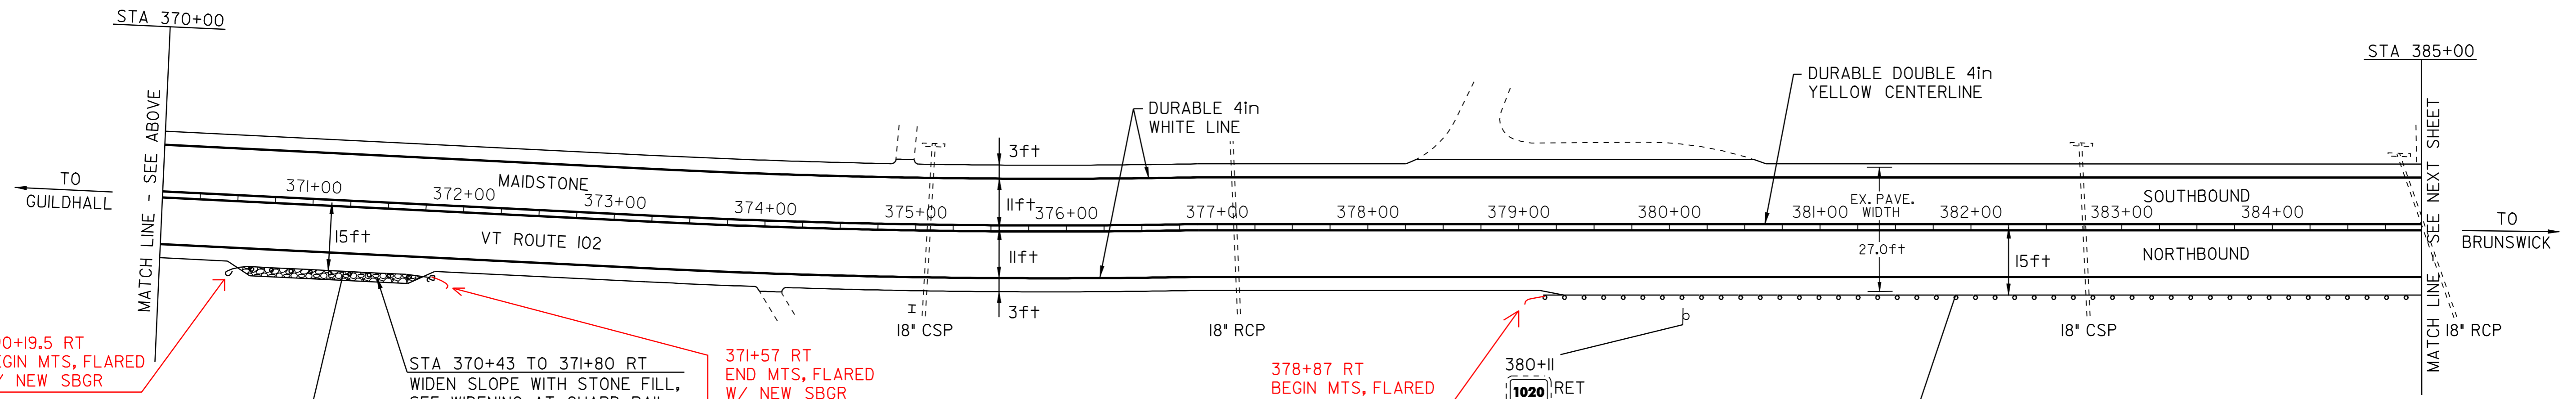

390+19.5 RT
BEGIN MTS, FLARED
W/ NEW SBGR

STA 370+43 TO 371+80 RT
WIDEN SLOPE WITH STONE FILL,
SEE WIDENING AT GUARD RAIL
DETAIL, SHEET 3.

371+57 RT
END MTS, FLARED
W/ NEW SBGR

378+87 RT
BEGIN MTS, FLARED
W/ NEW SBGR

STA 370+80 TO 371+58 RT
REMOVAL AND DISPOSAL OF GUIDE POSTS
~~STA 370+43 TO 370+80 RT~~
INSTALL MANUFACTURED TERMINAL SECTION, FLARED

~~STA 370+80 TO 371+30 RT~~
INSTALL STEEL BEAM GUARD RAIL, GALVANIZED w/8 FT POSTS

~~STA 371+30 TO 371+80 RT~~
INSTALL MANUFACTURED TERMINAL SECTION, TANGENT

REMOVAL AND DISPOSAL OF GUIDE POSTS
STA 370+80 TO 371+58 RT - 6

REMOVAL AND DISPOSAL OF GUARD RAIL
STA 355+00 TO 363+84 RT
STA 379+53 TO 385+00 RT

~~MANUFACTURED TERMINAL SECTION, FLARED~~

~~STA 364+72 TO 365+09 RT~~
~~STA 370+43 TO 370+80 RT~~

~~MANUFACTURED TERMINAL SECTION, TANGENT~~

~~STA 371+30 TO 371+80 RT~~
~~STA 379+16 TO 379+66 RT~~

~~STEEL BEAM GUARD RAIL, GALVANIZED~~

~~STA 355+00 TO 357+84 RT~~
~~STA 358+84 TO 364+72 RT~~

~~STEEL BEAM GUARD RAIL, GALVANIZED w/8 FT POSTS~~

~~STA 357+84 TO 358+84 RT~~
~~STA 370+80 TO 371+30 RT~~
~~STA 379+66 TO 385+00 RT~~

STA 379+53 TO 385+00 RT
REMOVAL AND DISPOSAL OF GUARD RAIL

~~STA 379+16 TO 379+66 RT~~
INSTALL MANUFACTURED TERMINAL SECTION, TANGENT

~~STA 379+66 TO 385+00 RT~~
INSTALL STEEL BEAM GUARD RAIL, GALVANIZED w/8 FT POSTS

PAVING PROJECT LAYOUT SHEET #8

DESIGNED BY BCE/PJM DATE 10-06
 DRAWN BY C.E.A., INC. DATE 10-06
 DESIGN FILE NO. 06c042.dgn
 PRF FILE 06c042p08.i DATE PLOTTED 24-AUG-2009
 PROJ. NAME **MAIDSTONE - BLOOMFIELD**
 PROJ. NO. **STP 2609(1)S**
 SHEET **18** OF **40** SHEETS

TEMPORARY 4in YELLOW LINE (PAINT)
DURABLE 4in YELLOW LINE (THERMOPLASTIC)

STA 385+00 TO 413+07 SOLID LT&RT
STA 395+37 DOUBLE SOLID LT
(WITH CENTERLINE BREAKS FOR TOWN HIGHWAYS)

TEMPORARY 4in WHITE LINE (PAINT)
DURABLE 4in WHITE LINE (THERMOPLASTIC)

STA 385+00 TO 413+07 SOLID LT&RT

TEMPORARY LETTER OR SYMBOL (PAINT)
DURABLE LETTER OR SYMBOL (THERMOPLASTIC)

STA 395+37 LT "STOP"

TEMPORARY 24in STOP BAR (PAINT)
DURABLE 24in STOP BAR (THERMOPLASTIC)

STA 395+37 LT HALL RD

REMOVING SIGNS
4

389+42.5 LT
BEGIN MTS, FLARED
W/ NEW SBGR

STA 389+35 TO 389+72 LT

INSTALL MANUFACTURED
TERMINAL SECTION, FLARED

STA 390+35 TO 395+25 LT

REMOVAL AND DISPOSAL
OF GUARD RAIL

STA 389+35 TO 399+35 LT

REMOVAL AND DISPOSAL
OF GUIDE POSTS

STA 389+72 TO 395+25 LT

INSTALL STEEL BEAM
GUARD RAIL, GALVANIZED
w/8 FT POSTS

STA 395+25 LT

RELOCATE MAILBOX
MULTIPLE SUPPORT

STA 395+50 LT

INSTALL ANCHOR FOR
STEEL BEAM RAIL

STA 395+50 TO 399+12 LT

REMOVAL AND DISPOSAL
OF GUARD RAIL

STA 395+50 TO 395+75 LT

INSTALL STEEL BEAM
GUARD RAIL, GALVANIZED

STA 395+75 TO 398+75 LT

INSTALL STEEL BEAM
GUARD RAIL, GALVANIZED
w/8 FT POSTS

STA 398+75 TO 399+12 LT

INSTALL MANUFACTURED
TERMINAL SECTION, FLARED

388+90 RT
BEGIN MTS, FLARED
W/ NEW SBGR

STA 386+70 TO 387+27 RT

REMOVAL AND DISPOSAL
OF GUIDE POSTS

STA 389+00 TO 389+37 RT

INSTALL MANUFACTURED
TERMINAL SECTION, FLARED

STA 389+37 TO 400+37 RT

INSTALL STEEL BEAM
GUARD RAIL, GALVANIZED
w/8 FT POSTS

STA 395+25 LT

INSTALL ANCHOR FOR
STEEL BEAM RAIL

399+07 LT
END MTS, FLARED
& NEW SBGR

STA 400+37 RT

INSTALL
15"x40" CSP

INSTALL BURIED END
TERMINAL w/ CULVERT,
SEE DETAIL, SHEET 40.

385+49.5 RT
END MTS, FLARED
W/ NEW SBGR

STA 385+00 TO 385+53 RT

REMOVAL AND DISPOSAL
OF GUARD RAIL

STA 385+00 TO 385+16 RT

INSTALL STEEL BEAM
GUARD RAIL, GALVANIZED
w/8 FT POSTS

STA 385+16 TO 385+53 RT

INSTALL MANUFACTURED
TERMINAL SECTION, FLARED

STA 397+46 RT

REMOVE D.I. AND 12" PIPE.
PAYMENT WILL BE AS
COMMON EXCAVATION.
BACKFILL WITH SUBBASE OF
CRUSHED GRAVEL, FINE
GRADED AND PAVE TO
FACE OF GUARD RAIL.

BRIDGE #5
114" CGMPP
STA 397+32= MM 7.53
(NOT FIELD MEASURED)
LEVEL & PAVE w/1/4"

STA 400+37 RT

INSTALL
15"x40" CSP

INSTALL BURIED END
TERMINAL w/ CULVERT,
SEE DETAIL, SHEET 40.

STA 400+00

STA 408+30 TO 410+50 RT

WIDEN SLOPE WITH STONE FILL,
SEE WIDENING AT GUARD RAIL
DETAIL, SHEET 3.

TOWN LINE
MAIDSTONE - STA 413+07
BRUNSWICK - STA 0+00

TO
GUILDHALL

TO
BRUNSWICK

MATCH LINE - SEE ABOVE

MATCH LINE - SEE NEXT SHEET

401+22

RET

1020
0515
0760

RET

REMOVAL AND DISPOSAL OF GUARD RAIL

STA 385+00 TO 385+53 RT
STA 389+75 TO 399+75 RT
STA 390+35 TO 395+25 LT
STA 395+50 TO 399+12 LT
STA 409+05 TO 413+07 RT

REMOVAL AND DISPOSAL OF GUIDE POSTS

STA 386+70 TO 387+27 RT - 3
STA 389+35 TO 399+35 LT - 4
STA 408+30 TO 409+05 RT - 7

MANUFACTURED TERMINAL SECTION, FLARED

STA 385+16 TO 385+53 RT
STA 389+00 TO 389+37 RT
STA 389+35 TO 389+72 LT
STA 398+75 TO 399+12 LT
STA 408+30 TO 408+67 RT

STEEL BEAM GUARD RAIL, GALVANIZED

STA 395+50 TO 395+75 LT

STEEL BEAM GUARD RAIL, GALVANIZED w/8 FT POSTS

STA 385+00 TO 385+16 RT
STA 389+37 TO 400+37 RT
STA 389+72 TO 395+25 LT
STA 395+75 TO 398+75 LT
STA 408+67 TO 413+07 RT

ANCHOR FOR STEEL BEAM RAIL

STA 395+25 LT - 1 394+80 LT 395+46 LT
STA 395+50 LT - 1 395+10 LT
STA 400+37 RT - 2 395+28 LT

RELOCATE MAILBOX, MULTIPLE SUPPORT

STA 395+25 LT - 3

STA 408+30 TO 409+05 RT

REMOVAL AND DISPOSAL
OF GUIDE POSTS

STA 409+05 TO 413+07 RT

REMOVAL AND DISPOSAL
OF GUARD RAIL

STA 408+30 TO 408+67 RT

INSTALL MANUFACTURED
TERMINAL SECTION, FLARED

STA 408+67 TO 413+07 RT

INSTALL STEEL BEAM
GUARD RAIL, GALVANIZED
w/8 FT POSTS

411+48

RET

1020
0515
0780

RET

LEGEND	
N	= NEW
R	= REMOVE
R&S	= REMOVE & SALVAGE
S	= SALVAGE
RET	= RETAIN
B-TO-B	= BACK TO BACK
⊕ ⊞ ⊠	= CATCH BASIN/DI
(N.W.)	= NO WORK REQUIRED (TYP. FOR D.I.'S, & C.B.'S WHERE NOTED)
⊥	= YIELDING MARKER POST
⊕	= UTILITY POLE
---	= DRIVE

PAVING PROJECT LAYOUT SHEET #9

DESIGNED BY	BCE/PJM	DATE	10-06
DRAWN BY	C.E.A., INC.	DATE	10-06
DESIGN FILE NO.	06c042.dgn		
PRF FILE	06c042p09.i	DATE PLOTTED	24-AUG-2009
PROJ. NAME	MAIDSTONE - BLOOMFIELD		
PROJ. NO.	STP 2609(1)S		
SHEET	19	OF	40 SHEETS


TEMPORARY 4in YELLOW LINE (PAINT)
DURABLE 4in YELLOW LINE (THERMOPLASTIC)
STA 0+00 TO 30+00
SOLID LT&RT

TEMPORARY 4in WHITE LINE (PAINT)
DURABLE 4in WHITE LINE (THERMOPLASTIC)
STA 0+00 TO 30+00
SOLID LT&RT

YIELDING MARKER POST
STA 3+66 RT

DITCHING LOCATIONS (REFER TO SHEET 10 FOR DETAILS)
STA 0+30 TO 3+25 LT

RELOCATE MAILBOX, SINGLE SUPPORT
STA 29+07 RT

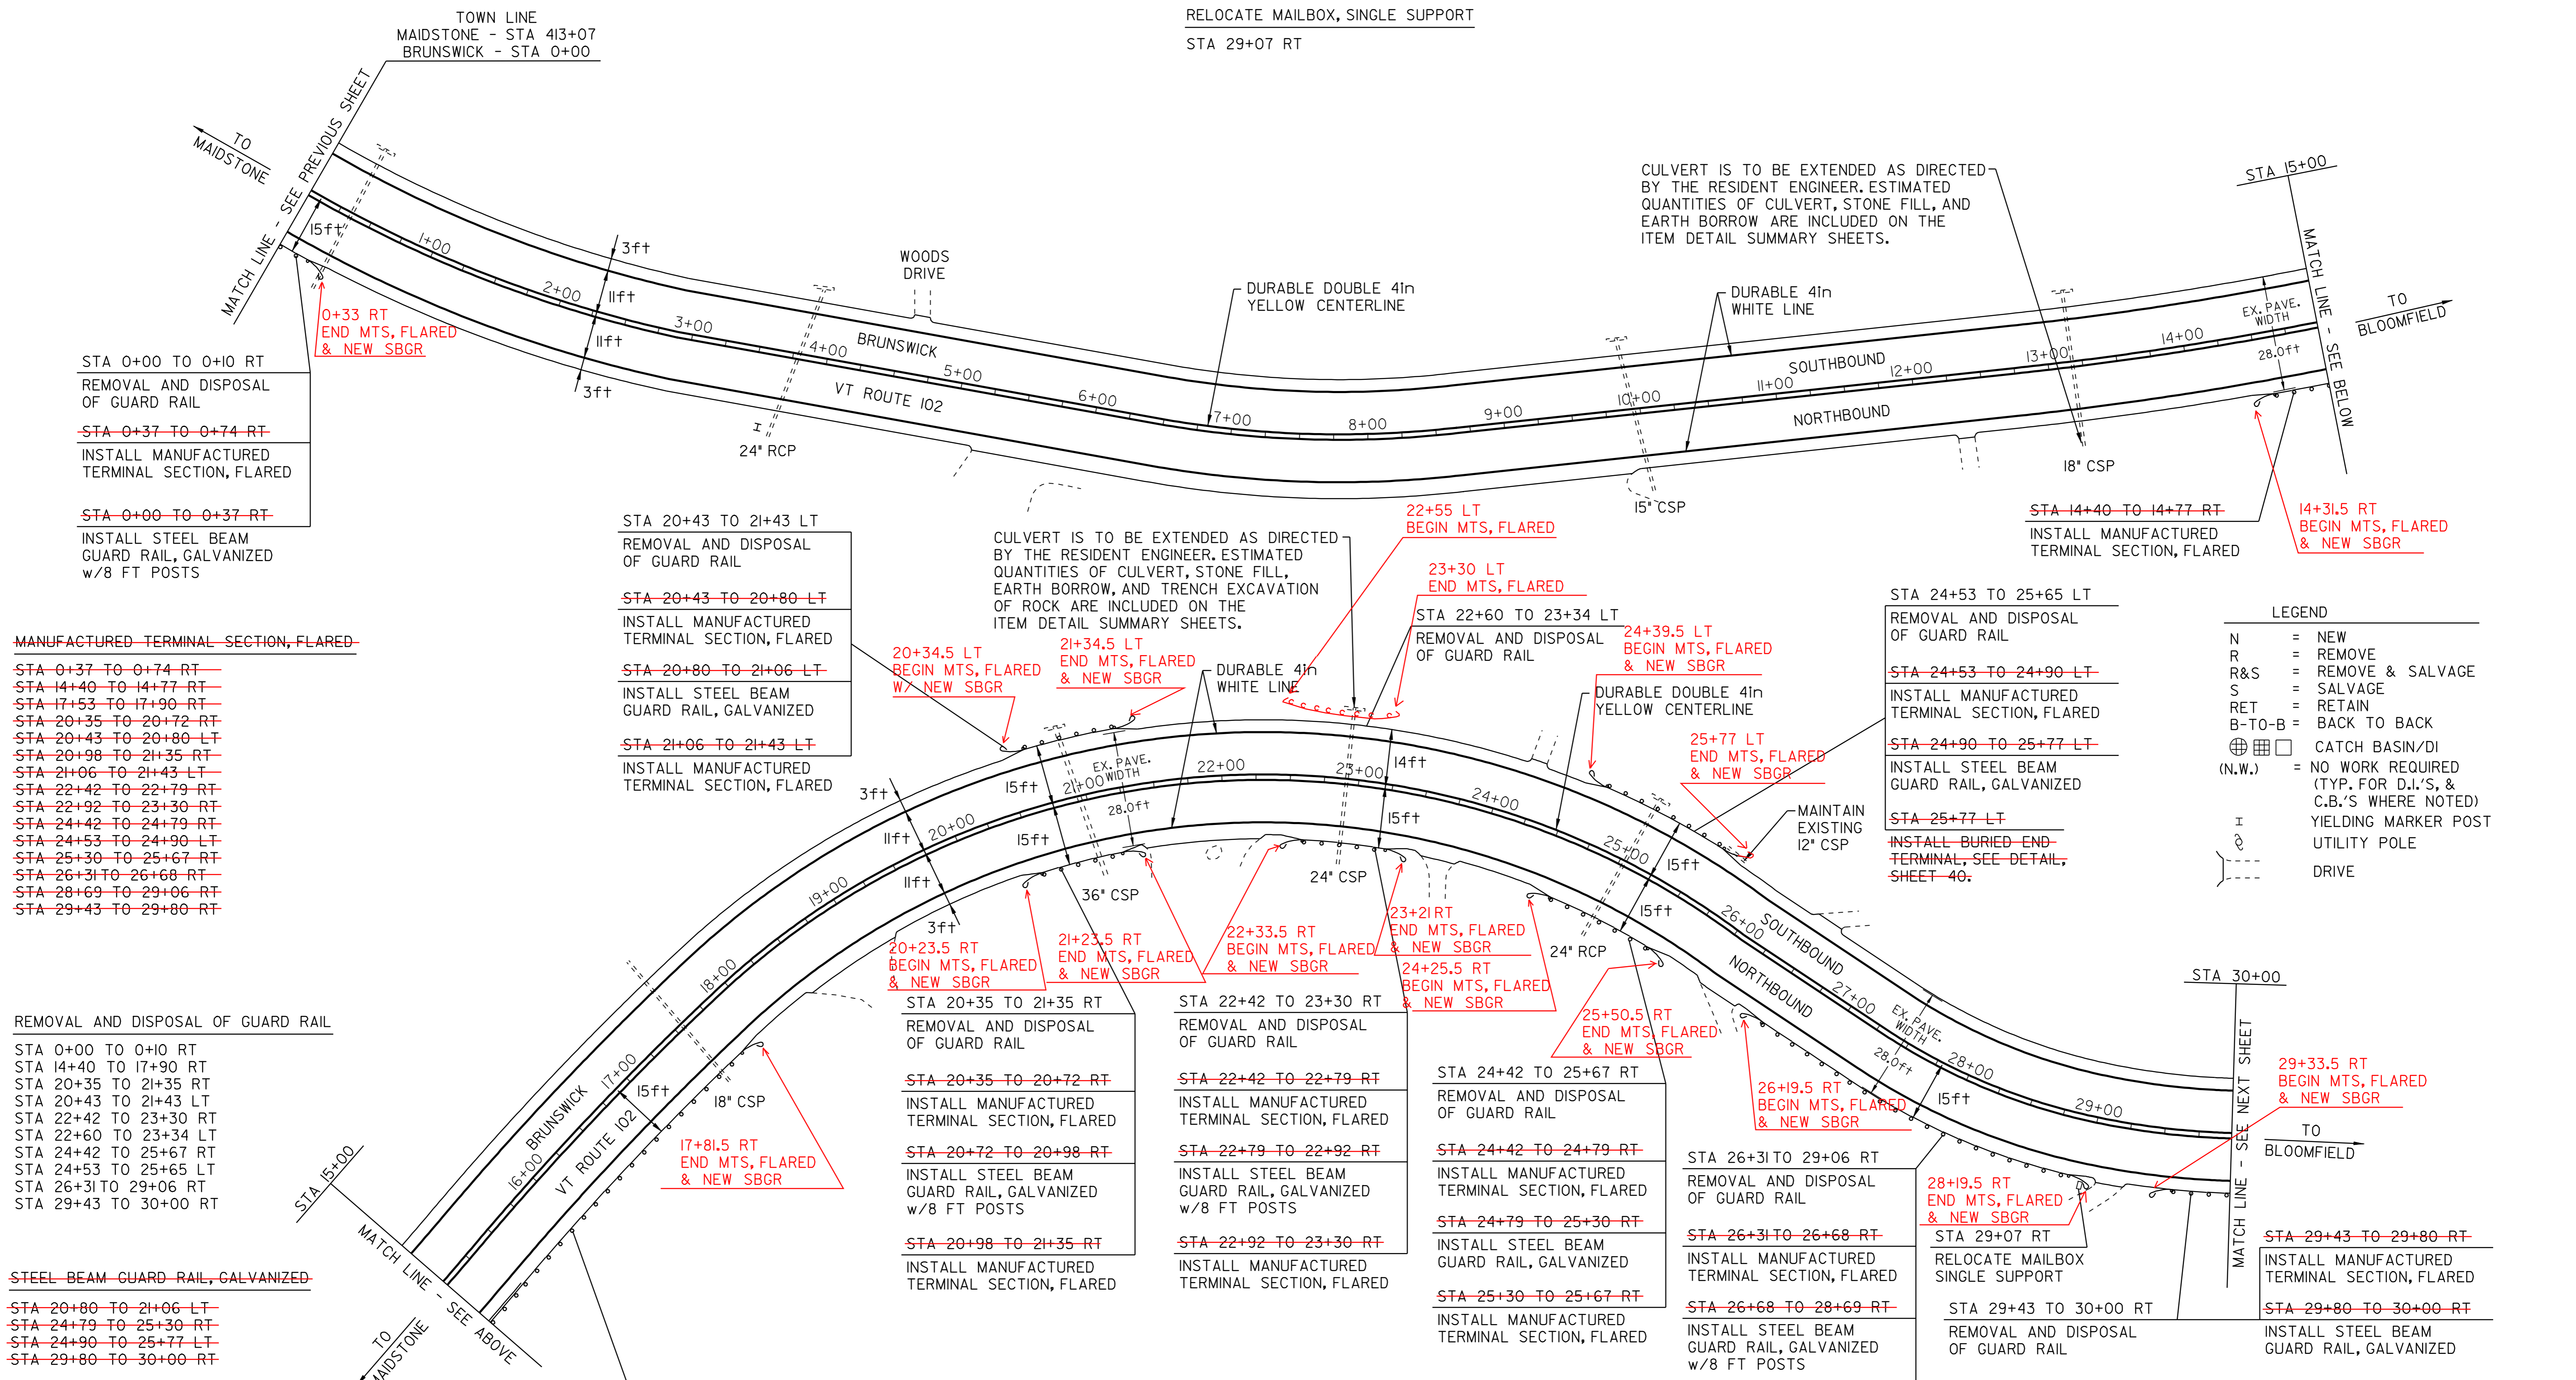

STA 0+00 TO 0+10 RT
REMOVAL AND DISPOSAL
OF GUARD RAIL

~~STA 0+37 TO 0+74 RT~~
INSTALL MANUFACTURED
TERMINAL SECTION, FLARED

~~STA 0+00 TO 0+37 RT~~
INSTALL STEEL BEAM
GUARD RAIL, GALVANIZED
w/8 FT POSTS

~~MANUFACTURED TERMINAL SECTION, FLARED~~

~~STA 0+37 TO 0+74 RT~~
~~STA 14+40 TO 14+77 RT~~
~~STA 17+53 TO 17+90 RT~~
~~STA 20+35 TO 20+72 RT~~
~~STA 20+43 TO 20+80 LT~~
~~STA 20+98 TO 21+35 RT~~
~~STA 21+06 TO 21+43 LT~~
~~STA 22+42 TO 22+79 RT~~
~~STA 22+92 TO 23+30 RT~~
~~STA 24+42 TO 24+79 RT~~
~~STA 24+53 TO 24+90 LT~~
~~STA 25+30 TO 25+67 RT~~
~~STA 26+31 TO 26+68 RT~~
~~STA 28+69 TO 29+06 RT~~
~~STA 29+43 TO 29+80 RT~~

REMOVAL AND DISPOSAL OF GUARD RAIL

STA 0+00 TO 0+10 RT
STA 14+40 TO 17+90 RT
STA 20+35 TO 21+35 RT
STA 20+43 TO 21+43 LT
STA 22+42 TO 23+30 RT
STA 22+60 TO 23+34 LT
STA 24+42 TO 25+67 RT
STA 24+53 TO 25+65 LT
STA 26+31 TO 29+06 RT
STA 29+43 TO 30+00 RT

~~STEEL BEAM GUARD RAIL, GALVANIZED~~

~~STA 20+80 TO 21+06 LT~~
~~STA 24+79 TO 25+30 RT~~
~~STA 24+90 TO 25+77 LT~~
~~STA 29+80 TO 30+00 RT~~

~~STEEL BEAM GUARD RAIL, GALVANIZED w/8 FT POSTS~~

~~STA 0+00 TO 0+37 RT~~
~~STA 14+77 TO 17+53 RT~~
~~STA 20+72 TO 20+98 RT~~
~~STA 22+79 TO 22+92 RT~~
~~STA 26+68 TO 28+69 RT~~

ANCHOR FOR STEEL BEAM RAIL
STA 25+77 LT - 2

STA 20+43 TO 21+43 LT
REMOVAL AND DISPOSAL
OF GUARD RAIL

~~STA 20+43 TO 20+80 LT~~
INSTALL MANUFACTURED
TERMINAL SECTION, FLARED

~~STA 20+80 TO 21+06 LT~~
INSTALL STEEL BEAM
GUARD RAIL, GALVANIZED

STA 21+06 TO 21+43 LT
INSTALL MANUFACTURED
TERMINAL SECTION, FLARED

STA 20+35 TO 21+35 RT
REMOVAL AND DISPOSAL
OF GUARD RAIL

~~STA 20+35 TO 20+72 RT~~
INSTALL MANUFACTURED
TERMINAL SECTION, FLARED

~~STA 20+72 TO 20+98 RT~~
INSTALL STEEL BEAM
GUARD RAIL, GALVANIZED
w/8 FT POSTS

~~STA 20+98 TO 21+35 RT~~
INSTALL MANUFACTURED
TERMINAL SECTION, FLARED

STA 14+40 TO 17+90 RT
REMOVAL AND DISPOSAL
OF GUARD RAIL

~~STA 14+77 TO 17+53 RT~~
INSTALL STEEL BEAM
GUARD RAIL, GALVANIZED
w/8 FT POSTS

~~STA 17+53 TO 17+90 RT~~
INSTALL MANUFACTURED
TERMINAL SECTION, FLARED

CULVERT IS TO BE EXTENDED AS DIRECTED
BY THE RESIDENT ENGINEER. ESTIMATED
QUANTITIES OF CULVERT, STONE FILL,
EARTH BORROW, AND TRENCH EXCAVATION
OF ROCK ARE INCLUDED ON THE
ITEM DETAIL SUMMARY SHEETS.

20+34.5 RT
BEGIN MTS, FLARED
& NEW SBGR

21+34.5 LT
END MTS, FLARED
& NEW SBGR

22+33.5 RT
BEGIN MTS, FLARED
& NEW SBGR

23+21 RT
END MTS, FLARED
& NEW SBGR

24+25.5 RT
BEGIN MTS, FLARED
& NEW SBGR

25+50.5 RT
END MTS, FLARED
& NEW SBGR

26+19.5 RT
BEGIN MTS, FLARED
& NEW SBGR

29+33.5 RT
BEGIN MTS, FLARED
& NEW SBGR

22+42 TO 23+30 RT
REMOVAL AND DISPOSAL
OF GUARD RAIL

~~STA 22+42 TO 22+79 RT~~
INSTALL MANUFACTURED
TERMINAL SECTION, FLARED

~~STA 22+79 TO 22+92 RT~~
INSTALL STEEL BEAM
GUARD RAIL, GALVANIZED
w/8 FT POSTS

~~STA 22+92 TO 23+30 RT~~
INSTALL MANUFACTURED
TERMINAL SECTION, FLARED

22+55 LT
BEGIN MTS, FLARED

23+30 LT
END MTS, FLARED

24+39.5 LT
BEGIN MTS, FLARED
& NEW SBGR

25+77 LT
END MTS, FLARED
& NEW SBGR

24+42 TO 25+67 RT
REMOVAL AND DISPOSAL
OF GUARD RAIL

~~STA 24+42 TO 24+79 RT~~
INSTALL MANUFACTURED
TERMINAL SECTION, FLARED

~~STA 24+79 TO 25+30 RT~~
INSTALL STEEL BEAM
GUARD RAIL, GALVANIZED

~~STA 25+30 TO 25+67 RT~~
INSTALL MANUFACTURED
TERMINAL SECTION, FLARED

STA 24+53 TO 25+65 LT
REMOVAL AND DISPOSAL
OF GUARD RAIL

~~STA 24+53 TO 24+90 LT~~
INSTALL MANUFACTURED
TERMINAL SECTION, FLARED

~~STA 24+90 TO 25+77 LT~~
INSTALL STEEL BEAM
GUARD RAIL, GALVANIZED

~~STA 25+77 LT~~
INSTALL BURIED END
TERMINAL, SEE DETAIL,
SHEET 40.

STA 26+31 TO 29+06 RT
REMOVAL AND DISPOSAL
OF GUARD RAIL

~~STA 26+31 TO 26+68 RT~~
INSTALL MANUFACTURED
TERMINAL SECTION, FLARED

~~STA 26+68 TO 28+69 RT~~
INSTALL STEEL BEAM
GUARD RAIL, GALVANIZED
w/8 FT POSTS

~~STA 28+69 TO 29+06 RT~~
INSTALL MANUFACTURED
TERMINAL SECTION, FLARED

STA 14+40 TO 14+77 RT
INSTALL MANUFACTURED
TERMINAL SECTION, FLARED

14+31.5 RT
BEGIN MTS, FLARED
& NEW SBGR

STA 29+07 RT
RELOCATE MAILBOX
SINGLE SUPPORT

STA 29+43 TO 30+00 RT
REMOVAL AND DISPOSAL
OF GUARD RAIL

LEGEND

N	=	NEW
R	=	REMOVE
R&S	=	REMOVE & SALVAGE
S	=	SALVAGE
RET	=	RETAIN
B-TO-B	=	BACK TO BACK
⊕	=	CATCH BASIN/DI
(N.W.)	=	NO WORK REQUIRED (TYP. FOR D.I.'S, & C.B.'S WHERE NOTED)
I	=	UTILITY POLE
---	=	DRIVE

PAVING PROJECT LAYOUT SHEET #10

DESIGNED BY	BCE/PJM	DATE	10-06
DRAWN BY	C.E.A., INC.	DATE	10-06
DESIGN FILE NO.	06c042.dgn		
PRF FILE	06c042p10.I	DATE PLOTTED	24-AUG-2009
PROJ. NAME	MAIDSTONE - BLOOMFIELD		
PROJ. NO.	STP 2609(1)S		
SHEET	20	OF	40 SHEETS

TEMPORARY 4in YELLOW LINE (PAINT)
 DURABLE 4in YELLOW LINE (THERMOPLASTIC)
 STA 30+00 TO 60+00 SOLID LT&RT

TEMPORARY 4in WHITE LINE (PAINT)
 DURABLE 4in WHITE LINE (THERMOPLASTIC)
 STA 30+00 TO 60+00 SOLID LT&RT

DITCHING LOCATIONS (REFER TO SHEET 10 FOR DETAILS)

STA 38+50 TO 48+75 LT
 STA 56+50 TO 60+00 LT

STA 35+18 TO 36+68 LT
 REMOVAL AND DISPOSAL
 OF GUARD RAIL
~~STA 35+18 TO 35+55 LT~~
 INSTALL MANUFACTURED
 TERMINAL SECTION, FLARED
~~STA 35+55 TO 36+31LT~~
 INSTALL STEEL BEAM
 GUARD RAIL, GALVANIZED
~~STA 36+31 TO 36+68 LT~~
 INSTALL MANUFACTURED
 TERMINAL SECTION, FLARED

35+02.5 LT
 BEGIN MTS, FLARED
 & NEW SBGR

36+52.5 LT
 END MTS, FLARED
 & NEW SBGR

36+33.5 RT
 END MTS, FLARED
 & NEW SBGR

STA 30+00 TO 36+43 RT
 REMOVAL AND DISPOSAL
 OF GUARD RAIL
~~STA 30+00 TO 34+56 RT~~
 INSTALL STEEL BEAM
 GUARD RAIL, GALVANIZED
~~STA 34+56 TO 36+06 RT~~
 INSTALL STEEL BEAM
 GUARD RAIL, GALVANIZED
 w/8 FT POSTS
~~STA 36+06 TO 36+43 RT~~
 INSTALL MANUFACTURED
 TERMINAL SECTION, FLARED

~~STA 47+83 TO 51+58 RT~~
 INSTALL STEEL BEAM
 GUARD RAIL, GALVANIZED

~~STA 47+46 TO 47+83 RT~~
 INSTALL MANUFACTURED
 TERMINAL SECTION, FLARED

47+21.5 RT
 BEGIN MTS, FLARED
 & NEW SBGR

~~STA 51+58 TO 60+00 RT~~
 INSTALL STEEL BEAM
 GUARD RAIL, GALVANIZED
 w/8 FT POSTS

56+49
 STA 57+60 TO 60+00 RT
 INSTALL TREATED
 TIMBER CURB

REMOVAL AND DISPOSAL OF GUARD RAIL
 STA 30+00 TO 36+43 RT
 STA 35+18 TO 36+68 LT
 STA 47+46 TO 60+00 RT

~~STEEL BEAM GUARD RAIL, GALVANIZED~~
~~STA 30+00 TO 34+56 RT~~
~~STA 35+55 TO 36+31LT~~
~~STA 47+83 TO 51+58 RT~~

STA 47+46 TO 60+00 RT
 REMOVAL AND DISPOSAL
 OF GUARD RAIL

~~MANUFACTURED TERMINAL SECTION, FLARED~~
~~STA 36+06 TO 36+43 RT~~
~~STA 35+18 TO 35+55 LT~~
~~STA 36+31 TO 36+68 LT~~
~~STA 47+46 TO 47+83 RT~~


~~STEEL BEAM GUARD RAIL, GALVANIZED w/8 FT POSTS~~
~~STA 34+56 TO 36+06 RT~~
~~STA 51+58 TO 60+00 RT~~
 TREATED TIMBER CURB
 STA 57+60 TO 60+00 RT
 56+49

LEGEND

- N = NEW
- R = REMOVE
- R&S = REMOVE & SALVAGE
- S = SALVAGE
- RET = RETAIN
- B-TO-B = BACK TO BACK
- ☐ = CATCH BASIN/DI
- (N.W.) = NO WORK REQUIRED (TYP. FOR D.I.'S, & C.B.'S WHERE NOTED)
- I = YIELDING MARKER POST
- ⊕ = UTILITY POLE
- = DRIVE

**PAVING
 PROJECT
 LAYOUT
 SHEET #11**

DESIGNED BY BCE/PJM DATE 10-06
 DRAWN BY C.E.A., INC. DATE 10-06
 DESIGN FILE NO. 06c042.dgn
 PRF FILE 06c042pl1.i DATE PLOTTED 24-AUG-2009
 PROJ. NAME **MAIDSTONE - BLOOMFIELD**
 PROJ. NO. **STP 2609(1)S**
 SHEET **21** OF **40** SHEETS

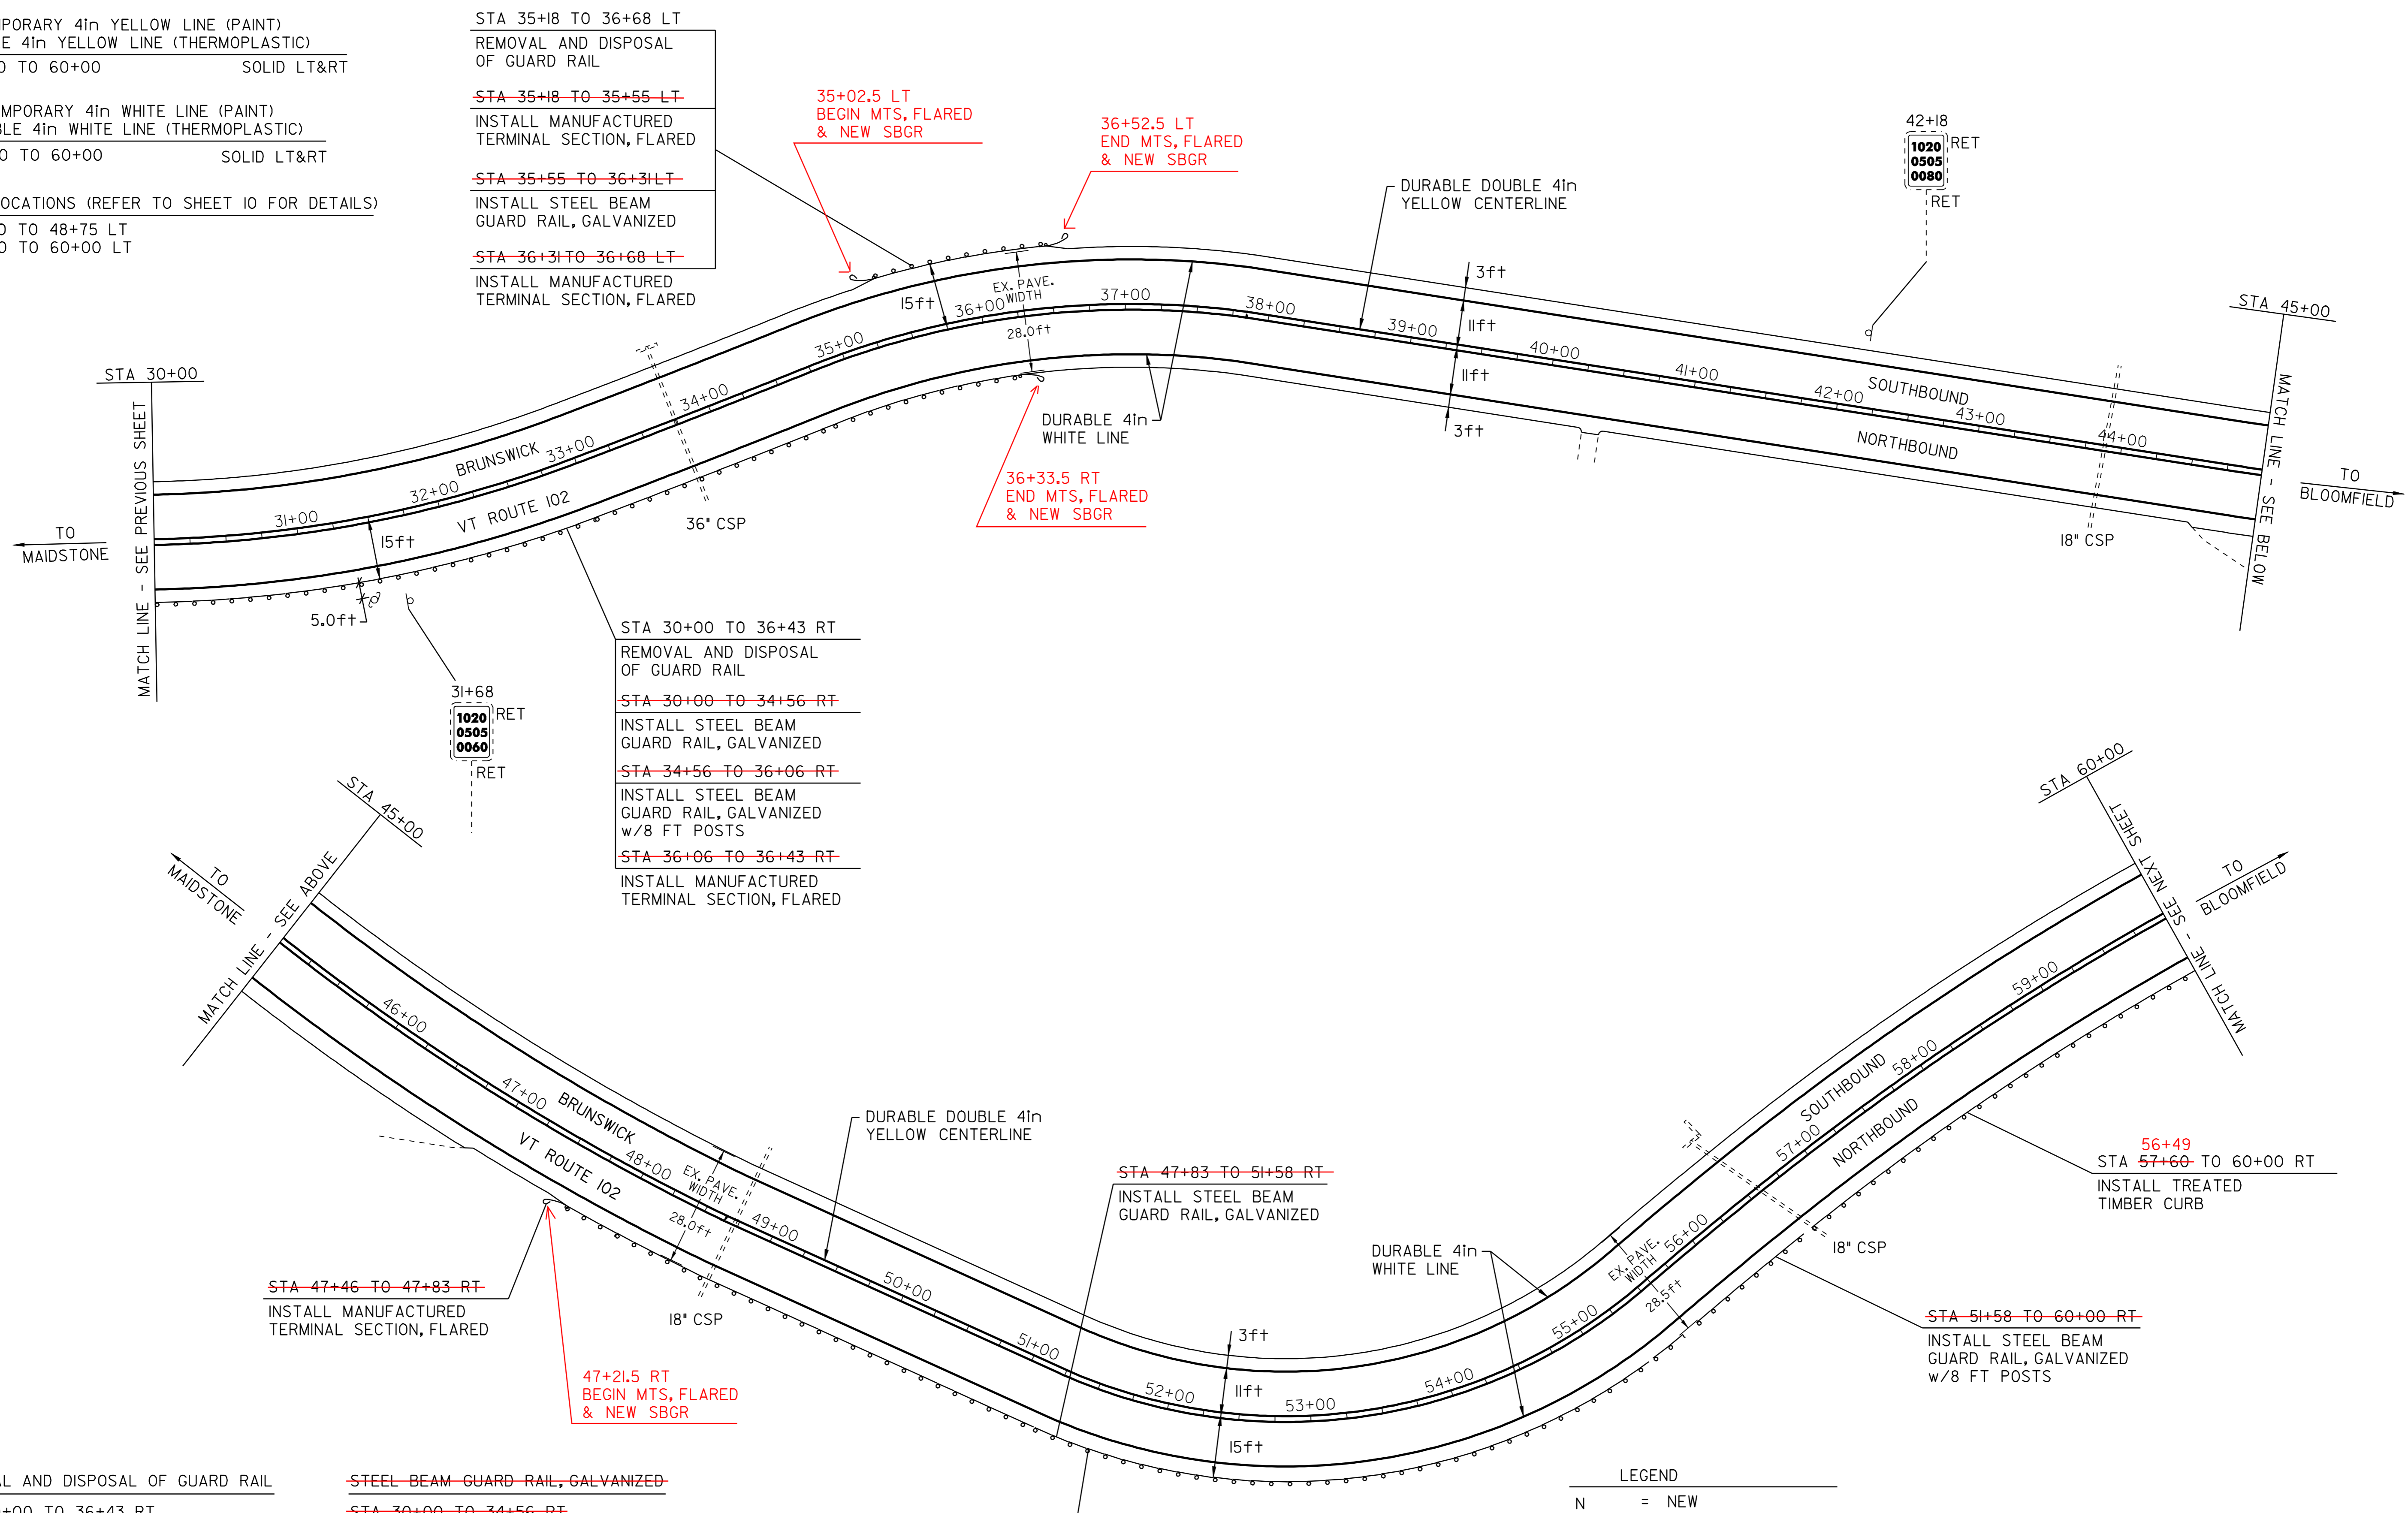

TEMPORARY 4in YELLOW LINE (PAINT)
DURABLE 4in YELLOW LINE (THERMOPLASTIC)

STA 60+00 TO 68+11 SOLID LT&RT
STA 68+11 TO 74+71 SOLID LT & DASHED RT
STA 74+71 TO 75+77 SOLID LT&RT
STA 75+77 TO 82+10 DASHED LT & SOLID RT
STA 82+10 TO 90+00 SOLID LT&RT

TEMPORARY 4in WHITE LINE (PAINT)
DURABLE 4in WHITE LINE (THERMOPLASTIC)

STA 60+00 TO 90+00 SOLID LT&RT

DITCHING LOCATIONS (REFER TO SHEET 10 FOR DETAILS)

STA 60+00 TO 64+00 LT
STA 70+75 TO 72+80 LT


STA 66+01 TO 69+38 LT
REMOVAL AND DISPOSAL OF GUARD RAIL

~~STA 66+01 TO 66+38 LT~~
INSTALL MANUFACTURED TERMINAL SECTION, FLARED

STA 66+38 TO 69+01 LT
INSTALL STEEL BEAM GUARD RAIL, GALVANIZED

~~STA 69+01 TO 69+38 LT~~
INSTALL MANUFACTURED TERMINAL SECTION, FLARED

YIELDING MARKER POST
STA 70+75 LT
STA 72+79 LT

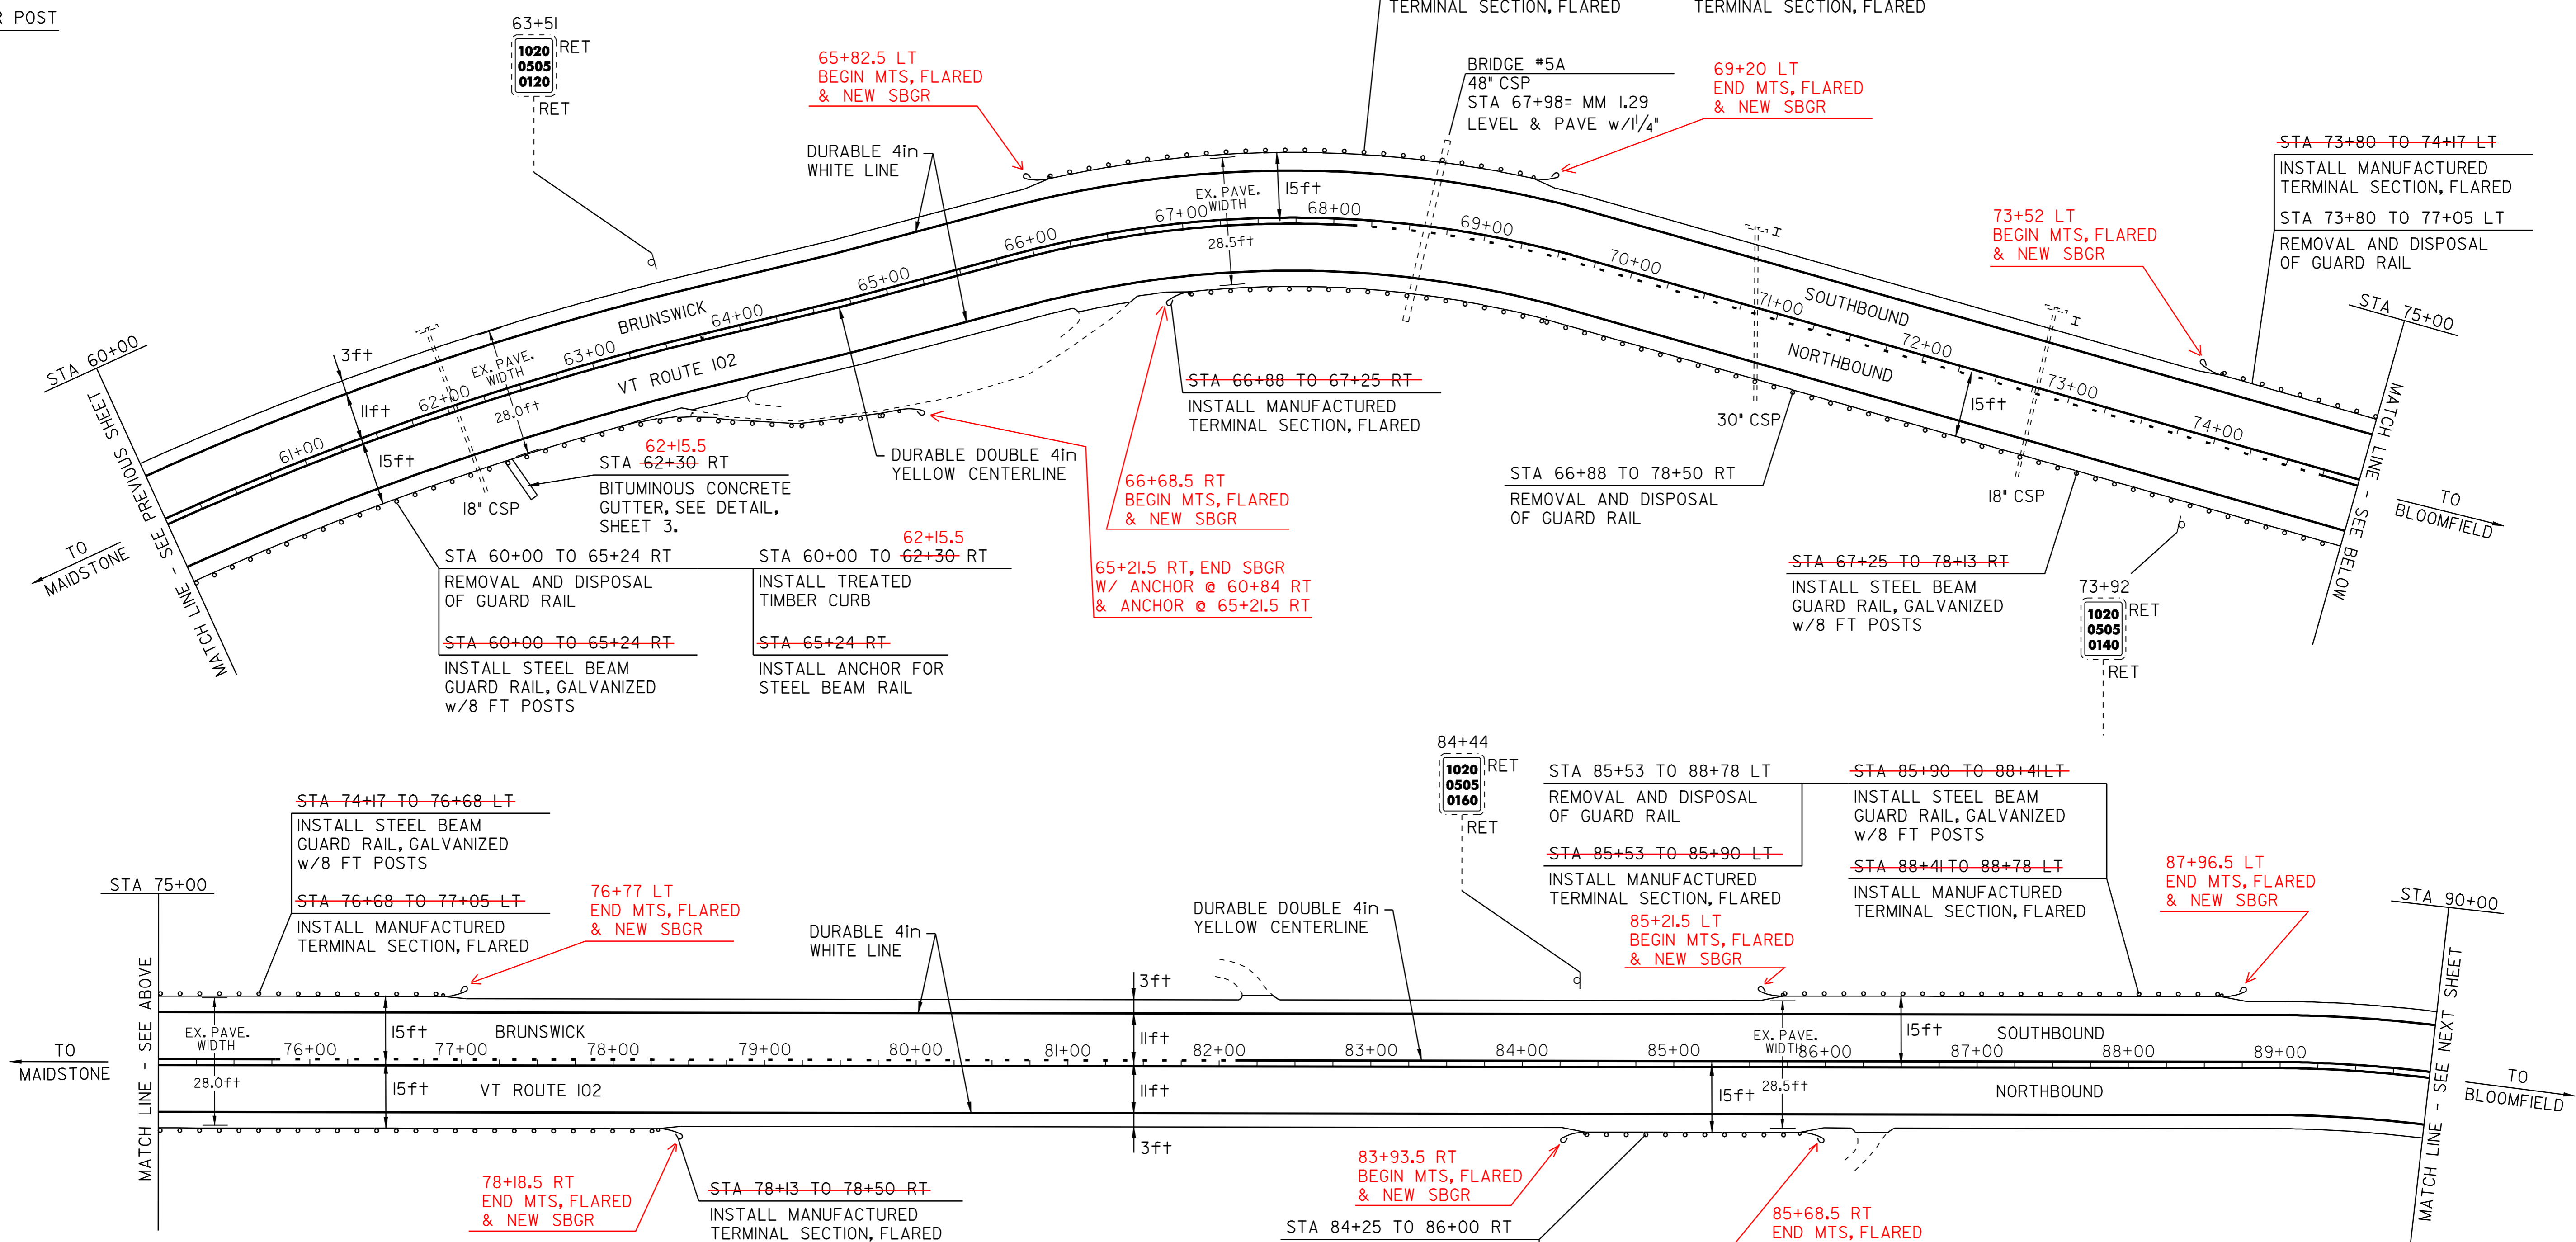

REMOVAL AND DISPOSAL OF GUARD RAIL

STA 60+00 TO 65+24 RT
STA 66+01 TO 69+38 LT
STA 66+88 TO 78+50 RT
STA 73+80 TO 77+05 LT
STA 84+25 TO 86+00 RT
STA 85+53 TO 88+78 LT

STEEL BEAM GUARD RAIL, GALVANIZED w/8 ft POSTS

~~STA 60+00 TO 65+24 RT~~
~~STA 67+25 TO 78+13 RT~~
~~STA 74+71 TO 76+68 LT~~
~~STA 85+90 TO 88+41 LT~~

MANUFACTURED TERMINAL SECTION, FLARED

~~STA 66+01 TO 66+38 LT~~
~~STA 66+88 TO 67+25 RT~~
~~STA 69+01 TO 69+38 LT~~
~~STA 73+80 TO 74+17 LT~~
~~STA 76+68 TO 77+05 LT~~
~~STA 78+13 TO 78+50 RT~~
~~STA 84+25 TO 84+62 RT~~
~~STA 85+53 TO 85+90 LT~~
~~STA 85+63 TO 86+00 RT~~
~~STA 88+41 TO 88+78 LT~~

STEEL BEAM GUARD RAIL, GALVANIZED

~~STA 66+38 TO 69+01 LT~~
~~STA 84+62 TO 85+63 RT~~

ANCHOR FOR STEEL BEAM RAIL

STA 65+24 RT

TREATED TIMBER CURB

STA 60+00 TO 62+30 RT
62+15.5

BITUMINOUS CONCRETE GUTTER (SEE DETAIL, SHEET 3)

STA 62+30 RT (30' LONG)
62+15.5

STA 84+25 TO 86+00 RT
REMOVAL AND DISPOSAL OF GUARD RAIL

~~STA 84+25 TO 84+62 RT~~
INSTALL MANUFACTURED TERMINAL SECTION, FLARED

~~STA 84+62 TO 85+63 RT~~
INSTALL STEEL BEAM GUARD RAIL, GALVANIZED

~~STA 85+63 TO 86+00 RT~~
INSTALL MANUFACTURED TERMINAL SECTION, FLARED

LEGEND

N = NEW
R = REMOVE
R&S = REMOVE & SALVAGE
S = SALVAGE
RET = RETAIN
B-TO-B = BACK TO BACK
⊕ □ = CATCH BASIN/DI (N.W.) = NO WORK REQUIRED (TYP. FOR D.I.'S, & C.B.'S WHERE NOTED)
I = YIELDING MARKER POST
⊕ = UTILITY POLE
--- = DRIVE

PAVING PROJECT LAYOUT SHEET #12

DESIGNED BY	BCE/PJM	DATE	10-06
DRAWN BY	C.E.A., INC.	DATE	10-06
DESIGN FILE NO.	06c042.dgn		
PRF FILE	06c042pl2.i	DATE PLOTTED	24-AUG-2009
PROJ. NAME	MAIDSTONE - BLOOMFIELD		
PROJ. NO.	STP 2609(1)S		
SHEET	22	OF	40 SHEETS

TEMPORARY 4in YELLOW LINE (PAINT)
DURABLE 4in YELLOW LINE (THERMOPLASTIC)
STA 120+00 TO 150+00
SOLID LT&RT

TEMPORARY 4in WHITE LINE (PAINT)
DURABLE 4in WHITE LINE (THERMOPLASTIC)
STA 120+00 TO 150+00
SOLID LT&RT

YIELDING MARKER POST
STA 120+50 LT

REMOVING SIGNS
9

H.D. STEEL BEAM GUARD RAIL, GALVANIZED
STA 136+33 TO 136+58 LT
STA 136+41 TO 136+66 RT
STA 137+70 TO 137+95 LT
STA 137+84 TO 138+09 RT

REMOVAL OF EXISTING RAILING
STA 136+58 TO 137+70 LT
STA 136+66 TO 137+84 RT

SPECIAL PROVISION (BRIDGE RAILING REPAIR, TYPE II)
STA 136+58 TO 137+70 LT
STA 136+66 TO 137+84 RT

REMOVAL AND DISPOSAL OF GUARD RAIL
STA 120+00 TO 122+40 RT
STA 126+03 TO 128+78 RT
STA 126+94 TO 128+94 LT
STA 128+96 TO 130+71 RT
STA 134+79 TO 136+66 RT
STA 135+83 TO 136+58 LT
STA 137+70 TO 138+08 LT
STA 137+84 TO 138+34 RT

~~MANUFACTURED TERMINAL SECTION, FLARED~~
~~STA 122+03 TO 122+40 RT~~
~~STA 126+03 TO 126+40 RT~~
~~STA 126+94 TO 127+31 LT~~
~~STA 128+41 TO 128+78 RT~~
~~STA 128+57 TO 128+94 LT~~
~~STA 128+96 TO 129+33 RT~~
~~STA 130+34 TO 130+71 RT~~
~~STA 134+79 TO 135+16 RT~~
~~STA 135+83 TO 136+20 LT~~
~~STA 138+09 TO 138+46 RT~~

~~STEEL BEAM GUARD RAIL, GALVANIZED~~
~~STA 120+00 TO 122+03 RT~~
~~STA 126+40 TO 128+41 RT~~
~~STA 127+31 TO 128+57 LT~~
~~STA 129+33 TO 130+34 RT~~
~~STA 136+20 TO 136+33 LT~~
~~STA 137+95 TO 138+08 LT~~

~~STEEL BEAM GUARD RAIL, GALVANIZED w/8 FT POSTS~~
~~STA 135+16 TO 136+41 RT~~

STA 126+94 TO 128+94 LT
REMOVAL AND DISPOSAL OF GUARD RAIL
STA 126+94 TO 127+31 LT
INSTALL MANUFACTURED TERMINAL SECTION, FLARED

STA 127+31 TO 128+57 LT
INSTALL STEEL BEAM GUARD RAIL, GALVANIZED
STA 128+57 TO 128+94 LT
INSTALL MANUFACTURED TERMINAL SECTION, FLARED

~~ANCHOR FOR STEEL BEAM RAIL~~
~~STA 138+08 LT~~

RELOCATE MAILBOX, SINGLE SUPPORT
STA 129+40 RT
STA 138+40 RT

226+45.5 LT
BEGIN MTS, FLARED & NEW SBGR

128+45.5 LT
END MTS, FLARED & NEW SBGR

134+23.75 RT
BEGIN MTS, FLARED

130+25.5 RT
END MTS, FLARED & NEW SBGR

128+50.5 RT
BEGIN MTS, FLARED & NEW SBGR

128+34.5 RT
END MTS, FLARED & NEW SBGR

122+11 RT
END MTS, FLARED & NEW SBGR

125+59.5 RT
BEGIN MTS, FLARED & NEW SBGR

137+50 LT
END SBGR W/ ANCHOR

137+73.75 RT
END MTS, FLARED



STA 120+00 TO 122+40 RT
REMOVAL AND DISPOSAL OF GUARD RAIL
STA 120+00 TO 122+03 RT
INSTALL STEEL BEAM GUARD RAIL, GALVANIZED
STA 122+03 TO 122+40 RT
INSTALL MANUFACTURED TERMINAL SECTION, FLARED

STA 135+83 TO 136+58 LT
REMOVAL AND DISPOSAL OF GUARD RAIL
STA 135+83 TO 136+20 LT
INSTALL MANUFACTURED TERMINAL SECTION, FLARED
STA 136+20 TO 136+33 LT
INSTALL STEEL BEAM GUARD RAIL, GALVANIZED
STA 136+33 TO 136+58 LT
INSTALL H.D. STEEL BEAM GUARD RAIL, GALVANIZED
STA 136+58 TO 137+70 LT
REMOVAL OF EXISTING RAILING

BRIDGE #6
STA 137+15 = MM 2.60 (FIELD MEASURED)
COLD PLANE 1/4", & PAVE 1/4"

STA 135+00 TO 136+58 RT
REMOVAL AND DISPOSAL OF GUARD RAIL
STA 136+58 TO 137+70 RT
RELOCATE MAILBOX, SINGLE SUPPORT

STA 134+79 TO 136+66 RT
REMOVAL AND DISPOSAL OF GUARD RAIL
STA 134+79 TO 135+16 RT
INSTALL MANUFACTURED TERMINAL SECTION, FLARED
STA 135+16 TO 136+41 RT
INSTALL STEEL BEAM GUARD RAIL, GALVANIZED w/8 FT POSTS

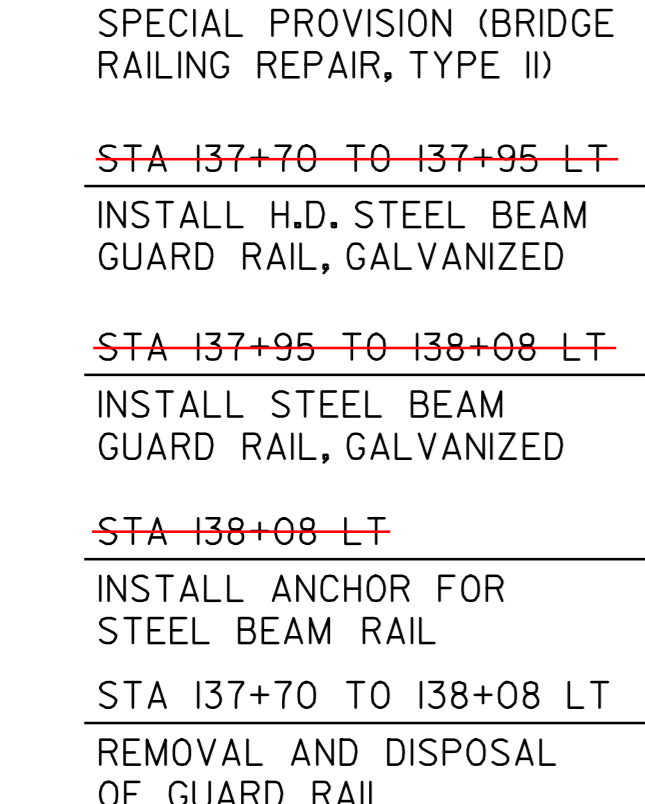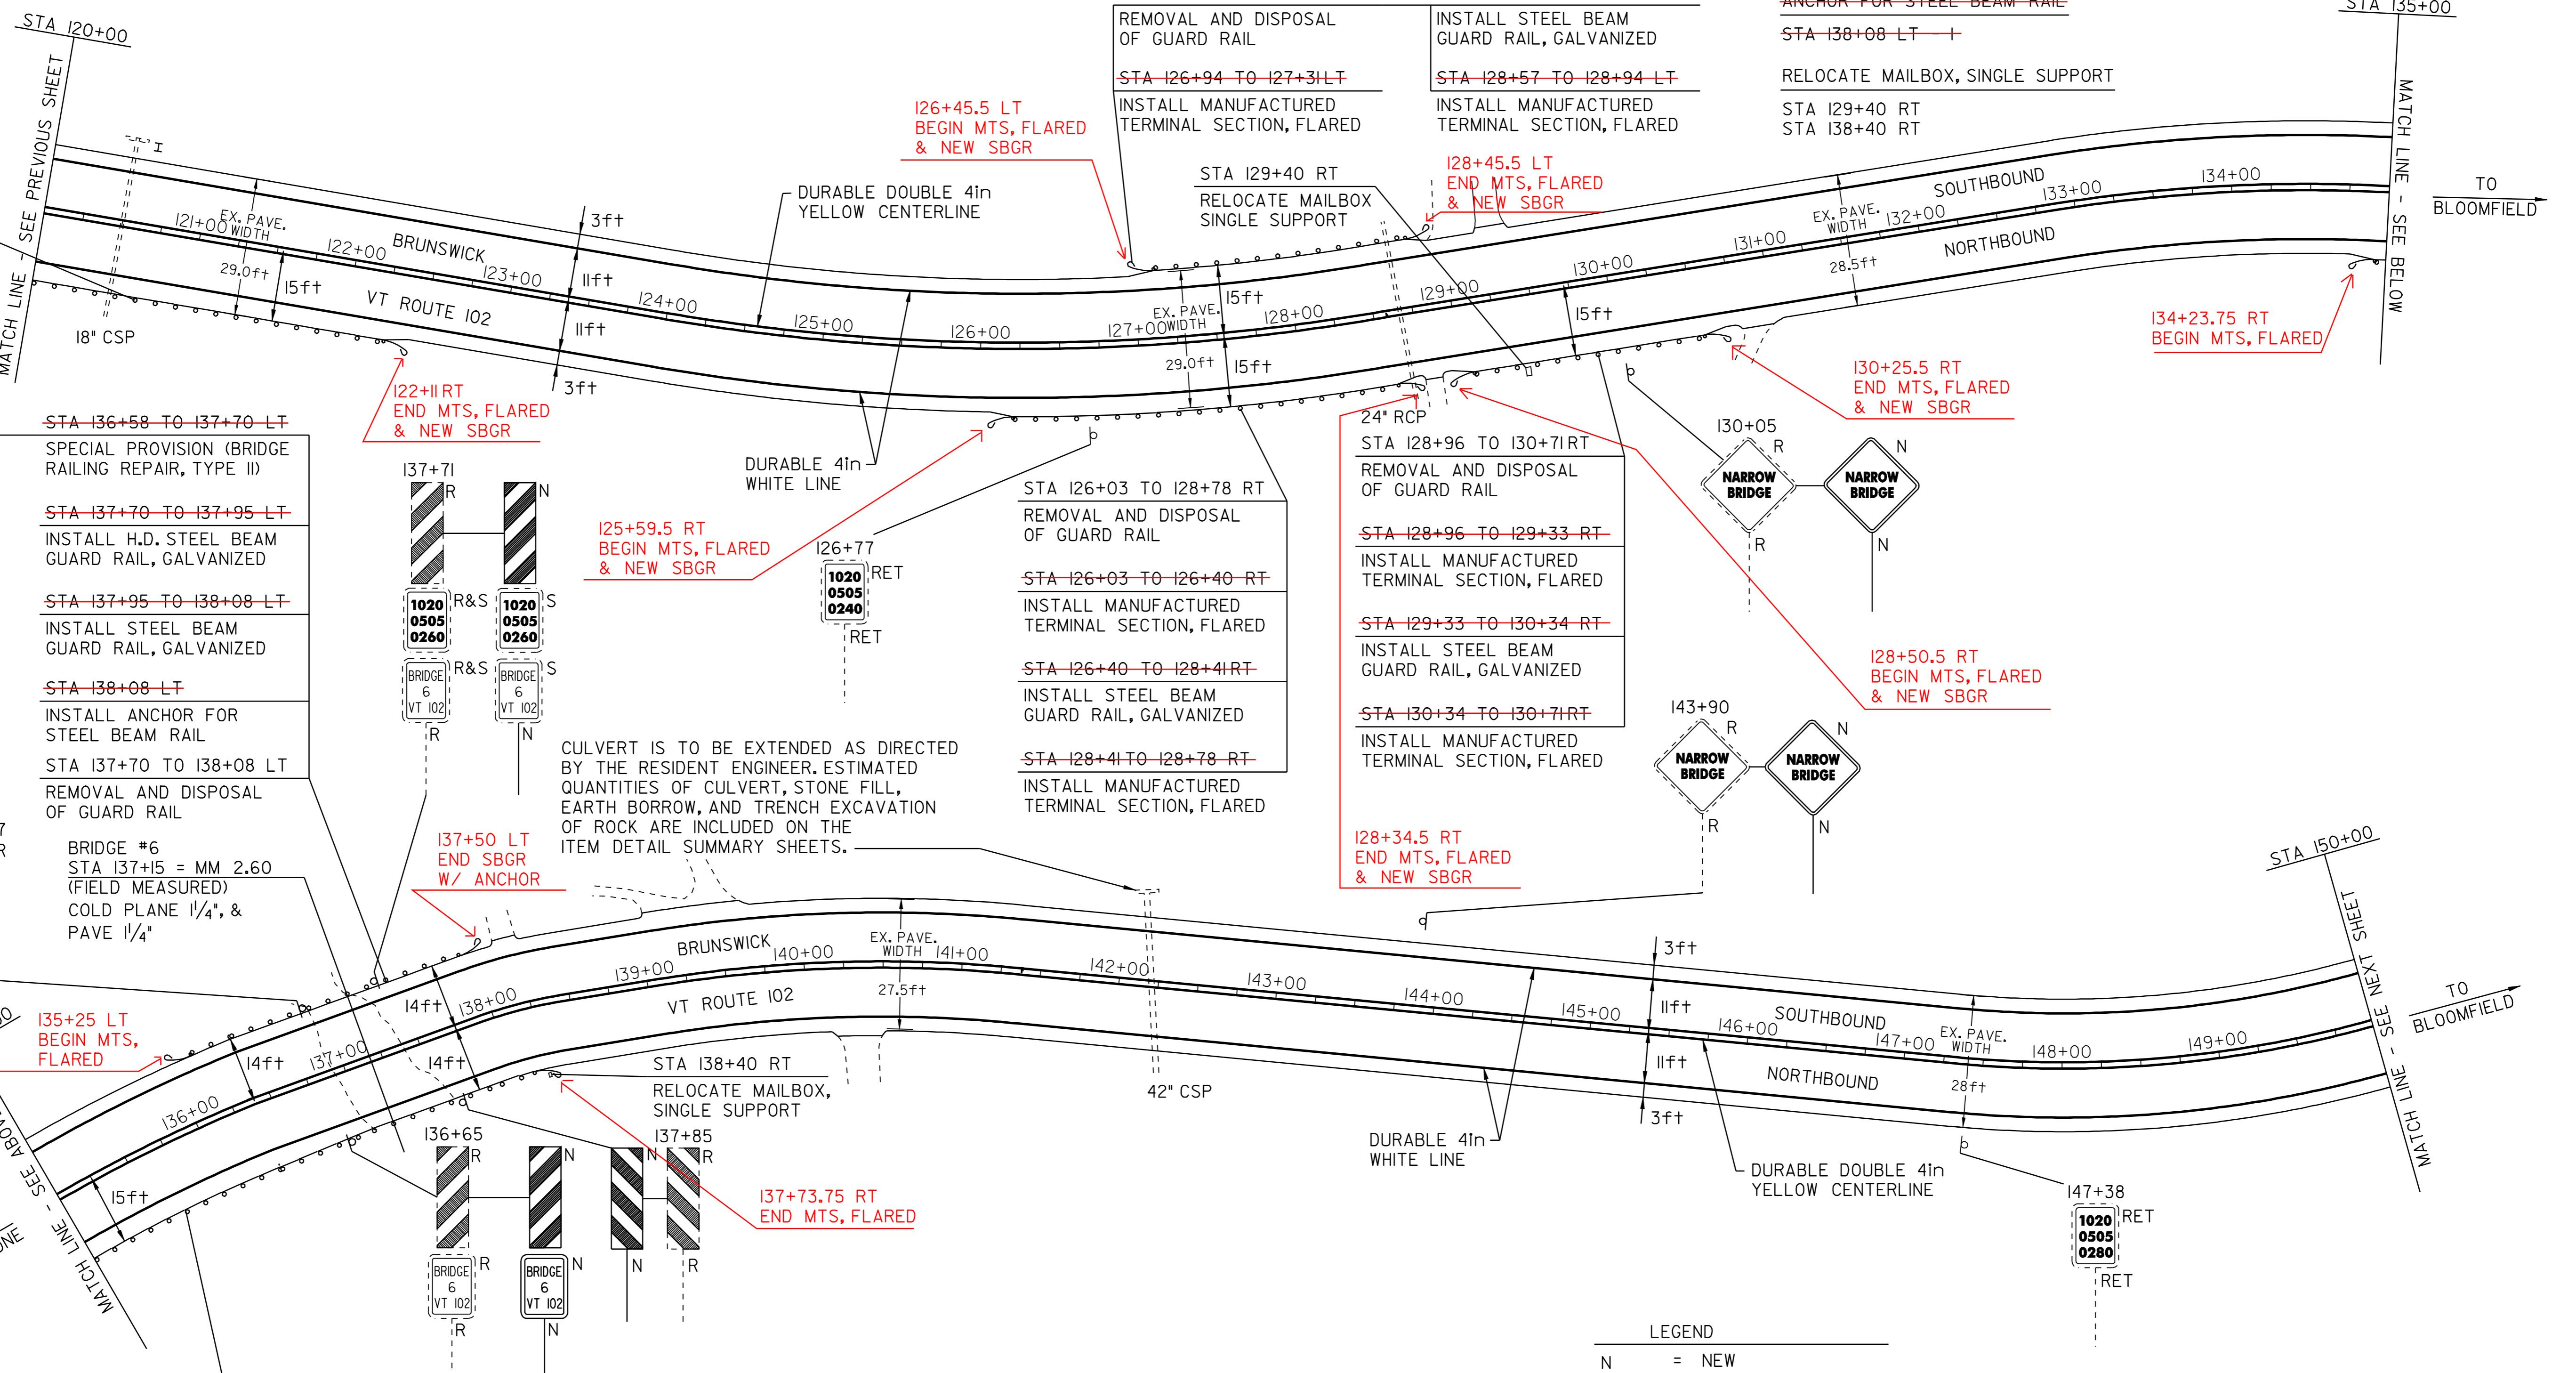

- LEGEND
- N = NEW
 - R = REMOVE
 - R&S = REMOVE & SALVAGE
 - S = SALVAGE
 - RET = RETAIN
 - B-T-O-B = BACK TO BACK
 - ⊕ ⊞ ⊠ = CATCH BASIN/DI (N.W.) = NO WORK REQUIRED (TYP. FOR D.I.'S, & C.B.'S WHERE NOTED)
 - I = YIELDING MARKER POST
 - ⊙ = UTILITY POLE
 - = DRIVE

PAVING PROJECT LAYOUT SHEET #14

DESIGNED BY BCE/PJM DATE 10-06

DRAWN BY C.E.A., INC. DATE 10-06

DESIGN FILE NO. 06c042.dgn

PRF FILE 06c042p14.l DATE PLOTTED 24-AUG-2009

PROJ. NAME **MAIDSTONE - BLOOMFIELD**

PROJ. NO. **STP 2609(1)S**

SHEET **24** OF **40** SHEETS

TEMPORARY 4in YELLOW LINE (PAINT)
 DURABLE 4in YELLOW LINE (THERMOPLASTIC)

STA 150+00 TO 162+62 SOLID LT&RT
 STA 162+62 TO 170+02 SOLID LT & DASHED RT
 STA 170+02 TO 170+54 DASHED
 STA 170+54 TO 177+94 DASHED LT & SOLID RT
 STA 177+94 TO 180+00 SOLID LT&RT



TEMPORARY 4in WHITE LINE (PAINT)
 DURABLE 4in WHITE LINE (THERMOPLASTIC)

STA 150+00 TO 180+00 SOLID LT&RT

DITCHING LOCATIONS (REFER TO SHEET 10 FOR DETAILS)

STA 150+00 TO 152+00 LT
 STA 157+25 TO 158+75 LT

RELOCATE MAILBOX, SINGLE SUPPORT
 STA 156+95 RT

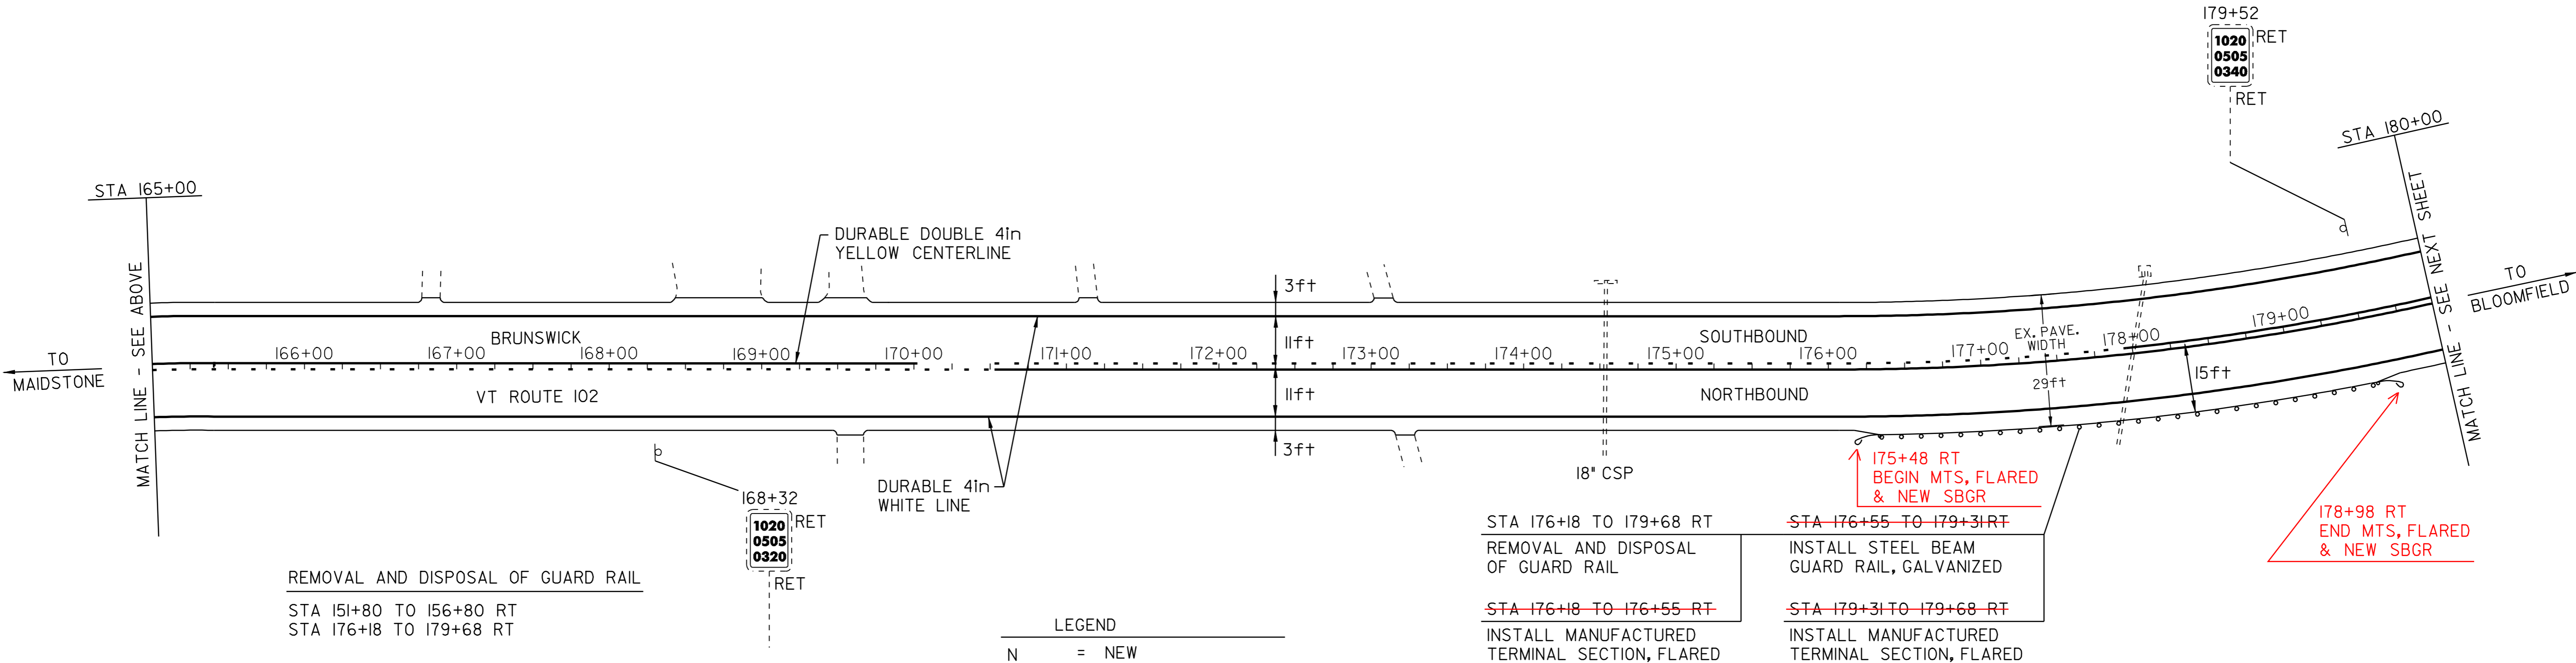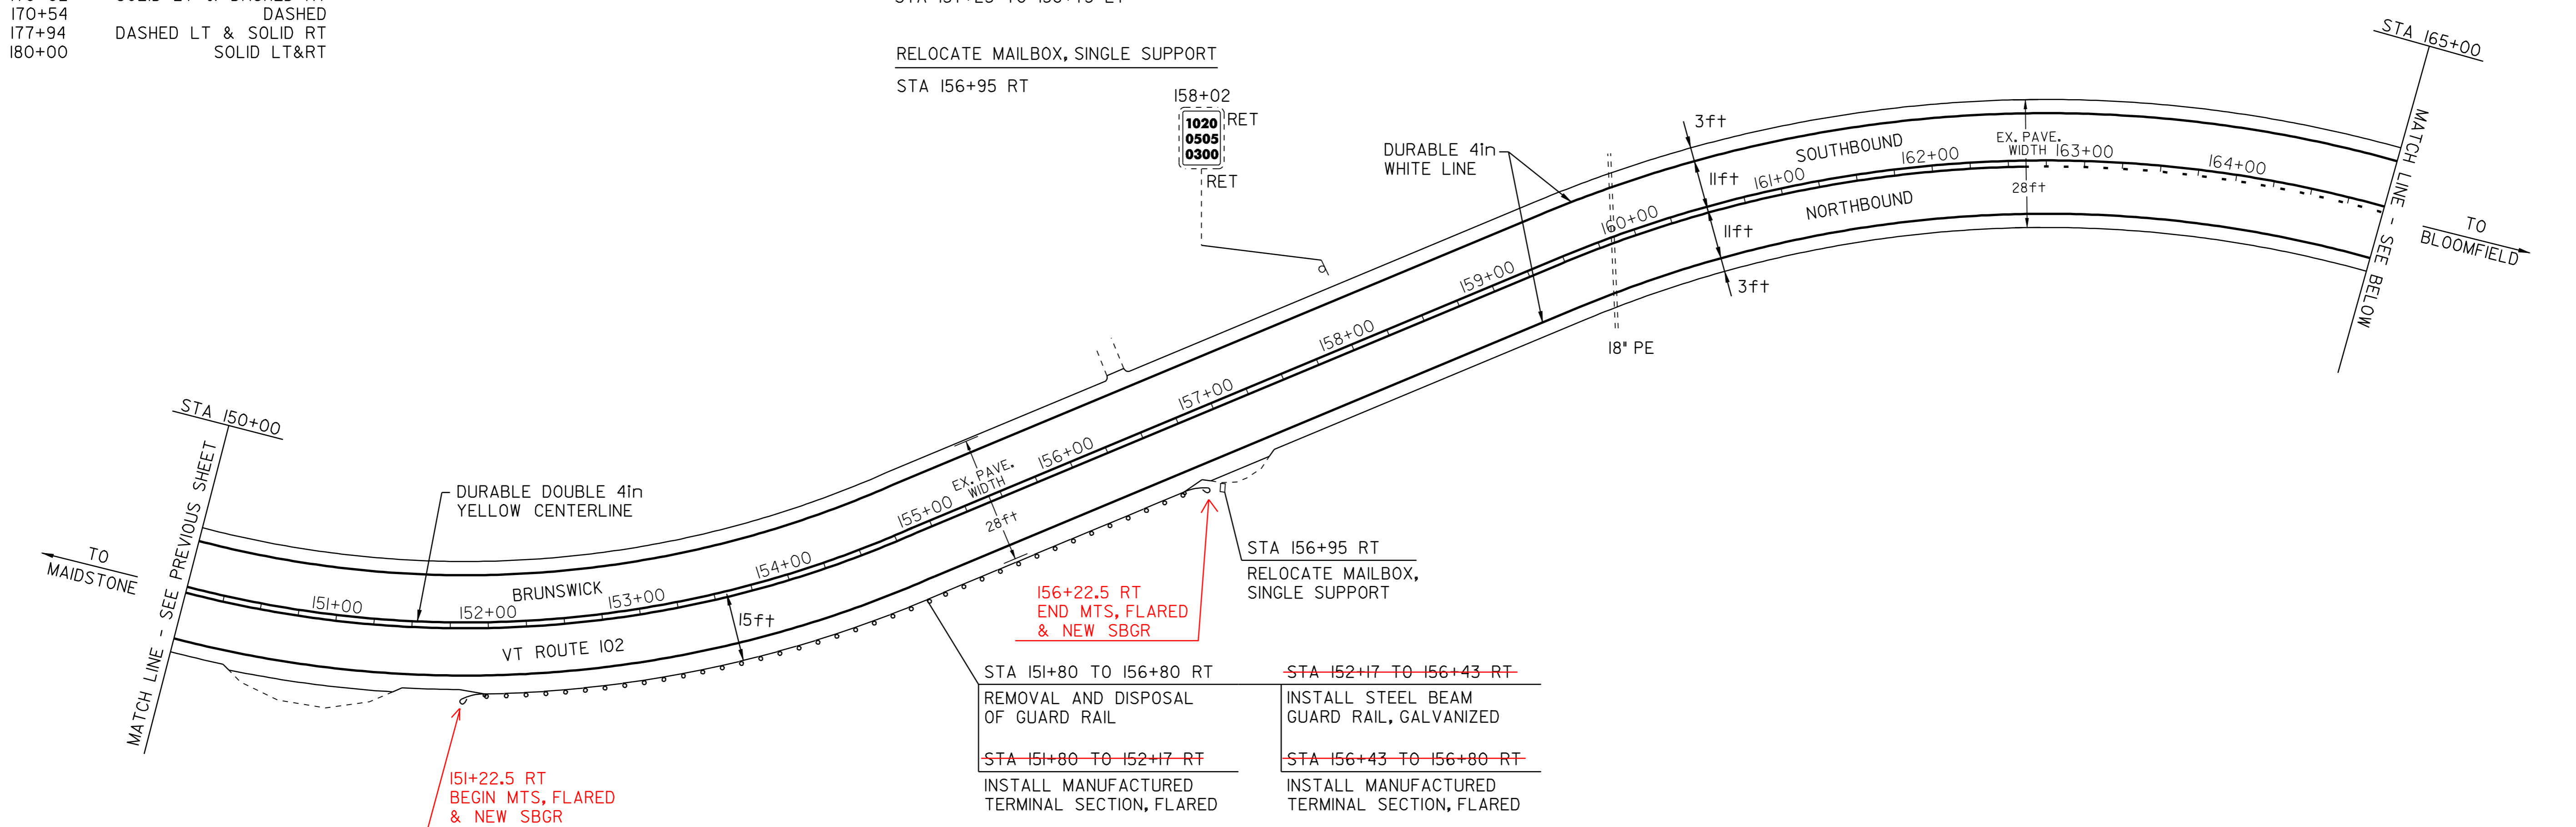

REMOVAL AND DISPOSAL OF GUARD RAIL
 STA 151+80 TO 156+80 RT
 STA 176+18 TO 179+68 RT

~~MANUFACTURED TERMINAL SECTION, FLARED~~
~~STA 151+80 TO 152+17 RT~~
~~STA 156+43 TO 156+80 RT~~
~~STA 176+18 TO 176+55 RT~~
~~STA 179+31 TO 179+68 RT~~

STEEL BEAM GUARD RAIL, GALVANIZED
 STA 152+17 TO 156+43 RT
 STA 176+55 TO 179+31 RT

LEGEND

N	=	NEW
R	=	REMOVE
R&S	=	REMOVE & SALVAGE
S	=	SALVAGE
RET	=	RETAIN
B-TO-B	=	BACK TO BACK
⊕ □	=	CATCH BASIN/DI
(N.W.)	=	NO WORK REQUIRED (TYP. FOR D.I.'S, & C.B.'S WHERE NOTED)
I	=	YIELDING MARKER POST
⊗	=	UTILITY POLE
---	=	DRIVE

STA 176+18 TO 179+68 RT
 REMOVAL AND DISPOSAL OF GUARD RAIL

~~STA 176+18 TO 176+55 RT~~
 INSTALL MANUFACTURED TERMINAL SECTION, FLARED

~~STA 176+55 TO 179+31 RT~~
 INSTALL STEEL BEAM GUARD RAIL, GALVANIZED

~~STA 179+31 TO 179+68 RT~~
 INSTALL MANUFACTURED TERMINAL SECTION, FLARED

PAVING PROJECT LAYOUT SHEET #15


DESIGNED BY	BCE/PJM	DATE	10-06
DRAWN BY	C.E.A., INC.	DATE	10-06
DESIGN FILE NO.	06c042.dgn		
PRF FILE	06c042pl5.l	DATE PLOTTED	24-AUG-2009
PROJ. NAME	MAIDSTONE - BLOOMFIELD		
PROJ. NO.	STP 2609(1)S		
SHEET	25	OF	40 SHEETS

TEMPORARY 4in YELLOW LINE (PAINT)
DURABLE 4in YELLOW LINE (THERMOPLASTIC)
STA 180+00 TO 210+00
SOLID LT&RT

TEMPORARY 4in WHITE LINE (PAINT)
DURABLE 4in WHITE LINE (THERMOPLASTIC)
STA 180+00 TO 210+00
SOLID LT&RT

YIELDING MARKER POST
STA 188+23 RT
STA 192+02 RT

DITCHING LOCATIONS (REFER TO SHEET 10 FOR DETAILS)
STA 191+00 TO 199+00 LT
STA 203+50 TO 205+20 LT

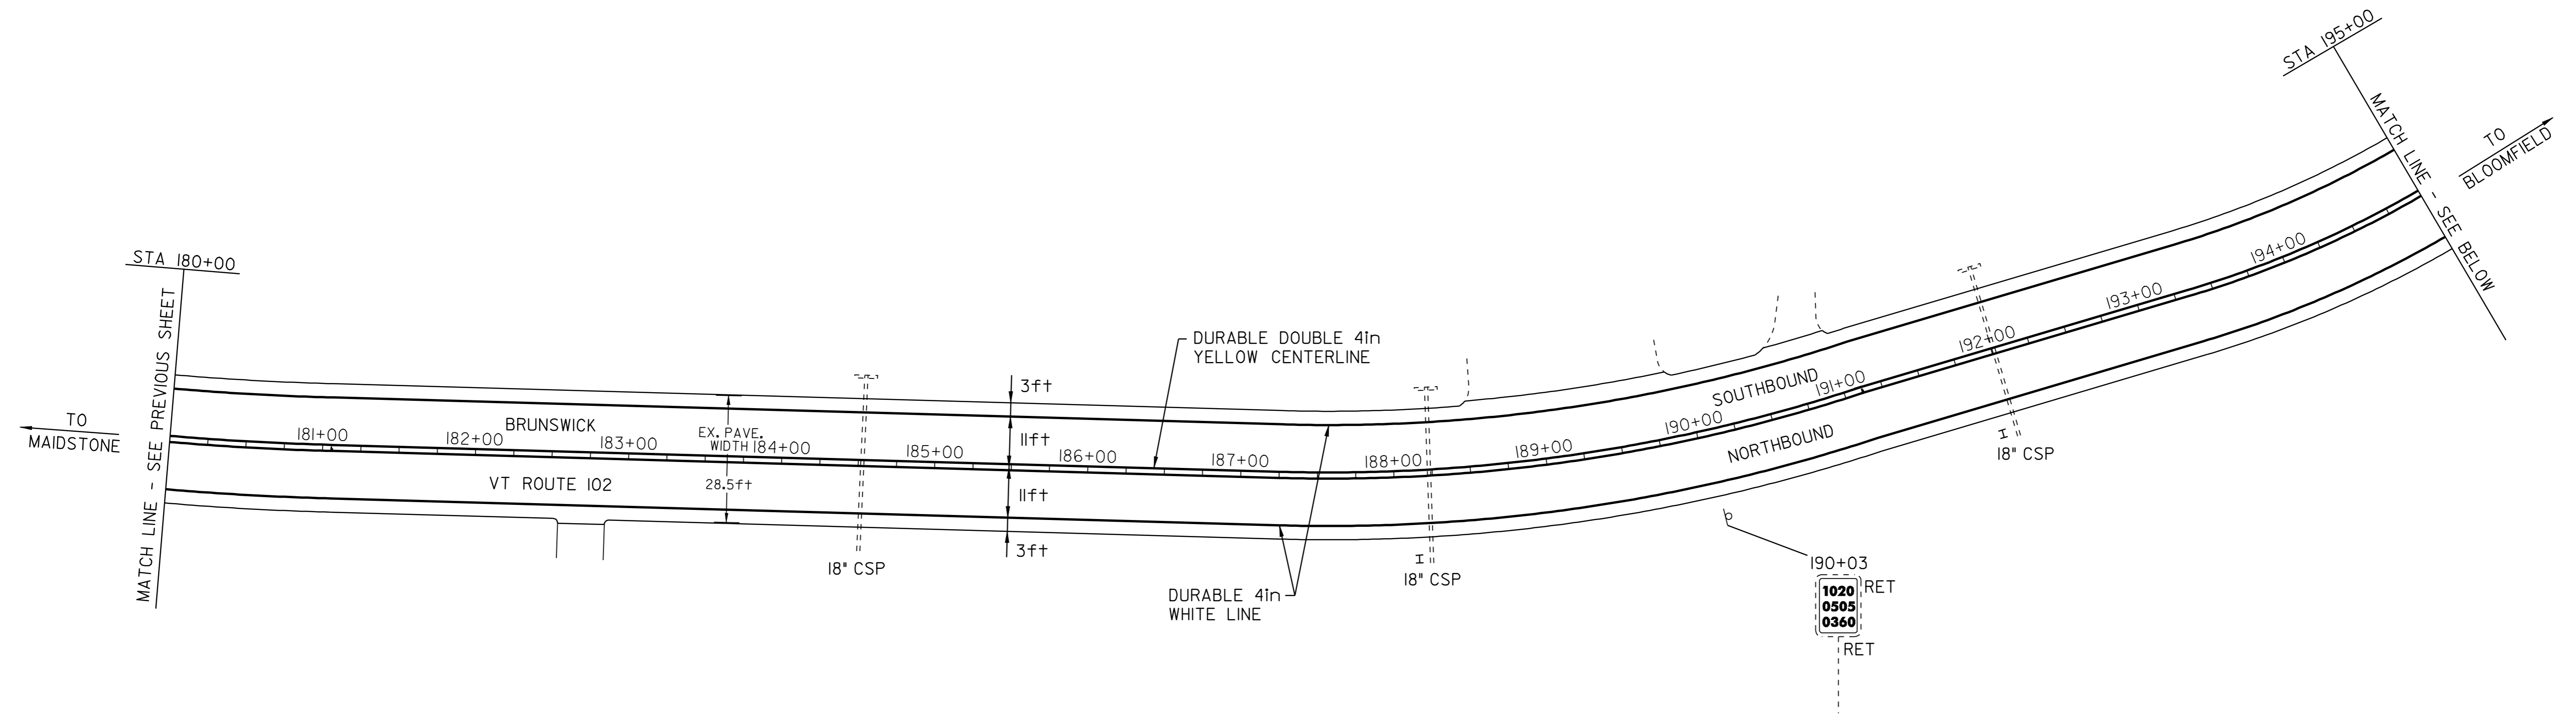

REMOVAL AND DISPOSAL OF GUARD RAIL

STA 195+40 TO 201+40 RT
STA 200+75 TO 203+50 LT

STEEL-BEAM GUARD RAIL, GALVANIZED

~~STA 195+77 TO 199+40 RT~~
~~STA 201+12 TO 203+13 LT~~

MANUFACTURED TERMINAL SECTION, FLARED

~~STA 195+40 TO 195+77 RT~~
~~STA 201+03 TO 201+40 RT~~
~~STA 200+75 TO 201+12 LT~~
~~STA 203+13 TO 203+50 LT~~

STEEL-BEAM GUARD RAIL, GALVANIZED w/8 FT POSTS

~~STA 199+40 TO 201+03 RT~~

STA 200+75 TO 203+50 LT

REMOVAL AND DISPOSAL OF GUARD RAIL
~~STA 200+75 TO 201+12 LT~~
INSTALL MANUFACTURED TERMINAL SECTION, FLARED


STA 201+12 TO 203+13 LT

INSTALL STEEL BEAM GUARD RAIL, GALVANIZED
~~STA 203+13 TO 203+50 LT~~
INSTALL MANUFACTURED TERMINAL SECTION, FLARED

199+97.5 LT
BEGIN MTS, FLARED & NEW SBGR

202+72.5 LT
END MTS, FLARED & NEW SBGR

200+63 RT
END MTS, FLARED & NEW SBGR

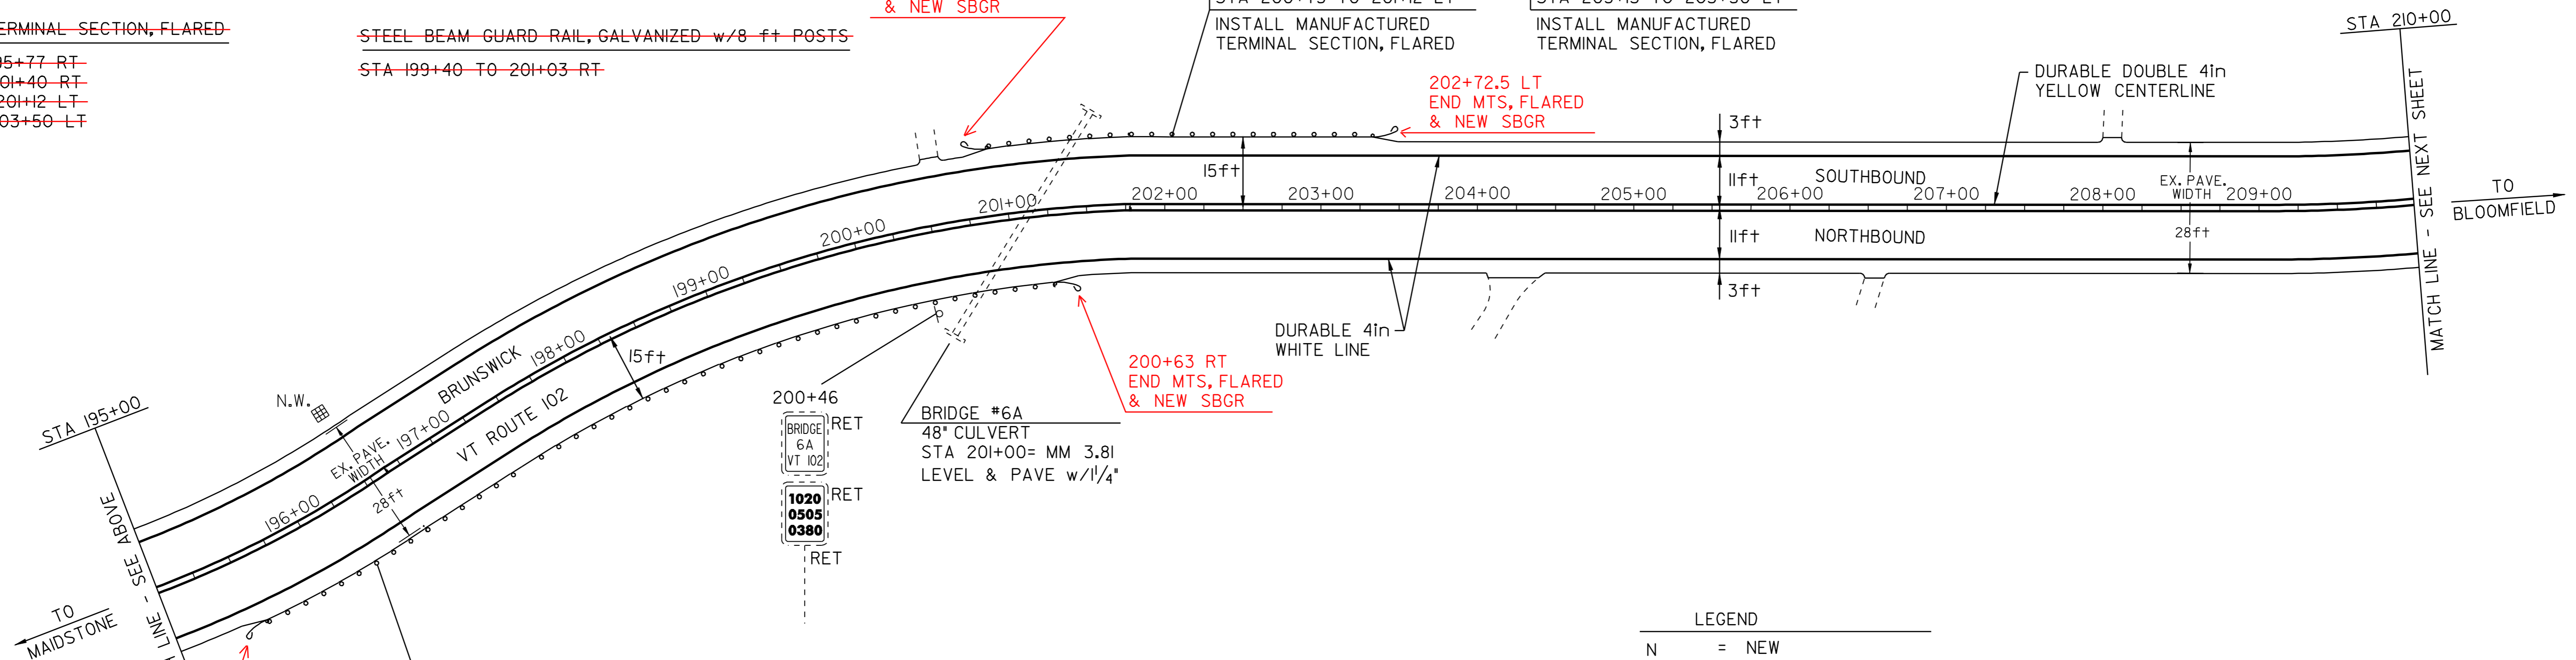

STA 195+40 TO 201+40 RT

REMOVAL AND DISPOSAL OF GUARD RAIL
~~STA 195+40 TO 195+77 RT~~
INSTALL MANUFACTURED TERMINAL SECTION, FLARED

STA 195+77 TO 199+40 RT

INSTALL STEEL BEAM GUARD RAIL, GALVANIZED

STA 199+40 TO 201+03 RT

INSTALL STEEL BEAM GUARD RAIL, GALVANIZED w/8 FT POSTS

STA 201+03 TO 201+40 RT

INSTALL MANUFACTURED TERMINAL SECTION, FLARED

LEGEND

- N = NEW
- R = REMOVE
- R&S = REMOVE & SALVAGE
- S = SALVAGE
- RET = RETAIN
- B-TO-B = BACK TO BACK
- ⊕ ⊞ □ CATCH BASIN/DI
- (N.W.) = NO WORK REQUIRED (TYP. FOR D.I.'S, & C.B.'S WHERE NOTED)
- I YIELDING MARKER POST
- ⊕ UTILITY POLE
- DRIVE

PAVING PROJECT LAYOUT SHEET #16

DESIGNED BY	BCE/PJM	DATE	10-06
DRAWN BY	C.E.A., INC.	DATE	10-06
DESIGN FILE NO.	06c042.dgn		
PRF FILE	06c042pl6.l	DATE PLOTTED	24-AUG-2009
PROJ. NAME	MAIDSTONE - BLOOMFIELD		
PROJ. NO.	STP 2609(1)S		
SHEET	26	OF	40 SHEETS

TEMPORARY 4in YELLOW LINE (PAINT)
 DURABLE 4in YELLOW LINE (THERMOPLASTIC)
 STA 210+00 TO 240+00 SOLID LT&RT

TEMPORARY 4in WHITE LINE (PAINT)
 DURABLE 4in WHITE LINE (THERMOPLASTIC)
 STA 210+00 TO 240+00 SOLID LT&RT

DITCHING LOCATIONS (REFER TO SHEET 10 FOR DETAILS)
 STA 210+00 TO 212+25 LT
 STA 217+50 TO 220+00 LT
 STA 225+75 TO 231+50 LT
 STA 232+75 TO 234+40 RT
 STA 237+00 TO 240+00 LT


~~MANUFACTURED TERMINAL SECTION, FLARED~~
~~STA 226+25 TO 226+62 RT~~
~~STA 230+13 TO 230+50 RT~~
~~STA 234+51 TO 234+88 LT~~
~~STA 234+75 TO 235+12 RT~~
~~STA 237+13 TO 237+50 RT~~
~~STA 238+90 TO 239+27 RT~~

~~STEEL BEAM GUARD RAIL, GALVANIZED~~
~~STA 226+62 TO 230+13 RT~~
~~STA 239+27 TO 240+00 RT~~

~~STEEL BEAM GUARD RAIL, GALVANIZED w/8 FT POSTS~~
~~STA 234+88 TO 236+51LT~~
~~STA 235+12 TO 237+13 RT~~

~~REMOVAL AND DISPOSAL OF GUARD RAIL~~
~~STA 226+25 TO 229+50 RT~~
~~STA 234+51 TO 236+51LT~~
~~STA 234+75 TO 237+50 RT~~
~~STA 238+90 TO 240+00 RT~~

~~ANCHOR FOR STEEL BEAM RAIL~~
~~STA 236+51LT - 2-~~

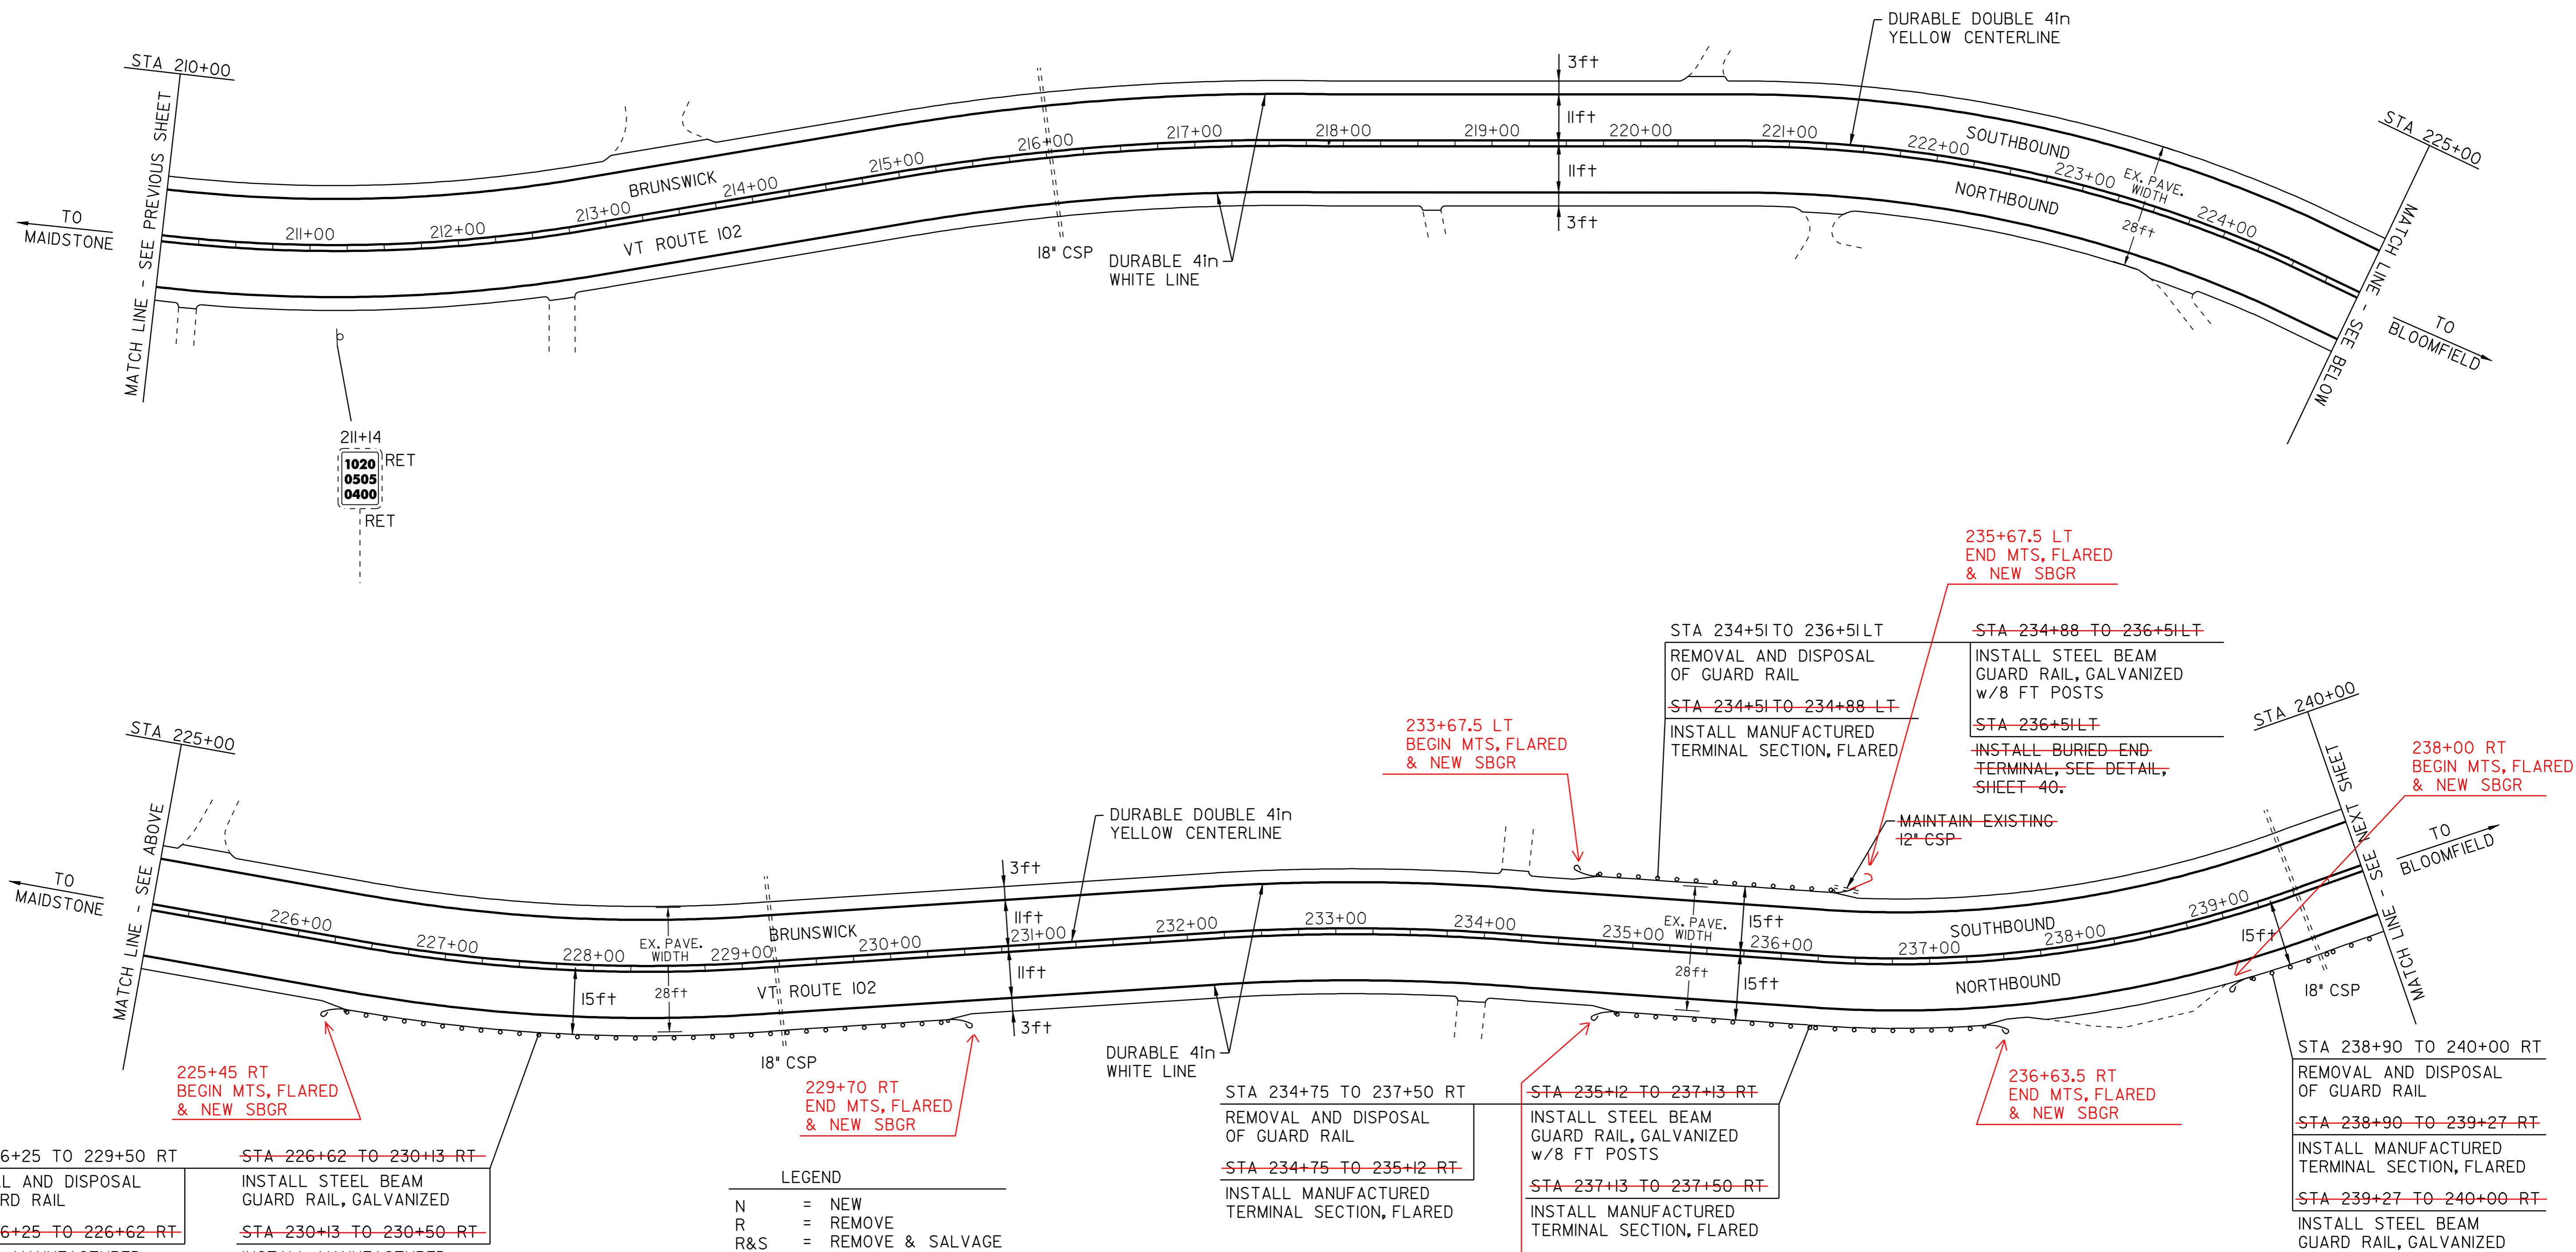

STA 226+25 TO 229+50 RT
 REMOVAL AND DISPOSAL OF GUARD RAIL
~~STA 226+25 TO 226+62 RT~~
 INSTALL MANUFACTURED TERMINAL SECTION, FLARED

~~STA 226+62 TO 230+13 RT~~
 INSTALL STEEL BEAM GUARD RAIL, GALVANIZED
~~STA 230+13 TO 230+50 RT~~
 INSTALL MANUFACTURED TERMINAL SECTION, FLARED

LEGEND

N = NEW
 R = REMOVE
 R&S = REMOVE & SALVAGE
 S = SALVAGE
 RET = RETAIN
 B-T-O-B = BACK TO BACK
 ⊕ □ = CATCH BASIN/DI (N.W.) = NO WORK REQUIRED (TYP. FOR D.I.'S, & C.B.'S WHERE NOTED)
 I = YIELDING MARKER POST
 Ⓢ = UTILITY POLE
 --- = DRIVE

STA 234+75 TO 237+50 RT
 REMOVAL AND DISPOSAL OF GUARD RAIL
~~STA 234+75 TO 235+12 RT~~
 INSTALL MANUFACTURED TERMINAL SECTION, FLARED

~~STA 235+12 TO 237+13 RT~~
 INSTALL STEEL BEAM GUARD RAIL, GALVANIZED w/8 FT POSTS
~~STA 237+13 TO 237+50 RT~~
 INSTALL MANUFACTURED TERMINAL SECTION, FLARED

STA 238+90 TO 240+00 RT
 REMOVAL AND DISPOSAL OF GUARD RAIL
~~STA 238+90 TO 239+27 RT~~
 INSTALL MANUFACTURED TERMINAL SECTION, FLARED
~~STA 239+27 TO 240+00 RT~~
 INSTALL STEEL BEAM GUARD RAIL, GALVANIZED

PAVING PROJECT LAYOUT SHEET #17



DESIGNED BY	BCE/PJM	DATE	10-06
DRAWN BY	C.E.A., INC.	DATE	10-06
DESIGN FILE NO.	06c042.dgn		
PRF FILE	06c042pl7.l	DATE PLOTTED	24-AUG-2009
PROJ. NAME	MAIDSTONE - BLOOMFIELD		
PROJ. NO.	STP 2609(1)S		
SHEET	27	OF	40 SHEETS

TEMPORARY 4in YELLOW LINE (PAINT)
DURABLE 4in YELLOW LINE (THERMOPLASTIC)
STA 240+00 TO 270+00
SOLID LT&RT

TEMPORARY 4in WHITE LINE (PAINT)
DURABLE 4in WHITE LINE (THERMOPLASTIC)
STA 240+00 TO 270+00
SOLID LT&RT

DITCHING LOCATIONS (REFER TO SHEET 10 FOR DETAILS)
STA 240+00 TO 250+75 LT
STA 256+50 TO 259+00 LT
STA 265+00 TO 270+00 LT

YIELDING MARKER POST
STA 265+10 RT

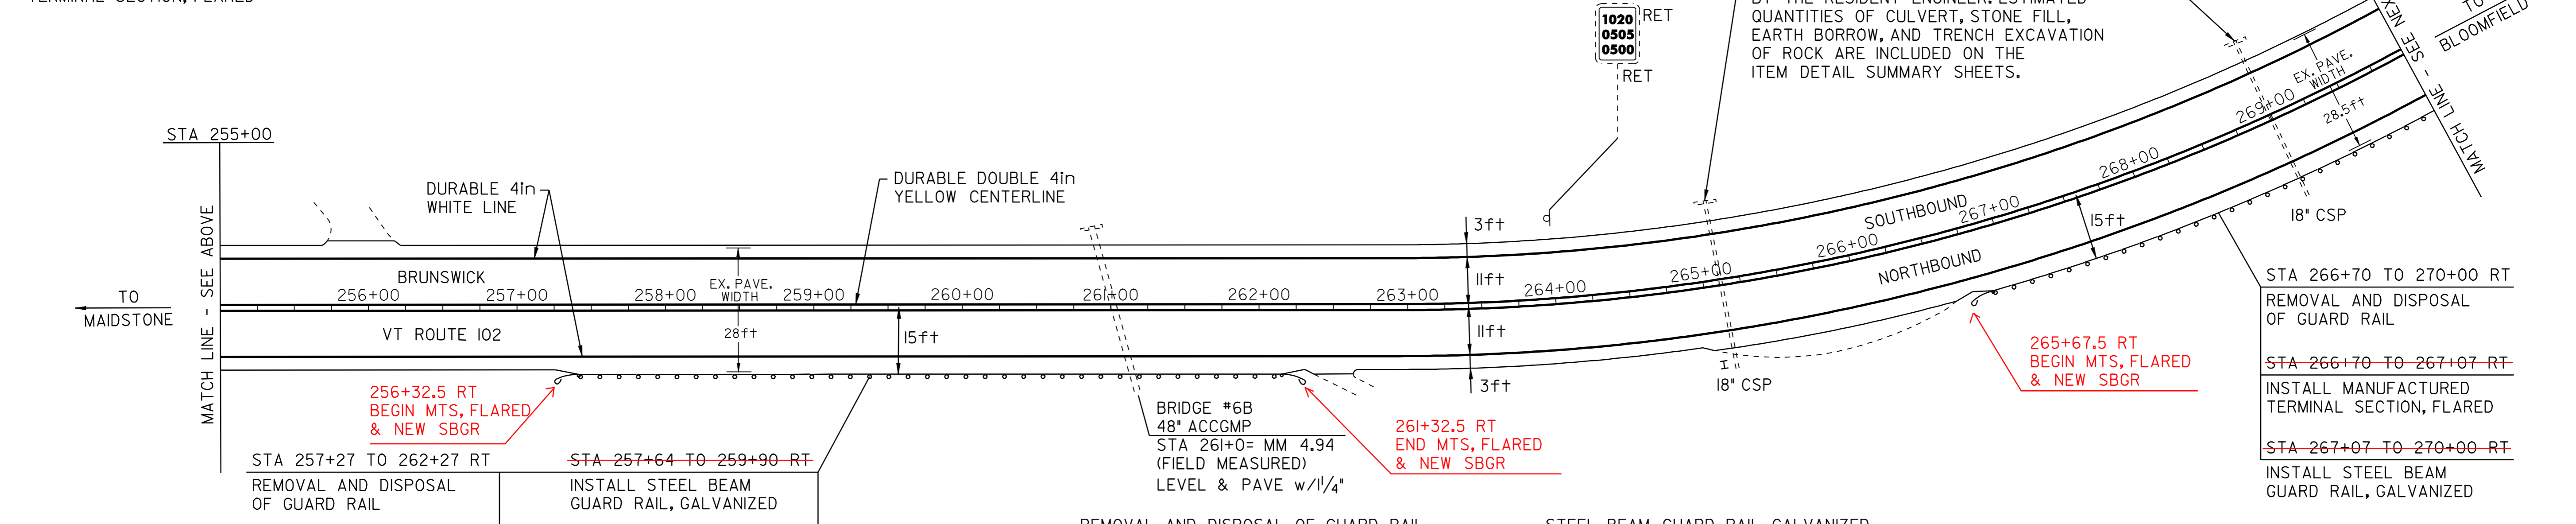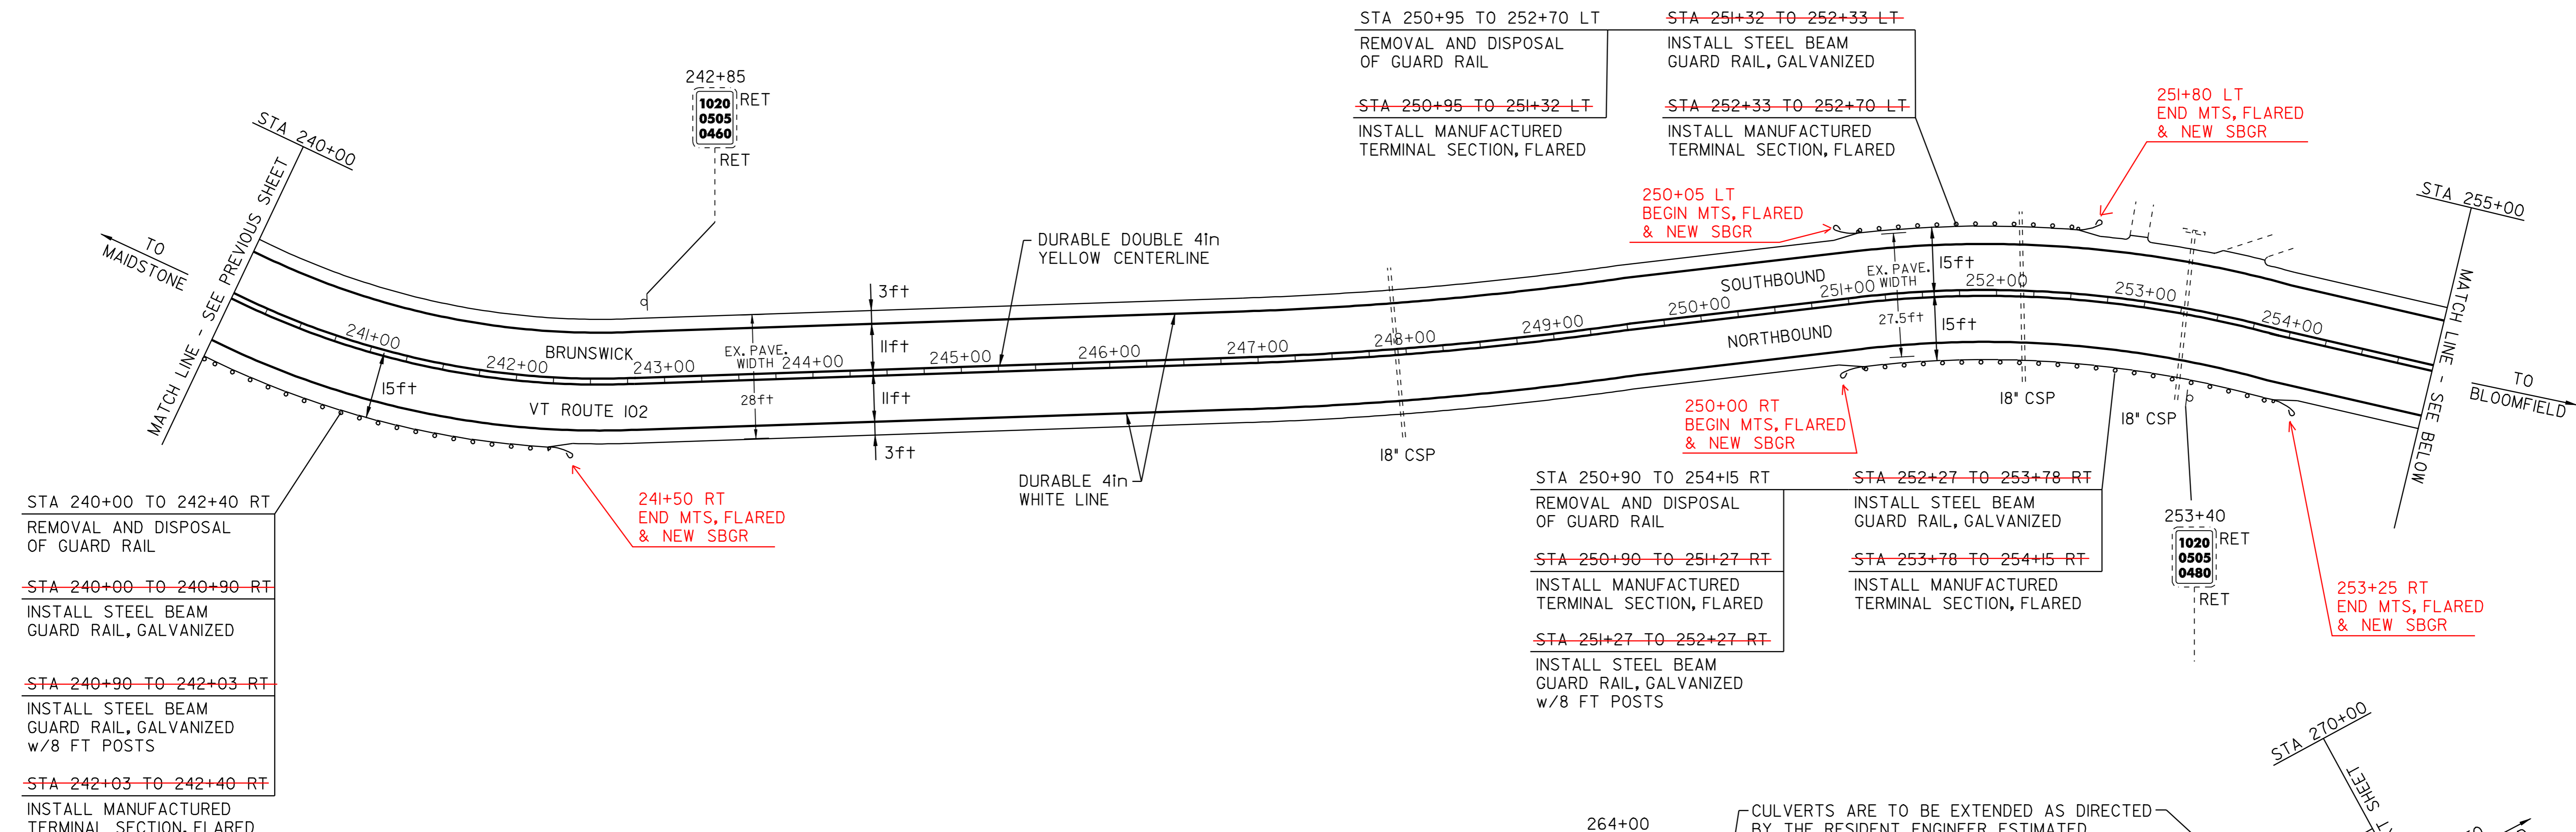

- LEGEND
- N = NEW
 - R = REMOVE
 - R&S = REMOVE & SALVAGE
 - S = SALVAGE
 - RET = RETAIN
 - B-TO-B = BACK TO BACK
 - ☐ = CATCH BASIN/DI
 - (N.W.) = NO WORK REQUIRED (TYP. FOR D.I.'S, & C.B.'S WHERE NOTED)
 - I = YIELDING MARKER POST
 - ⊙ = UTILITY POLE
 - = DRIVE

STA 257+27 TO 262+27 RT
REMOVAL AND DISPOSAL OF GUARD RAIL

~~STA 257+27 TO 257+64 RT~~
INSTALL MANUFACTURED TERMINAL SECTION, FLARED

STA 257+64 TO 259+90 RT
INSTALL STEEL BEAM GUARD RAIL, GALVANIZED

~~STA 259+90 TO 261+90 RT~~
INSTALL STEEL BEAM GUARD RAIL, GALVANIZED w/8 FT POSTS

~~STA 261+90 TO 262+27 RT~~
INSTALL MANUFACTURED TERMINAL SECTION, FLARED

REMOVAL AND DISPOSAL OF GUARD RAIL

STA 240+00 TO 242+40 RT
STA 250+90 TO 254+15 RT
STA 250+95 TO 252+70 LT
STA 257+27 TO 262+27 RT
STA 266+70 TO 270+00 RT

~~MANUFACTURED TERMINAL SECTION, FLARED~~

~~STA 242+03 TO 242+40 RT~~
~~STA 250+90 TO 251+27 RT~~
~~STA 250+95 TO 251+32 LT~~
~~STA 252+33 TO 252+70 LT~~
~~STA 253+78 TO 254+15 RT~~
~~STA 257+27 TO 257+64 RT~~
~~STA 261+90 TO 262+27 RT~~
~~STA 266+70 TO 267+07 RT~~

STEEL BEAM GUARD RAIL, GALVANIZED

~~STA 240+00 TO 240+90 RT~~
~~STA 251+32 TO 252+33 LT~~
~~STA 252+27 TO 253+78 RT~~
~~STA 257+64 TO 259+90 RT~~
~~STA 267+07 TO 270+00 RT~~

~~STEEL BEAM GUARD RAIL, GALVANIZED w/8 FT POSTS~~

~~STA 240+90 TO 242+03 RT~~
~~STA 251+27 TO 252+27 RT~~
~~STA 259+90 TO 261+90 RT~~

PAVING PROJECT LAYOUT SHEET #18

DESIGNED BY	BCE/PJM	DATE	10-06
DRAWN BY	C.E.A., INC.	DATE	10-06
DESIGN FILE NO.	06c042.dgn		
PRF FILE	06c042pl8.l	DATE PLOTTED	24-AUG-2009
PROJ. NAME	MAIDSTONE - BLOOMFIELD		
PROJ. NO.	STP 2609(1)S		
SHEET	28	OF	40 SHEETS

TEMPORARY 4in YELLOW LINE (PAINT)
DURABLE 4in YELLOW LINE (THERMOPLASTIC)
STA 270+00 TO 300+00 SOLID LT&RT

TEMPORARY 4in WHITE LINE (PAINT)
DURABLE 4in WHITE LINE (THERMOPLASTIC)
STA 270+00 TO 300+00 SOLID LT&RT

STA 276+10 TO 280+35 LT
REMOVAL AND DISPOSAL
OF GUARD RAIL

STA 276+47 TO 279+98 LT
INSTALL STEEL BEAM
GUARD RAIL, GALVANIZED

STA 276+10 TO 276+47 LT
INSTALL MANUFACTURED
TERMINAL SECTION, FLARED

STA 279+98 TO 280+35 LT
INSTALL MANUFACTURED
TERMINAL SECTION, FLARED

STA 270+00 TO 270+95 RT
REMOVAL AND DISPOSAL
OF GUARD RAIL

STA 270+00 TO 270+58 RT
INSTALL STEEL BEAM
GUARD RAIL, GALVANIZED

STA 270+58 TO 270+95 RT
INSTALL MANUFACTURED
TERMINAL SECTION, FLARED

TO MAIDSTONE
MATCH LINE - SEE PREVIOUS SHEET
15ft
15ft
15ft

274+95 LT
BEGIN MTS, FLARED
& NEW SBGR

272+42.5 RT
BEGIN MTS, FLARED
& NEW SBGR

269+92.5 RT
END MTS, FLARED
& NEW SBGR

BRIDGE #7
STA 276+60= MM 5.24
LEVEL & PAVE w/1/4"

279+32.5 LT
END MTS, FLARED
& NEW SBGR

275+92.5 RT
END MTS, FLARED
& NEW SBGR

STA 273+45 TO 276+95 RT
REMOVAL AND DISPOSAL
OF GUARD RAIL

STA 273+82 TO 276+58 RT
INSTALL STEEL BEAM
GUARD RAIL, GALVANIZED

STA 273+45 TO 273+82 RT
INSTALL MANUFACTURED
TERMINAL SECTION, FLARED

STA 276+58 TO 276+95 RT
INSTALL MANUFACTURED
TERMINAL SECTION, FLARED

STA 296+50 TO 300+00 LT
REMOVAL AND DISPOSAL
OF GUARD RAIL

STA 296+50 TO 296+87 LT
INSTALL MANUFACTURED
TERMINAL SECTION, FLARED

STA 296+87 TO 300+00 LT
INSTALL STEEL BEAM
GUARD RAIL, GALVANIZED
w/8 FT POSTS

TO MAIDSTONE
MATCH LINE - SEE ABOVE
18" CSP
18" CSP

295+43.5 LT
BEGIN MTS, FLARED
& NEW SBGR

295+32.5 RT
BEGIN MTS, FLARED
& NEW SBGR

298+45 RT
END MTS, FLARED
& NEW SBGR

REMOVAL AND DISPOSAL OF GUARD RAIL
STA 270+00 TO 270+95 RT
STA 273+45 TO 276+95 RT
STA 276+10 TO 280+35 LT
STA 296+32 TO 299+70 RT
STA 296+50 TO 300+00 LT

STEEL BEAM GUARD RAIL, GALVANIZED
STA 270+00 TO 270+58 RT
STA 273+82 TO 276+58 RT
STA 276+47 TO 279+98 LT

MANUFACTURED TERMINAL SECTION, FLARED
STA 270+58 TO 270+95 RT
STA 273+45 TO 273+82 RT
STA 276+10 TO 276+47 LT
STA 276+58 TO 276+95 RT
STA 279+98 TO 280+35 LT
STA 296+32 TO 296+69 RT
STA 296+50 TO 296+87 LT
STA 299+33 TO 299+70 RT

STEEL BEAM GUARD RAIL, GALVANIZED w/8 FT POSTS
STA 296+69 TO 299+33 RT
STA 296+87 TO 300+00 LT
DITCHING LOCATIONS (REFER TO SHEET 10 FOR DETAILS)
STA 270+00 TO 273+40 LT

- LEGEND
- N = NEW
 - R = REMOVE
 - R&S = REMOVE & SALVAGE
 - S = SALVAGE
 - RET = RETAIN
 - B-TO-B = BACK TO BACK
 - ⊕ □ = CATCH BASIN/DI (N.W.) = NO WORK REQUIRED (TYP. FOR D.I.'S, & C.B.'S WHERE NOTED)
 - I = YIELDING MARKER POST
 - ⊗ = UTILITY POLE
 - = DRIVE

PAVING PROJECT LAYOUT SHEET #19

DESIGNED BY	BCE/PJM	DATE	10-06
DRAWN BY	C.E.A., INC.	DATE	10-06
DESIGN FILE NO.	06c042.dgn		
PRF FILE	06c042p19.I	DATE PLOTTED	24-AUG-2009
PROJ. NAME	MAIDSTONE - BLOOMFIELD		
PROJ. NO.	STP 2609(1)S		
SHEET	29	OF	40 SHEETS

TEMPORARY 4in YELLOW LINE (PAINT)
DURABLE 4in YELLOW LINE (THERMOPLASTIC)

STA 300+00 TO 304+66 SOLID LT&RT
STA 304+66 TO 312+58 SOLID LT & DASHED RT
STA 312+58 TO 319+44 DASHED
STA 319+44 TO 327+36 DASHED LT & SOLID RT
STA 327+36 TO 330+00 SOLID LT&RT

TEMPORARY 4in WHITE LINE (PAINT)
DURABLE 4in WHITE LINE (THERMOPLASTIC)

STA 300+00 TO 330+00 SOLID LT&RT

STA 300+00 TO 301+00 LT
REMOVAL AND DISPOSAL
OF GUARD RAIL

~~STA 300+63 TO 301+00 LT~~
INSTALL MANUFACTURED
TERMINAL SECTION, FLARED

~~STA 300+00 TO 300+63 LT~~
INSTALL STEEL BEAM
GUARD RAIL, GALVANIZED
w/8 FT POSTS

STA 305+90 TO 310+65 LT
REMOVAL AND DISPOSAL
OF GUARD RAIL

~~STA 305+90 TO 306+27 LT~~
INSTALL MANUFACTURED
TERMINAL SECTION, FLARED

~~STA 306+27 TO 310+28 LT~~
INSTALL STEEL BEAM
GUARD RAIL, GALVANIZED
w/8 FT POSTS

~~STA 310+28 TO 310+65 LT~~
INSTALL MANUFACTURED
TERMINAL SECTION, FLARED

299+93.5 LT
END MTS, FLARED
& NEW SBGR

304+97.5 LT
BEGIN MTS, FLARED
& NEW SBGR

309+60 LT
END MTS, FLARED
& NEW SBGR

304+97.5 RT
BEGIN MTS, FLARED
& NEW SBGR



308+22.5 RT
END MTS, FLARED
& NEW SBGR

STA 305+40 TO 309+27 RT
REMOVAL AND DISPOSAL
OF GUARD RAIL

~~STA 305+40 TO 305+77 RT~~
INSTALL MANUFACTURED
TERMINAL SECTION, FLARED

~~STA 305+77 TO 308+90 RT~~
INSTALL STEEL BEAM
GUARD RAIL, GALVANIZED
w/8 FT POSTS

~~STA 308+90 TO 309+27 RT~~
INSTALL MANUFACTURED
TERMINAL SECTION, FLARED

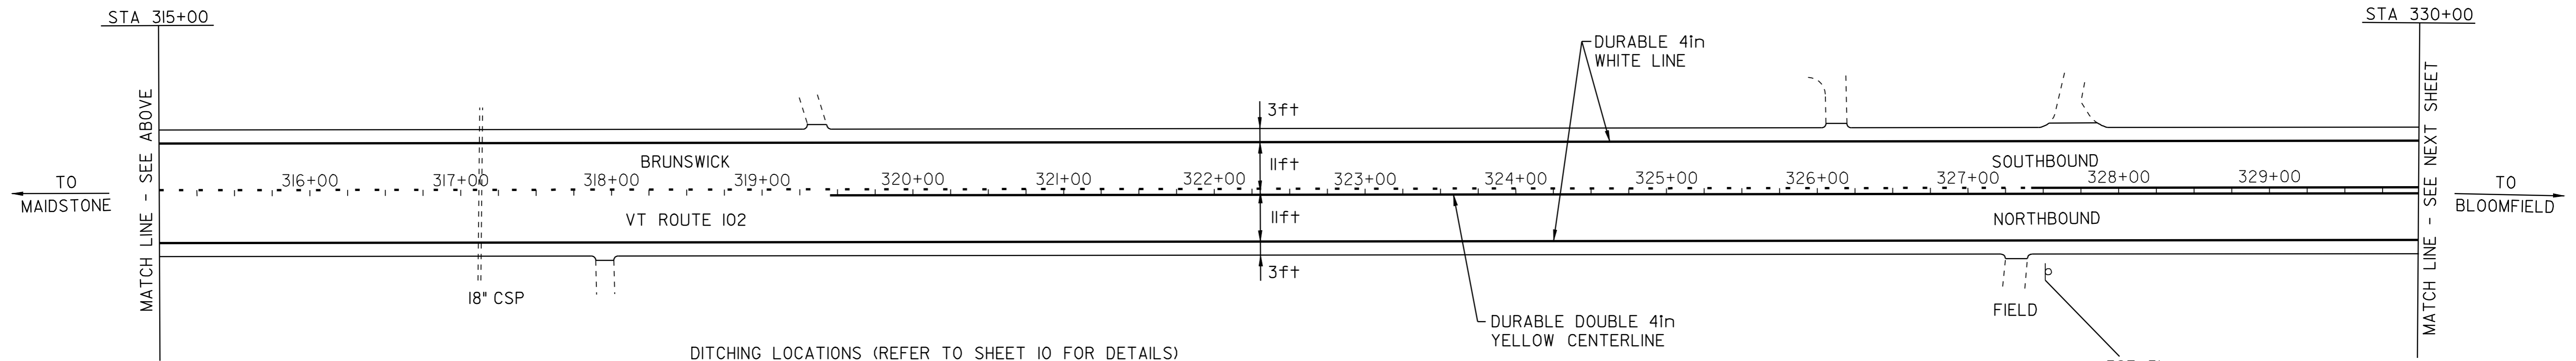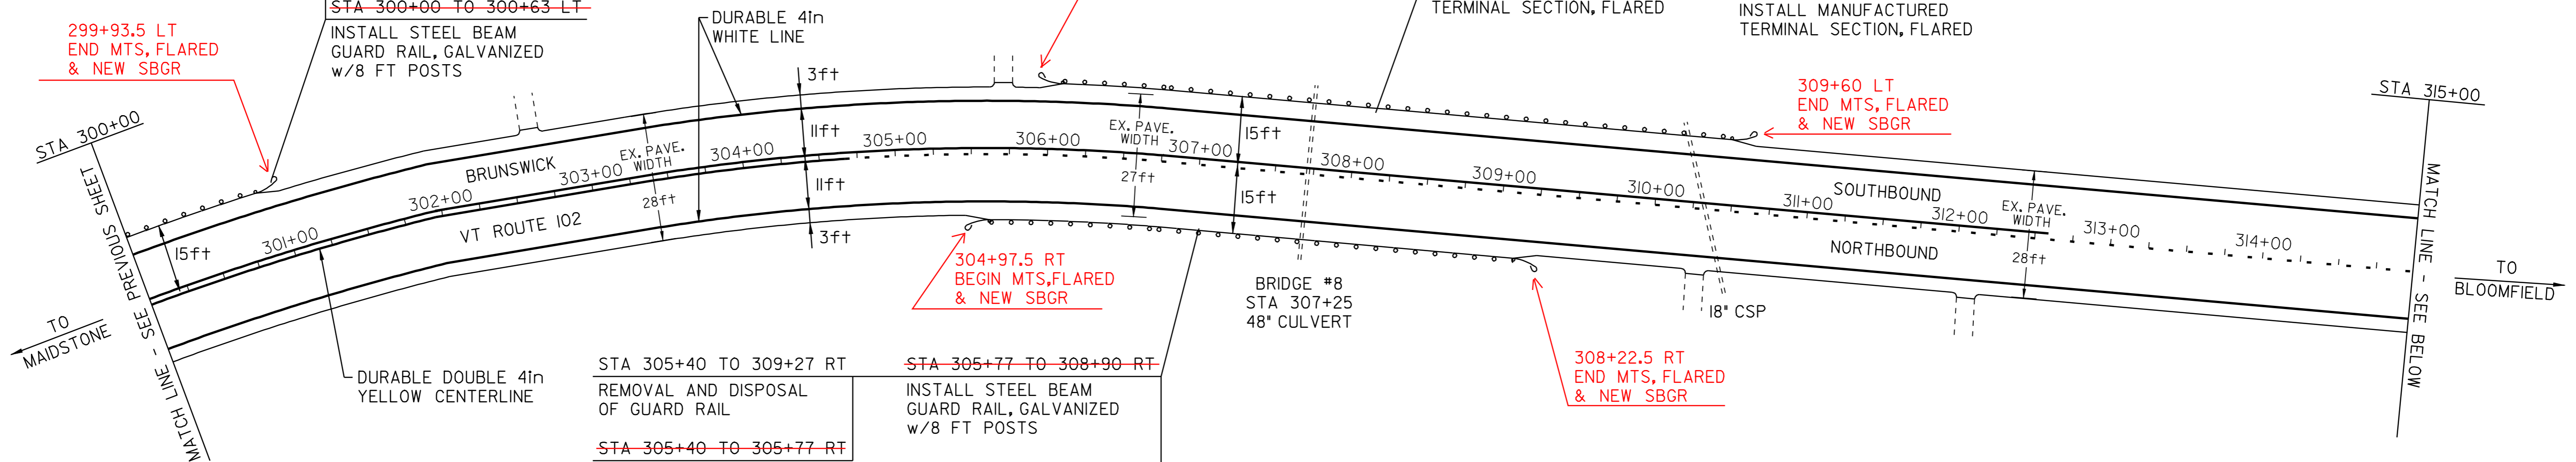

DITCHING LOCATIONS (REFER TO SHEET 10 FOR DETAILS)

STA 328+75 TO 330+00 LT

REMOVAL AND DISPOSAL OF GUARD RAIL

STA 300+00 TO 301+00 LT
STA 305+40 TO 309+27 RT
STA 305+90 TO 310+65 LT

~~MANUFACTURED TERMINAL SECTION, FLARED~~

~~STA 300+63 TO 301+00 LT~~
~~STA 305+40 TO 305+77 RT~~
~~STA 305+90 TO 306+27 LT~~
~~STA 308+90 TO 309+27 RT~~
~~STA 310+28 TO 310+65 LT~~

~~STEEL BEAM GUARD RAIL, GALVANIZED w/8 ft POSTS~~

~~STA 300+00 TO 300+63 LT~~
~~STA 305+77 TO 308+90 RT~~
~~STA 306+27 TO 310+28 LT~~

LEGEND

N	=	NEW
R	=	REMOVE
R&S	=	REMOVE & SALVAGE
S	=	SALVAGE
RET	=	RETAIN
B-TO-B	=	BACK TO BACK
⊕	=	CATCH BASIN/DI
(N.W.)	=	NO WORK REQUIRED (TYP. FOR D.I.'S, & C.B.'S WHERE NOTED)
I	=	YIELDING MARKER POST
⊙	=	UTILITY POLE
---	=	DRIVE

PAVING PROJECT LAYOUT SHEET #20

DESIGNED BY	BCE/PJM	DATE	10-06
DRAWN BY	C.E.A., INC.	DATE	10-06
DESIGN FILE NO.	06c042.dgn		
PRF FILE	06c042p20.1	DATE PLOTTED	24-AUG-2009
PROJ. NAME	MAIDSTONE - BLOOMFIELD		
PROJ. NO.	STP 2609(1)S		
SHEET	30	OF	40 SHEETS

TEMPORARY 4in YELLOW LINE (PAINT)
DURABLE 4in YELLOW LINE (THERMOPLASTIC)

STA 330+00 TO 336+07 SOLID LT&RT
STA 336+07 TO 343+20 SOLID LT & DASHED RT
STA 343+20 TO 343+99 SOLID LT&RT
STA 343+99 TO 351+12 DASHED LT & SOLID RT
STA 351+12 TO 374+11 SOLID LT&RT


TEMPORARY 4in WHITE LINE (PAINT)
DURABLE 4in WHITE LINE (THERMOPLASTIC)

STA 330+00 TO 374+11 SOLID LT&RT

DITCHING LOCATIONS (REFER TO SHEET 10 FOR DETAILS)

STA 332+00 TO 335+00 LT
STA 339+60 TO 342+50 RT

RELOCATE MAILBOX, SINGLE SUPPORT
STA 360+02 RT

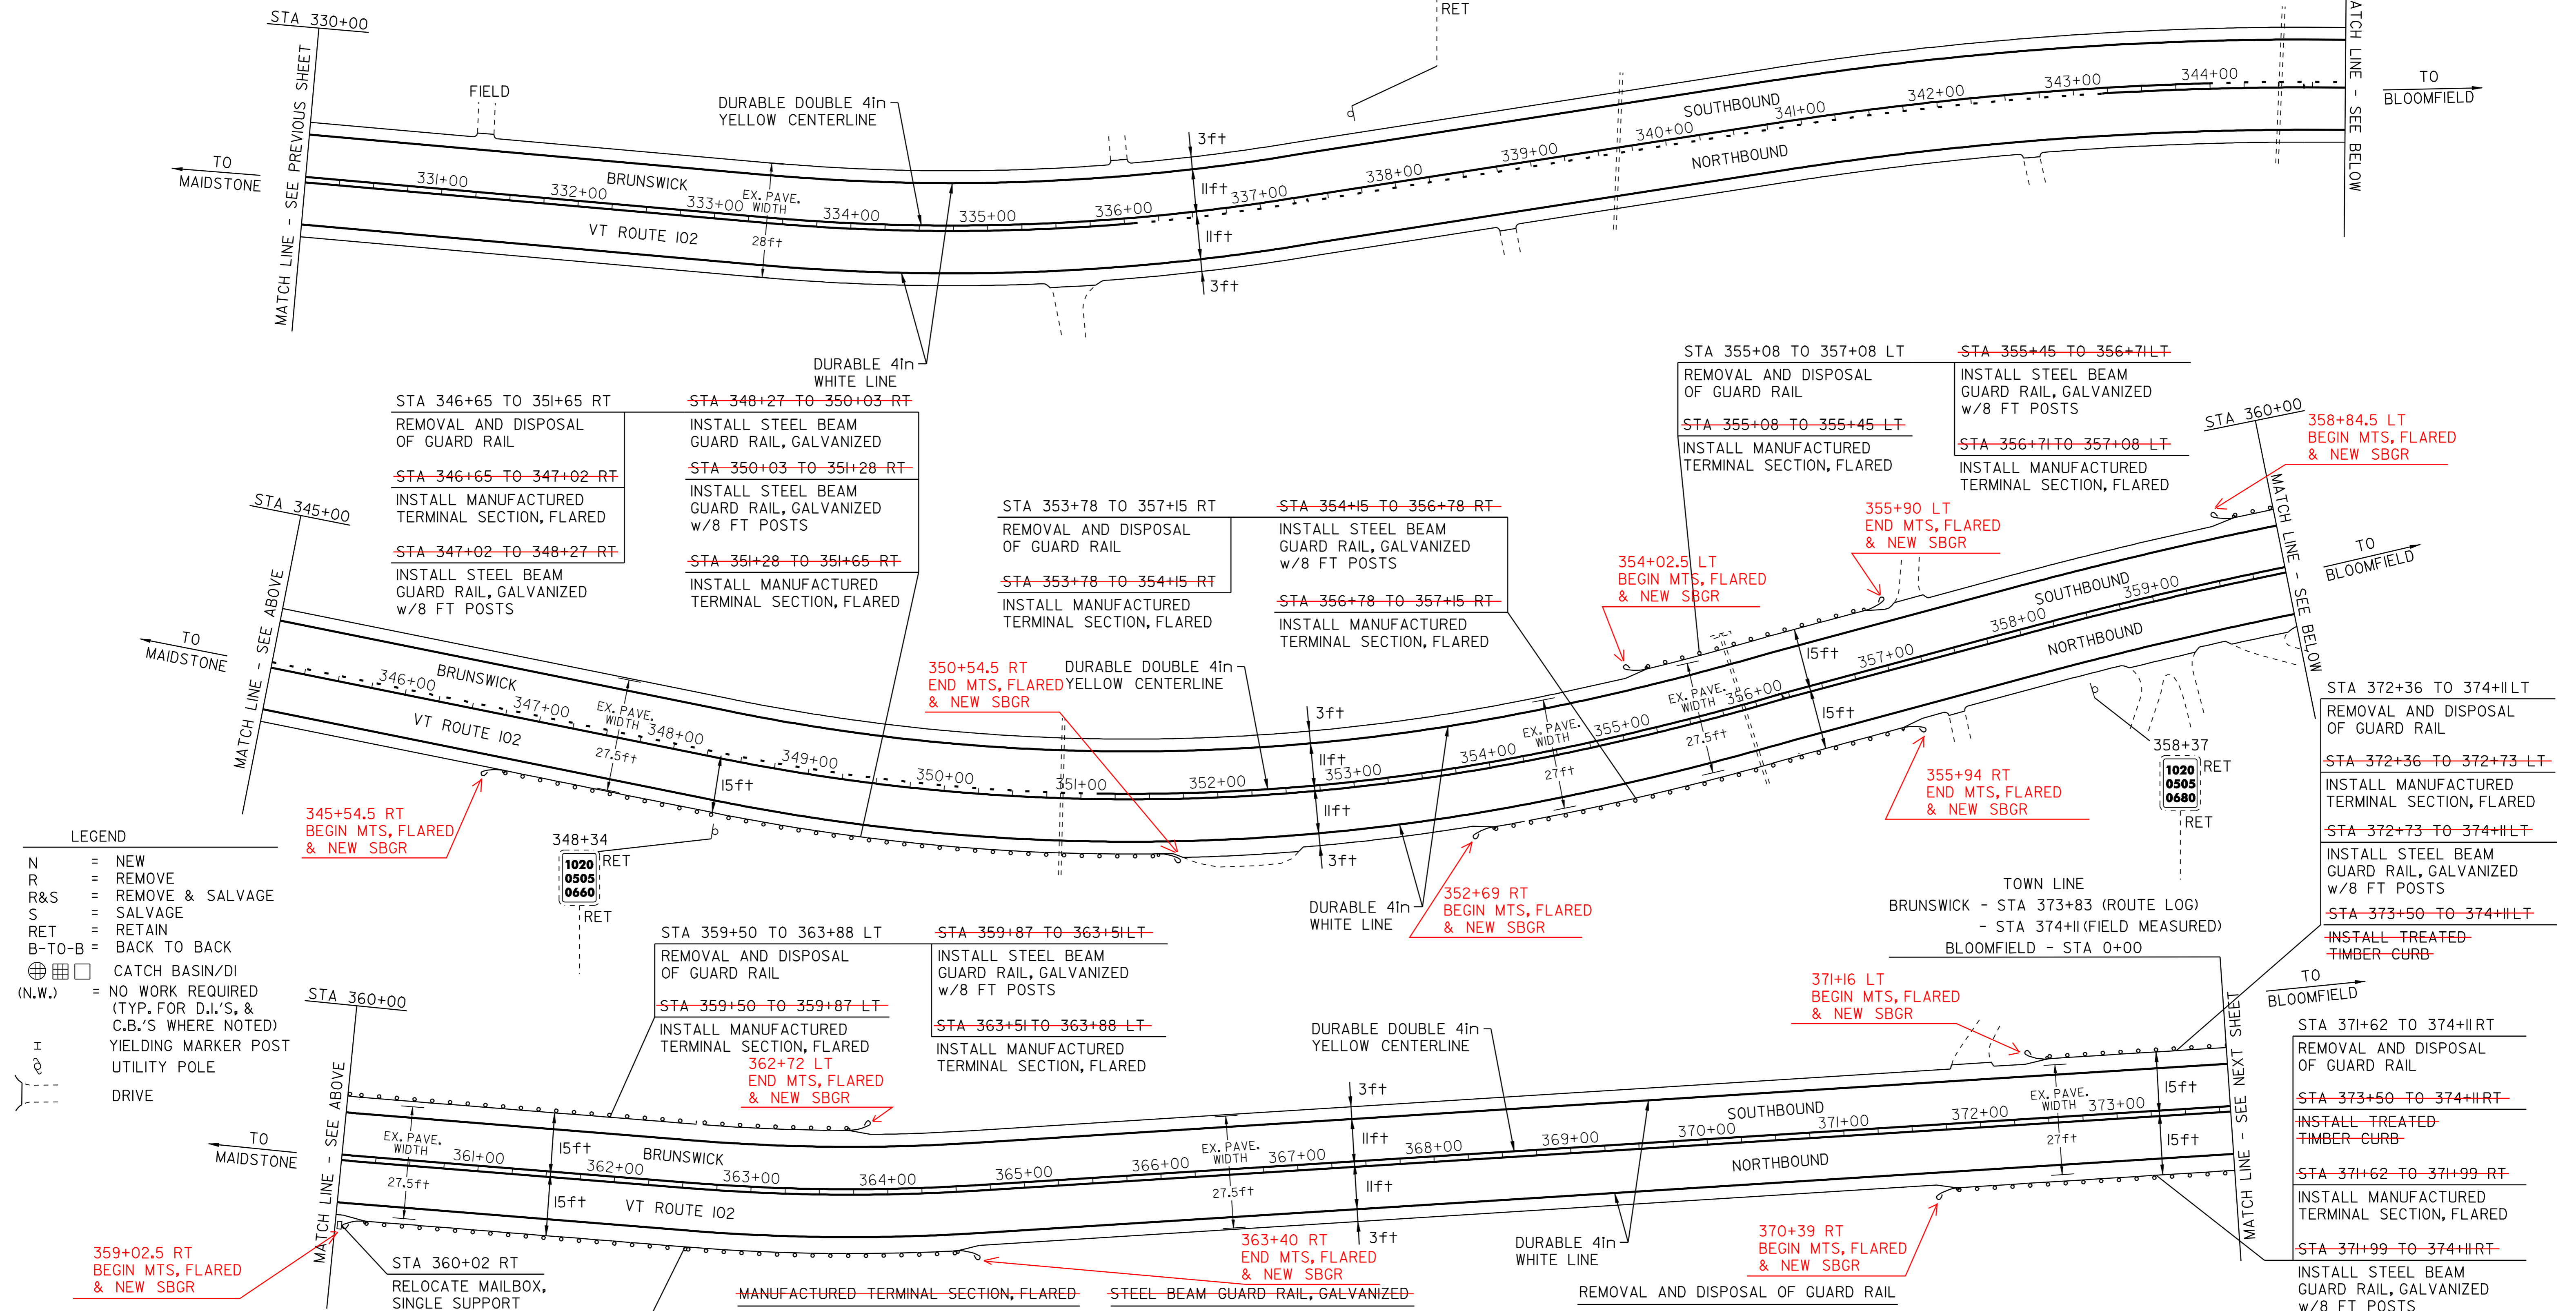

LEGEND

N = NEW
R = REMOVE
R&S = REMOVE & SALVAGE
S = SALVAGE
RET = RETAIN
B-TO-B = BACK TO BACK
CATCH BASIN/DI
(N.W.) = NO WORK REQUIRED (TYP. FOR D.I.'S, & C.B.'S WHERE NOTED)
I = YIELDING MARKER POST
UTILITY POLE
DRIVE

STA 360+05 TO 364+67 RT
REMOVAL AND DISPOSAL OF GUARD RAIL

STA 360+05 TO 360+42 RT
INSTALL MANUFACTURED TERMINAL SECTION, FLARED

STA 360+42 TO 364+30 RT
INSTALL STEEL BEAM GUARD RAIL, GALVANIZED w/8 FT POSTS

STA 364+30 TO 364+67 RT
INSTALL MANUFACTURED TERMINAL SECTION, FLARED

~~MANUFACTURED TERMINAL SECTION, FLARED~~

~~STA 346+65 TO 347+02 RT~~
~~STA 351+28 TO 351+65 RT~~
~~STA 353+78 TO 354+15 RT~~
~~STA 355+08 TO 355+45 LT~~
~~STA 356+71 TO 357+08 LT~~
~~STA 356+78 TO 357+15 RT~~
~~STA 359+50 TO 359+87 LT~~
~~STA 360+05 TO 360+42 RT~~
~~STA 363+51 TO 363+88 LT~~
~~STA 364+30 TO 364+67 RT~~
~~STA 371+62 TO 371+99 RT~~
~~STA 372+36 TO 372+73 LT~~

~~STEEL BEAM GUARD RAIL, GALVANIZED~~
~~STA 348+27 TO 350+03 RT~~

~~STEEL BEAM GUARD RAIL, GALVANIZED w/8 FT POSTS~~

~~STA 347+02 TO 348+27 RT~~
~~STA 350+03 TO 351+28 RT~~
~~STA 354+15 TO 356+78 RT~~
~~STA 355+45 TO 356+71 LT~~
~~STA 359+87 TO 363+51 LT~~
~~STA 360+42 TO 364+30 RT~~
~~STA 371+99 TO 374+11 RT~~
~~STA 372+73 TO 374+11 LT~~

REMOVAL AND DISPOSAL OF GUARD RAIL

STA 346+65 TO 351+65 RT
STA 353+78 TO 357+15 RT
STA 355+08 TO 357+08 LT
STA 359+50 TO 363+88 LT
STA 360+05 TO 364+67 RT
STA 371+62 TO 374+11 RT
STA 372+36 TO 374+11 LT

TREATED TIMBER CURB

372+26.5 STA 373+50 TO 374+11 RT
371+53.5 STA 373+50 TO 374+11 LT

PAVING PROJECT LAYOUT SHEET #21

DESIGNED BY BCE/PJM DATE 10-06

DRAWN BY C.E.A., INC. DATE 10-06

DESIGN FILE NO. 06c042.dgn

PRF FILE 06c042p2LI DATE PLOTTED 24-AUG-2009

PROJ. NAME **MAIDSTONE - BLOOMFIELD**

PROJ. NO. **STP 2609(1)S**

SHEET **31** OF **40** SHEETS


TEMPORARY 4in YELLOW LINE (PAINT)
DURABLE 4in YELLOW LINE (THERMOPLASTIC)
STA 0+00 TO 11+50
STA 3+90
(WITH CENTERLINE BREAKS FOR TOWN HIGHWAYS)
SOLID LT&RT
DOUBLE SOLID LT

TEMPORARY 4in WHITE LINE (PAINT)
DURABLE 4in WHITE LINE (THERMOPLASTIC)
STA 0+00 TO 11+50
(WITH EDGELINE BREAKS FOR TOWN HIGHWAYS)
SOLID LT&RT
(WITH EDGELINE BREAKS FOR TOWN HIGHWAYS)

TEMPORARY LETTER OR SYMBOL (PAINT)
DURABLE LETTER OR SYMBOL (THERMOPLASTIC)
STA 3+90 LT
STA 11+23 RT
"STOP"
"STOP AHEAD"

TEMPORARY 24in STOP BAR (PAINT)
DURABLE 24in STOP BAR (THERMOPLASTIC)
STA 3+90 LT
TH #1

REMOVING SIGNS
I3

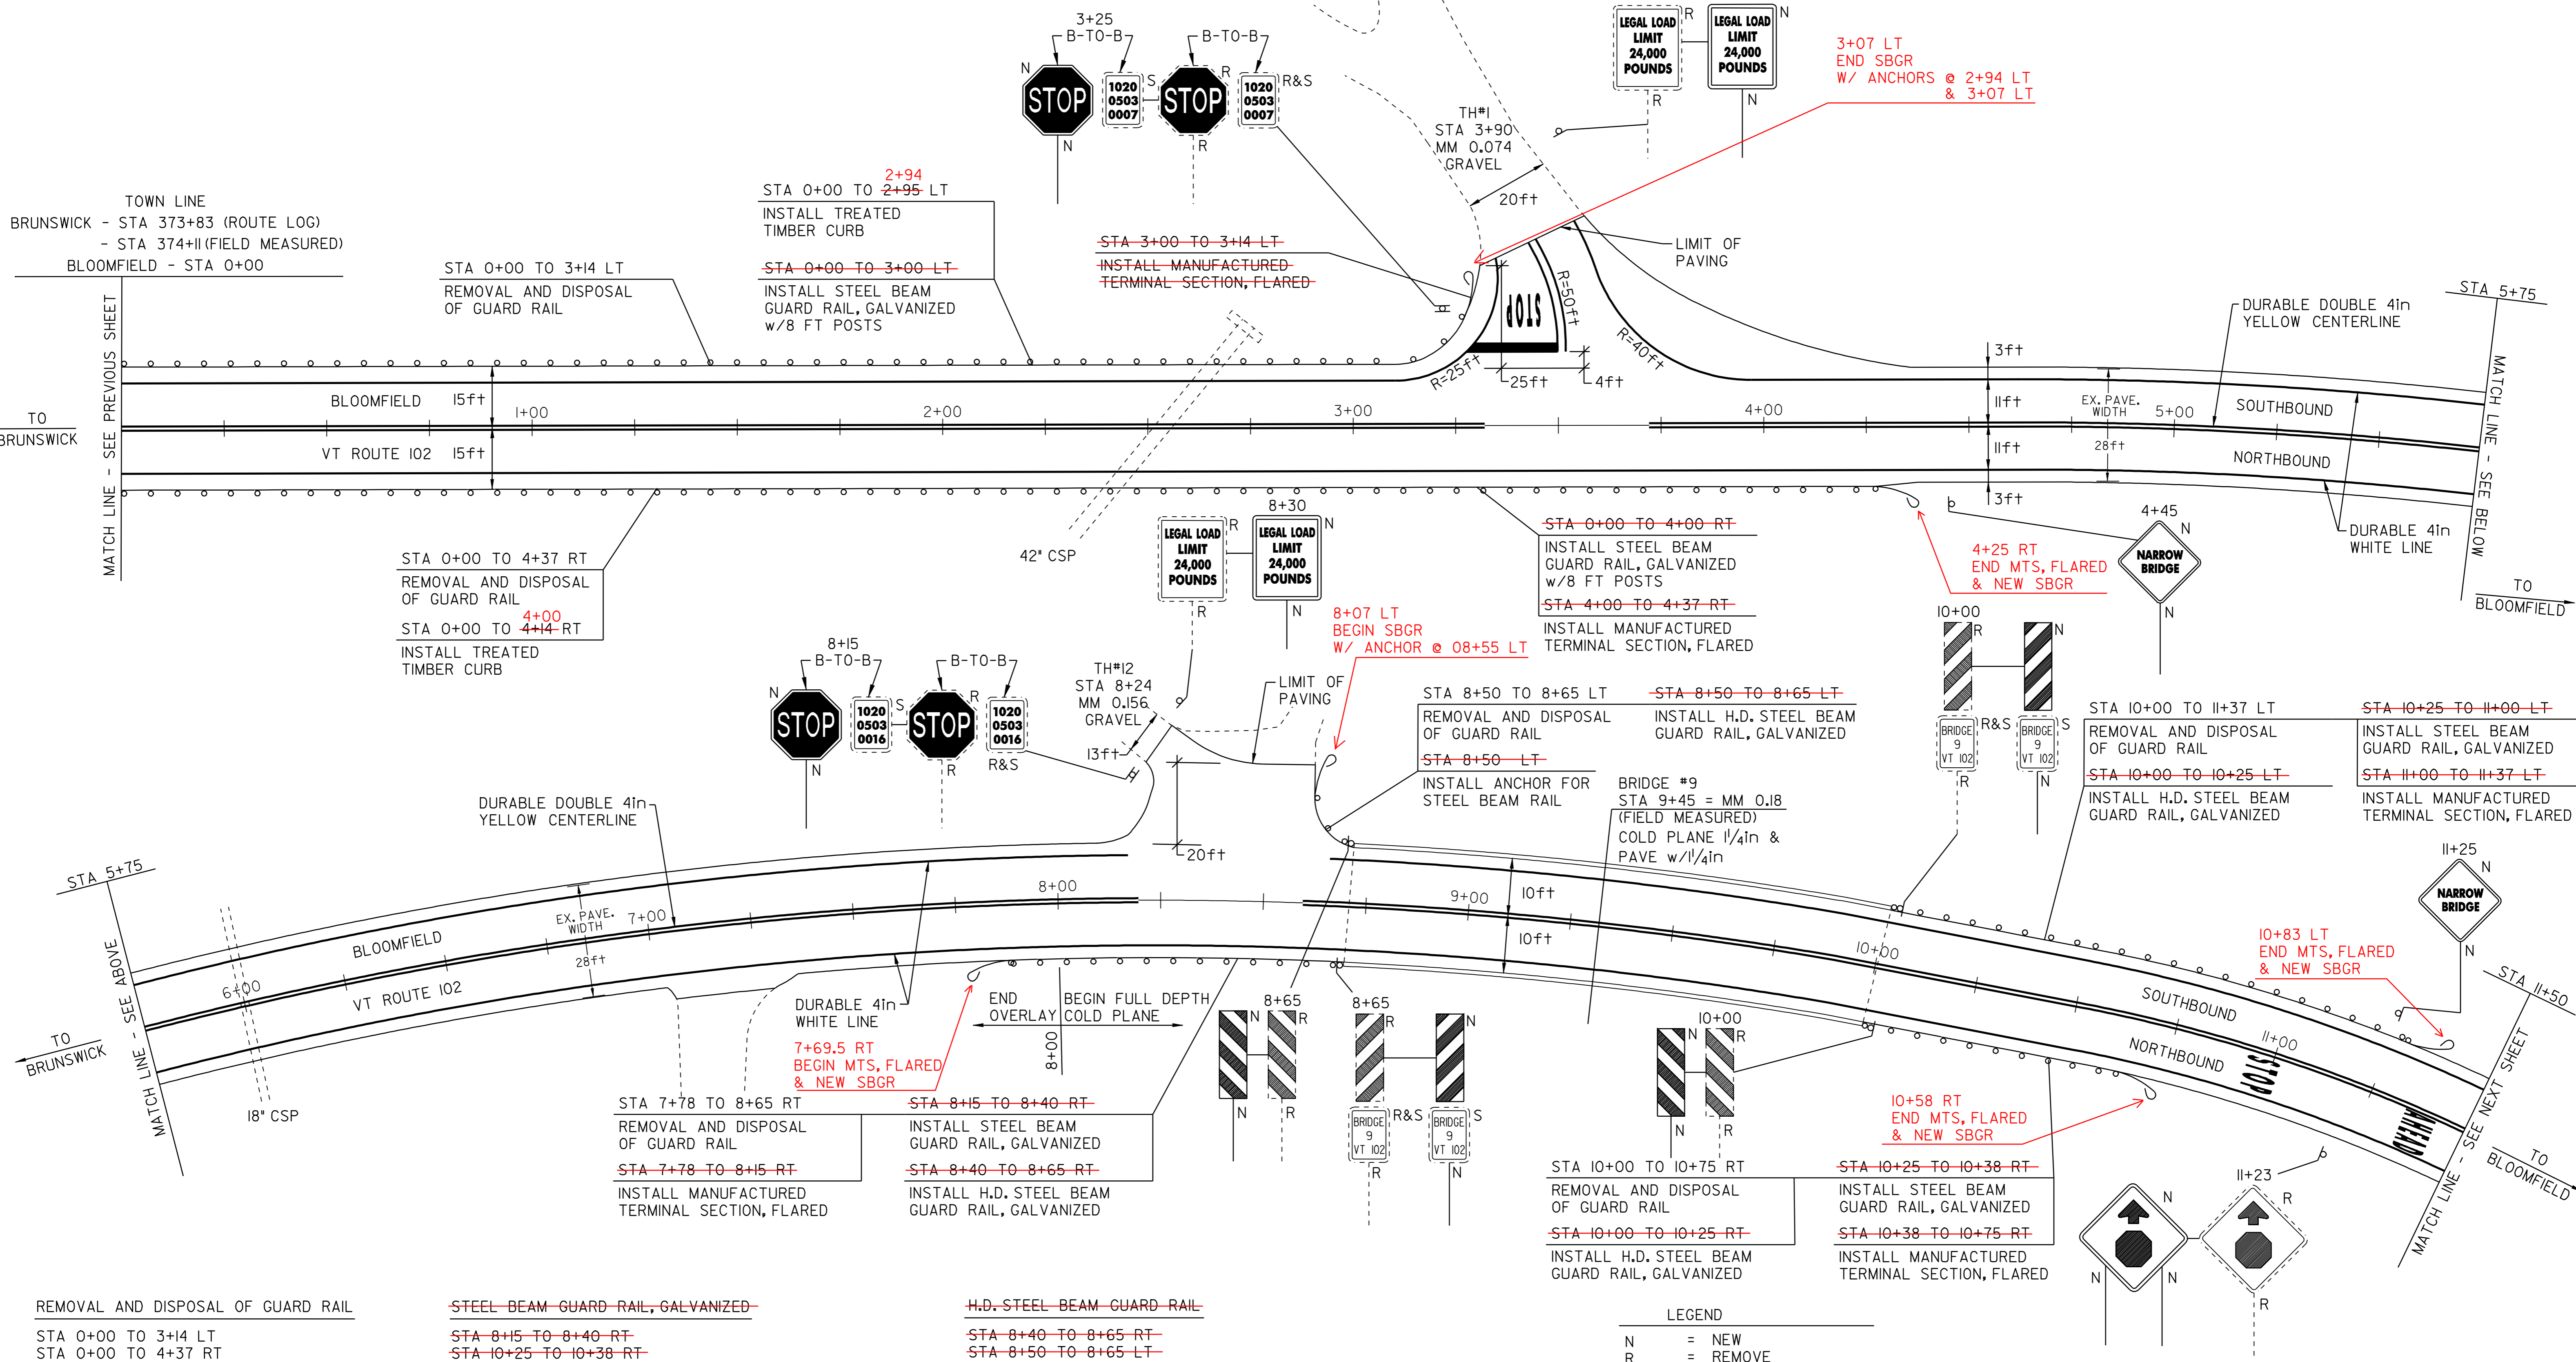

REMOVAL AND DISPOSAL OF GUARD RAIL
STA 0+00 TO 3+14 LT
STA 0+00 TO 4+37 RT
STA 7+78 TO 8+65 RT
STA 8+50 TO 8+65 LT
STA 10+00 TO 10+75 RT
STA 10+00 TO 11+37 LT

~~STEEL BEAM GUARD RAIL, GALVANIZED~~
STA 8+15 TO 8+40 RT
STA 10+25 TO 10+38 RT
STA 10+25 TO 11+00 LT

~~H.D. STEEL BEAM GUARD RAIL~~
STA 8+40 TO 8+65 RT
STA 8+50 TO 8+65 LT
STA 10+00 TO 10+25 RT
STA 10+00 TO 10+25 LT

~~MANUFACTURED TERMINAL SECTION, FLARED~~
STA 3+00 TO 3+14 LT
STA 4+00 TO 4+37 RT
STA 7+78 TO 8+15 RT
STA 10+38 TO 10+75 RT
STA 11+00 TO 11+37 LT

~~STEEL BEAM GUARD RAIL, GALVANIZED w/8 FT POSTS~~
STA 0+00 TO 3+00 LT
STA 0+00 TO 4+00 RT

~~ANCHOR FOR STEEL BEAM RAIL~~
STA 8+50 LT - I -

TREATED TIMBER CURB
STA 0+00 TO 2+95 LT 2+94 LT
STA 0+00 TO 4+14 RT 4+00 RT

LEGEND

N	= NEW
R	= REMOVE
R&S	= REMOVE & SALVAGE
S	= SALVAGE
RET	= RETAIN
B-T-O-B	= BACK TO BACK
⊕	= CATCH BASIN/DI
(N.W.)	= NO WORK REQUIRED (TYP. FOR D.L.'S, & C.B.'S WHERE NOTED)
I	= YIELDING MARKER POST
⊙	= UTILITY POLE
---	= DRIVE

PAVING PROJECT LAYOUT SHEET #22

DESIGNED BY	BCE/PJM	DATE	10-06
DRAWN BY	C.E.A., INC.	DATE	10-06
DESIGN FILE NO.	06c042.dgn		
PRF FILE	06c042p22.i	DATE PLOTTED	24-AUG-2009
PROJ. NAME	MAIDSTONE - BLOOMFIELD		
PROJ. NO.	STP 2609(1)S		
SHEET	32	OF	40 SHEETS

TEMPORARY 4in YELLOW LINE (PAINT)
 DURABLE 4in YELLOW LINE (THERMOPLASTIC)
 STA 11+50 TO 20+00
 (WITH CENTERLINE BREAKS FOR TOWN HIGHWAYS)

TEMPORARY 4in WHITE LINE (PAINT)
 DURABLE 4in WHITE LINE (THERMOPLASTIC)
 STA 11+50 TO 20+00
 (WITH EDGELINE BREAKS FOR TOWN HIGHWAYS)


REMOVING SIGNS
 10

TEMPORARY LETTER OR SYMBOL (PAINT)
 DURABLE LETTER OR SYMBOL (THERMOPLASTIC)
 STA 17+21RT
 STA 17+99 LT

TEMPORARY 24in STOP BAR (PAINT)
 DURABLE 24in STOP BAR (THERMOPLASTIC)
 STA 17+35 RT
 STA 17+93 LT

VEHICLE DETECTOR LOOP NOTES:

1. THIS PLAN IS NOT TO SCALE AND SHALL BE USED AS A GUIDE. THE CONTRACTOR SHALL CONFIRM ALL LOCATIONS, INCLUDING, BUT NOT LIMITED TO, UTILITIES, POLES, PULL BOXES, STRIPING, AND LOOP DETECTORS. THE CONTRACTOR SHALL CONFIRM ALL LOCATIONS IN THE FIELD WITH THE RESIDENT ENGINEER PRIOR TO INSTALLATION.
2. PRIOR TO COLD PLANING, THE CONTRACTOR SHALL DISCONNECT THE VEHICLE DETECTOR LOOPS AT THE TRAFFIC COUNTERS.
3. SAW CUT THE LEVELING COURSE FOR THE PLACEMENT OF ALL PROPOSED VEHICLE DETECTOR LOOPS. ONCE THE PROPOSED VEHICLE DETECTOR LOOPS ARE INSTALLED, THE INDUCTANCE, RESISTANCE, AND LEAKAGE TO GROUND MUST BE TESTED USING PROPERLY CALIBRATED EQUIPMENT. THESE TEST RESULTS SHALL BE COMPARED WITH THE CALCULATED VALUES SHOWN ON THE LAYOUT PLANS AND THE FIELD MEASURED VALUES SHALL BE RECORDED ON THE LAYOUT PLANS. UPON COMPLETION OF THE INSTALLATION OF THE PROPOSED VEHICLE LOOP DETECTORS, THE COUNTERS SHALL BE RETURNED TO NORMAL OPERATION.
4. THE CONTRACTOR SHALL USE THE EXISTING CONDUIT WHICH RUNS FROM THE CURB TO THE CONTROLLER PANEL FOR THE NEW LOOP DETECTORS.
5. WORK SHALL BE PAID FOR UNDER ITEM 678.22, VEHICLE LOOP DETECTOR.
6. WORK IMPROVEMENTS CONSISTING OF THOSE SHOWN ON PLANS SHALL BE PERFORMED ACCORDING TO SPECIFICATIONS AND STANDARD DRAWINGS OF VERMONT AGENCY OF TRANSPORTATION. VEHICLE DETECTOR LOOPS SHALL COMPLY WITH VTRANS STANDARD E-172.

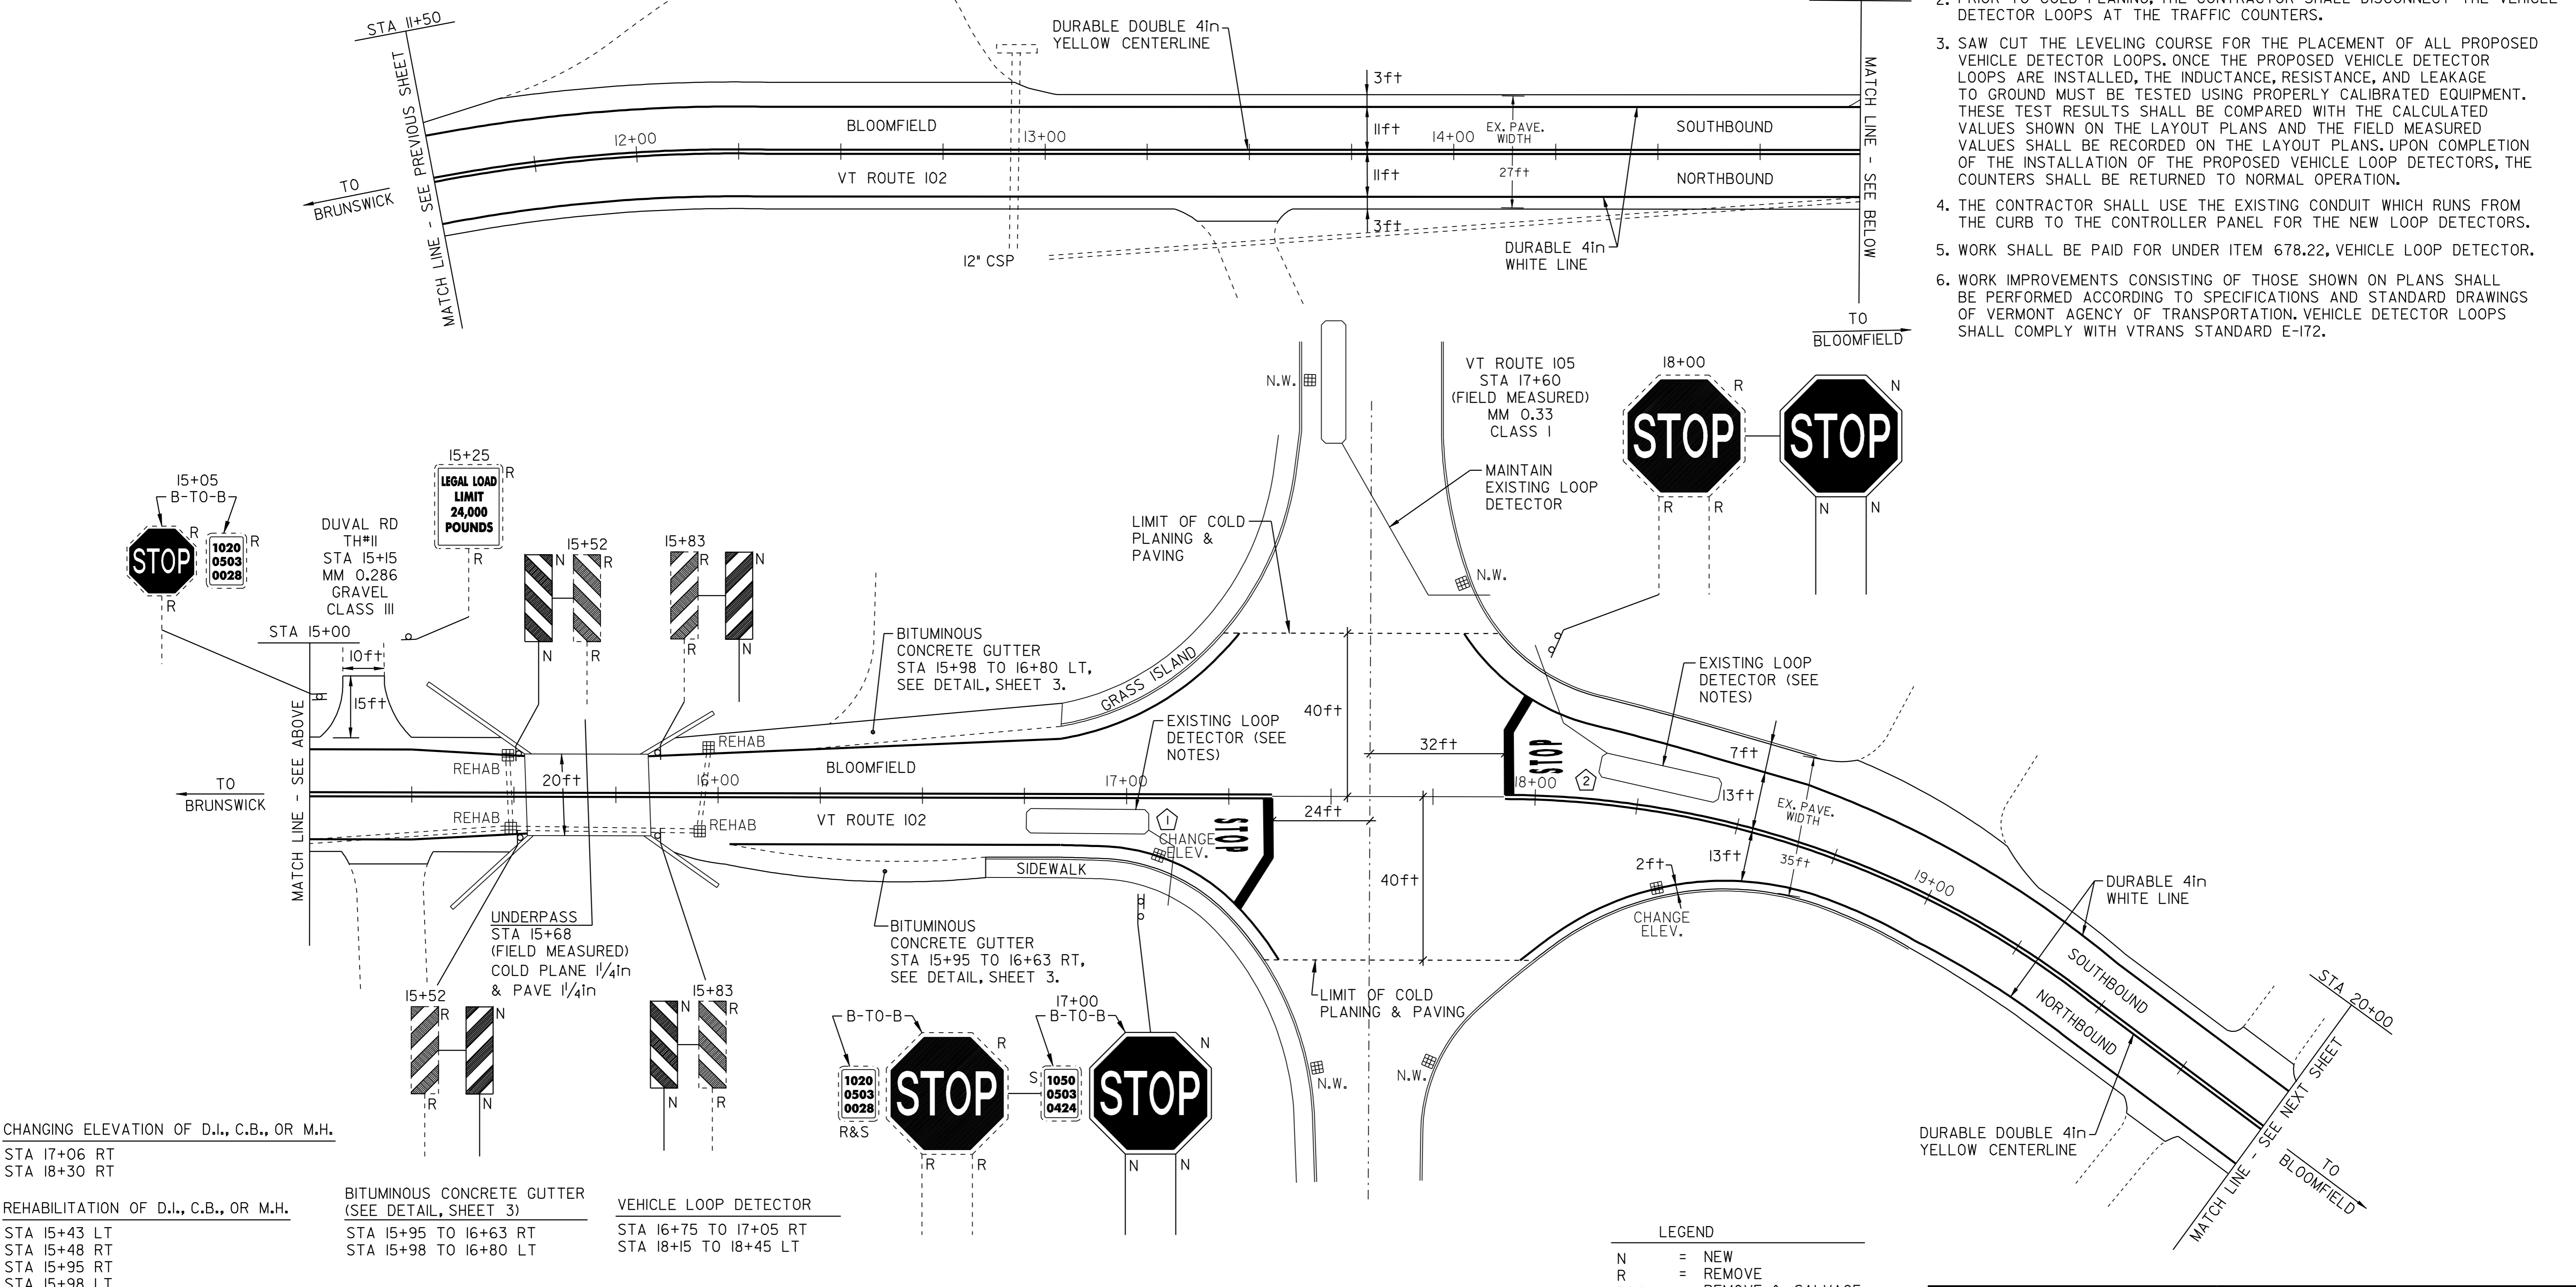

CHANGING ELEVATION OF D.I., C.B., OR M.H.
 STA 17+06 RT
 STA 18+30 RT

REHABILITATION OF D.I., C.B., OR M.H.
 STA 15+43 LT
 STA 15+48 RT
 STA 15+95 RT
 STA 15+98 LT

BITUMINOUS CONCRETE GUTTER (SEE DETAIL, SHEET 3)
 STA 15+95 TO 16+63 RT
 STA 15+98 TO 16+80 LT

VEHICLE LOOP DETECTOR
 STA 16+75 TO 17+05 RT
 STA 18+15 TO 18+45 LT

LEGEND

- N = NEW
- R = REMOVE
- R&S = REMOVE & SALVAGE
- S = SALVAGE
- RET = RETAIN
- B-T-O-B = BACK TO BACK
- ☐ = CATCH BASIN/DI
- (N.W.) = NO WORK REQUIRED (TYP. FOR D.I.'S, & C.B.'S WHERE NOTED)
- I = YIELDING MARKER POST
- ⊕ = UTILITY POLE
- = DRIVE

VEHICLE DETECTOR LOOPS									
LOOP	SIZE (ft)	TYPE & NO. TURNS	MODE	INDUCTANCE (uH)		RESISTANCE (ohms)		LEAKAGE TO GROUND (ft-ohms)	ESTIMATED QUANT. (ft)
				CALC.	ACT.	CALC.	ACT.		
102	6x30	LONG-2	PASSAGE	266		0.33			102
112	6x30	LONG-2	PASSAGE	268		0.36			112

ALL CALCULATED VALUES ARE AT THE CONTROLLER, MEASURED VALUES MUST BE FILLED IN PRIOR TO TEST PERIOD.

PAVING PROJECT LAYOUT SHEET #23


DESIGNED BY BCE/PJM DATE 10-06
 DRAWN BY C.E.A., INC. DATE 10-06
 DESIGN FILE NO. 06c042.dgn
 PRF FILE 06c042p23.1 DATE PLOTTED 24-AUG-2009
 PROJ. NAME **MAIDSTONE - BLOOMFIELD**
 PROJ. NO. **STP 2609(1)S**
 SHEET **33** OF **40** SHEETS

TEMPORARY 4in YELLOW LINE (PAINT)
 DURABLE 4in YELLOW LINE (THERMOPLASTIC)
 STA 20+00 TO 26+75 SOLID LT&RT
 (WITH CENTERLINE BREAKS FOR TOWN HIGHWAYS)

TEMPORARY 4in WHITE LINE (PAINT)
 DURABLE 4in WHITE LINE (THERMOPLASTIC)
 STA 20+00 TO 26+75 SOLID LT&RT
 (WITH EDGELINE BREAKS FOR TOWN HIGHWAYS)

TEMPORARY LETTER OR SYMBOL (PAINT)
 DURABLE LETTER OR SYMBOL (THERMOPLASTIC)
 STA 22+84 LT "STOP AHEAD"
 STA 22+84 RT "STOP AHEAD"

REMOVING SIGNS
 4

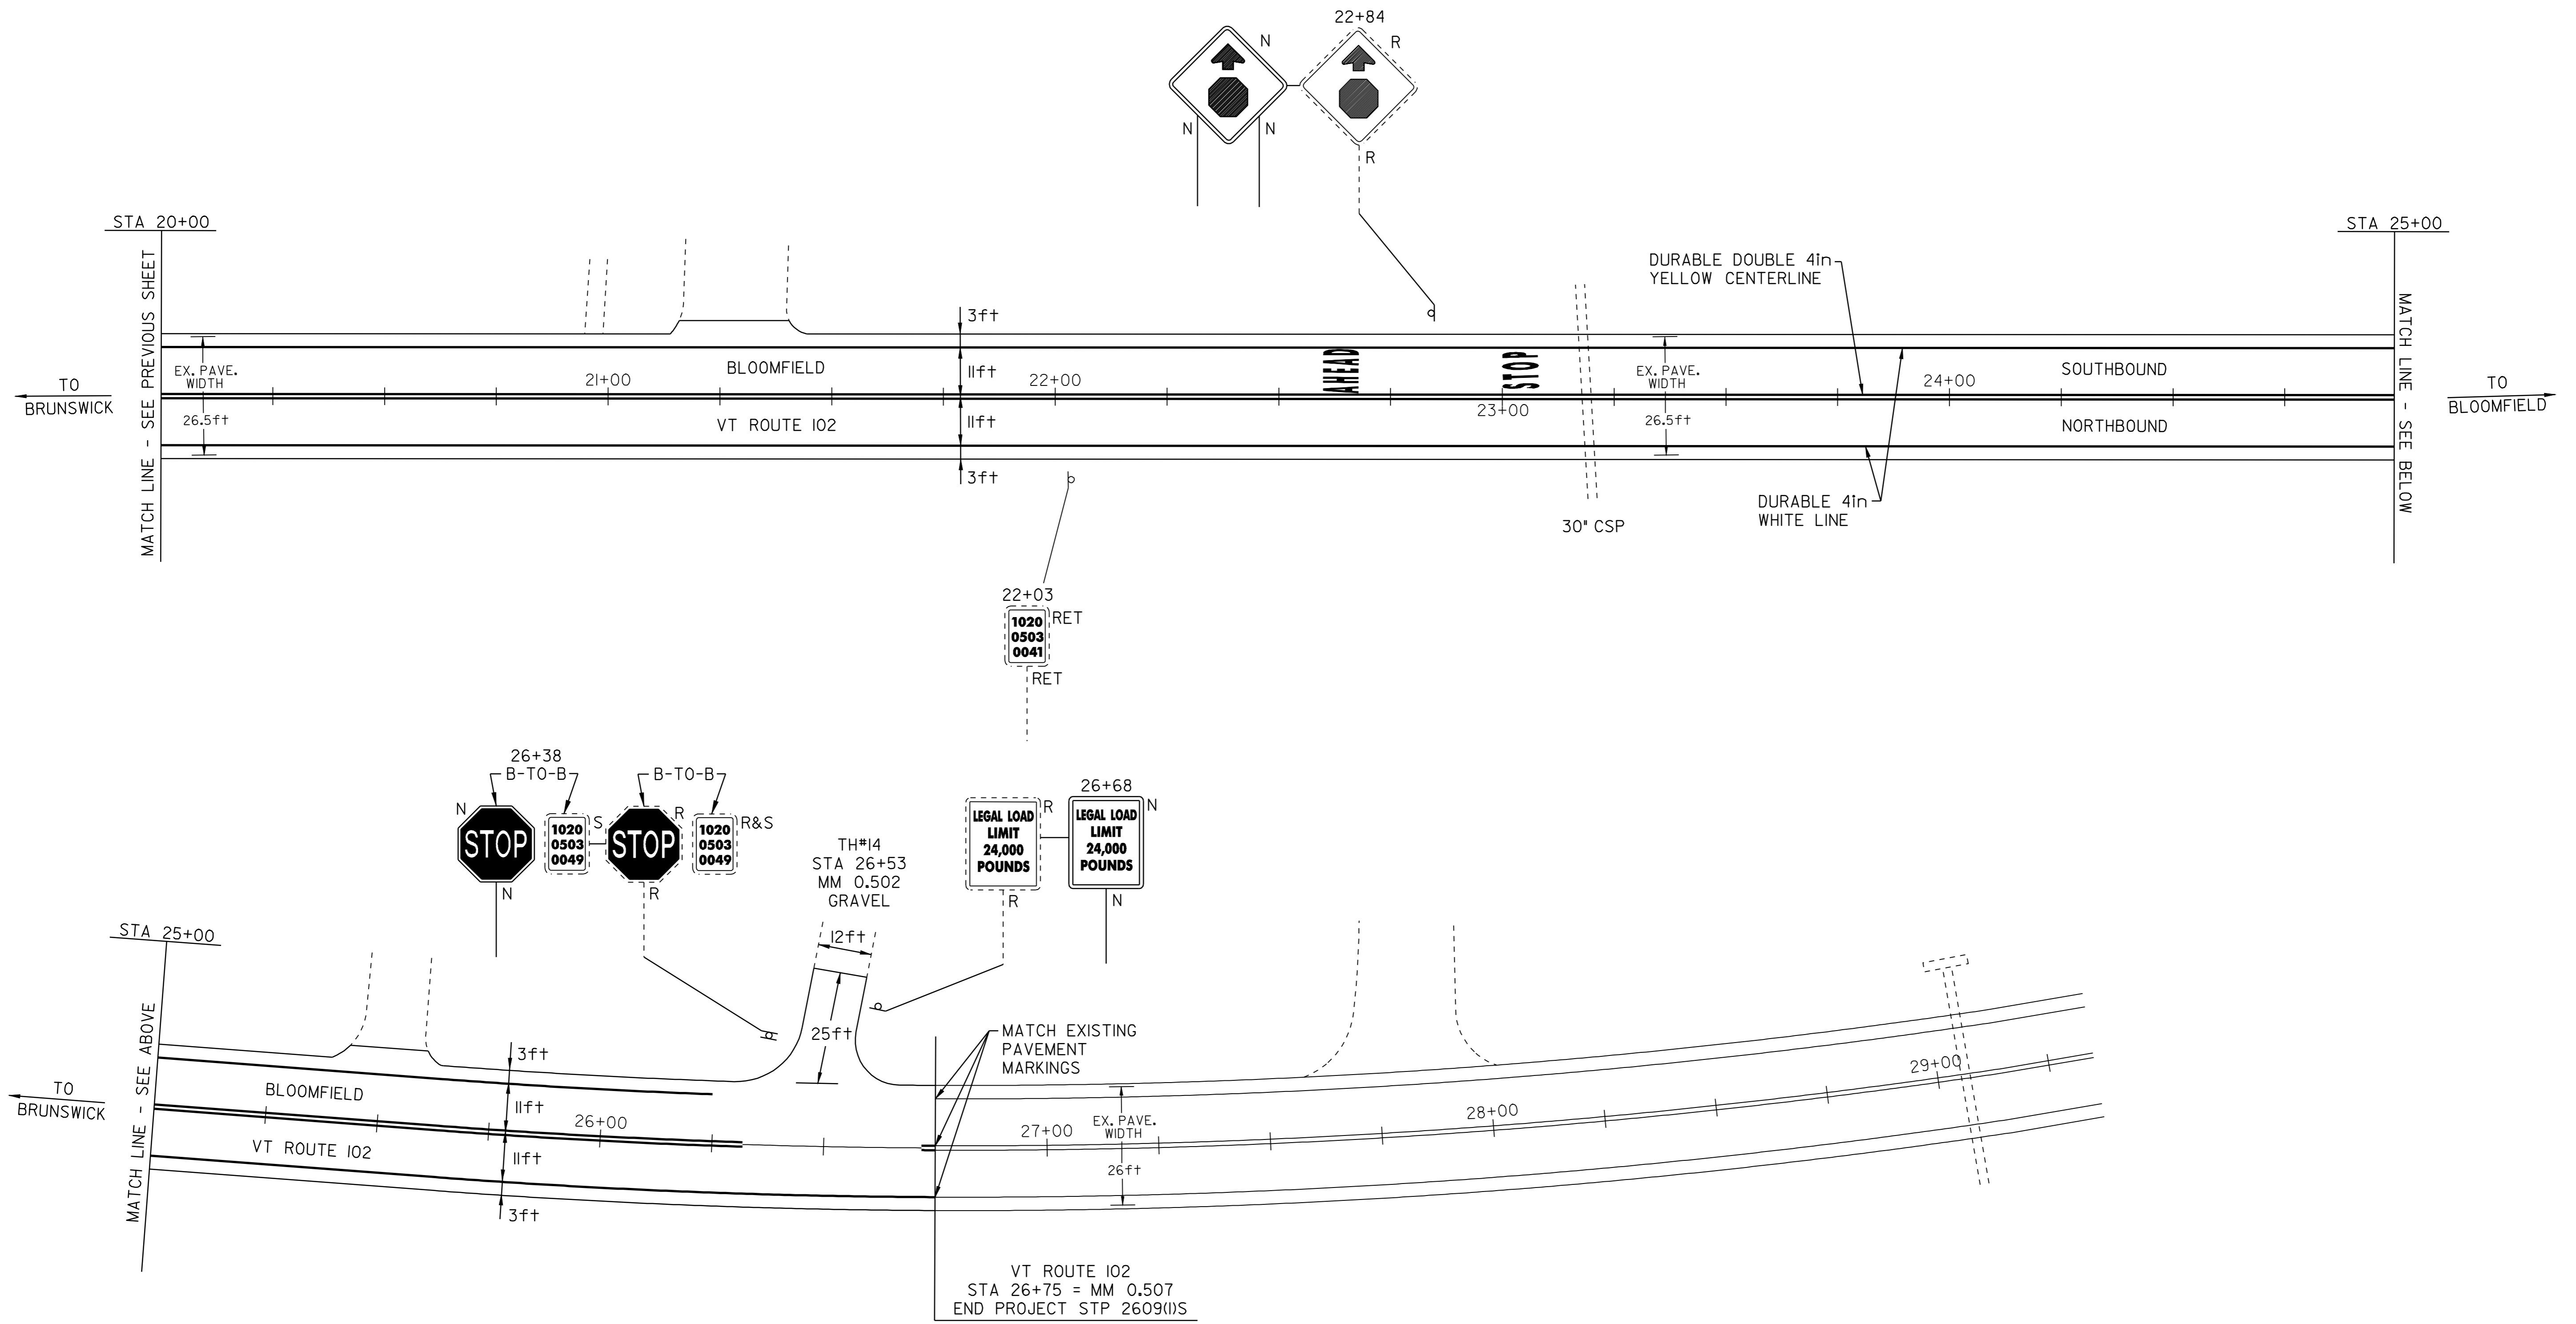

<h1>PAVING PROJECT LAYOUT SHEET #24</h1>	DESIGNED BY	BCE/PJM	DATE	10-06
	DRAWN BY	C.E.A., INC.	DATE	10-06
	DESIGN FILE NO.	06c042.dgn		
	PRF FILE	06c042p24.i	DATE PLOTTED	24-AUG-2009
	PROJ. NAME	MAIDSTONE - BLOOMFIELD		
PROJ. NO.	STP 2609(1)S			
SHEET	34	OF	40	SHEETS

KILOMETER MARKER, STATION, OR SIGN NUMBER	SIGN LEGEND	SIGN DIMENSIONS		NEW & SALVAGED SIGNS				EXIST POST RETAIN	NO. OF POSTS	NEW SIGN POSTS																				REMARKS	SIGN DETAIL			
		EA	WIDTH (in)	HEIGHT (in)	"A"	"B"	SALV SIGN			SALV TIS	FLANGED CHANNEL			SQUARE STEEL (in)			TUBULAR ALUMINUM (in)			TUBULAR STEEL (in)				W-SHAPE STEEL			DETAIL ON SHEET NUMBER	STD. SHEET NUMBER						
											lb/ft	1.12	2.0	3.0	1.75	2.0	2.5	A SECTION	S SQUARE	3.0	4.0	4.0 MOD.	FOUNDATION	3.0	3.5	4.0			5.0		FTG. SIZE		WEIGHT	POST SIZE
																															24"	30"		


OPTION ITEMS																															
BL00MFIELD 3+25 LT		1	30	30	6.25					1			X		X														BACK TO BACK	E-143	
3+55 LT		1	24	30	5.0					1			X		X														REFER TO STANDARD E-121 FOR PLACEMENT.	E-141	
4+45 RT		1	30	30	6.25					1			X		X															E-154	
8+15 LT		1	30	30	6.25					1			X		X														BACK TO BACK	E-143	
8+30 LT		1	24	30	5.0					1			X		X														REFER TO STANDARD E-121 FOR PLACEMENT.	E-141	
8+65 LT		1	12	36	3.0					1			X		X															E-120	
8+65 RT		1	12	36	3.0					1			X		X															E-120	
10+00 LT		1	12	36	3.0					1			X		X															E-120	
10+00 RT		1	12	36	3.0					1			X		X															E-120	
11+23 RT		1	36	36	9.0					2			X		X															E-150	
11+25 LT		1	30	30	6.25					1			X		X															E-154	

FINAL POST LENGTHS ARE TO BE DETERMINED IN THE FIELD. POST SIZES ARE COMPUTED BASED ON INFORMATION FURNISHED ON THE STANDARD SHEETS AND THE ROADWAY, TRAFFIC & SAFETY DIVISION'S "SIGN POST DESIGN GUIDELINE."	SF	SF	EA.	SF		LF	LF	LF	LF	LF	LF	EA.	LB	LB	LB	EA.	LB	LB	LB	EA.	EA.	LB								
						180																								
	SHEET TOTALS	56.0		4			180				180																			


TRAFFIC SIGN SUMMARY SHEET #2

PROJECT: **MAIDSTONE - BLOOMFIELD**
 DESIGN FILE NAME: 06c042.dgn
 IPARM FILE NAME: 06c042ts2.1
 SURVEYED BY:
 SQUAD LEADER:

PROJECT NO.: **STP 2609(1)S**
 DATE: 8-06
 PLOT DATE: 24-AUG-2009 08:4
 SURVEY DATE:
 DRAWN BY: C.E.A., INC.
 SHEET: **36** OF **40**

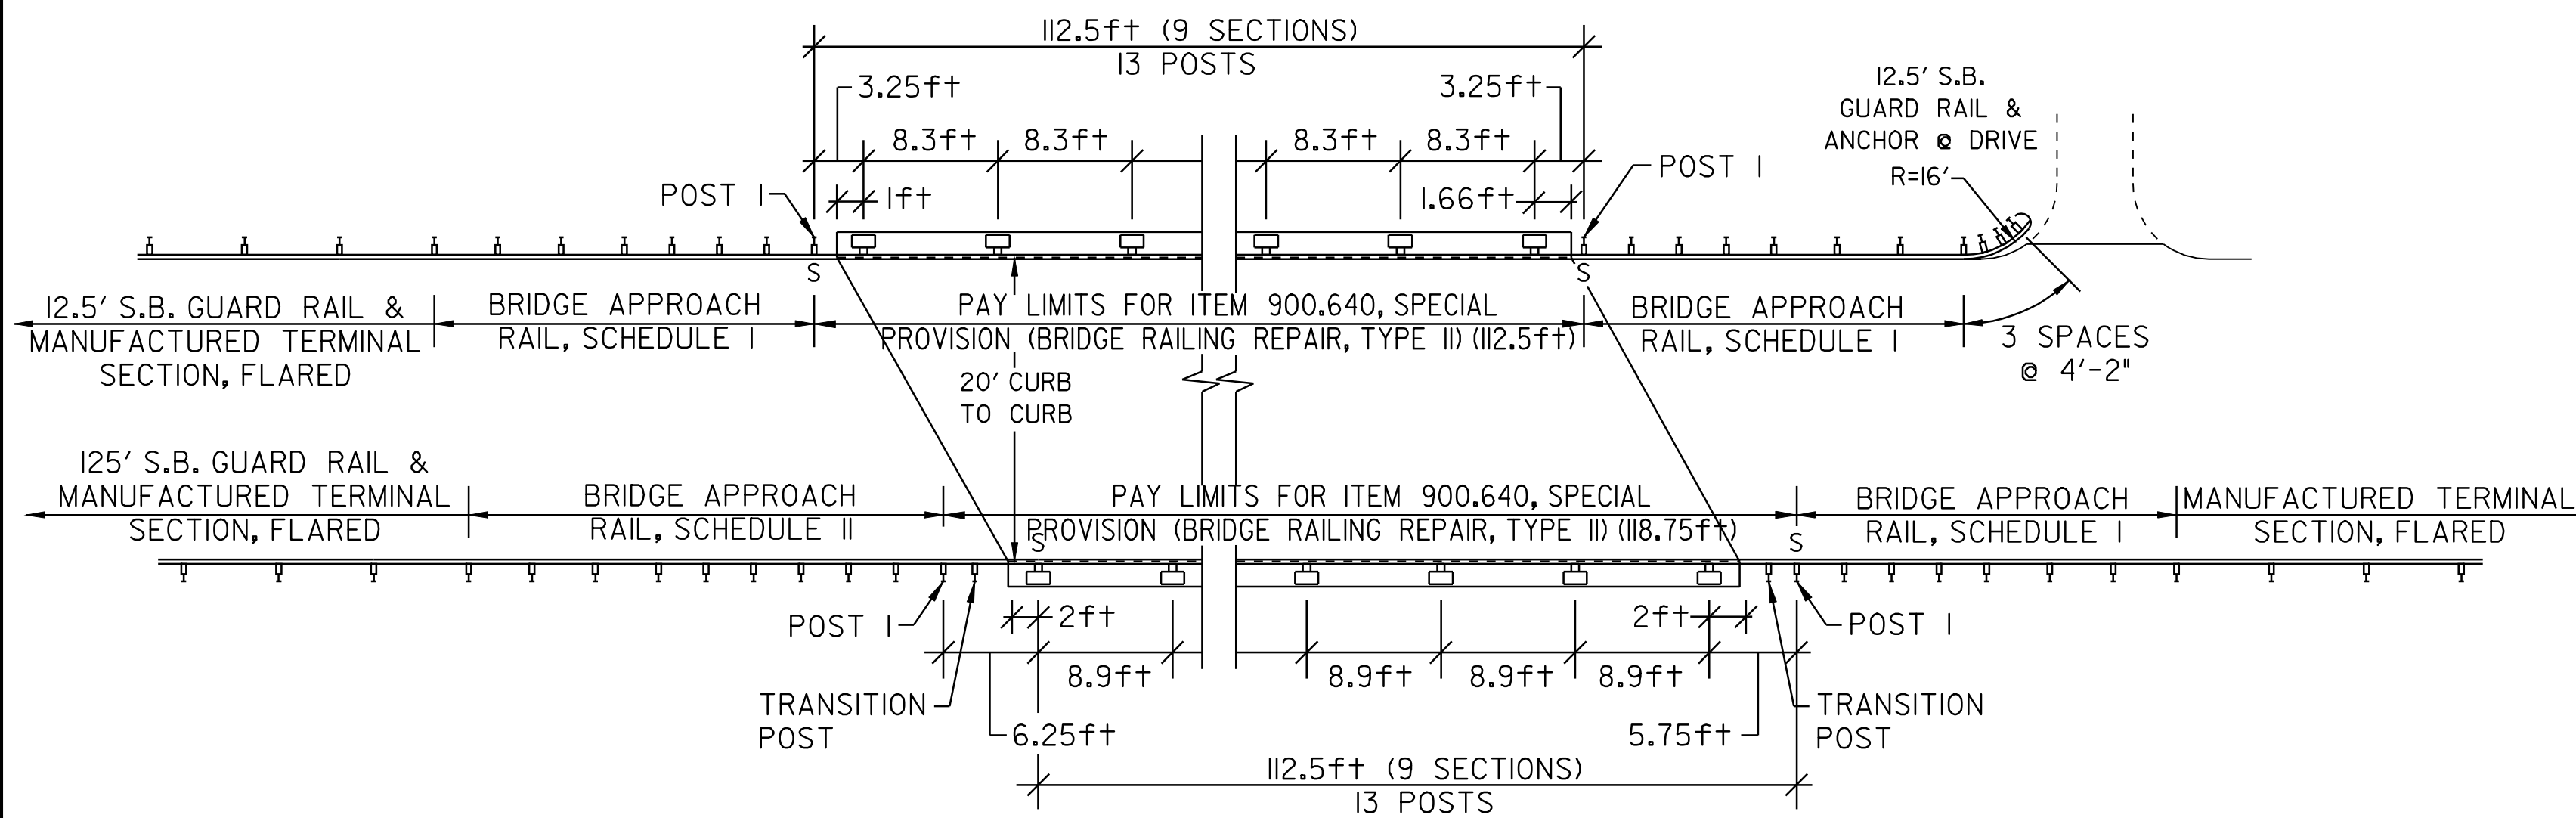

BRUNSWICK - BRIDGE #6
STA 137+15 = MM 2.60
(FIELD MEASURED)

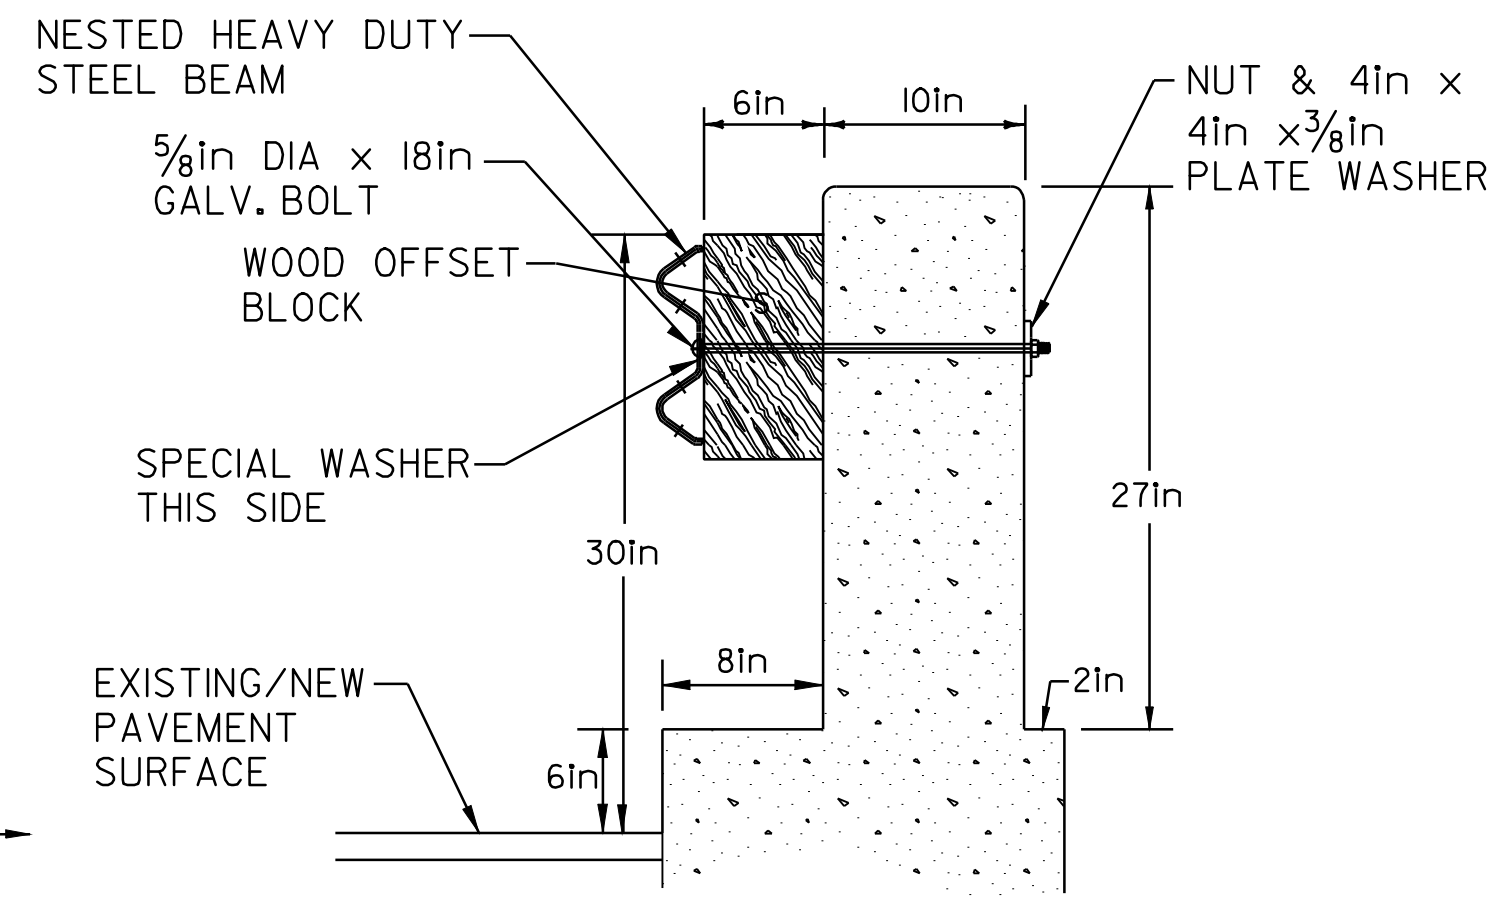

POST DETAIL


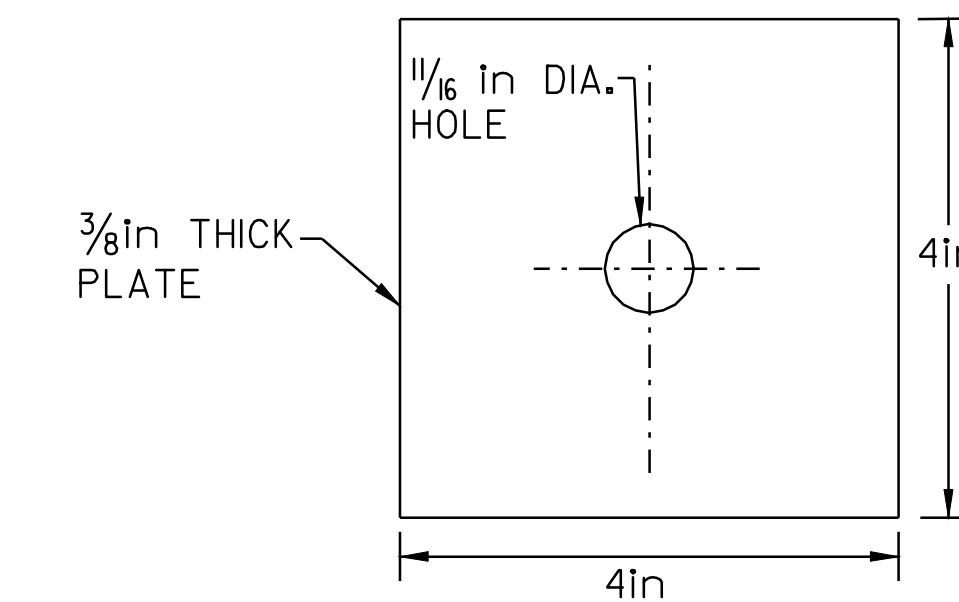



PLATE WASHER DETAIL
 (MATERIAL SHALL MEET AASHTO M270M/M270 GRADE 50)

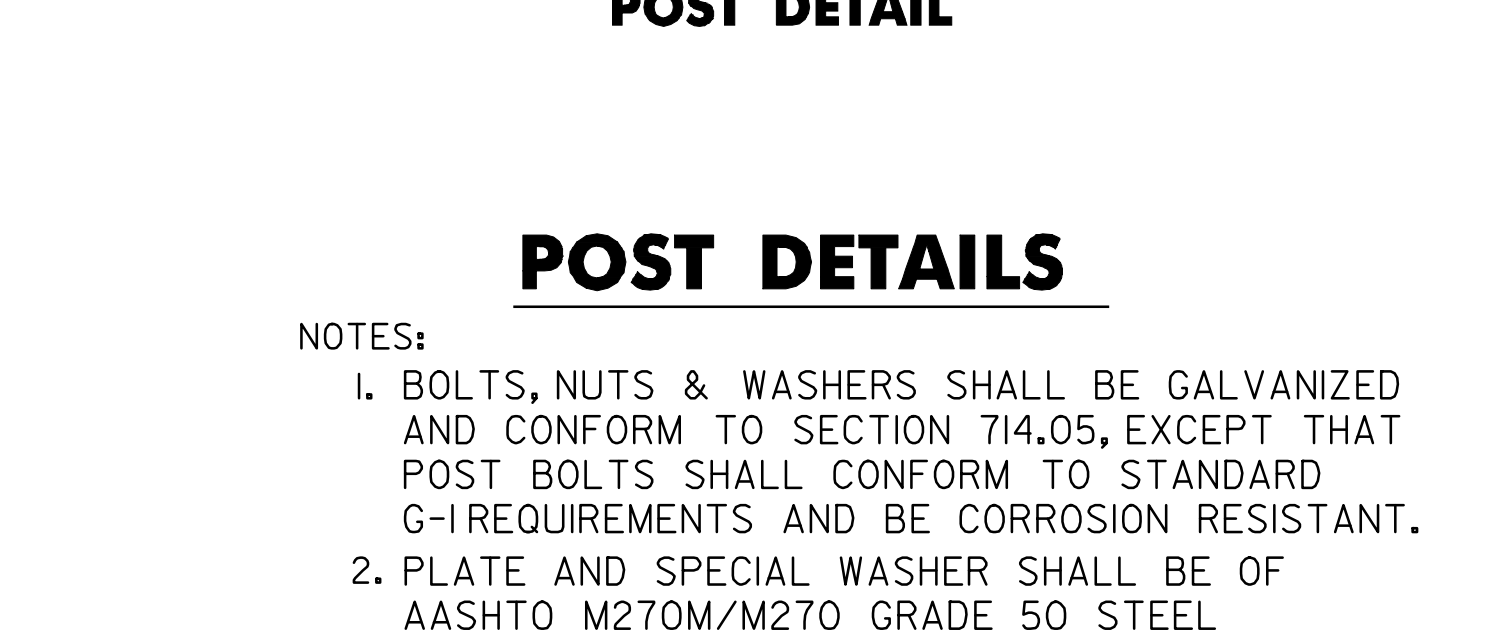

SPECIAL WASHER DETAIL
 (MATERIAL SHALL MEET AASHTO M270M/M270 GRADE 50)


- NOTES:**
1. BOLTS, NUTS & WASHERS SHALL BE GALVANIZED AND CONFORM TO SECTION 714.05, EXCEPT THAT POST BOLTS SHALL CONFORM TO STANDARD G-1 REQUIREMENTS AND BE CORROSION RESISTANT.
 2. PLATE AND SPECIAL WASHER SHALL BE OF AASHTO M270M/M270 GRADE 50 STEEL

POST DETAILS

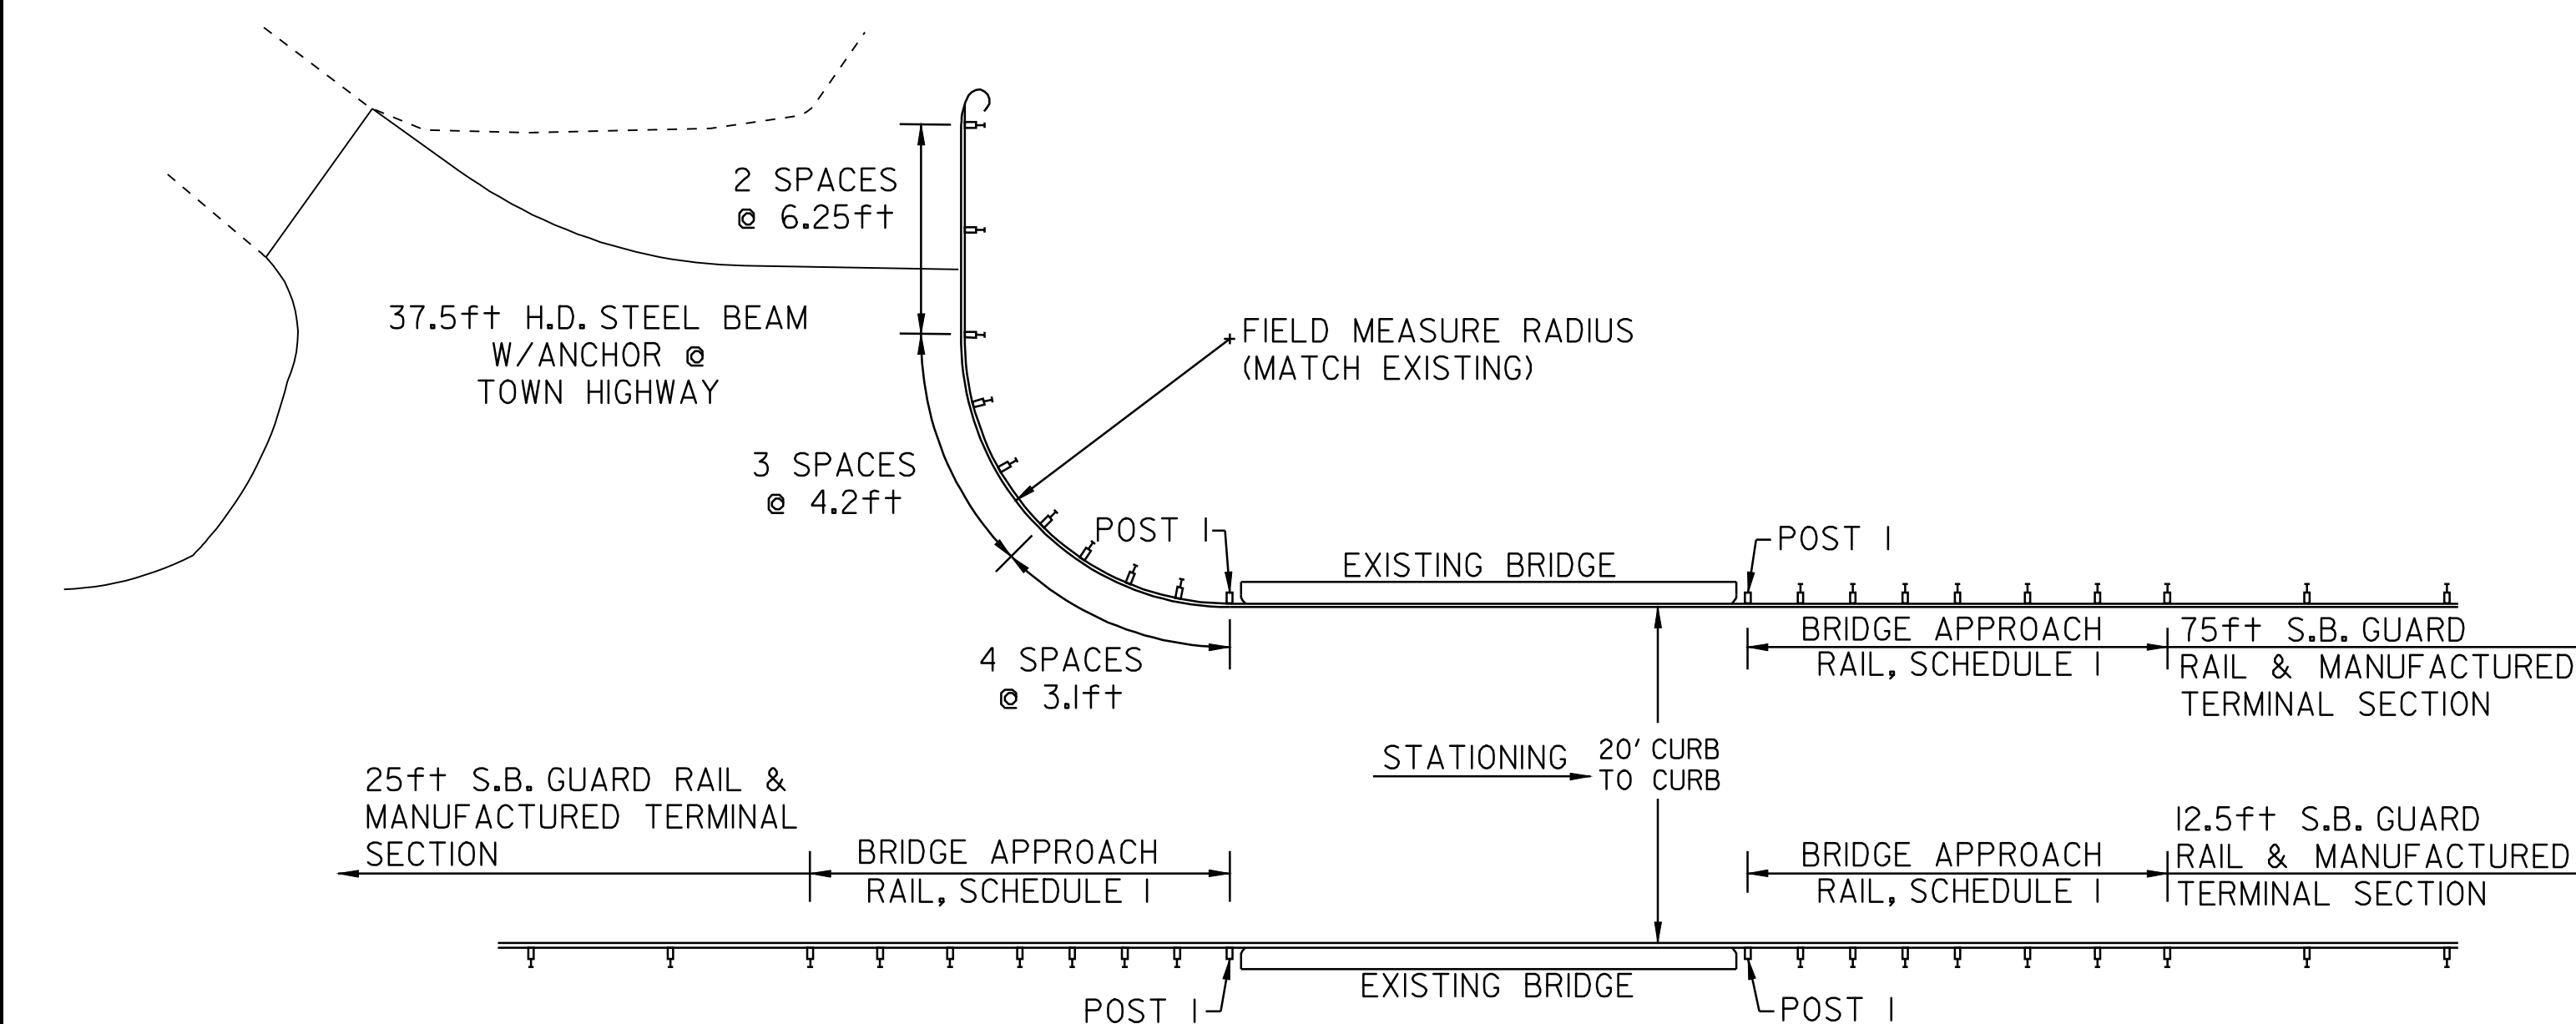

BLOOMFIELD - BRIDGE #9
STA 9+45 = MM 0.18
(FIELD MEASURED)

BRIDGE DETAIL SHEET #2	DESIGNED BY	BCE/PJM	DATE	10-06
	DRAWN BY	C.E.A., INC.	DATE	10-06
	DESIGN FILE NO.	06c042.dgn		
	PRF FILE	06c042br2.1	DATE PLOTTED	24-AUG-2009 09
	PROJ. NAME	MAIDSTONE - BLOOMFIELD		
PROJ. NO.	STP 2609(1)S			
SHEET	39	OF	40	SHEETS

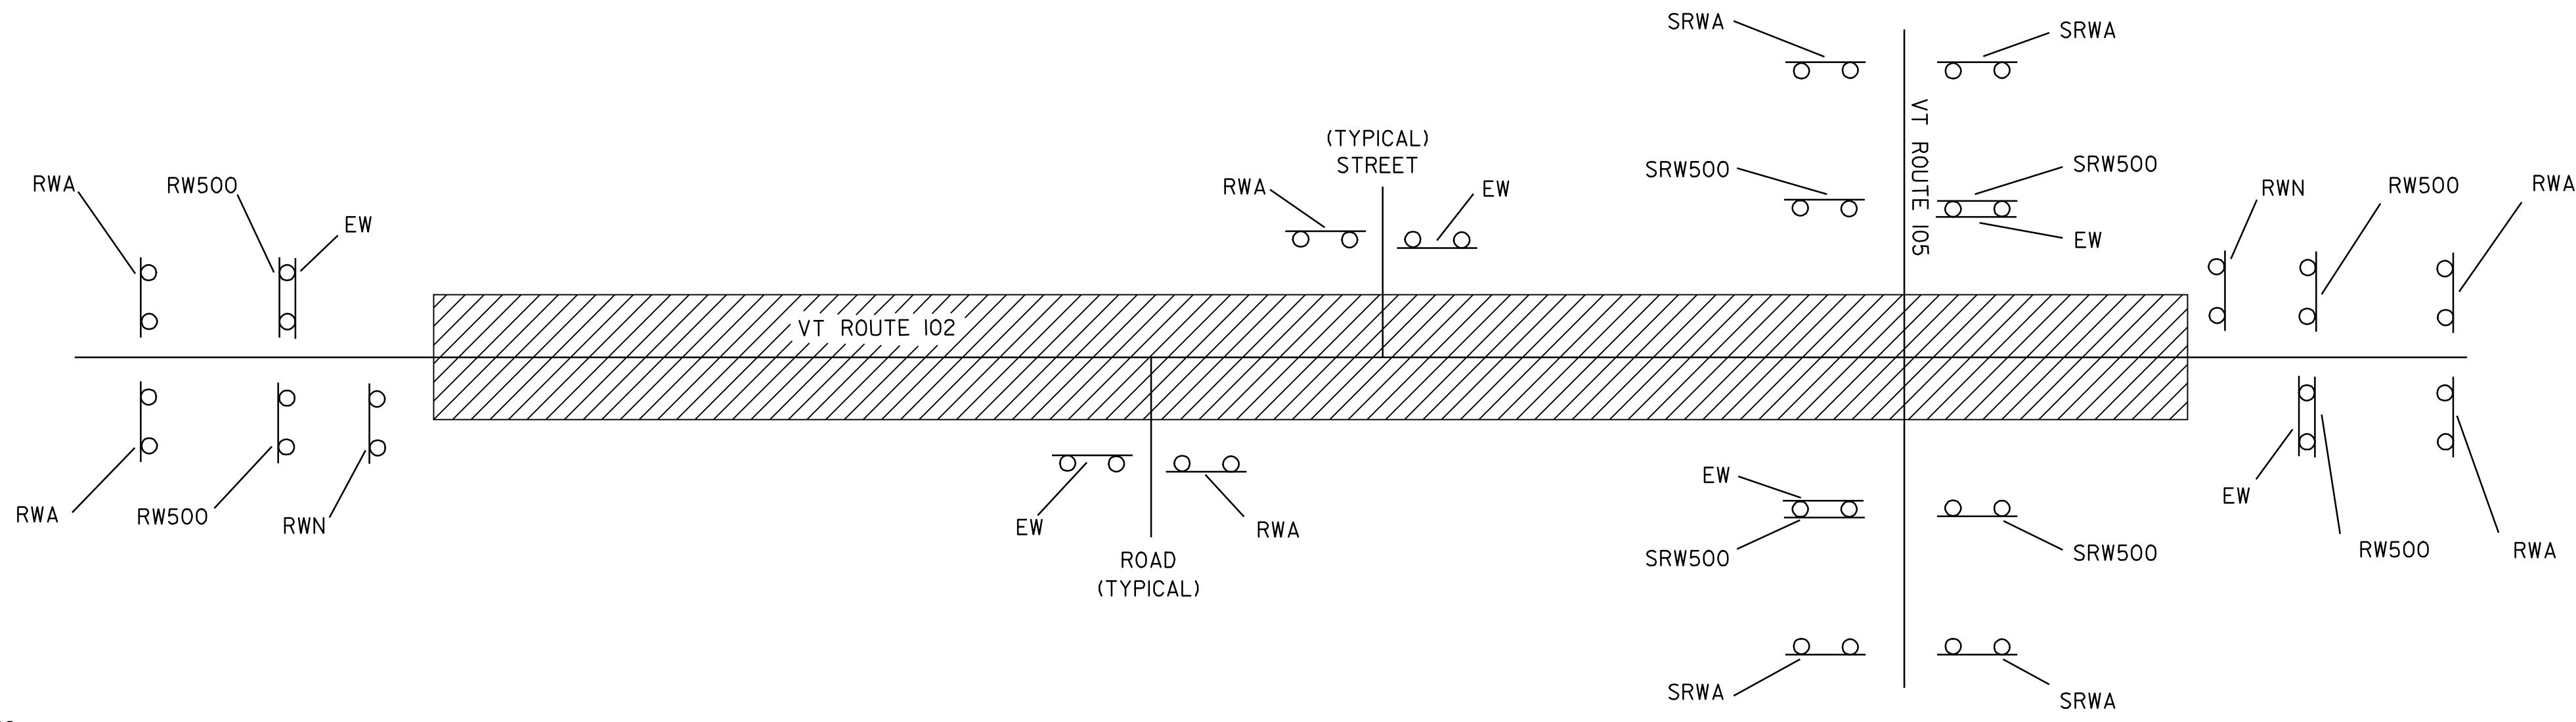

TOWN HIGHWAY	RWA	RW500	SRWA	SRW500	EW	RWN
MAIDSTONE						
BEGIN PROJECT	2	2			1	1
MAIDSTONE STATE HIGHWAY	1				1	
HALL RD	1				1	
SFH	1				1	
BLOOMFIELD						
TH#1	1				1	
TH#12	1				1	
VT ROUTE 105			4	4	2	
TH#14	1				1	
END PROJECT	2	2			1	1
TOTALS	10	4	4	4	10	2



- NOTES:**
1. THE CONTRACTOR SHALL SUBMIT A TRAFFIC CONTROL PLAN FOR APPROVAL PRIOR TO THE START OF CONSTRUCTION. THE COST OF PREPARING THIS PLAN (AND MAKING CHANGES IF NECESSARY) SHALL NOT BE PAID SEPARATELY BUT SHALL BE INCIDENTAL TO ITEM 641.10, "TRAFFIC CONTROL".
 2. THE CONTRACTOR SHALL INCLUDE A CONSTRUCTION SIGN APPROACH PACKAGE FOR EXPECTED LANE CLOSURES AND WORK ZONE SPEED REDUCTIONS IN COMPLIANCE WITH VTRANS STANDARD E-103. PAYMENT FOR PROVIDING THIS PACKAGE SHALL BE INCIDENTAL TO ITEM 641.10, "TRAFFIC CONTROL".
 3. THE MUTCD 2003 SHALL BE THE STANDARD FOR ALL TRAFFIC CONTROL DEVICES. EXISTING SIGNS, SIGNALS AND MARKINGS SHALL BE VALID UNTIL SUCH TIME AS THEY ARE REPLACED OR RECONSTRUCTED. WHEN NEW TRAFFIC CONTROL DEVICES ARE ERECTED OR PLACED OR EXISTING TRAFFIC CONTROL DEVICES ARE REPLACED OR REPAIRED THE EQUIPMENT, DESIGN, METHOD OF INSTALLATION, PLACEMENT OR REPAIR SHALL CONFORM TO THESE STANDARDS.
 4. NO CONSTRUCTION SIGNS SHALL BE INSTALLED AS TO INTERFERE OR OBSTRUCT THE VIEW OF EXISTING TRAFFIC CONTROL DEVICES, STOPPING SIGHT DISTANCE, AND CORNER SIGHT DISTANCE FROM DRIVES AND TOWN HIGHWAYS.
 5. ON VTRANS STANDARDS E-103, SIGN W4-2 MAY BE REPLACED WITH W9-2:

CONSTRUCTION APPROACH SIGNING


SEE STANDARDS E-100 AND E-100A FOR SIGN PLACEMENT

PAYMENT FOR CONSTRUCTION SIGNING WILL BE MADE UNDER ITEM 641.10, TRAFFIC CONTROL.

RESIDENT ENGINEER, AT HIS OR HER DISCRETION, SHALL ELIMINATE CONSTRUCTION APPROACH SIGNING AT DEAD END LOCATIONS.

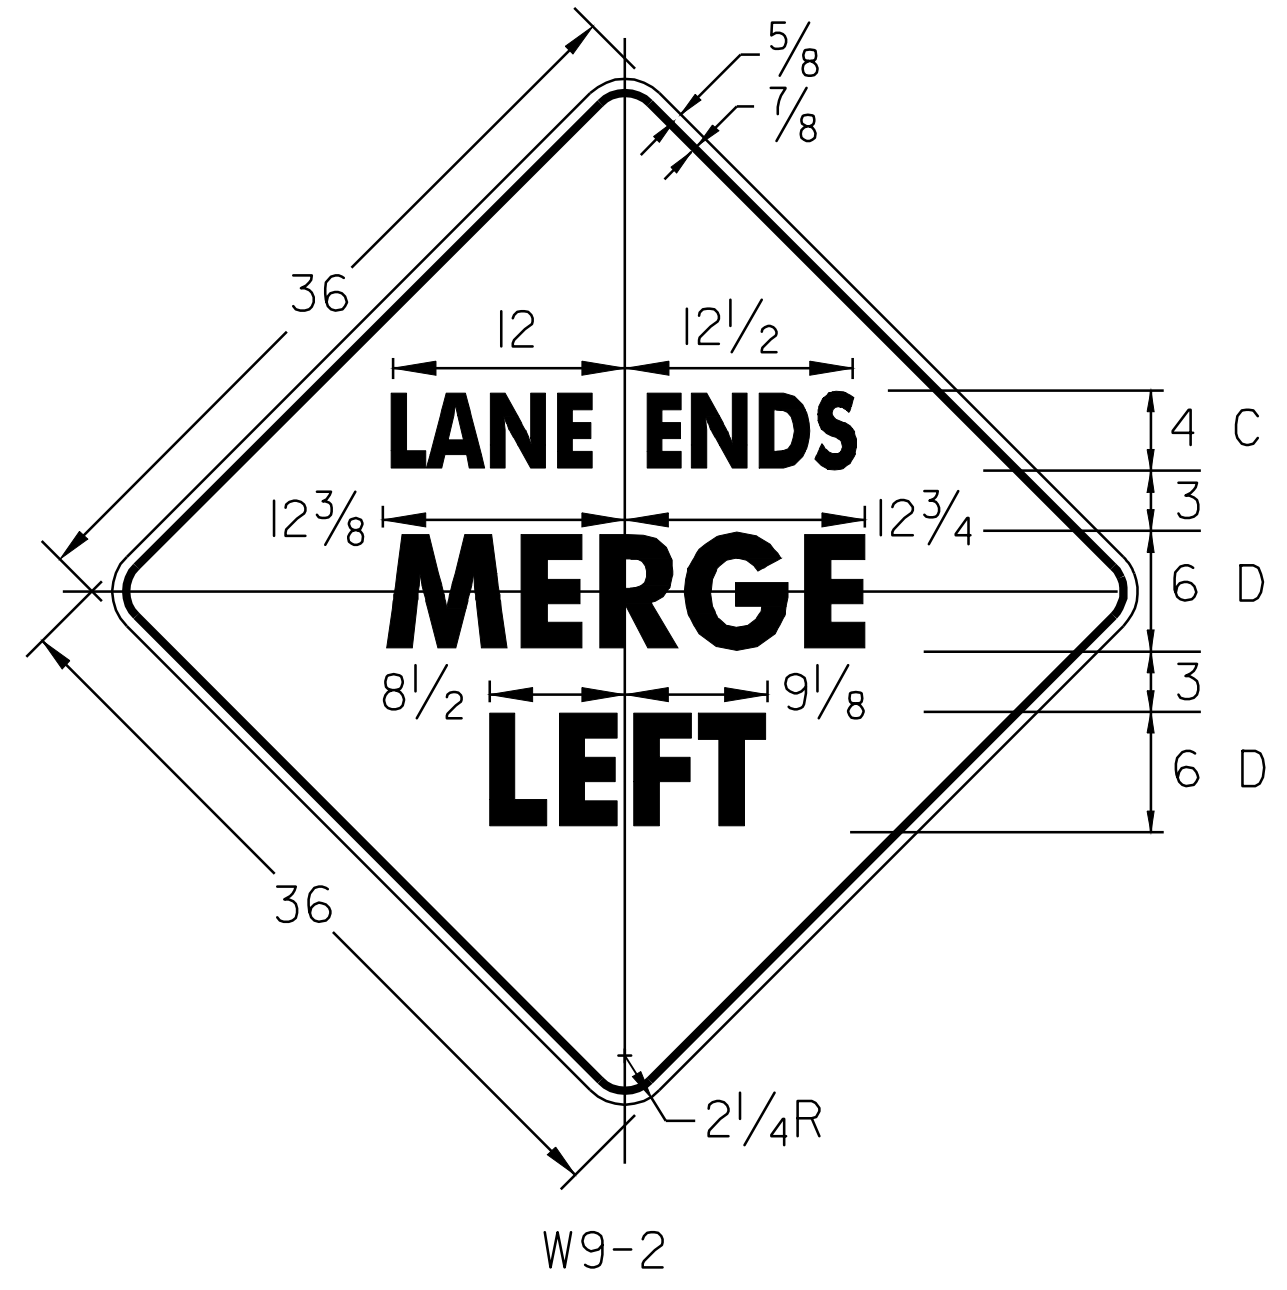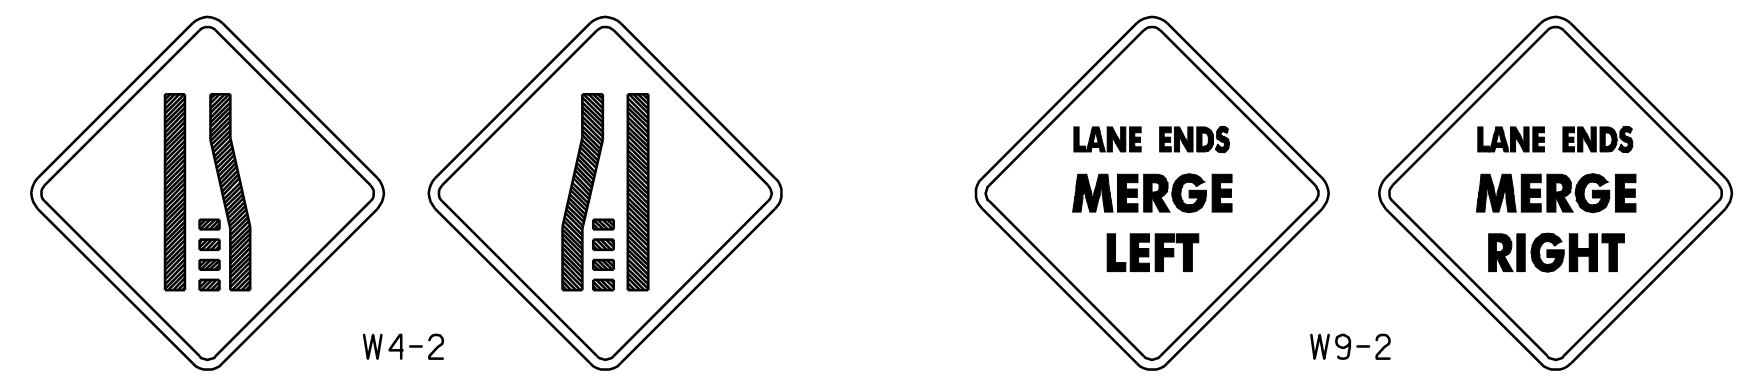

MATERIALS & COLORS:
PER VAOT STANDARD E-154

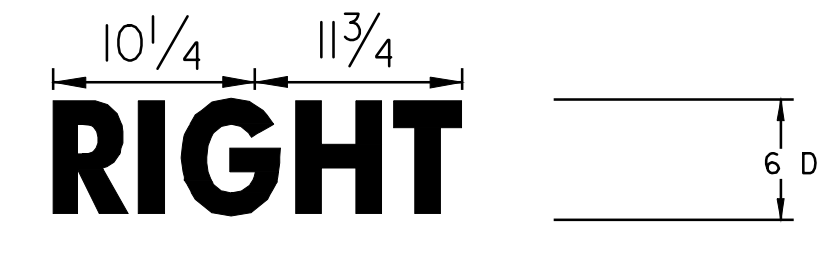

CONSERVATION SEED MIX

RURAL AREA - SEED MIXTURE

% WT.	lbs./ACRE	NAME	PUR%	GERM%
37.5	22.5	CREeping RED FESCUE	98	85
37.5	22.5	TALL FESCUE	95	90
5.0	3	RED TOP	95	90
15.0	9	BIRDSFOOT TREFOIL	98	85
5.0	3	ANNUAL RYEGRASS	95	85
100.0	60			

SEED MIXTURE:
SHALL NOT HAVE A WEED CONTENT EXCEEDING 0.40% BY WEIGHT AND SHALL BE FREE OF ALL NOXIOUS SEED.

SEED:
TO BE APPLIED PER SEEDING FORMULAS OR AS DIRECTED BY THE ENGINEER.

FERTILIZER:
FORMULA 10-20-10, TO BE USED WITH SEED, APPLIED AT THE RATE OF 500 lbs/ACRE. (HYDRO SEEDERS MAY USE 19-19-19 FORMULA)

AGRICULTURAL LIMESTONE:
TO BE APPLIED AT THE RATE OF 2.0 TONS/ACRE, OR AS DIRECTED BY THE ENGINEER.



HAY MULCH:
TO BE PLACED ON EARTH SLOPES AT THE RATE OF 2.0 TONS/ACRE, OR AS DIRECTED BY THE ENGINEER.

TOPSOIL:
TO BE USED AS INDICATED ON THE PLANS, OR AS DIRECTED BY THE ENGINEER.

LIST OF CONSTRUCTION SIGNS

LEGEND

RWA = ROAD WORK AHEAD
RW500 = ROAD WORK 500 FEET
EW = END WORK
RWN = ROAD WORK NEXT 13 MILES
SRWA = SIDE ROAD WORK AHEAD
SRW500 = SIDE ROAD WORK 500 FEET

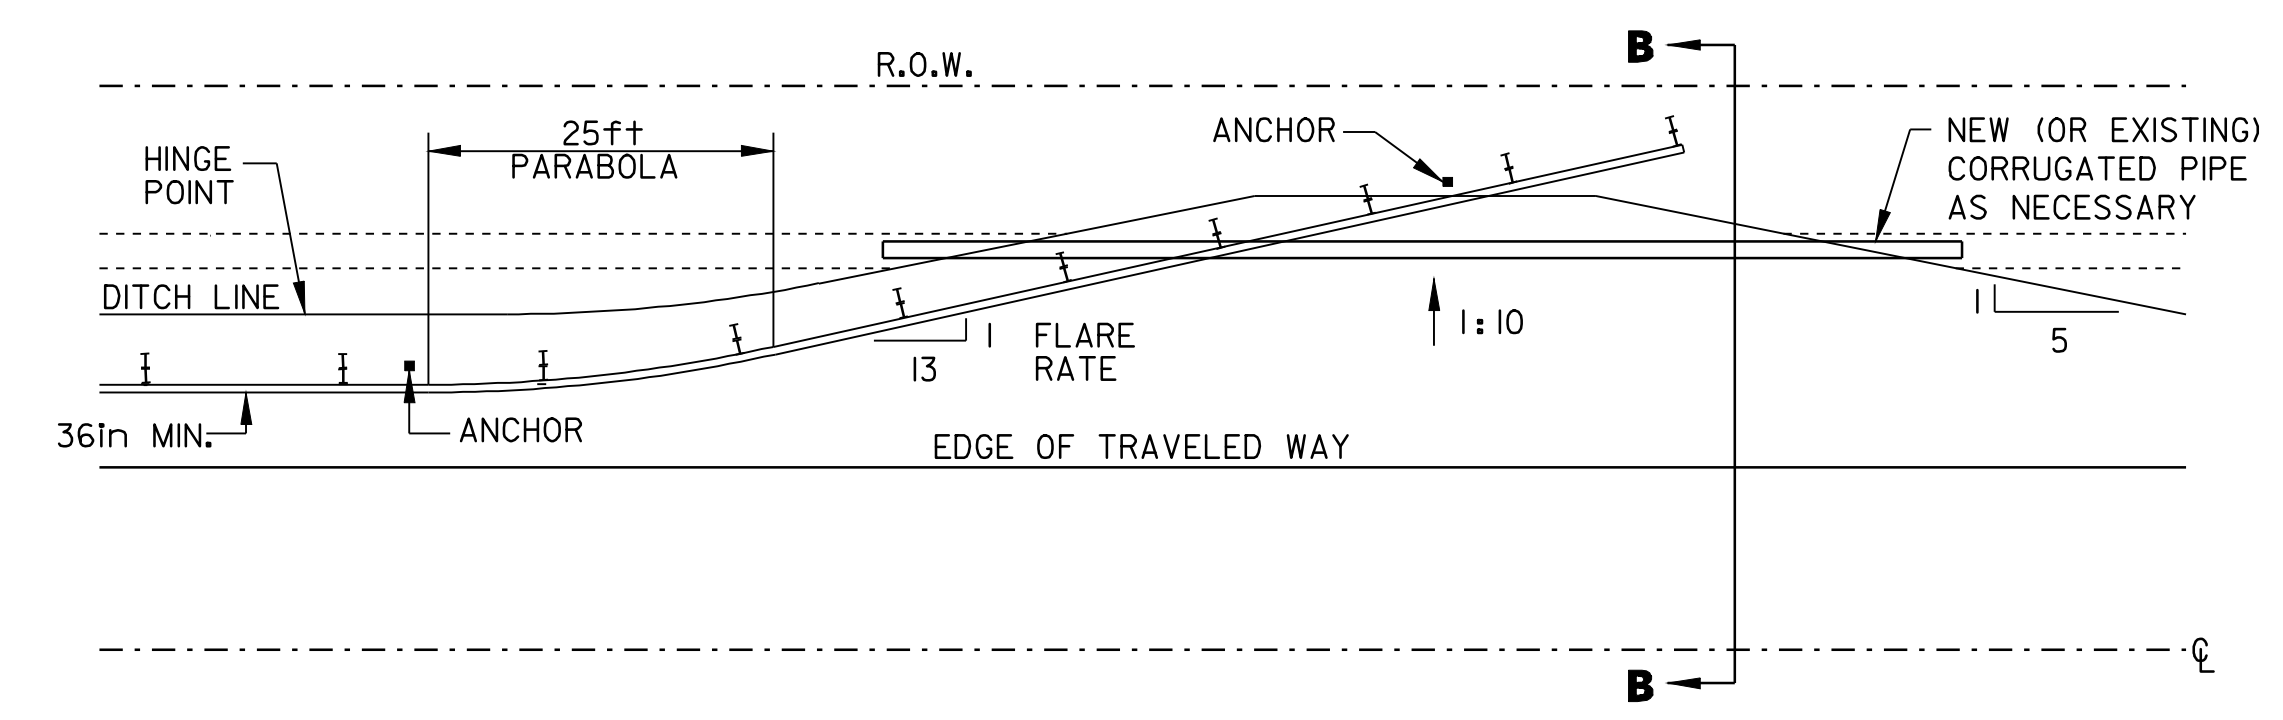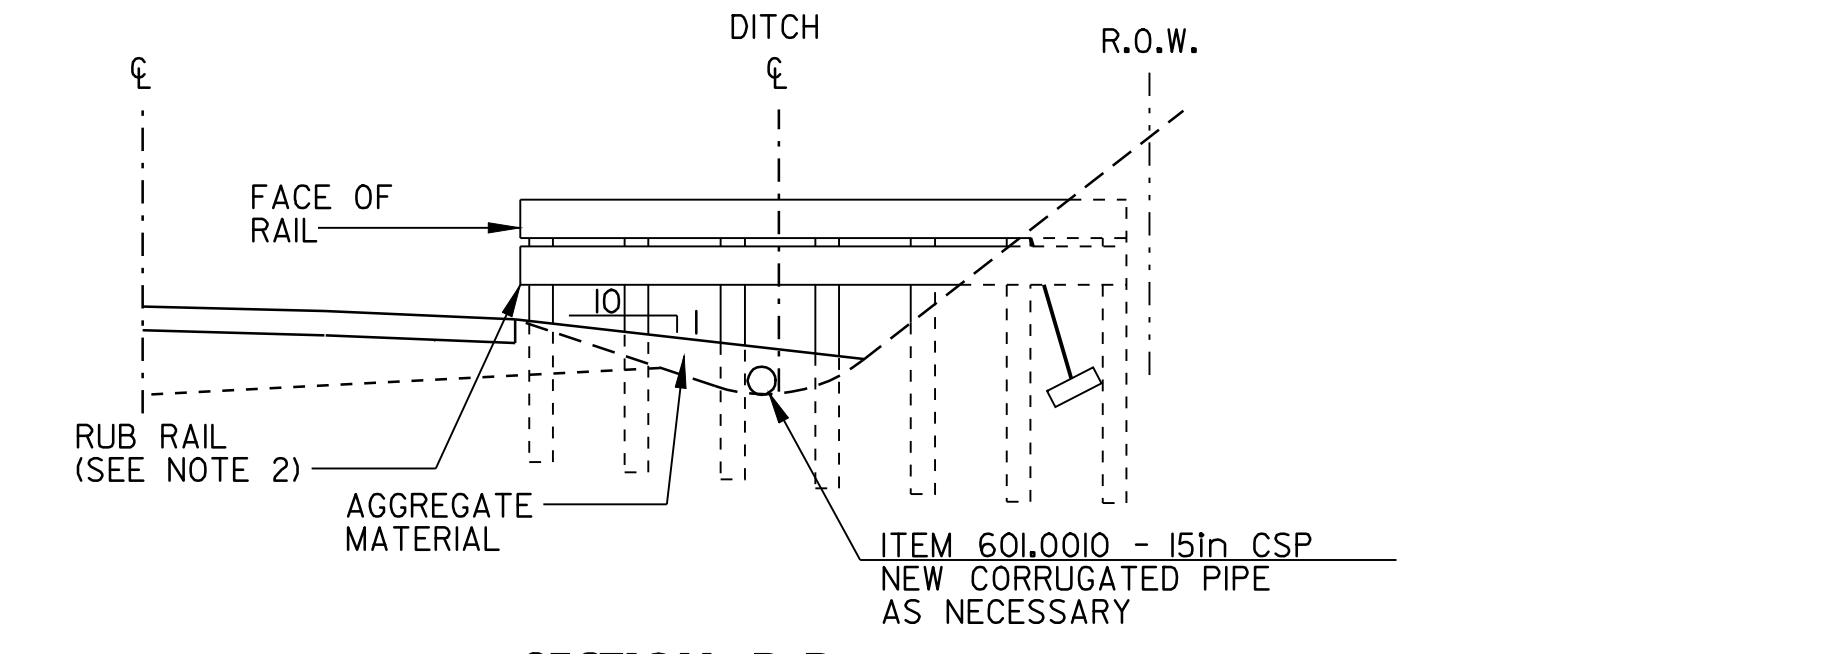

DETAIL FOR BURIED GUARDRAIL ENDS INTO BACKSLOPES

NOT TO SCALE

MAIDSTONE STA 305+20 RT
STA 344+34 RT
STA 400+37 RT

BRUNSWICK STA 25+77 LT
STA 236+51 LT

- NOTES:**
1. PRIMARY RAIL SHALL REMAIN AT A CONSTANT HEIGHT (LEVEL) RELATIVE TO THE HEIGHT OF RAIL AT THE EDGE OF SHOULDER.
 2. ADDITION OF RUB RAIL IS REQUIRED WHEN OPENING BENEATH PRIMARY RAIL EXCEEDS 18in. RUB RAIL EXTENDS FROM THE EDGE OF SHOULDER TO THE BACK SLOPE.

CONSTRUCTION APPROACH SIGNING, CONSERVATION SEED MIX, and BURIED END TERMINAL SHEET

DESIGNED BY	BCE/PJM	DATE	8-06
DRAWN BY	C.E.A., INC.	DATE	8-06
DESIGN FILE NO.	06c042.dgn		
PRF FILE	06c042cas.1	DATE PLOTTED	24-AUG-2009 09
PROJ. NAME	MAIDSTONE - BLOOMFIELD		
PROJ. NO.	STP 2609(1)S		
SHEET	40	OF	40 SHEETS