

INDEX OF SHEETS


VAOT STANDARD

C-10	2/11/2008
D-3	6/1/1994
E-100	1/2/2004
E-101	5/30/2003
E-102	6/30/2003
E-102A	5/1/2004
E-108	6/8/2009
E-108A	6/8/2009
E-III	3/11/1997
E-121	8/8/1995
E-123	3/16/2004
E-136B	8/8/1995
E-138	5/30/2003
E-141	9/20/1995
E-143	6/15/2004
E-144	3/29/1999
E-163	5/20/1999
E-164	6/8/2009
E-193	8/18/1995
G-1	1/3/2000
G-1d	1/3/2000
G-19	11/15/2002
J-3	8/7/1995


INDEX OF SHEETS

SHT	
1	TITLE SHEET
2	INDEX OF SHEETS/TIE SHEET
3	GENERAL NOTES
4	PROJECT TYPICAL SHEET
5	MISCELLANEOUS DETAILS SHEET
6	BRIDGE DETAIL SHEET
7-9	QUANTITY SHEETS
10	HANDWORK DETAIL SHEET
11-13	ITEM DETAIL SUMMARY SHEETS
14	DITCH CLEANING SHEET
15-70	ROADWAY LAYOUT SHEETS
71-78	TRAFFIC SIGN SUMMARY SHEETS
79-81	SIGN DETAIL SHEETS
82	TEMPORARY TRAFFIC CONTROL PLAN

BRIDGE JOINT ASPHALTIC PLUG (STRUCTURES DETAIL SD-516.10)

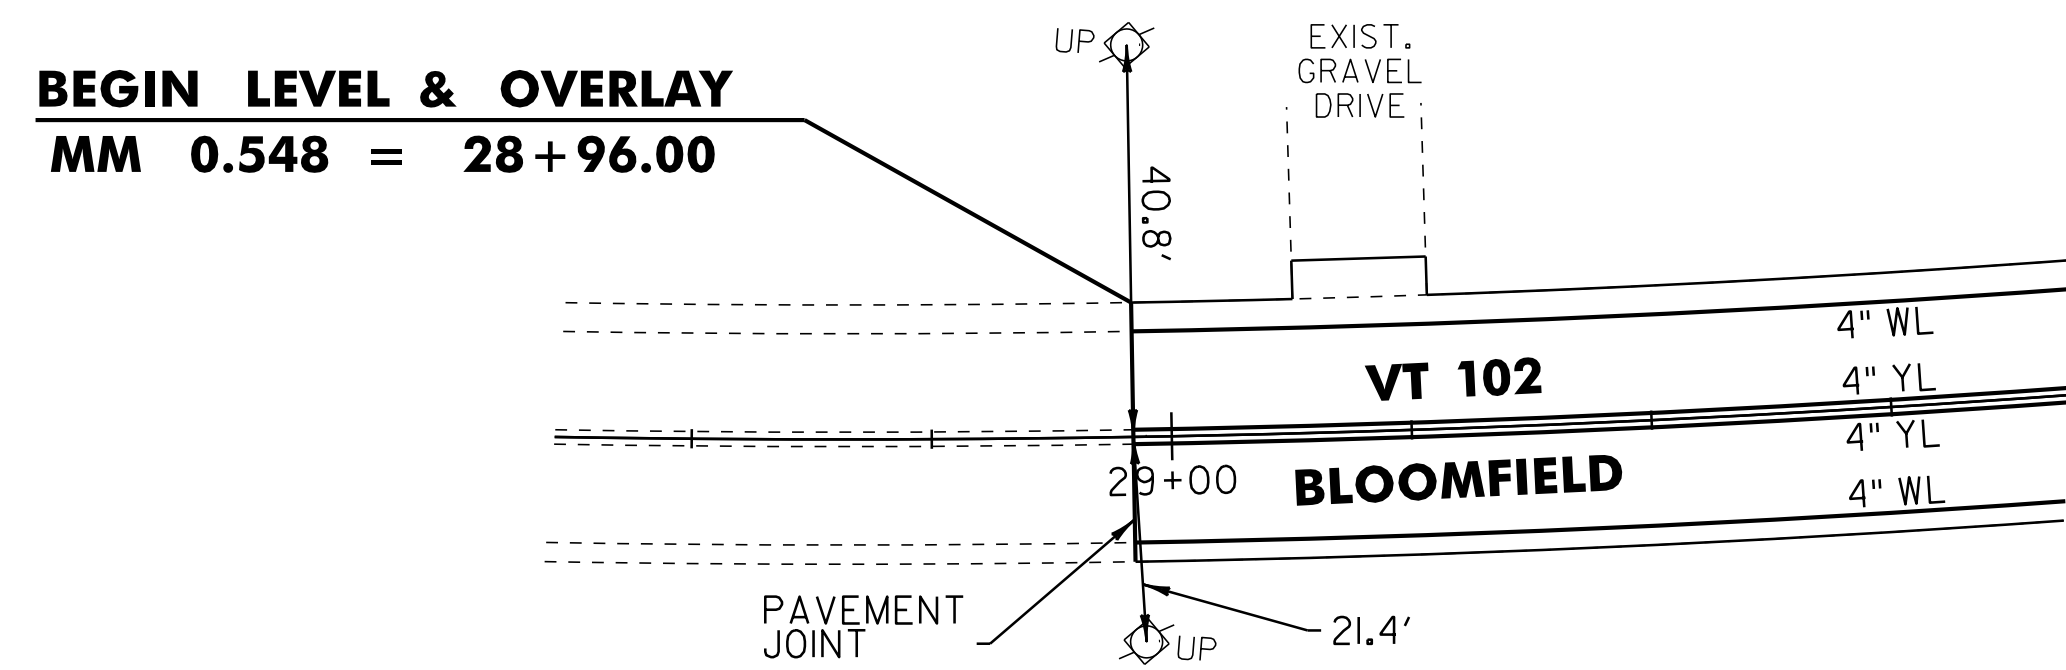

**VT ROUTE 102
BEGIN STP 2610(1) PROJECT TIE**

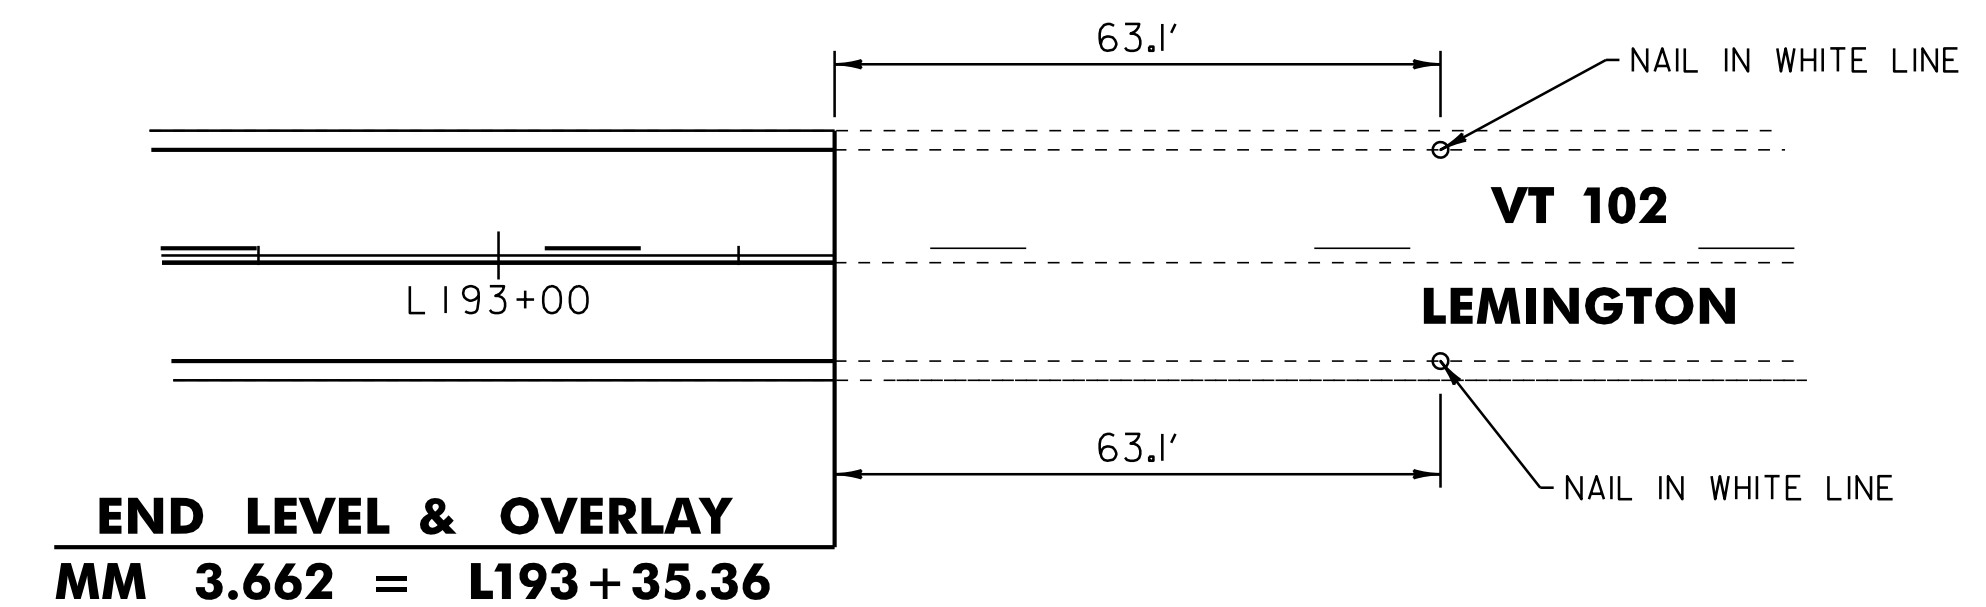

**VT ROUTE 102
END STP 2610(1) PROJECT TIE**

NOT TO SCALE

INDEX OF SHEETS/TIE SHEET

PROJECT NAME:	BLOOMFIELD-LEMINGTON
PROJECT NUMBER:	STP 2610(1)
FILE NAME:	/pave/07cl84/pcl84
PROJECT LEADER:	PTS
DESIGNED BY:	NLL
IPARM FILE NAME:	06C052.2
PLOT DATE:	19-JUN-2013 16:58
DRAWN BY:	SNG
CHECKED BY:	PTS
SHEET	2 OF 82