


646.602 TEMPORARY 4" WHITE LINE, PAINT
 646.402 DURABLE 4" WHITE LINE, THERMOPLASTIC OR
 646.403 DURABLE 4" WHITE LINE, EPOXY PAINT OR
 646.404 DURABLE 4" WHITE LINE, POLYUREA,
 28+96 TO 30+50 SOLID LT & RT

646.612 TEMPORARY 4" YELLOW LINE, PAINT
 646.412 DURABLE 4" YELLOW LINE, THERMOPLASTIC OR
 646.413 DURABLE 4" YELLOW LINE, EPOXY PAINT OR
 646.414 DURABLE 4" YELLOW LINE, POLYUREA,
 28+96 TO 30+50 SOLID LT & RT

675.50 REMOVING SIGNS
 AS SHOWN - 13

675.60 ERECTING SALVAGED SIGNS
 AS SHOWN - 3

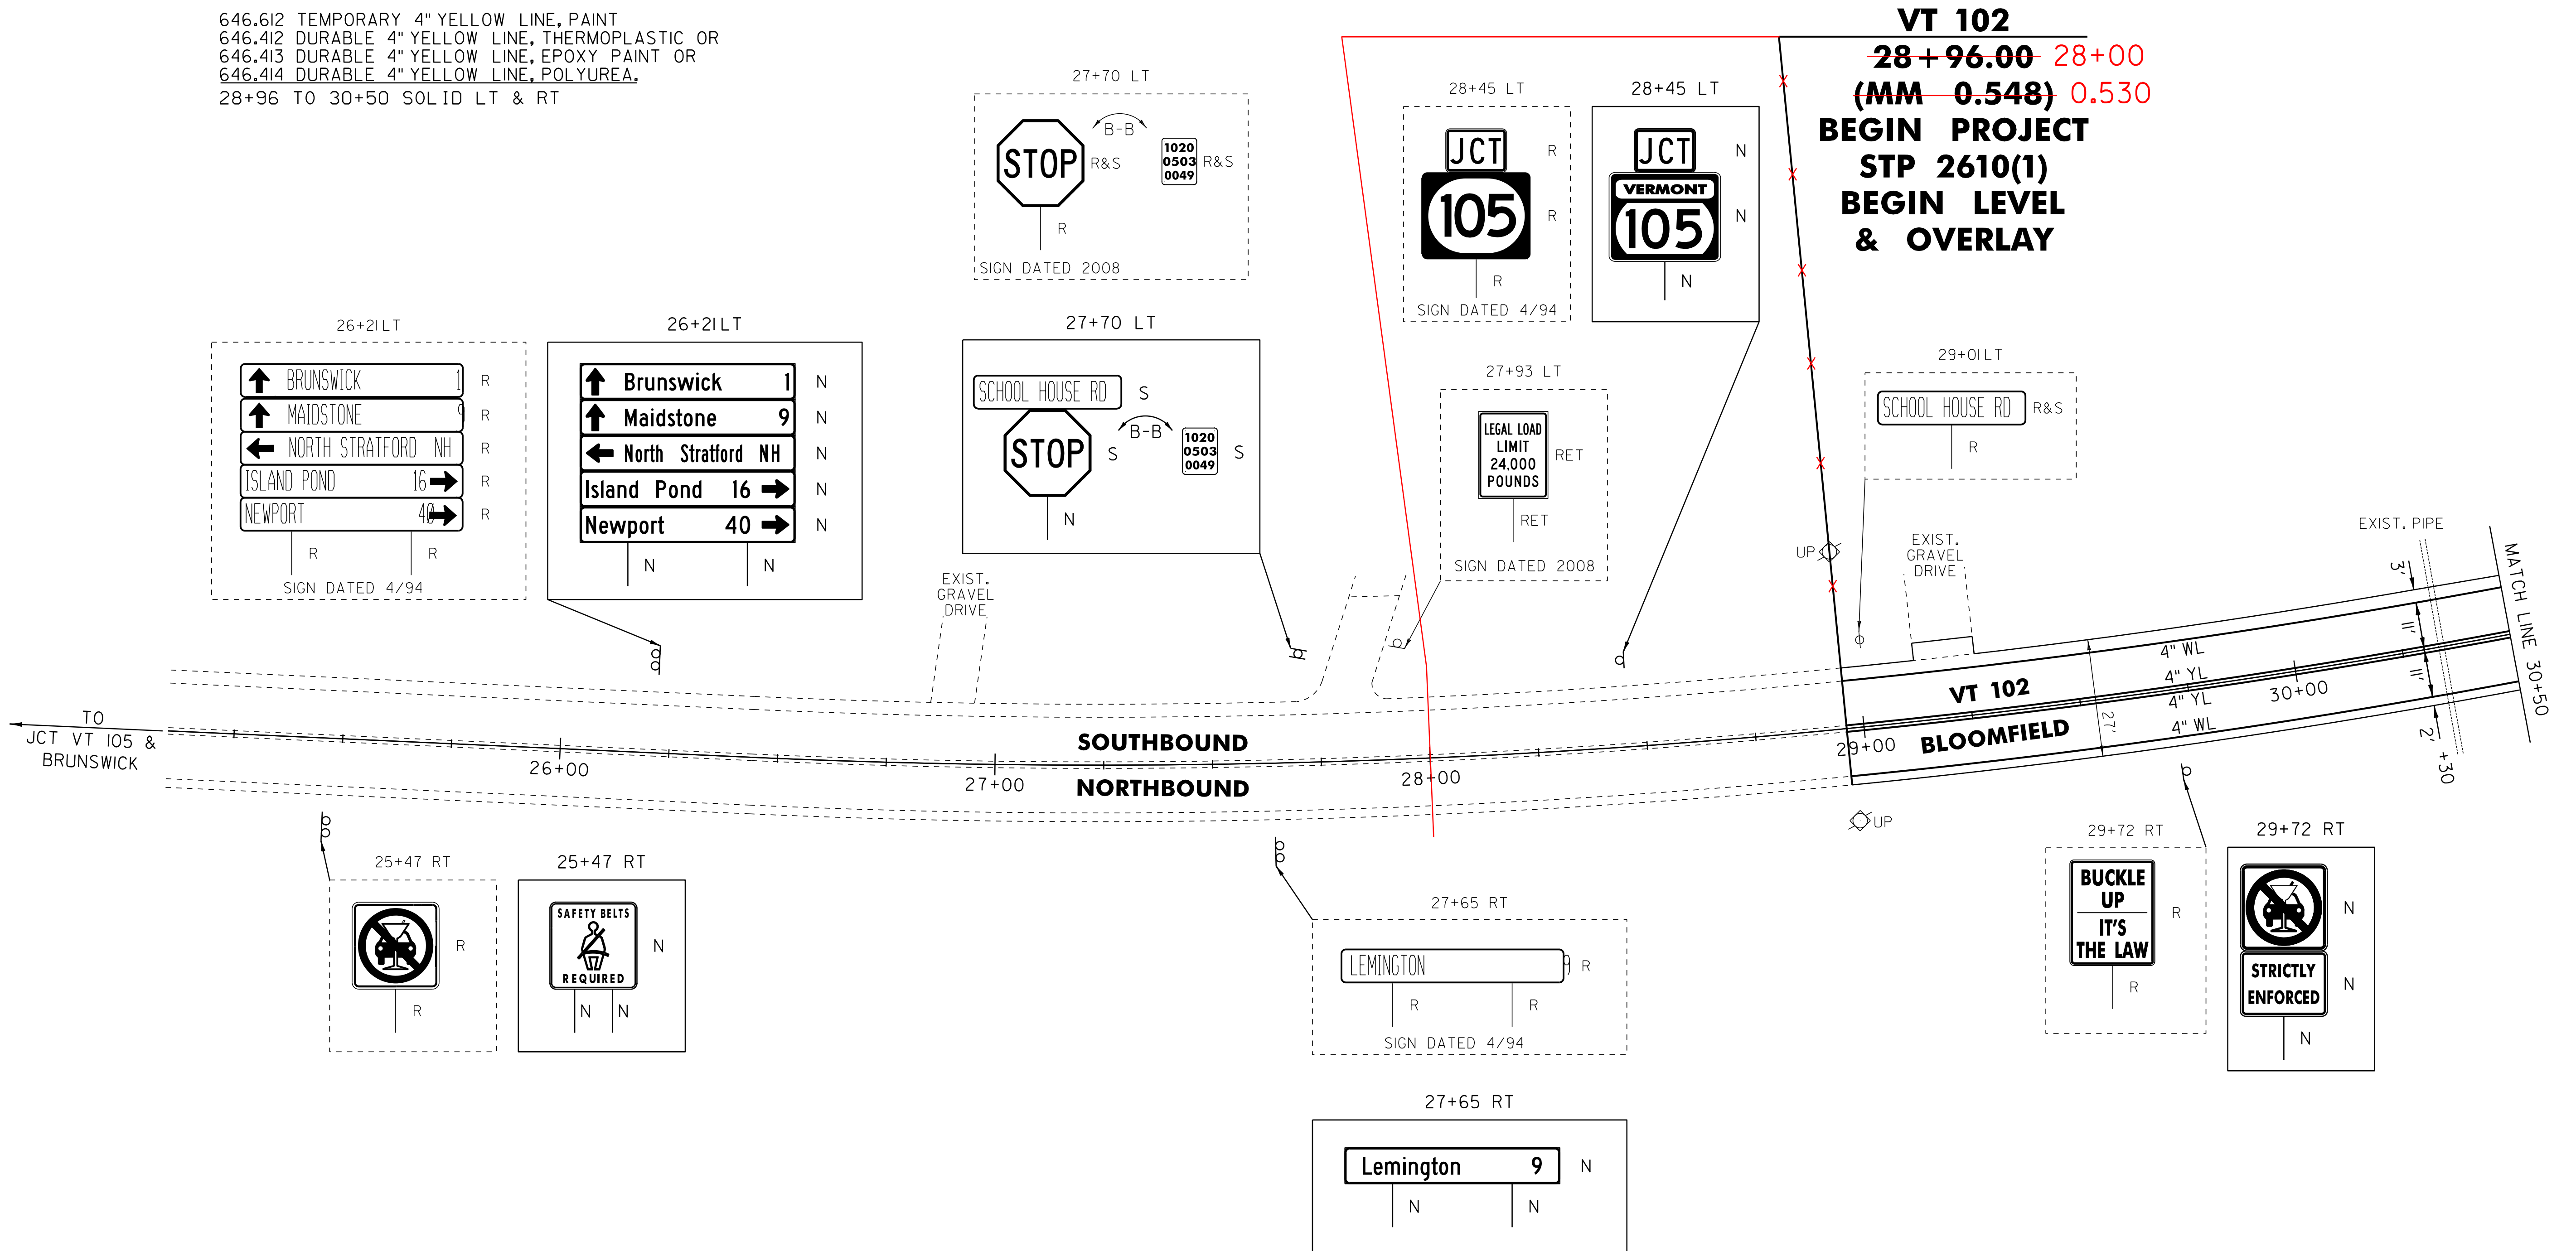

VT 102
~~28+96.00~~ 28+00
 (MM 0.548) 0.530
BEGIN PROJECT
STP 2610(1)
BEGIN LEVEL
& OVERLAY

- LEGEND**
- R = REMOVE EXISTING
 - S = SALVAGE
 - R&S = REMOVE AND SALVAGE
 - N = NEW
 - RET = RETAIN
 - B-B = BACK TO BACK
 - = EXISTING GUARDRAIL
 - = PROPOSED GUARDRAIL
 - YL = YELLOW LINE
 - WL = WHITE LINE
 - = DELINEATOR

NOT TO SCALE

ROADWAY LAYOUT 1

PROJECT NAME: BLOOMFIELD-LEMINGTON
 PROJECT NUMBER: STP 2610(1)

FILE NAME: /pave/06c052/pc052 PLOT DATE: 19-JUN-2013 16:59
 PROJECT LEADER: PTS DRAWN BY: SNG
 DESIGNED BY: NLL CHECKED BY: PTS
 IPARM FILE NAME: 06C052_15 SHEET 15 OF 82