

646.602 TEMPORARY 4" WHITE LINE, PAINT
 646.402 DURABLE 4" WHITE LINE, THERMOPLASTIC OR
 646.403 DURABLE 4" WHITE LINE, EPOXY PAINT OR
 646.404 DURABLE 4" WHITE LINE, POLYUREA,
 51+50 TO 61+50 SOLID LT & RT

646.612 TEMPORARY 4" YELLOW LINE, PAINT
 646.412 DURABLE 4" YELLOW LINE, THERMOPLASTIC OR
 646.413 DURABLE 4" YELLOW LINE, EPOXY PAINT OR
 646.414 DURABLE 4" YELLOW LINE, POLYUREA,
 51+50 TO 53+59 DASHED CL
 53+59 TO 61+50 DASHED LT, SOLID RT



621.50 MANUFACTURED
 TERMINAL SECTION, FLARED
 60+23 TO 60+60.5 RT

621.80 REMOVAL AND DISPOSAL OF GUARDRAIL
 60+23 TO 60+60.5 RT

900.620 SPECIAL PROVISION
 (DELINEATOR WITH STEEL POST)
 60+23 RT

675.50 REMOVING SIGNS
 AS SHOWN - 1

675.60 ERECTING SALVAGED SIGNS
 AS SHOWN - 1

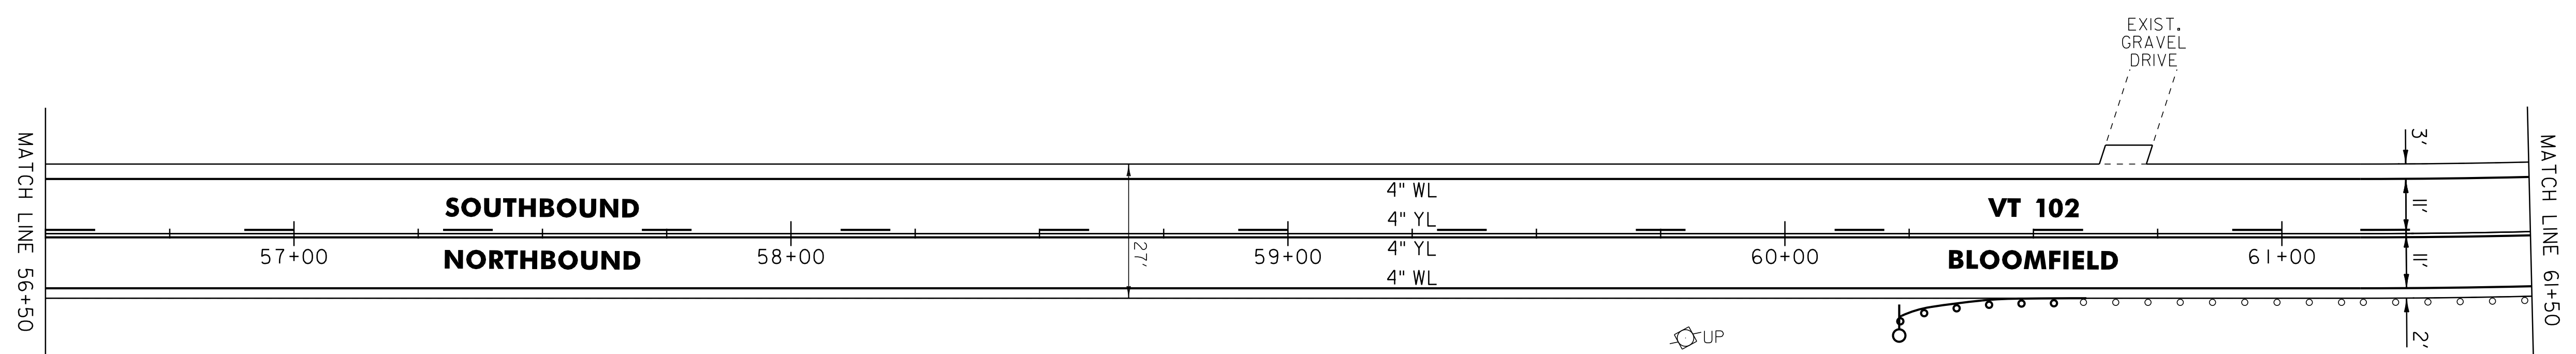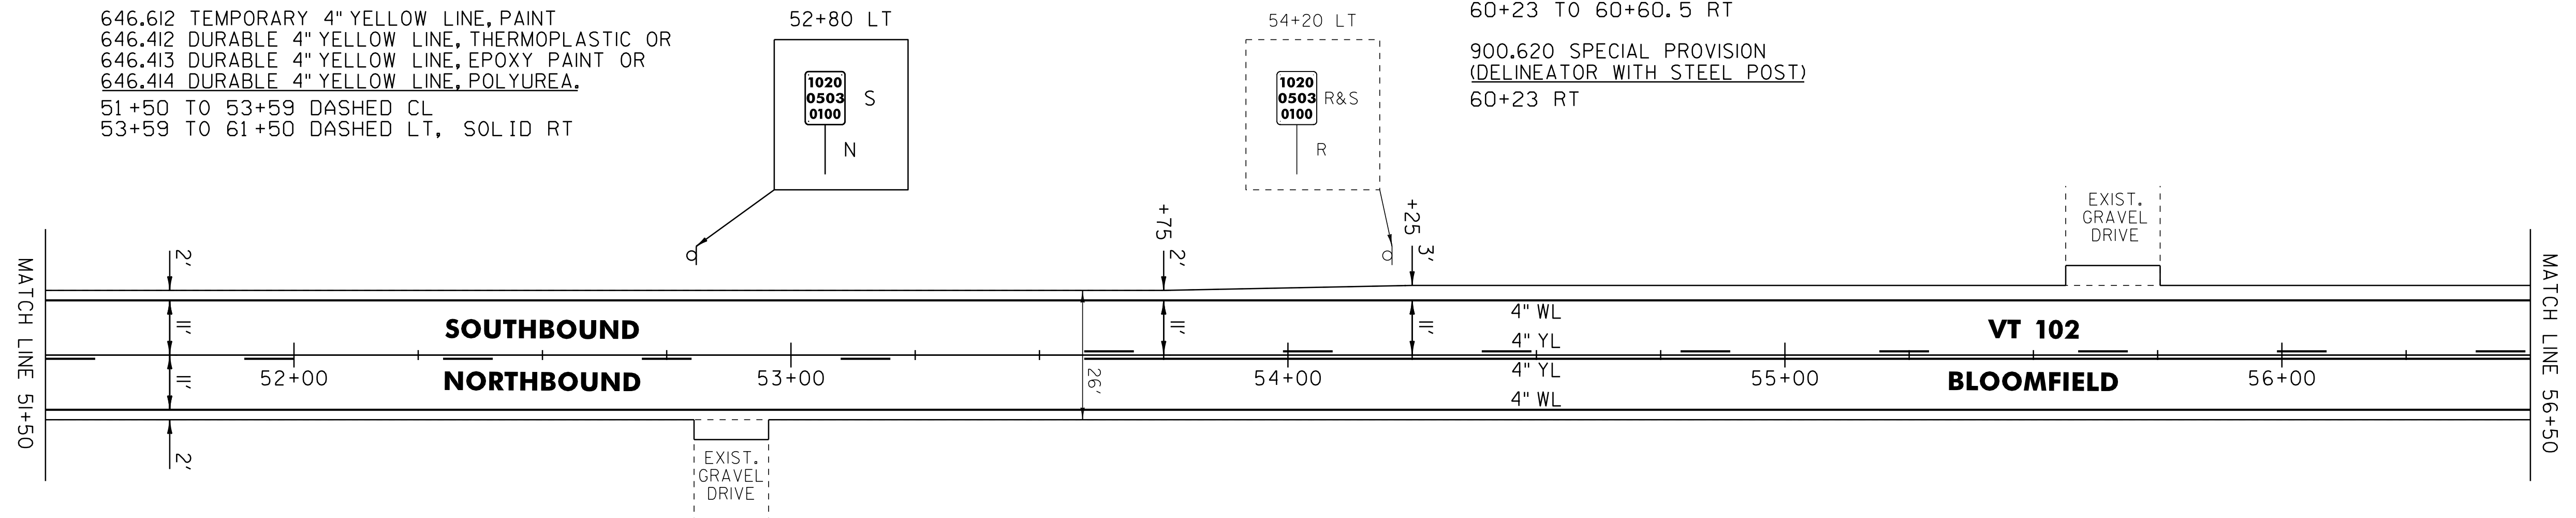

LEGEND

- R = REMOVE EXISTING
- S = SALVAGE
- R&S = REMOVE AND SALVAGE
- N = NEW
- RET = RETAIN
- B-B = BACK TO BACK
- = EXISTING GUARDRAIL
- = PROPOSED GUARDRAIL
- YL = YELLOW LINE
- WL = WHITE LINE
- = DELINEATOR

ROADWAY LAYOUT 4

PROJECT NAME: BLOOMFIELD-LEMINGTON

PROJECT NUMBER: STP 2610(I)

FILE NAME: /pave/06c052/pc052

PROJECT LEADER: PTS

DESIGNED BY: NLL

IPARM FILE NAME: 06C052.18

PLOT DATE: 19-JUN-2013 16:59

DRAWN BY: SNG

CHECKED BY: PTS

SHEET 18 OF 82

NOT TO SCALE