

646.602 TEMPORARY 4" WHITE LINE, PAINT
 646.402 DURABLE 4" WHITE LINE, THERMOPLASTIC OR
 646.403 DURABLE 4" WHITE LINE, EPOXY PAINT OR
 646.404 DURABLE 4" WHITE LINE, POLYUREA,
 152+00 TO 162+00 SOLID LT & RT

646.612 TEMPORARY 4" YELLOW LINE, PAINT
 646.412 DURABLE 4" YELLOW LINE, THERMOPLASTIC OR
 646.413 DURABLE 4" YELLOW LINE, EPOXY PAINT OR
 646.414 DURABLE 4" YELLOW LINE, POLYUREA,
 152+00 TO 152+60 SOLID LT & RT
 152+60 TO 161+30 DASHED LT, SOLID RT
 161+30 TO 162+00 SOLID LT & RT


621.50 MANUFACTURED
 TERMINAL SECTION, FLARED
 154+78 TO 155+15.5 RT
 157+76 TO 158+13.5 LT
 158+47 TO 158+84.5 RT

621.80 REMOVAL AND DISPOSAL OF GUARDRAIL
 154+78 TO 155+15.5 RT
 157+76 TO 158+13.5 LT
 158+47 TO 158+84.5 RT

900.620 SPECIAL PROVISION
 (DELINEATOR WITH STEEL POST)
 154+78 RT
 157+76 LT
 157+95 RT
 158+47 RT

675.50 REMOVING SIGNS
 AS SHOWN - 1

675.60 ERECTING SALVAGED SIGNS
 AS SHOWN - 1

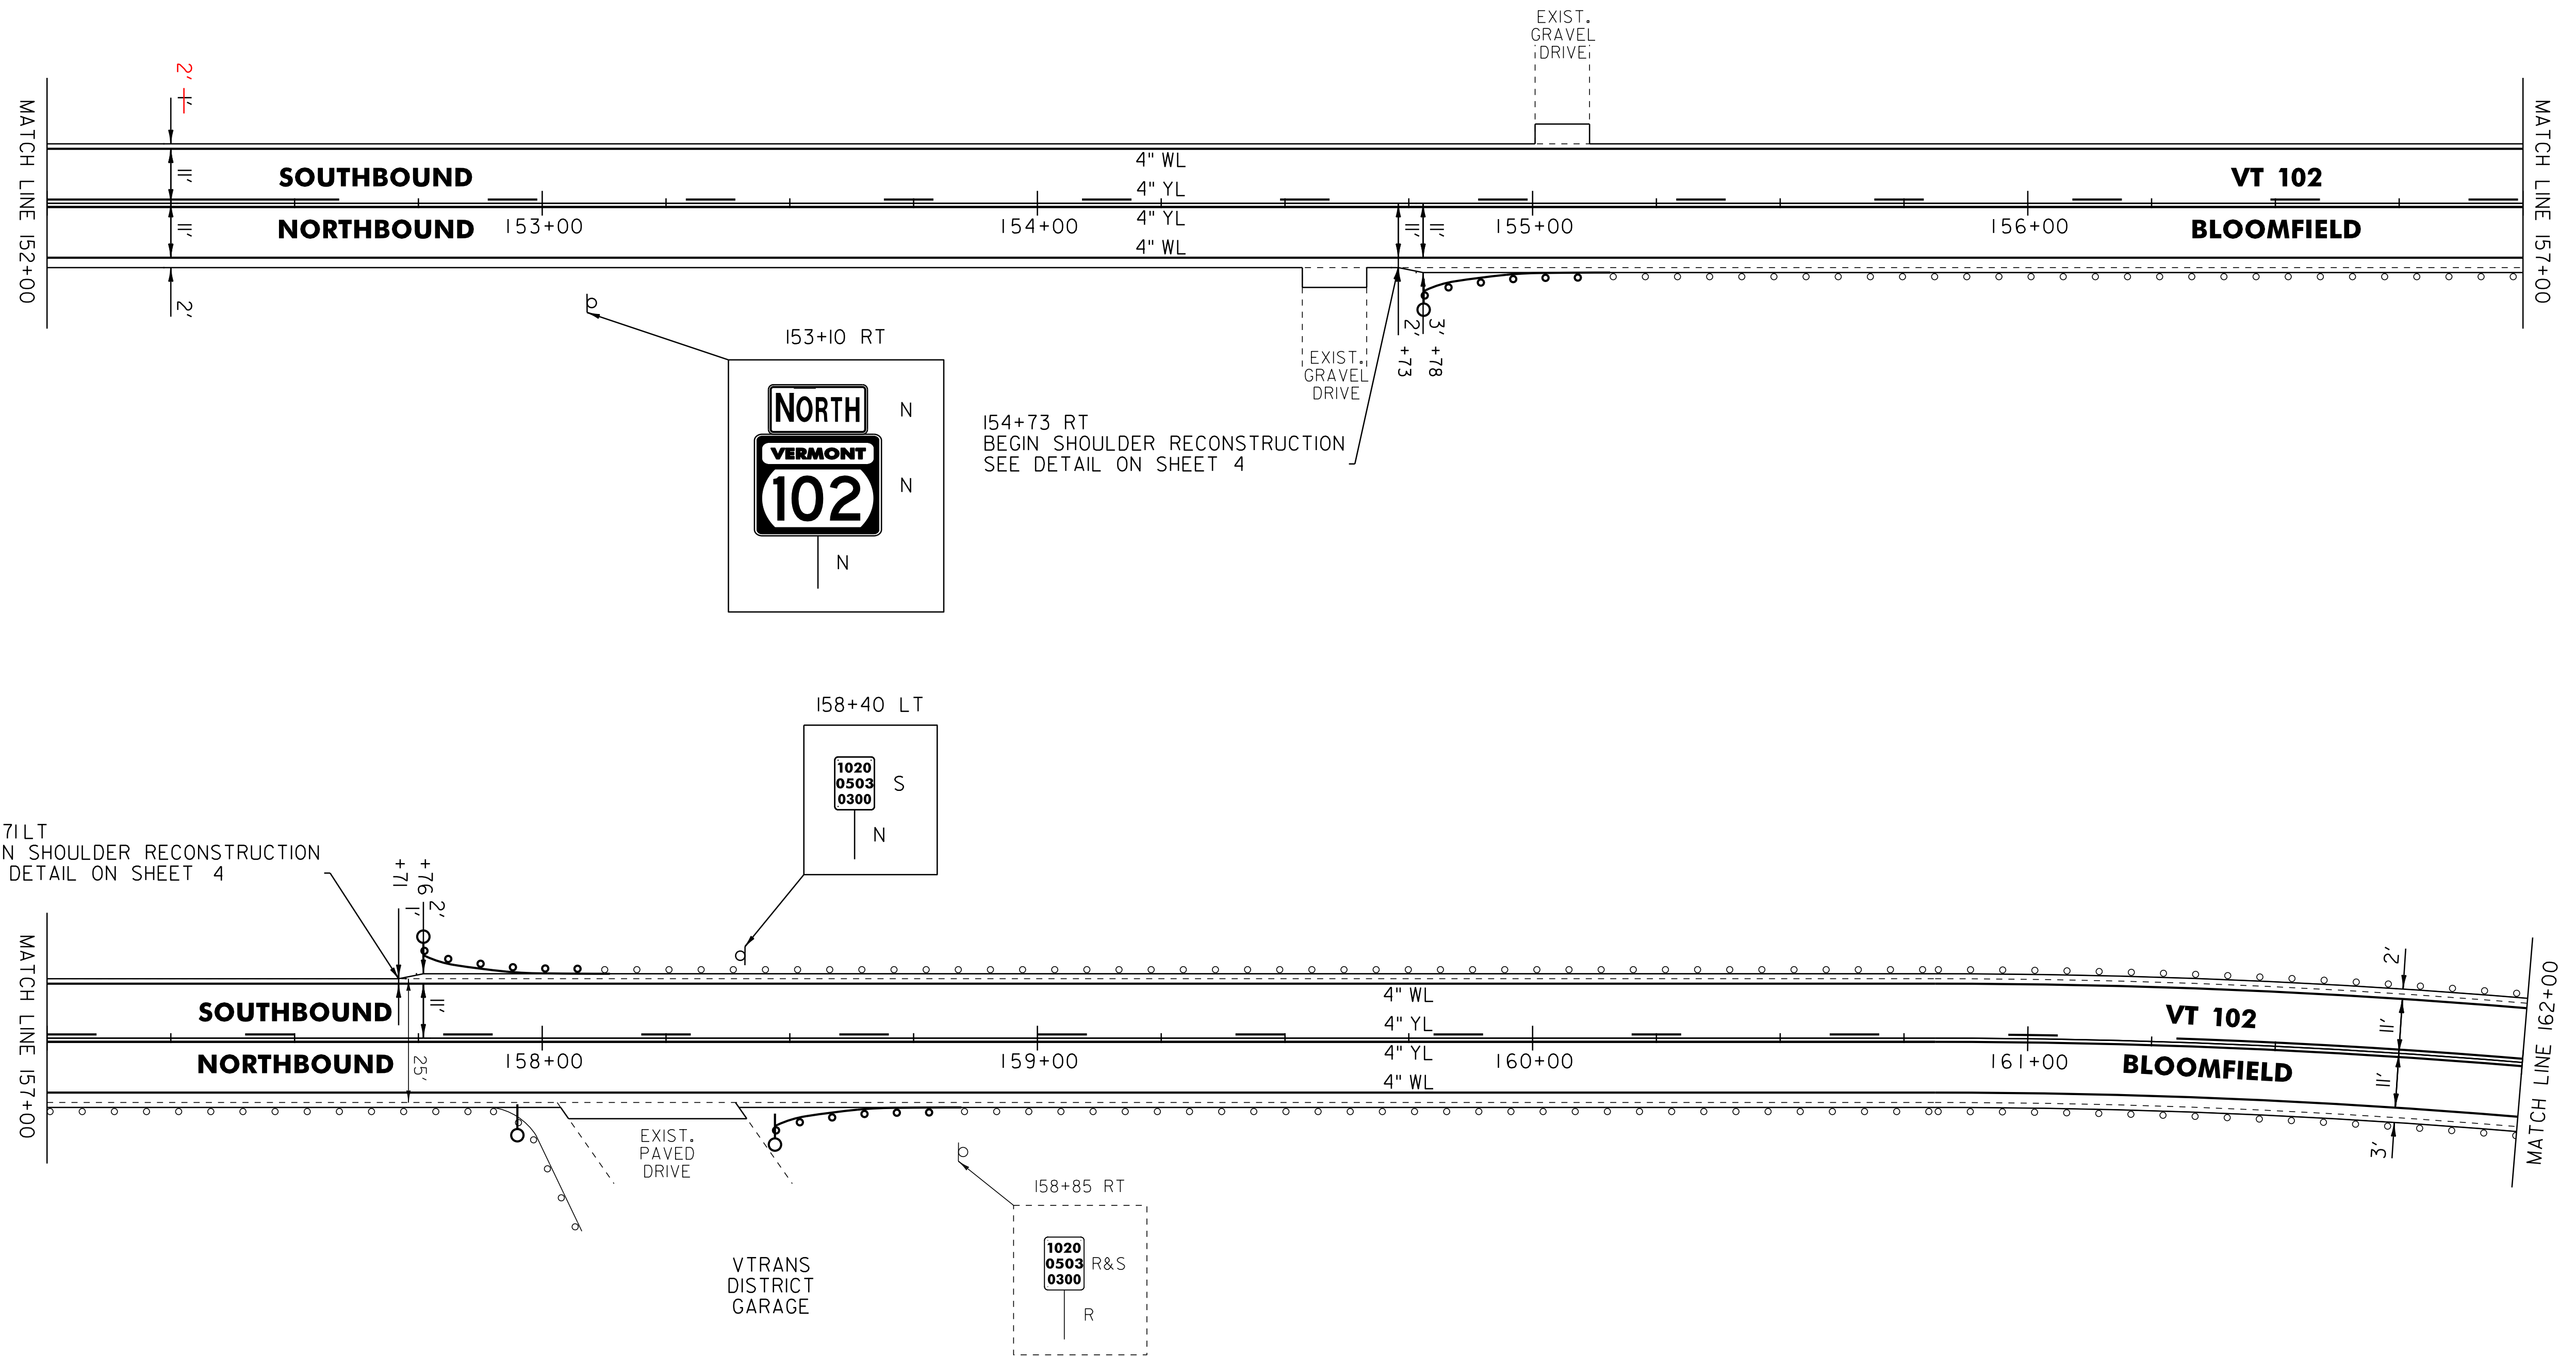

157+71 LT
 BEGIN SHOULDER RECONSTRUCTION
 SEE DETAIL ON SHEET 4

154+73 RT
 BEGIN SHOULDER RECONSTRUCTION
 SEE DETAIL ON SHEET 4

NOT TO SCALE

- LEGEND**
- R = REMOVE EXISTING
 - S = SALVAGE
 - R&S = REMOVE AND SALVAGE
 - N = NEW
 - RET = RETAIN
 - B-B = BACK TO BACK
 - = EXISTING GUARDRAIL
 - b— = PROPOSED GUARDRAIL
 - YL = YELLOW LINE
 - WL = WHITE LINE
 - = DELINEATOR

ROADWAY LAYOUT 14

PROJECT NAME: BLOOMFIELD-LEMINGTON
 PROJECT NUMBER: STP 2610(I)

FILE NAME: /pave/06c052/pc052
 PROJECT LEADER: PTS
 DESIGNED BY: NULL
 IPARM FILE NAME: 06C052.28

PLOT DATE: 19-JUN-2013 16:59
 DRAWN BY: SNG
 CHECKED BY: PTS
 SHEET 28 OF 82