


646.602 TEMPORARY 4" WHITE LINE, PAINT
 646.402 DURABLE 4" WHITE LINE, THERMOPLASTIC OR
 646.403 DURABLE 4" WHITE LINE, EPOXY PAINT OR
 646.404 DURABLE 4" WHITE LINE, POLYUREA.
 220+50 TO 231+50 SOLID LT & RT
 646.612 TEMPORARY 4" YELLOW LINE, PAINT
 646.412 DURABLE 4" YELLOW LINE, THERMOPLASTIC OR
 646.413 DURABLE 4" YELLOW LINE, EPOXY PAINT OR
 646.414 DURABLE 4" YELLOW LINE, POLYUREA.
 220+50 TO 226+78 SOLID LT, DASHED RT
 226+78 TO 231+50 DASHED CL

675.50 REMOVING SIGNS
 AS SHOWN - 3
 675.60 ERECTING SALVAGED SIGNS
 AS SHOWN - 1

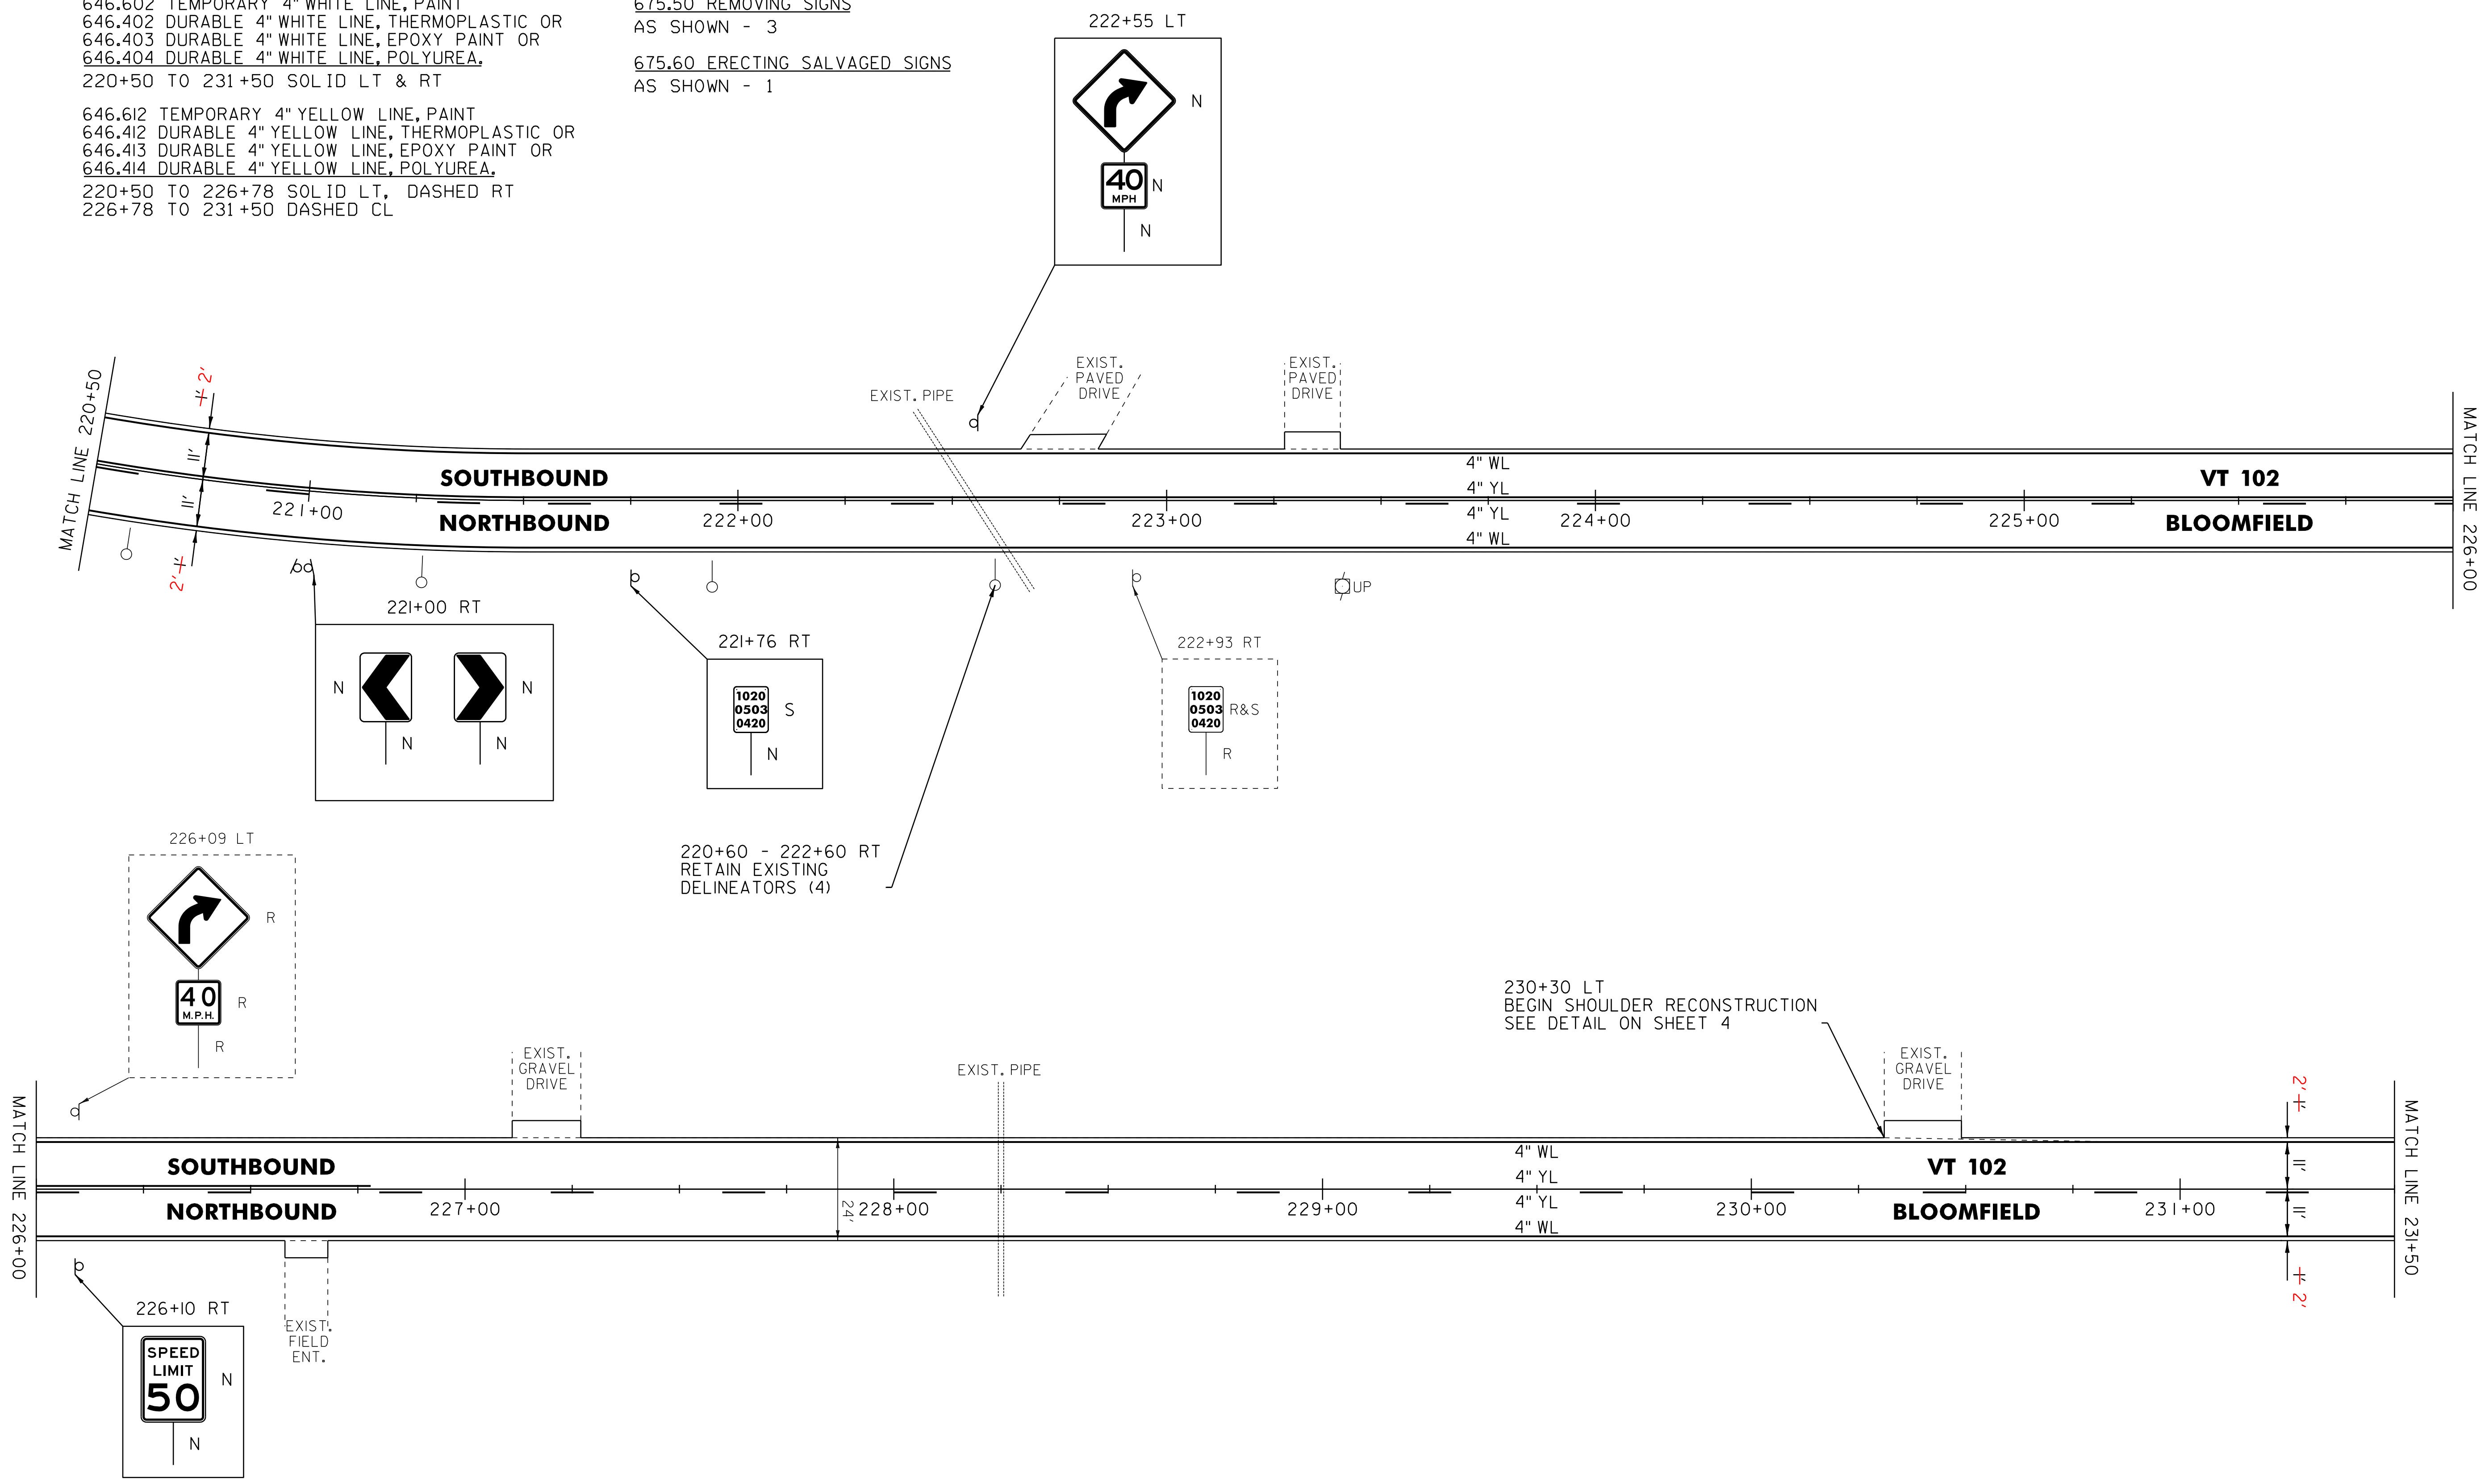

NOT TO SCALE

LEGEND

R	=	REMOVE EXISTING
S	=	SALVAGE
R&S	=	REMOVE AND SALVAGE
N	=	NEW
RET	=	RETAIN
B-B	=	BACK TO BACK
○	=	EXISTING GUARDRAIL
⌋	=	PROPOSED GUARDRAIL
⌋	=	YELLOW LINE
—	=	WHITE LINE
○	=	DELINEATOR

ROADWAY LAYOUT 22

PROJECT NAME: BLOOMFIELD-LEMINGTON	FILE NAME: /pave/06c052/pc052	PLOT DATE: 19-JUN-2013 16:59
PROJECT NUMBER: STP 2610(I)	PROJECT LEADER: PTS	DRAWN BY: SNG
	DESIGNED BY: NLL	CHECKED BY: PTS
	IPARM FILE NAME: 06C052_36	SHEET 36 OF 82