

646.602 TEMPORARY 4" WHITE LINE, PAINT
 646.402 DURABLE 4" WHITE LINE, THERMOPLASTIC OR
 646.403 DURABLE 4" WHITE LINE, EPOXY PAINT OR
 646.404 DURABLE 4" WHITE LINE, POLYUREA,
 317+00 TO 327+50 SOLID LT & RT

646.612 TEMPORARY 4" YELLOW LINE, PAINT
 646.412 DURABLE 4" YELLOW LINE, THERMOPLASTIC OR
 646.413 DURABLE 4" YELLOW LINE, EPOXY PAINT OR
 646.414 DURABLE 4" YELLOW LINE, POLYUREA,
 317+00 TO 319+40 SOLID LT, DASHED RT
 319+40 TO 326+83 DASHED LT, SOLID RT
 326+83 TO 327+50 SOLID LT & RT

621.20 STEEL BEAM GUARDRAIL, GALVANIZED
 317+63.5 TO 317+76 RT
 317+63.5 TO 317+76 LT
 318+44.8 TO 318+57.3 RT
 318+44.8 TO 318+57.3 LT

621.205 STEEL BEAM GUARDRAIL,
 GALVANIZED W/8' POSTS
 324+21 TO 327+50 RT

621.21 H.D. STEEL BEAM
 GUARDRAIL, GALVANIZED
 317+76 TO 318+01 RT
 317+76 TO 318+01 LT
 318+13.5 TO 318+44.8 RT
 318+13.5 TO 318+44.8 LT

621.50 MANUFACTURED
 TERMINAL SECTION, FLARED
 317+26 TO 317+63.5 RT
 317+26 TO 317+63.5 LT
 318+57.3 TO 318+94.8 RT
 323+83.5 TO 324+21 RT


621.51 MANUFACTURED
 TERMINAL SECTION, TANGENT
 318+57.3 TO 319+07.3 LT

621.80 REMOVAL AND DISPOSAL OF GUARDRAIL
 317+76 TO 318+01 LT
 317+76 TO 318+01 RT
 318+13.5 TO 318+50 LT
 318+13.5 TO 318+51 RT
 324+15 TO 327+50 RT

900.620 SPECIAL PROVISION
 (DELINEATOR WITH STEEL POST)

317+26 LT
 317+26 RT
 318+94.8 RT
 319+07.3 LT
 323+83.5 RT

613.11 STONE FILL, TYPE II
 649.31 GEOTEXTILE UNDER STONE FILL
 318+00 RT
 675.50 REMOVING SIGNS
 AS SHOWN - 1

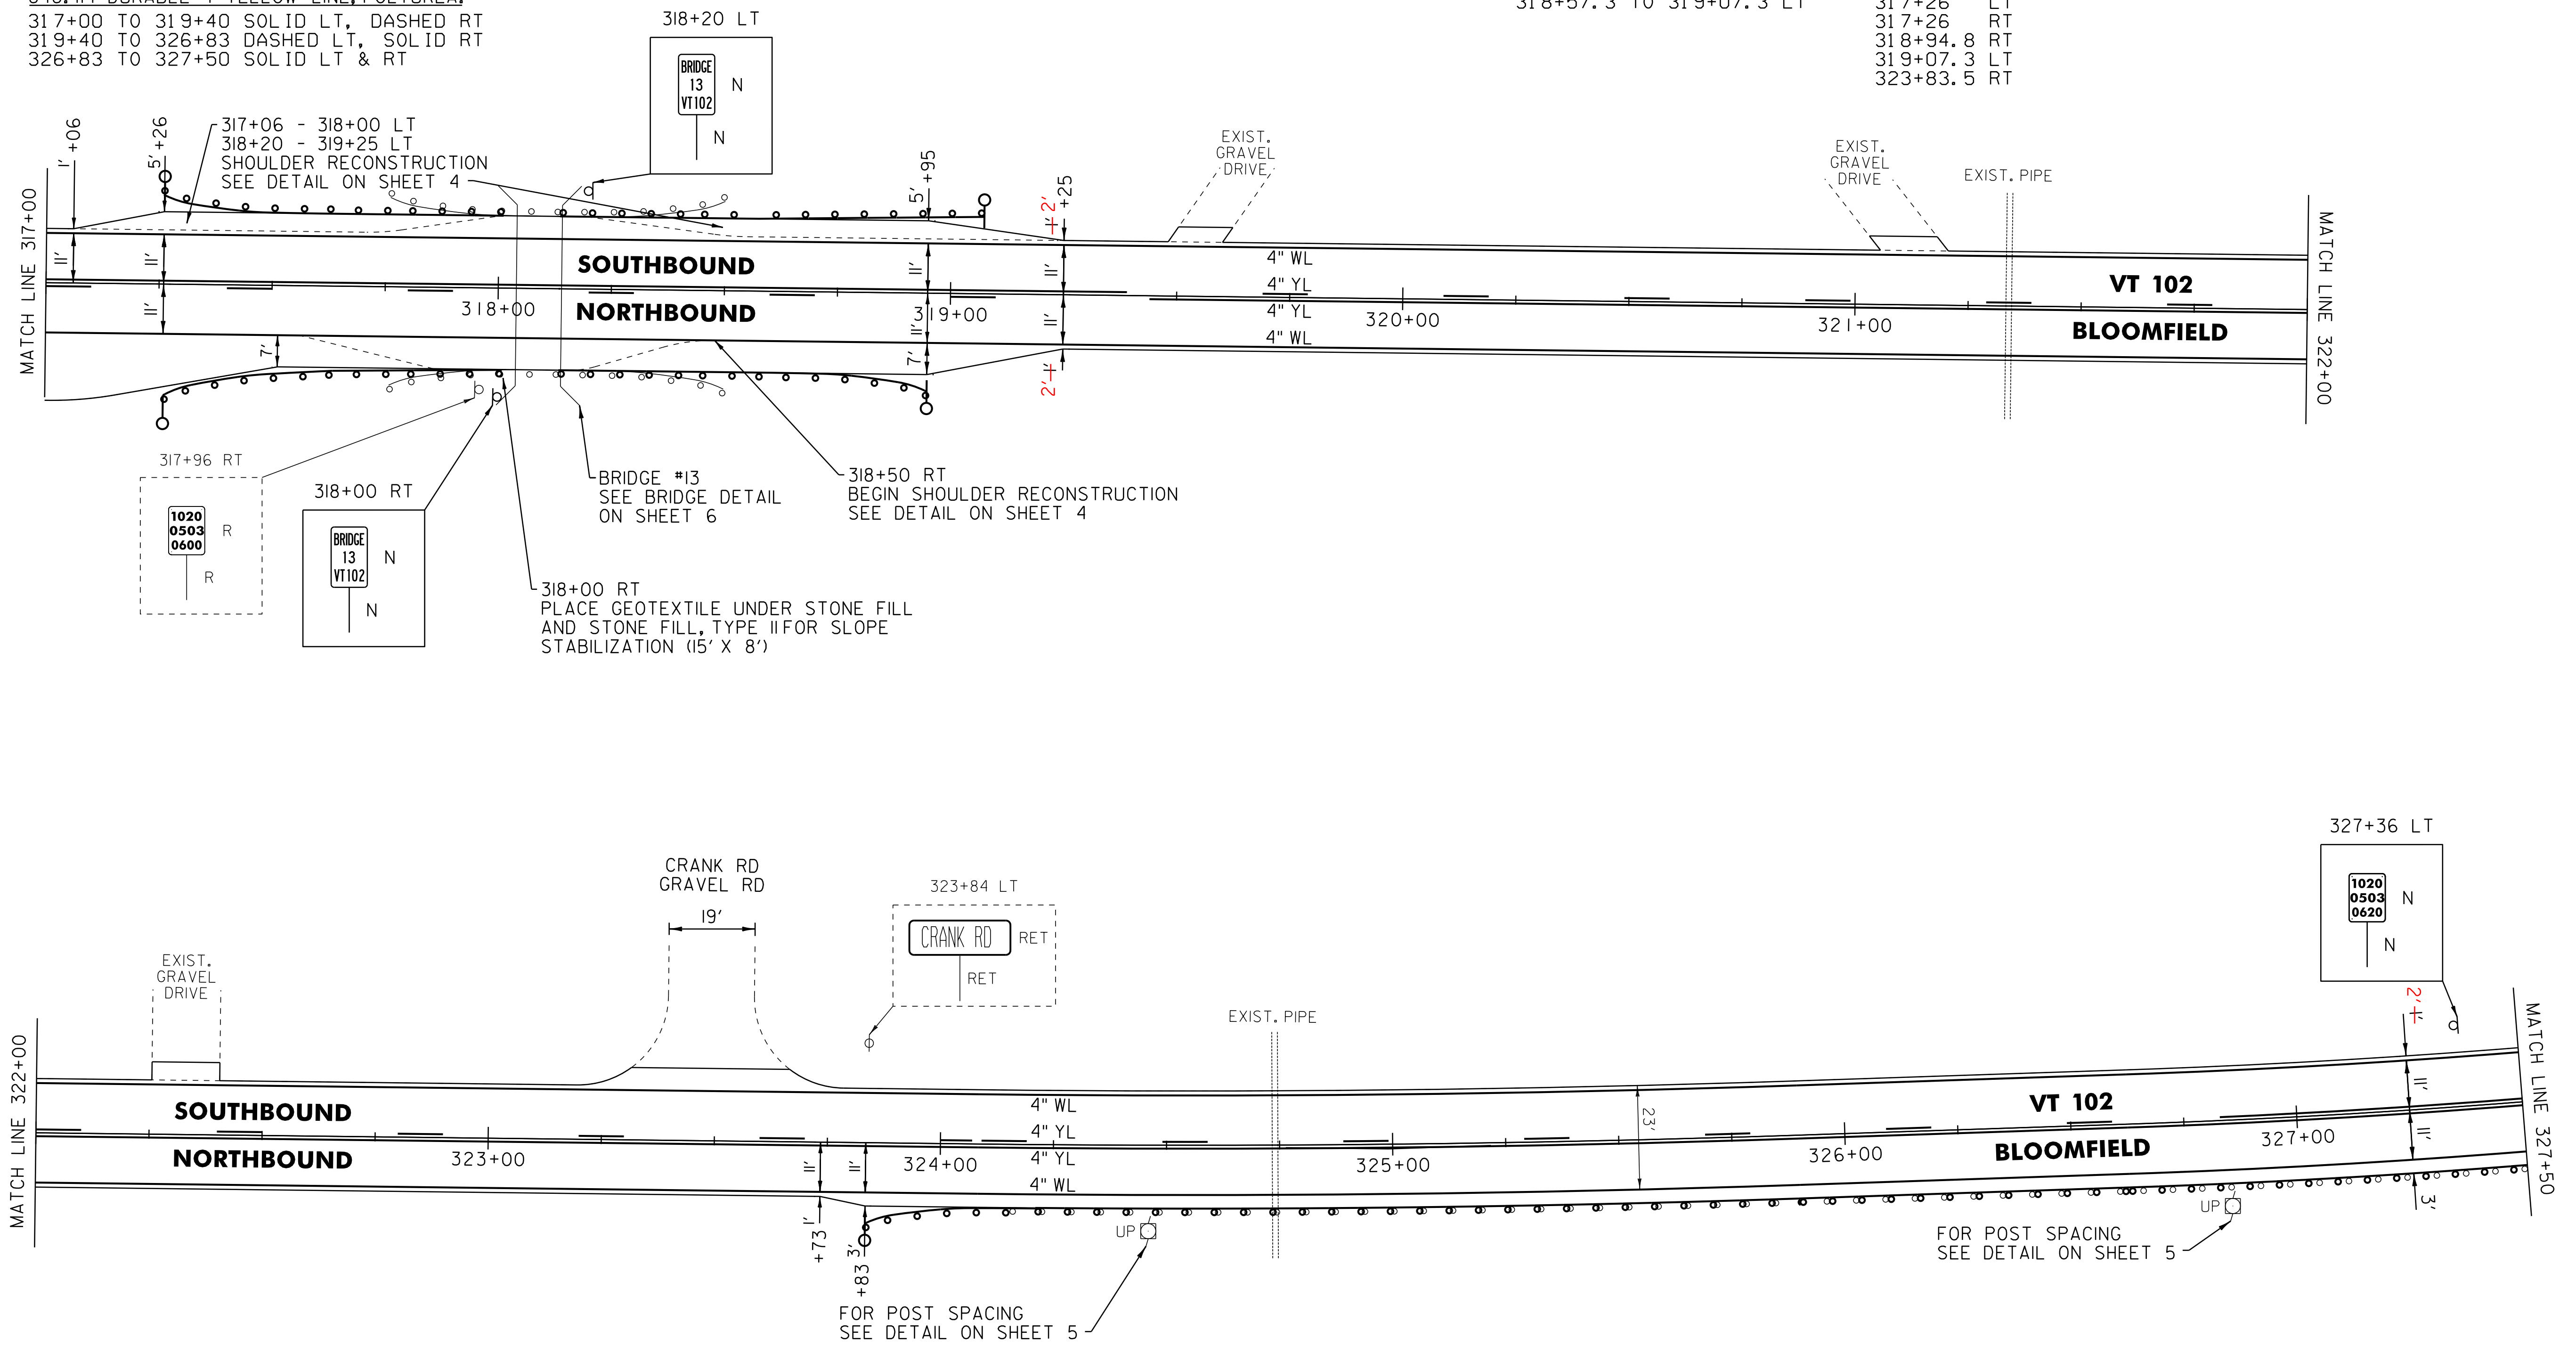

LEGEND

- R = REMOVE EXISTING
- S = SALVAGE
- R&S = REMOVE AND SALVAGE
- N = NEW
- RET = RETAIN
- B-B = BACK TO BACK
- = EXISTING GUARDRAIL
- = PROPOSED GUARDRAIL
- YL = YELLOW LINE
- WL = WHITE LINE
- = DELINEATOR

ROADWAY LAYOUT 31

PROJECT NAME: BLOOMFIELD-LEMINGTON

PROJECT NUMBER: STP 2610(I)

FILE NAME: /pave/06c052/pc052

PROJECT LEADER: PTS

DESIGNED BY: NLL

IPARM FILE NAME: 06C052.45

PLOT DATE: 19-JUN-2013 16:59

DRAWN BY: SNG

CHECKED BY: PTS

SHEET 45 OF 82

NOT TO SCALE