


646.602 TEMPORARY 4" WHITE LINE, PAINT
 646.402 DURABLE 4" WHITE LINE, THERMOPLASTIC OR
 646.403 DURABLE 4" WHITE LINE, EPOXY PAINT OR
 646.404 DURABLE 4" WHITE LINE, POLYUREA,
 338+50 TO 349+50 SOLID LT & RT
 646.612 TEMPORARY 4" YELLOW LINE, PAINT
 646.412 DURABLE 4" YELLOW LINE, THERMOPLASTIC OR
 646.413 DURABLE 4" YELLOW LINE, EPOXY PAINT OR
 646.414 DURABLE 4" YELLOW LINE, POLYUREA,
 338+50 TO 349+50 SOLID LT & RT

621.50 MANUFACTURED
 TERMINAL SECTION, FLARED
 338+50 TO 338+71 RT
 900.620 SPECIAL PROVISION
 (DELINEATOR WITH STEEL POST)
 338+71 RT

675.50 REMOVING SIGNS
 AS SHOWN - 2

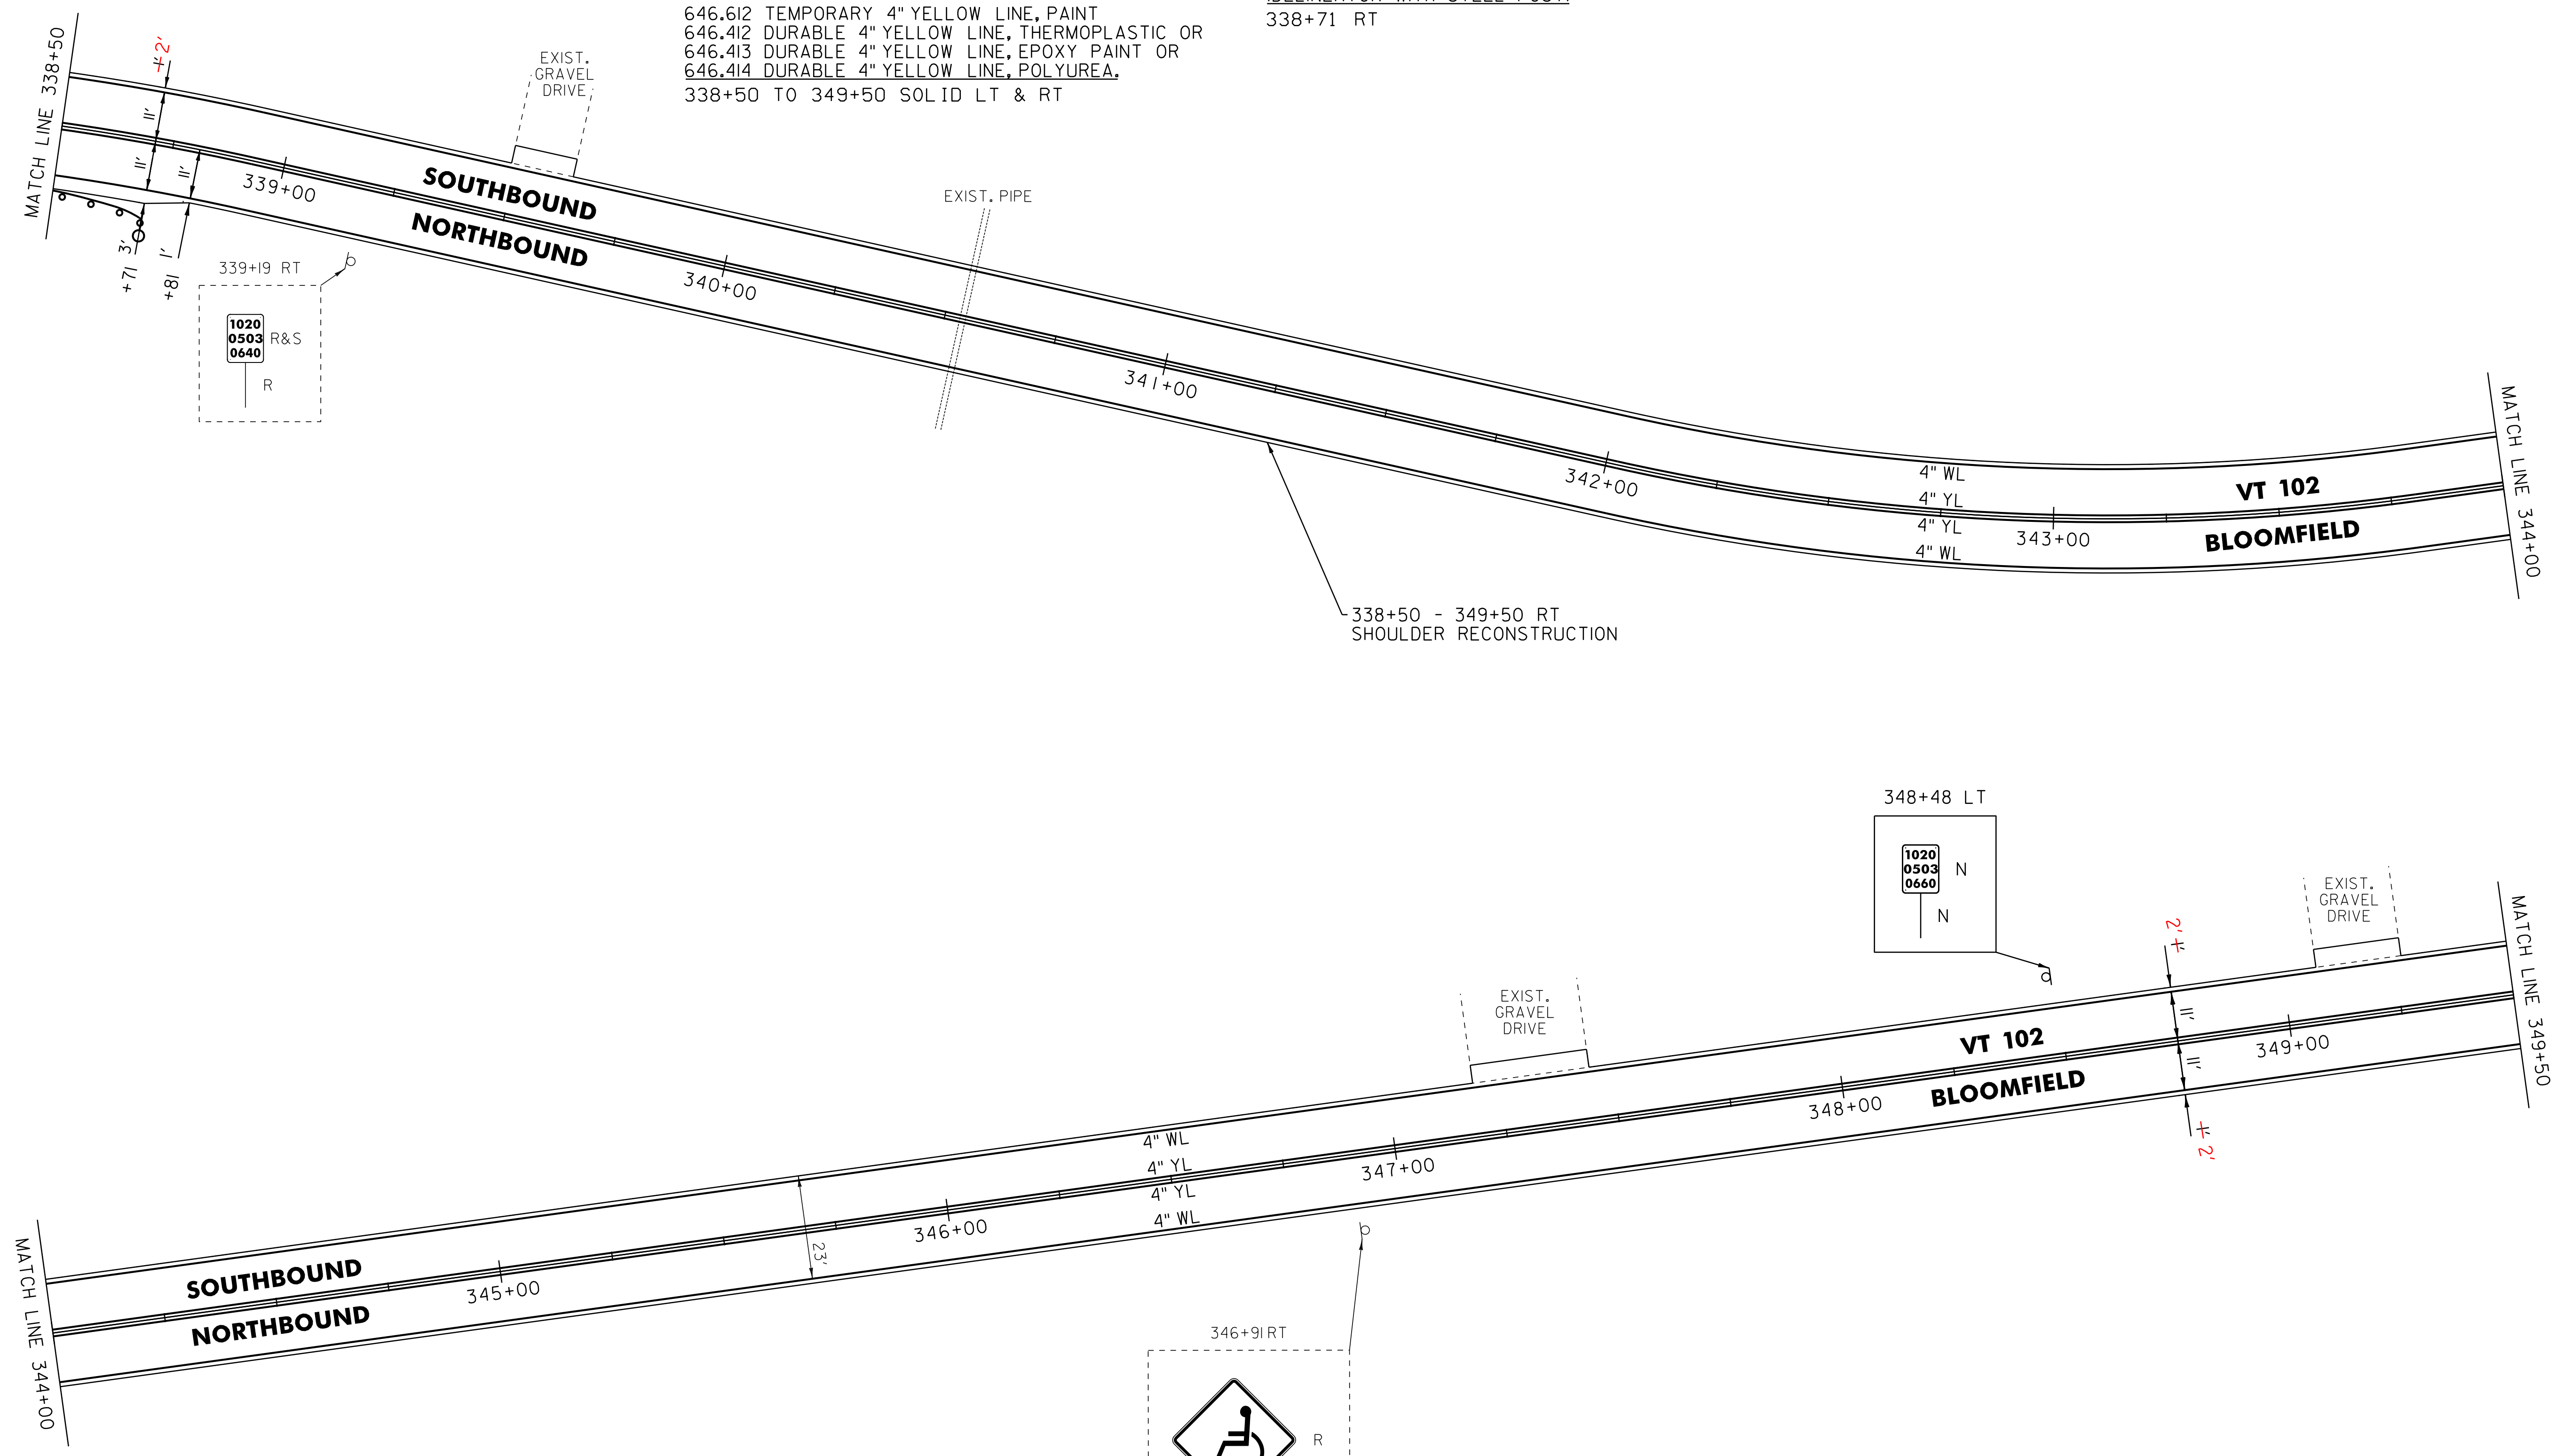

NOT TO SCALE

LEGEND

R	=	REMOVE EXISTING
S	=	SALVAGE
R&S	=	REMOVE AND SALVAGE
N	=	NEW
RET	=	RETAIN
B-B	=	BACK TO BACK
⊕	=	EXISTING GUARDRAIL
⊕	=	PROPOSED GUARDRAIL
— —	=	YELLOW LINE
— —	=	WHITE LINE
—○—	=	DELINEATOR

ROADWAY LAYOUT 33

PROJECT NAME: BLOOMFIELD-LEMINGTON
 PROJECT NUMBER: STP 2610(I)
 FILE NAME: /pave/06c052/pc052
 PROJECT LEADER: PTS
 DESIGNED BY: NLL
 IPARM FILE NAME: 06C052.47

PLOT DATE: 19-JUN-2013 16:59
 DRAWN BY: SNG
 CHECKED BY: PTS
 SHEET 47 OF 82